


The drawing is an instrument of service and the property of e group landscape architecture / environmental design inc. and shall remain the property of e group landscape architecture / environmental design inc. This use of the drawing shall be restricted to the original site for which it was prepared and publication thereof is prohibited without the written consent of e group landscape architecture / environmental design inc.

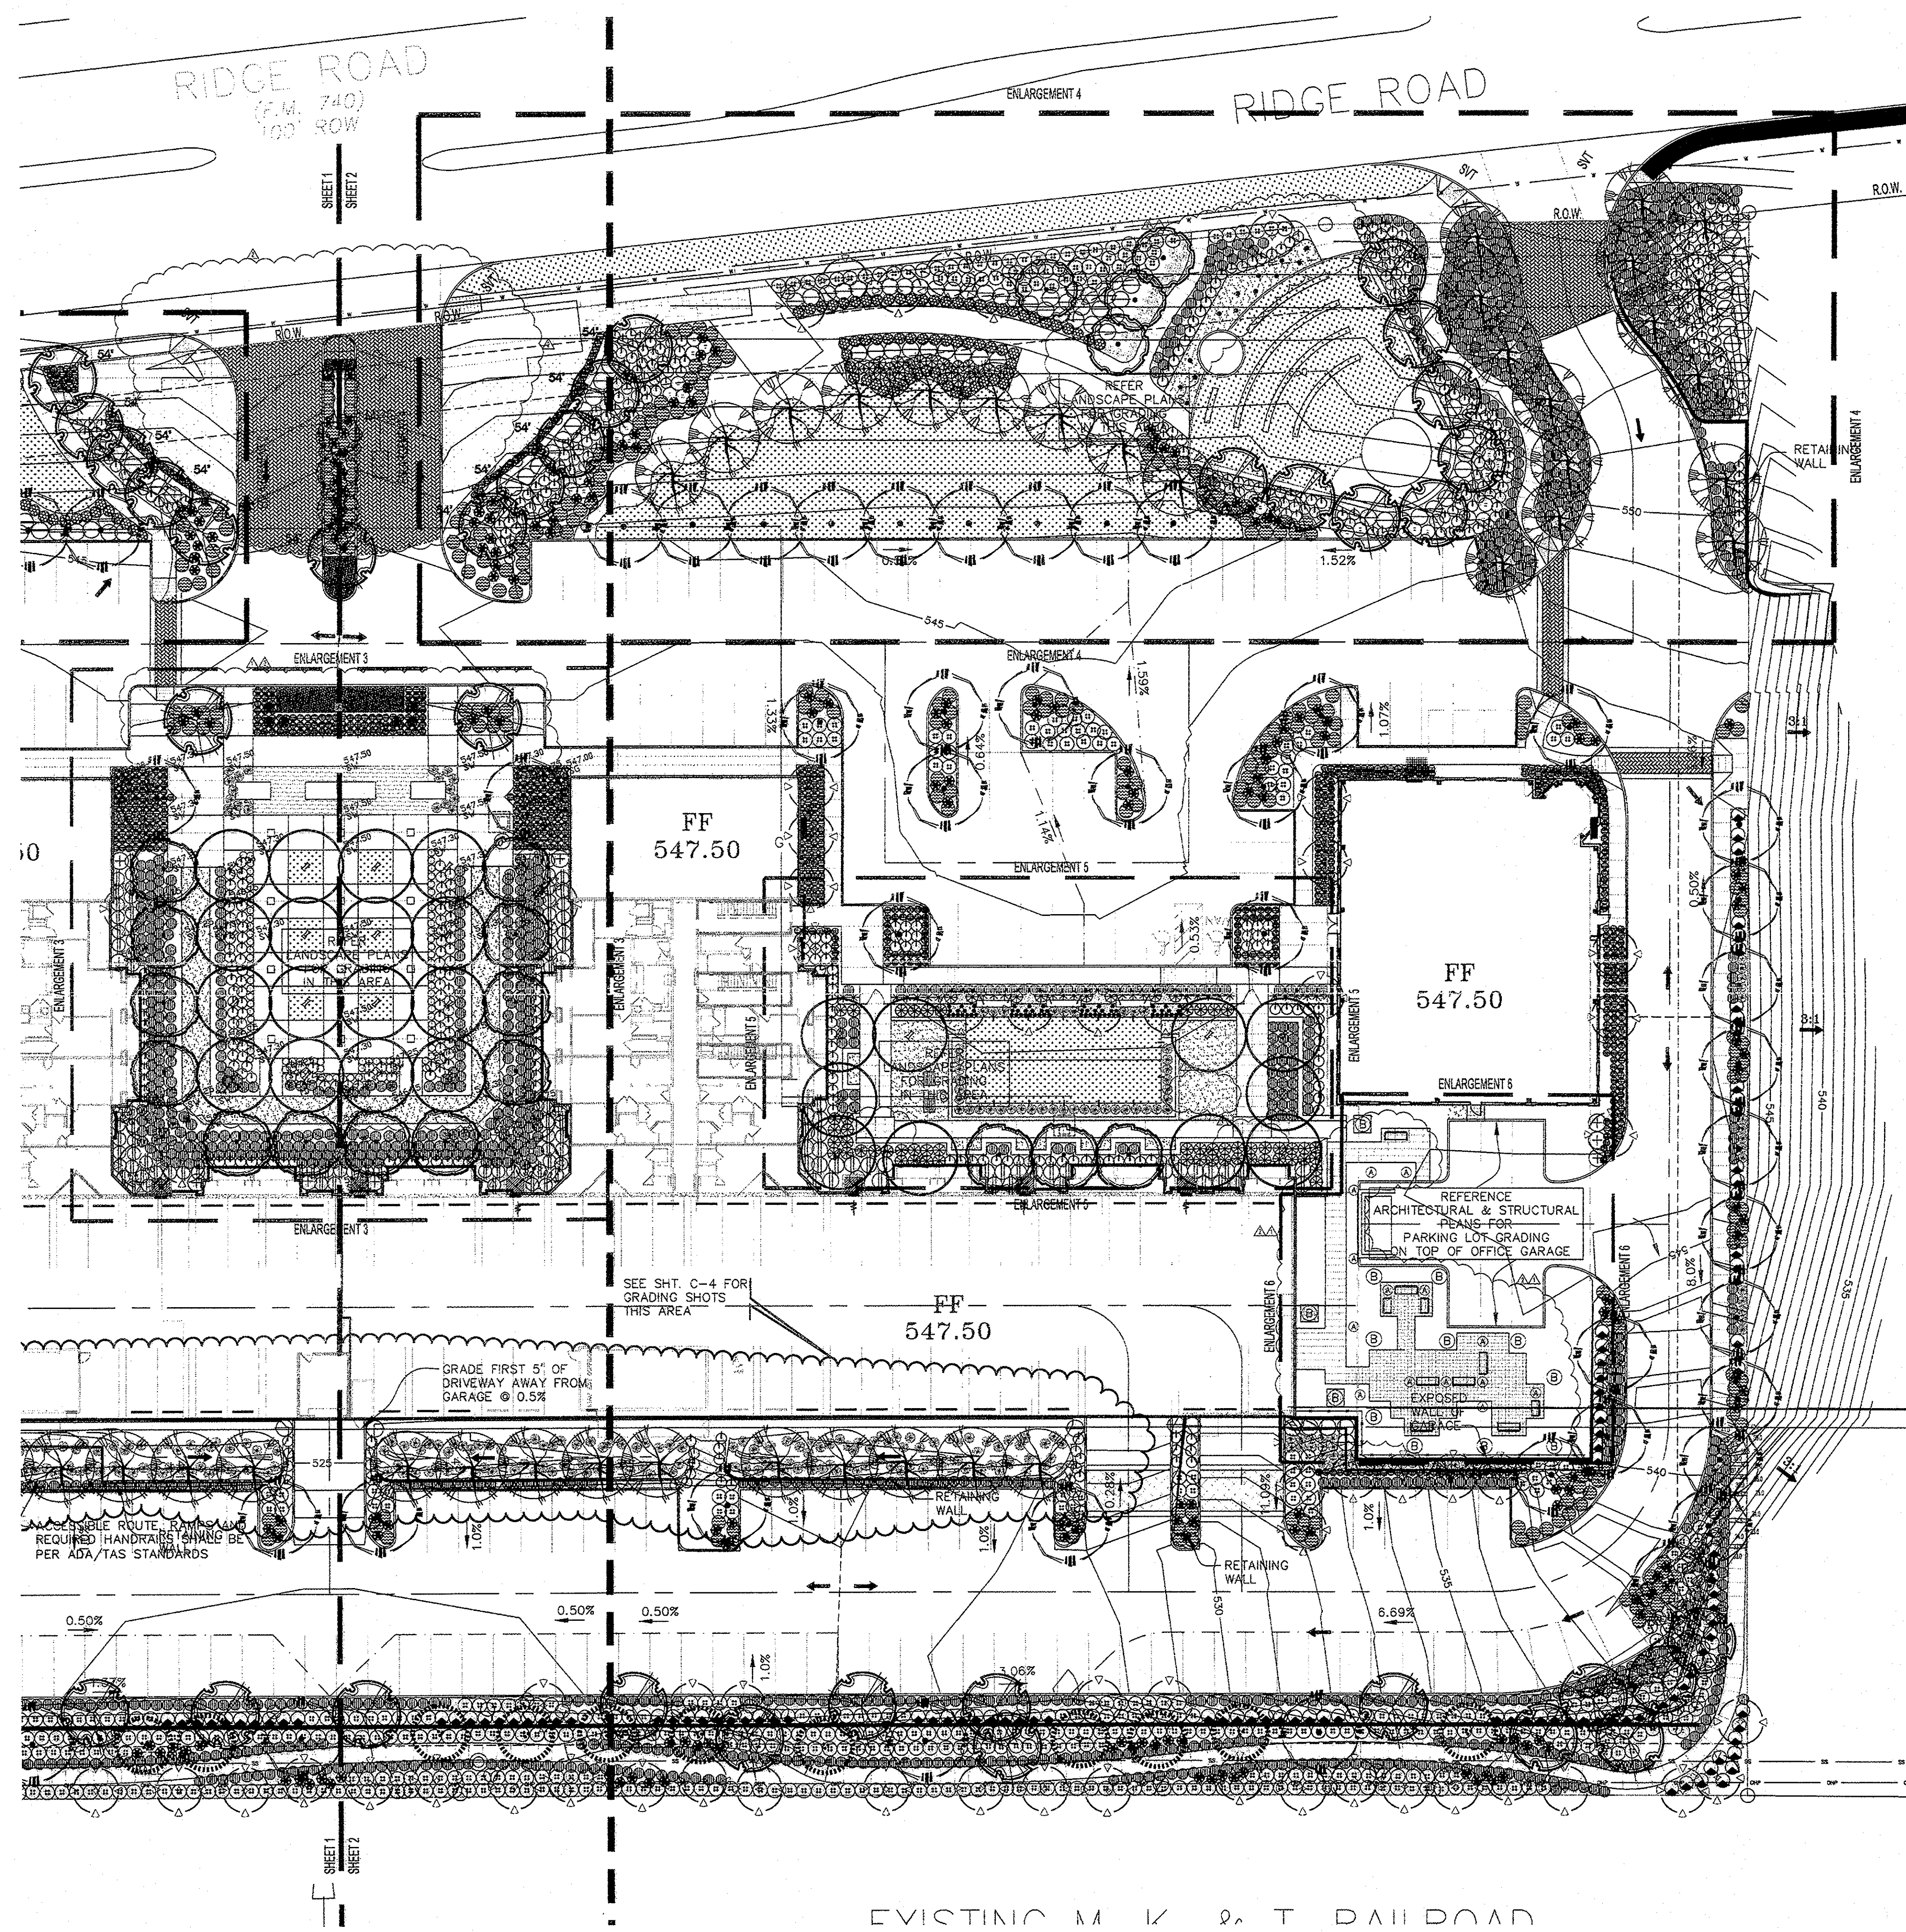

PLANT LEGEND

ACCENT TREES	BOTANICAL / COMMON NAME	SIZE	QTY
○	Ulmus parvifolia CHINESE ELM	48" BOX STANDARD	32
○	Quercus virginiana LIVE OAK	48" BOX STANDARD	77
○	Magnolia grandiflora Little Gem	38" BOX STANDARD	13
○	Lagerströmia indica CRABE MYRTLE	38" BOX STANDARD	17
○	Yucca ceroxylon PURPLE LEAF PLUM	48" BOX MULTI-TRUNK	13
○	Acer spicatum AUTUMN BLAZE	54/48" BOX MULTI-TRUNK	11/40
○	Pyrus caryocarpa BRADFORD PEAR	54" BOX STANDARD	66
○	Taxodium distichum BALD CYPRESS	54" BOX STANDARD	16

SHRUBS	SIZE	QTY
⊕	Viburnum tinus VIBURNUM	6 GAL 12
⊕	Photinia fraseri FRASERS PHOTINIA	6 GAL 212
⊕	Linum catharticum BLUE VASE	5 GAL 224
⊕	Melaleuca eucalyptum ORANGE GRAPE HOLLY	4 GAL 138
⊕	Photinia fraseri tree form	5 GAL 8
⊕	Lagerströmia indica Dwarf White	5 GAL 179
⊕	Photinia fraseri Dwarf White	5 GAL 100
⊕	Pyracantha hybrid Red Sp	5 GAL 908
⊕	Nandina domestica Dwarf Nandina	5 GAL 1330

GROUND COVERS	SIZE	QTY
⊕	Trachelium minus asiaticum ASIANIC JASMINE	1 GAL 2088
⊕	Juniper squarosa 'Tamariscifolia'	5 GAL 434
⊕	Taxus canadensis 'prostrata'	4 GAL 127
⊕	Hemerocallis species DAYLILY	1 GAL 152
⊕	Eurythmum japonicus 'variegatum' VAREGATED EVERGREEN EUONYMUS	2 GAL 47
⊕	Zephyranthes x 'Purple Sunray'	1 GAL 67
⊕	RAIN LILY	7 GAL 67

ACCENTS	SIZE	QTY
⊕	Yucca monticola SOFT LEAF YUCCA	5 GAL 347
⊕	Persea indica Purple Fountain Grass	5 GAL 79
⊕	Muhlenbergia capillaris AUTUMN GLOW	5 GAL 81
⊕	Muhlenbergia capillaris RED SUN	5 GAL 144
⊕	Hemerocallis species RED YUCCA	1 GAL 240
⊕	Annals PER MAINTENANCE SUPERINTENDENT	4" Container 9" O.C. x

POTS	QTY PER POT	SIZE	TOTAL QTY
A	POT 'A' - CALIFORNIA CR-CAL-2922T	(1) 5 GAL	14
B	POT 'B' - CALIFORNIA CR-CAL-2922P	(1) 5 GAL	14
C	POT 'C' - CASCADE CR-CES3638 WITH SAUCER	(1) 15 GAL	9

MATERIALS	QTY
⊕	SURFACE SELECT BOULDERS 25
⊕	SOIL (sq ft) 23,970 SF
⊕	TEXTURE 10 HYBRID BERMAUDA 87,285.61 SF

e group
landscape architecture
environmental design inc.

817 North Central Avenue
Phoenix, Arizona 85004
602-462-9000
Fax: 602-462-9001
www.egroupinc.com

ROCKWALL COMMONS
ROCKWALL, TEXAS

T.F. STONE COMPANY
18800 Dallas Pkwy #400
Dallas, Texas 75248
(972) 9315911

HUMPHREYS & PARTNERS
ARCHITECTS, L.P.
3300 ALPHEA ROAD • DALLAS, TEXAS 75245
(972) 751-8550 • 3701 51st • 9538 FAX
DALLAS • SAN ANTONIO
CHICAGO • LOS ANGELES

KEY MAP LOCATION

△	8/27/04 CITY COMMENTS
△	4/20/07 - 4/30/07 VE ITEMS
△	6/6/07 OWNER COMMENTS

○	DESIGN REVIEW
○	DESIGN DEVELOPMENT
○	CONSTRUCTION DOCUMENTS
○	BID/PRICING PACKAGE
○	CONSTRUCTION ISSUE

MAY 10, 2004

LM, TH, MM, JL, RV
MS, ZK
205142

RECORD DRAWING
THIS RECORD DRAWING HEREIN REFLECTS TO THE BEST OF THE DESIGN ENGINEER'S KNOWLEDGE, THE APPROXIMATE LOCATION OF THE CONSTRUCTED WORK, USING INFORMATION AS PROVIDED BY THE CONTRACTORS AND SURVEYED GRADES.

1 inch = 50 feet

NORTH

EXISTING METROLINK & T DAIL ROAD