



ENGINEERING SERVICES, INC.  
P.O. Box 215  
Bedford, Texas 76095  
Ph. 817/715-0716



Contractor

ENGINEERED RETAINING  
WALL SYSTEMS, INC.  
EULESS, TEXAS

ROCKWALL COMMONS

ROCKWALL, TEXAS

THE USE OF THESE PLANS AND SPECIFICATIONS SHALL BE RESTRICTED TO THE ORIGINAL SITE FOR WHICH THEY WERE PREPARED. ANY REPRODUCTION OR DISTRIBUTION IS EXPRESSLY LIMITED TO SUCH USE. ANY OTHER REPRODUCTION, REUSE, OR DISCLOSURE BY ANY METHOD, IN WHOLE OR IN PART, IS PROHIBITED. THESE DRAWINGS AND SPECIFICATIONS CONTAIN PROPRIETARY INFORMATION AND TITLE REMAINS IN THE EXCLUSIVE POSSESSION OF FX ENGINEERING SERVICES, INC.

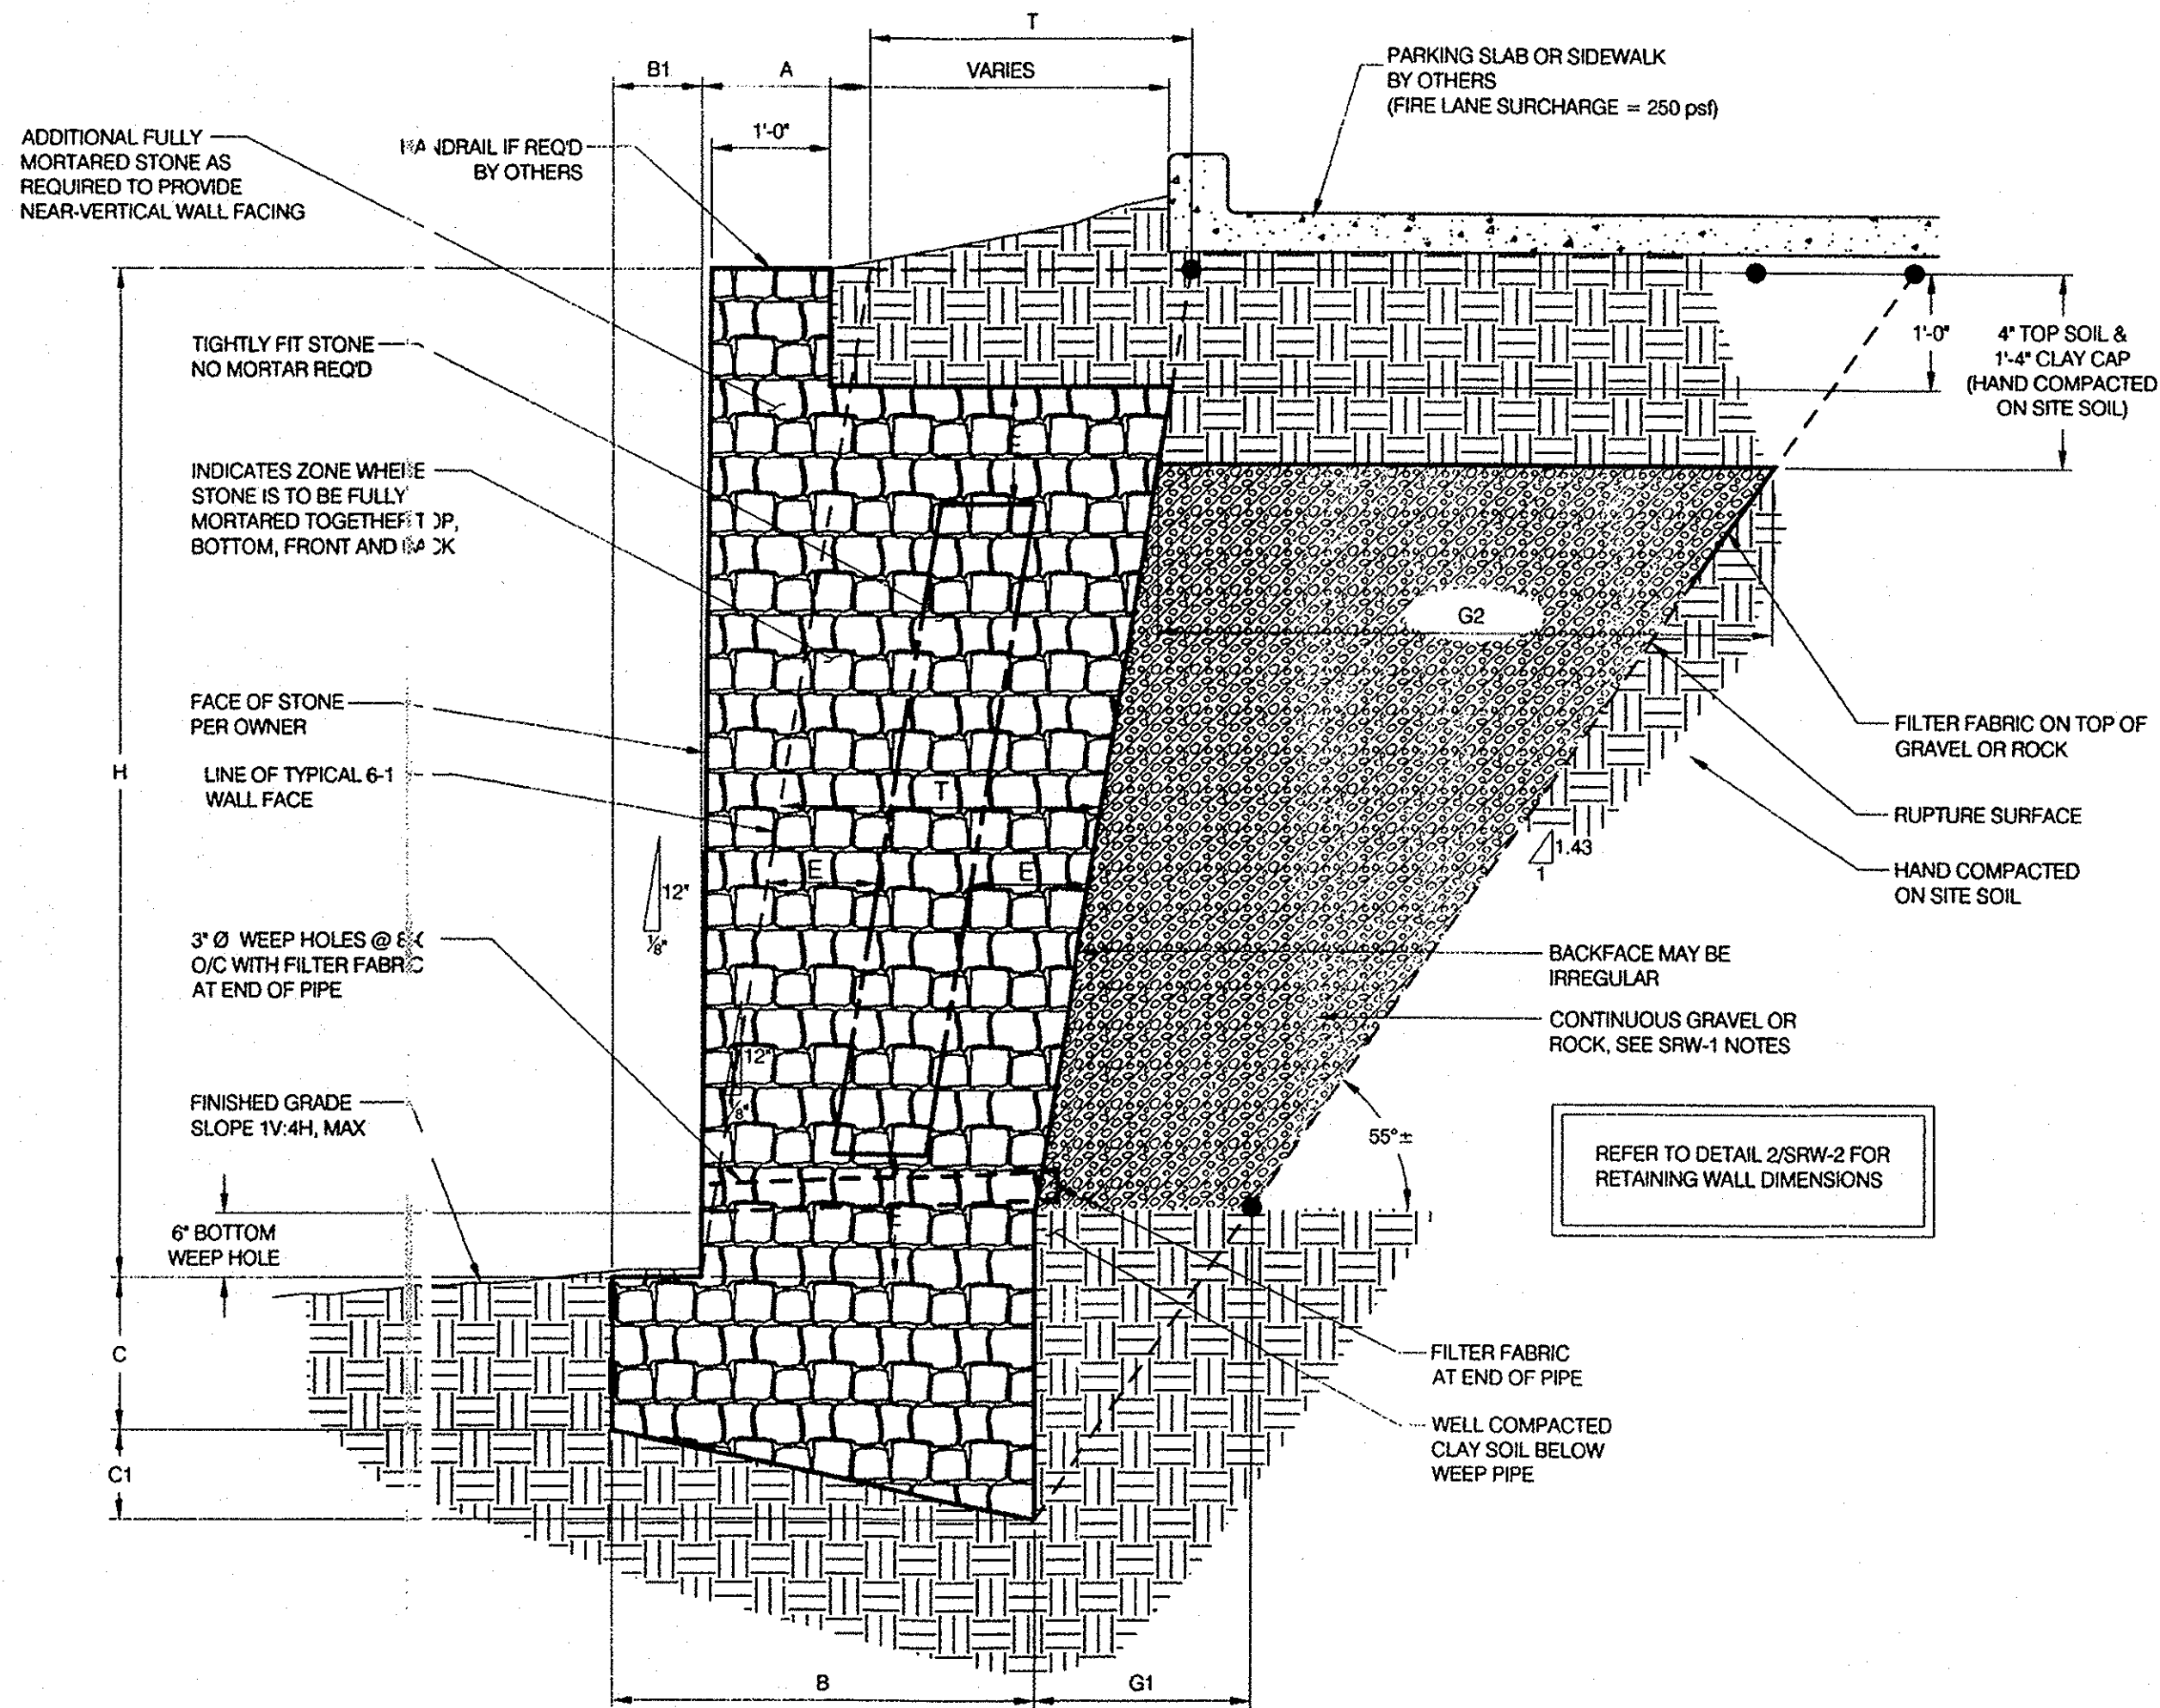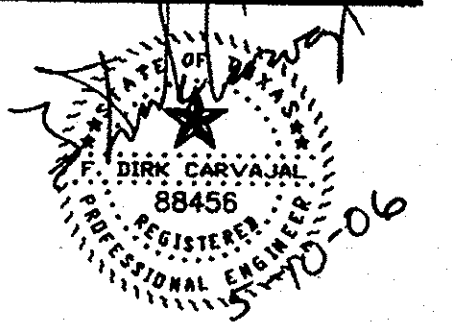

1  
SRW-6 SCALE: 3/4" = 1'-0"

**RETAINING WALL SECTION W/ NEAR-VERTICAL FACE**  
**BEARING ON UNDISTURBED SOILS OR COMPACTED AND TESTED SOILS**  
**SLOPE SOILS ON TOP & BOTTOM OF WALL 1V : 4H (14°) MAX**

**RECORD DRAWING**  
THIS RECORD DRAWING HEREIN REFLECTS TO THE BEST OF THE DESIGN ENGINEERS KNOWLEDGE, THE APPROXIMATE LOCATION OF THE CONSTRUCTED WORK, USING INFORMATION AS PROVIDED BY THE CONTRACTORS AND SURVEYED GRADES.

Revisions

#	ISSUE	DATE

1 ADD SHT SRW-6 5/10/06

**Sheet Information**  
Date: 8/27/04  
FX Job #: 0122  
Scale: AS NOTED  
Drawn: RKR  
Approved: FDC

Sheet Title

TYPICAL  
WALL  
SECTIONS

Sheet #

SRW-6

ISSUE for CONSTRUCTION