


CONSTRUCTION PLANS
FOR
ROCKWALL COMMUNITY HOSPITAL
LOT 15, BLOCK A
MOB PARKING LOT EXPANSION
HORIZON ROAD @ ROCKWALL PARKWAY
EDWARD TEAL SURVEY, ABSTRACY No. 207
5.406 ACRES
CITY OF ROCKWALL, ROCKWALL COUNTY, TEXAS

FOR
PERKINS + WILL
 10100 N. CENTRAL EXPRESSWAY SUITE 300
 DALLAS, TEXAS 75206
 OFFICE: 214-289-8700 ; FAX: 214-289-8701

PREPARED BY
 **Pacheco Koch**
 Consulting Engineers
 8350 N. CENTRAL EXPWY., SUITE 1000 PH. 972.235.3031
 DALLAS, TEXAS 75206 FAX 972.235.9544

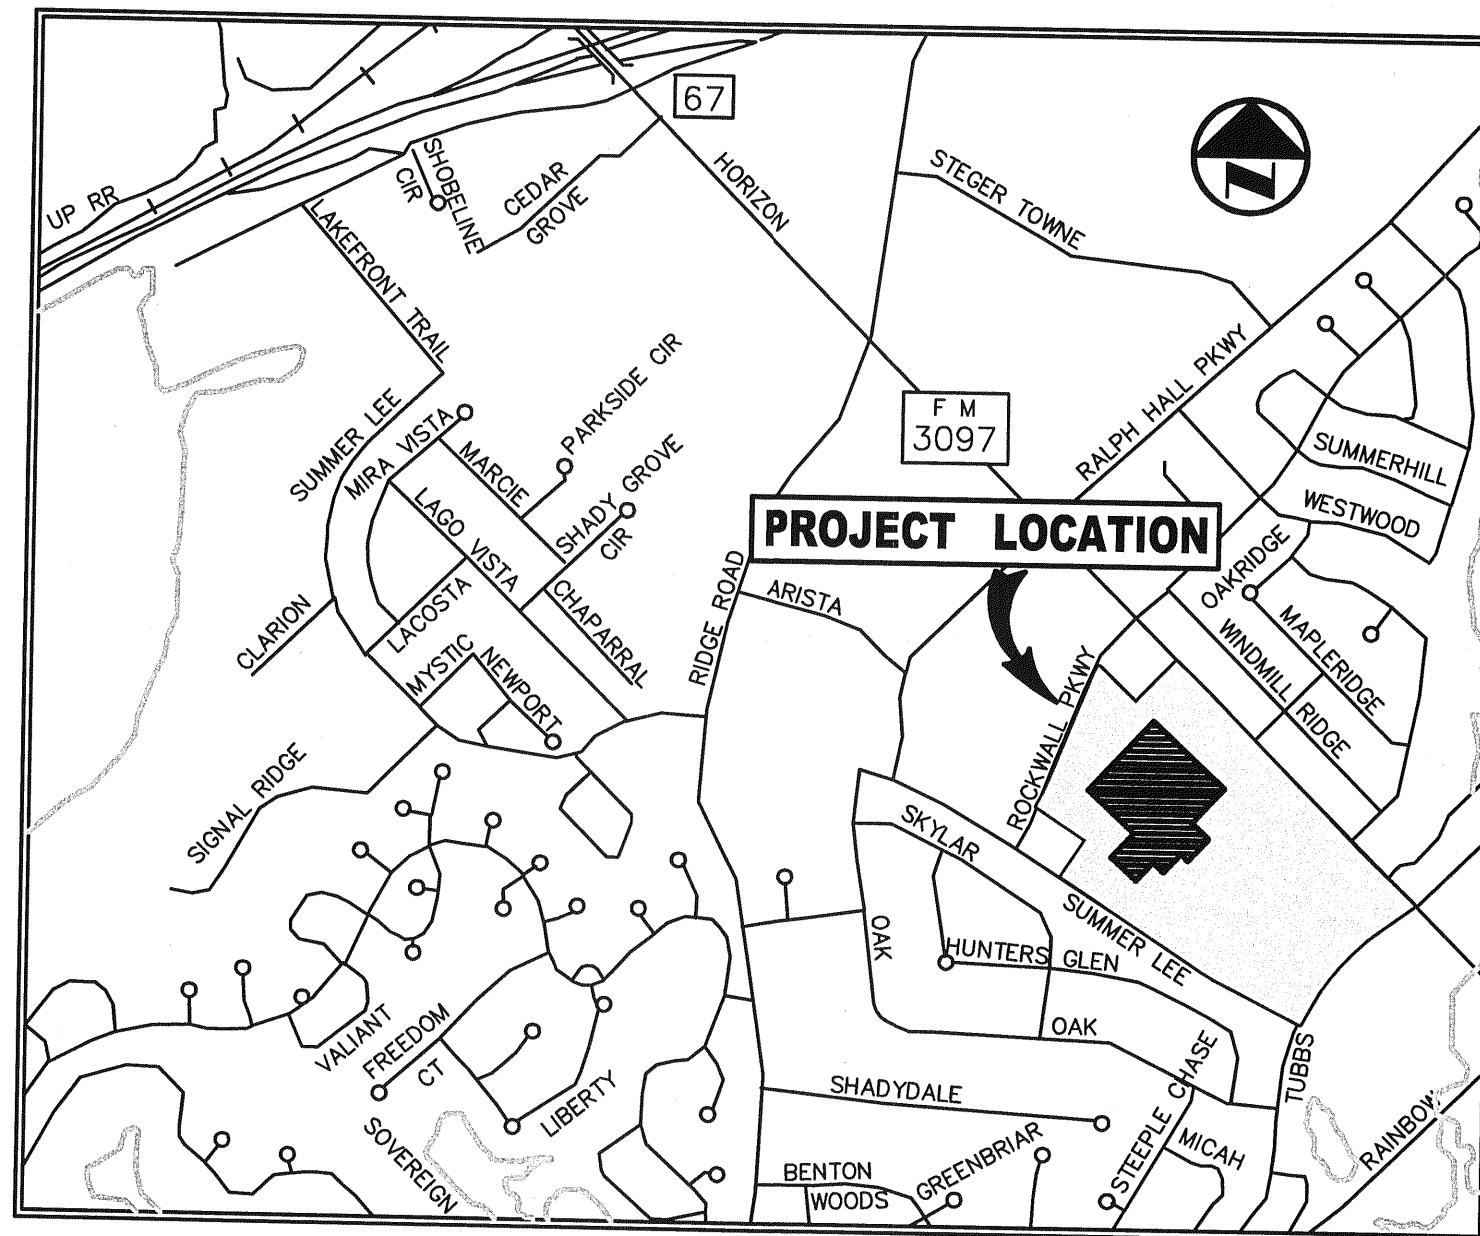


VICINITY MAP
 NTS

DRAWING SHEET INDEX

SHEET	DESCRIPTION
C1.1	DIMENSIONAL CONTROL PLAN
C2.1	GRADING PLAN
C3.1	DRAINAGE AREA MAP
C4.1	STORM SEWER PLAN
C4.2	STORM SEWER PROFILE
C5.1	PAVING PLAN & DETAILS
C6.1	EROSION CONTROL PLAN & DETAILS
L1.1	LANDSCAPE PLAN
L1.2	SOIL AMENDMENT PLAN & LANDSCAPE DETAILS
L2.1	IRRIGATION PLAN
L2.2	IRRIGATION DETAILS

RECORD DRAWING

THIS DRAWING HAS BEEN REVISED TO REFLECT CONSTRUCTION RECORDS MAINTAINED AND PROVIDED BY THE CONTRACTOR FOR THIS PROJECT.
 CONTRACTOR: ROGERS O'BRIEN
 DATE REVISED: 2/24/2009

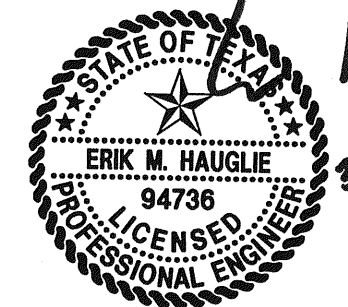

THE SEAL APPEARING ON THIS DOCUMENT WAS AUTHORIZED BY ERIC M. HAUGLE, P.E. 94738 ON 03/06/2008. ALTERATION OF A SEALED DOCUMENT WITHOUT PROPER NOTIFICATION TO THE RESPONSIBLE ENGINEER IS AN OFFENSE UNDER THE TEXAS ENGINEERING PRACTICE ACT.