

GENERAL NOTES:

ALL DIMENSIONS ARE TO BACK-OF-CURB
ALL CURBS ARE 6" STANDARD CURBS


SIDEWALK SECTIONS:

ALL SIDEWALKS WILL BE A MINIMUM OF 5' UNLESS ADJACENT TO PARKING
(6' MINIMUM IF ADJACENT TO STALL) 4" 3000 PSI CONCRETE WITH WELDED WIRE MESH

PARKING LOT PAVEMENT - PARKING LOT PAVEMENT SHALL BE 5" THICK 3000 PSI, 5.5 SACK REINFORCED CONCRETE PAVEMENT ON 12" DEEP SCARIFIED AND COMPACTED SUBGRADE TO 95% STANDARD PROCTOR (ASTM-D-698) AT OR SLIGHTLY ABOVE OPTIMUM MOISTURE CONTENT TO BE REINFORCED WITH NO. 3 BARS 18" O.C.E.W. - CITY OF ROCKWALL TO RECEIVE AND REVIEW CONCRETE MIX DESIGN

AS-BUILT DRAWING 10-12-15

THIS DOCUMENT IS SUBMITTED AS AN "AS-BUILT DRAWING" FOR RECORD PURPOSES ONLY. ANY MODIFICATION OR CHANGES THAT HAVE BEEN MADE DURING CONSTRUCTION AND NOTED ON THIS DRAWING HAVE BEEN SUPPLIED BY THE OWNER, HIS REPRESENTATIVE OR THE CONTRACTOR. FIELD INSPECTION/CONTRACT SUPERVISION OF THE CONSTRUCTION WAS PERFORMED BY OTHERS. IT IS NOT GUARANTEED BY HELMBERGER ASSOCIATES, INC. THAT THIS DOCUMENT REPRESENTS "AS-BUILT" CONDITIONS. TBPE FIRM NO. 000756

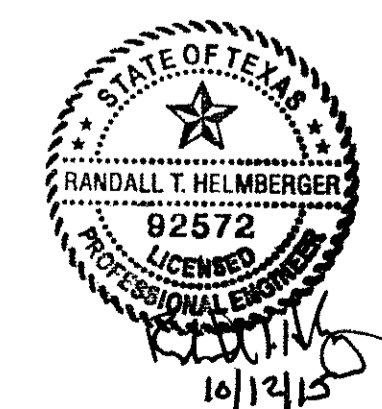

OWNER:
ROCKWALL COUNTY VETERINARY CLINIC
2897 TX-66
ROCKWALL, TEXAS 75087
DR. KEITH TAYLOR
(972) 722-9422

CONTRACTOR:
TRI-STAR CONSTRUCTION, INC.
3601 YUCCA DRIVE, SUITE #2
FLOWER MOUND, TEXAS 75028
MR. RANDY AHLFS
(972) 436-1867

ENGINEER:
HELMBERGER ASSOCIATES, INC.
1525 BOZMAN ROAD
WYLIE, TEXAS 75098
MR. RANDALL HELMBERGER
(972) 442-7459

SITE IMPROVEMENTS						
ROCKWALL COUNTY VETERINARY CLINIC						
2897 TX-66						
ROCKWALL, TEXAS						
TBPE REGISTRATION NO. F-000756		H HELMBERGER ASSOCIATES, INC. CIVIL AND ENVIRONMENTAL ENGINEERS 625 BOZMAN ROAD, WYLIE, TEXAS 75098 (972) 442-7459				
DESIGN	DRAWN	DATE	SCALE	NOTES	FILE	NO.
HELM.	CADD	JULY 2015	1"=20'	SPALN	1509	C1