

POND # 2

FREQUENCY = 10 YEAR

I. VOLUME REQUIRED

PRESENT CONDITION Td = 20 DESIGN TIME C = 0.35 I = 5.68 IN/HR A = 16.09 ACRES Q = C*I*A = 31.98 CFS	PROPOSED CONDITION Td = 10 DESIGN TIME C = 0.90 I = 7.19 IN/HR A = 16.09 ACRES Q = C*I*A = 104.12 CFS
---	---

MAX. RELEASE RATE = PRESENT CONDITION-DIRECT DISCHARGE
 MAX. RELEASE RATE = 31.98 - 0.26 = 31.72 CFS

TIME	INTENSITY	DISCHARGE	INFLOW	OUTFLOW	STORAGE
10	7.19	104.83	62,898.12	19,323.36	43,574.76
15	6.35	92.58	63,324.70	24,154.20	59,170.50
20	5.68	82.81	95,377.23	29,985.04	70,392.24
25	5.14	74.94	112,411.60	33,815.68	78,595.92
30	4.7	68.53	123,346.80	36,646.72	84,700.08
35	4.33	63.13	132,575.94	43,477.56	89,098.38
40	4.01	58.47	140,317.92	48,308.40	92,009.52
45	3.73	54.36	146,835.18	53,139.24	93,695.94
50	3.5	51.03	153,090.00	57,970.08	95,119.92
55	3.29	47.97	158,295.06	62,800.92	95,494.14
60	3.1	45.20	162,712.80	67,631.76	95,061.04
70	2.78	40.53	170,236.08	77,293.44	92,942.64
80	2.53	36.89	177,059.52	86,955.12	90,104.40
90	2.32	33.83	182,658.24	96,616.80	86,041.44

II. VOLUME PROVIDED

POND # 2

ELEV	AREA	AVE. AREA	VOLUME	CUM. VOL.
541	55,831.71	53,465.45	53,465.45	170,439.65
540	51,299.18	49,244.35	49,244.35	116,974.20
539	47,189.52	45,249.81	45,249.81	67,729.85
538	43,310.09	22,480.05	22,480.05	22,480.05
537	1,850.01			

V-NOTCH CALCULATIONS

$$Q = 2.5 \cdot H^{2.5} \cdot \tan \theta / 2$$

Q = DISCHARGE

H = HEAD ON WEIR = W.S. ELEV. - F.L. ELEV

θ = ANGLE OF NOTCH IN DEGREES

$$H = \text{TOTAL HEAD} = 539.56 - 536.68 = 2.88$$

$$Q = 2.5 \cdot 2.88^{2.5} \cdot \tan 68.9/2 = 24.15 \text{ CFS}$$

FREQUENCY = 25 YEAR

I. VOLUME REQUIRED

PRESENT CONDITION Td = 20 DESIGN TIME C = 0.35 I = 6.61 IN/HR A = 16.09 ACRES Q = C*I*A = 37.22 CFS	PROPOSED CONDITION Td = 10 DESIGN TIME C = 0.90 I = 8.32 IN/HR A = 16.09 ACRES Q = C*I*A = 119.03 CFS
---	---


MAX. RELEASE RATE = PRESENT CONDITION-DIRECT DISCHARGE
 MAX. RELEASE RATE = 37.22 - 0.29 = 36.93 CFS

TIME	INTENSITY	DISCHARGE	INFLOW	OUTFLOW	STORAGE
10	8.22	119.85	71,908.56	22,487.22	49,421.34
15	7.33	106.87	96,184.28	28,109.03	68,075.24
20	6.61	96.37	115,648.56	33,730.83	81,917.73
25	6.01	87.83	131,438.70	39,352.64	92,086.07
30	5.50	80.19	144,342.00	44,974.44	99,367.56
35	5.07	73.92	155,233.26	50,596.25	104,637.02
40	4.69	68.38	164,112.48	56,218.05	107,894.43
45	4.37	63.71	172,029.42	61,839.86	110,189.57
50	4.08	59.49	178,459.20	67,461.66	110,997.54
55	3.83	55.84	184,276.82	73,083.47	111,183.16
60	3.60	52.49	189,566.80	78,705.27	110,251.53
70	3.21	46.80	196,587.56	89,948.80	106,618.68
80	2.90	42.26	202,953.60	101,192.49	101,761.11
90	2.64	38.49	207,852.48	112,436.10	96,416.38

II. VOLUME PROVIDED

POND # 2

ELEV	AREA	AVE. AREA	VOLUME	CUM. VOL.
541	55,831.71	53,465.45	53,465.45	170,439.65
540	51,299.18	49,244.35	49,244.35	116,974.20
539	47,189.52	45,249.81	45,249.81	67,729.85
538	43,310.09	22,480.05	22,480.05	22,480.05
537	1,850.01			

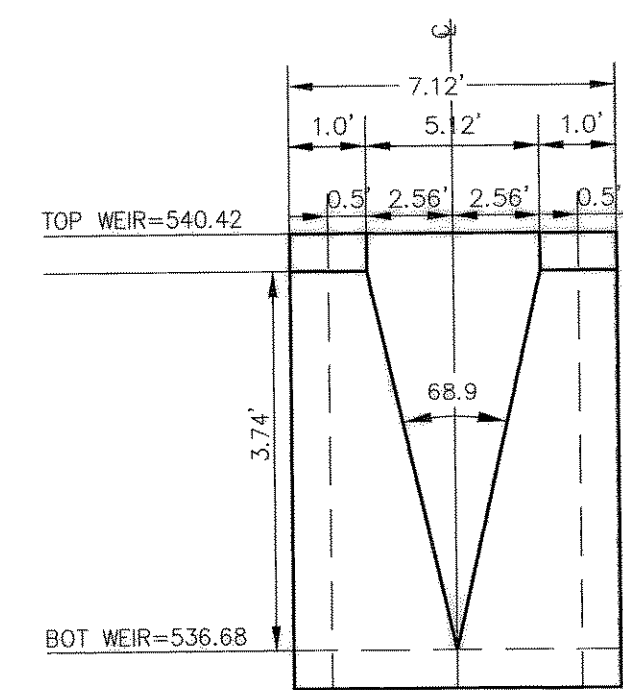

SECTION "A-A"
NTS

$$H = \text{TOTAL HEAD} = 539.88 - 536.68 = 3.20$$

$$Q = 2.5 \cdot 3.20^{2.5} \cdot \tan 68.9/2 = 31.43 \text{ CFS}$$

FREQUENCY = 50 YEAR

I. VOLUME REQUIRED

PRESENT CONDITION Td = 20 DESIGN TIME C = 0.35 I = 7.42 IN/HR A = 16.09 ACRES Q = C*I*A = 41.78 CFS	PROPOSED CONDITION Td = 10 DESIGN TIME C = 0.90 I = 9.01 IN/HR A = 16.09 ACRES Q = C*I*A = 130.47 CFS
---	---


MAX. RELEASE RATE = PRESENT CONDITION-DIRECT DISCHARGE
 MAX. RELEASE RATE = 41.78 - 0.32 = 41.46 CFS

TIME	INTENSITY	DISCHARGE	INFLOW	OUTFLOW	STORAGE
10	9.01	131.37	78,819.48	25,242.84	53,576.64
15	8.16	118.97	107,075.52	31,553.55	75,521.97
20	7.42	108.18	129,820.32	37,864.26	91,956.06
25	6.77	98.71	146,059.90	44,174.97	103,884.93
30	6.20	90.40	162,712.80	50,485.68	112,227.12
35	5.70	83.11	174,522.60	56,796.39	117,726.21
40	5.25	76.55	183,708.00	63,107.10	120,600.90
45	4.86	70.86	191,318.78	69,417.81	121,900.95
50	4.50	65.61	196,830.00	75,728.52	121,101.48
55	4.19	61.09	201,597.86	82,039.23	119,558.63
60	3.90	56.86	204,703.20	88,349.94	116,353.26
70	3.41	49.72	208,814.76	100,571.36	107,843.40
80	3.00	43.74	209,952.00	113,592.78	96,359.22
90	2.66	38.78	209,427.12	126,214.20	83,212.92

II. VOLUME PROVIDED

POND # 2

ELEV	AREA	AVE. AREA	VOLUME	CUM. VOL.
541	55,831.71	53,465.45	53,465.45	170,439.65
540	51,299.18	49,244.35	49,244.35	116,974.20
539	47,189.52	45,249.81	45,249.81	67,729.85
538	43,310.09	22,480.05	22,480.05	22,480.05
537	1,850.01			

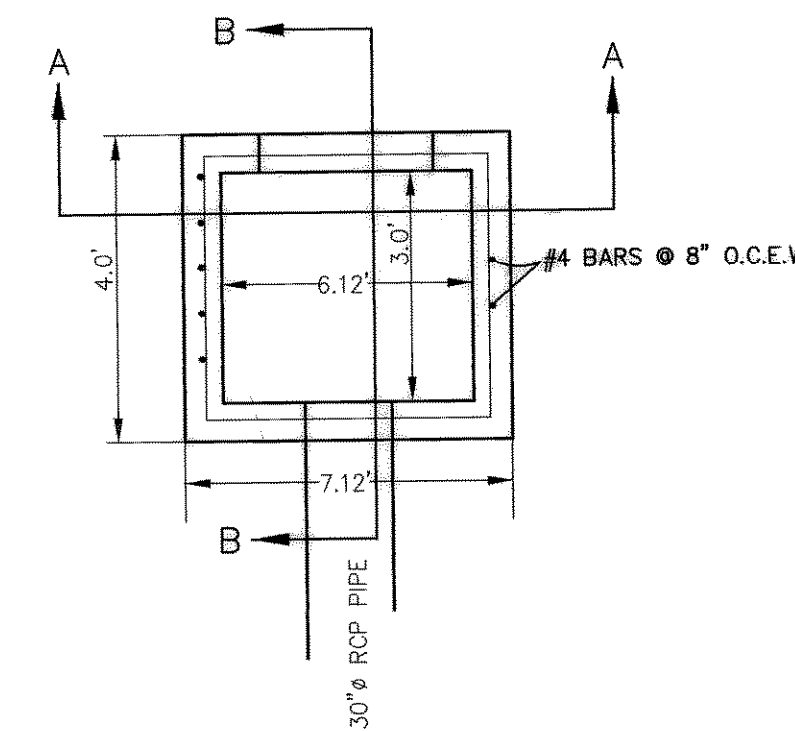

PLAN
NTS

$$H = \text{TOTAL HEAD} = 540.09 - 536.68 = 3.41$$

$$Q = 2.5 \cdot 3.41^{2.5} \cdot \tan 68.9/2 = 36.84 \text{ CFS}$$

FREQUENCY = 100 YEAR

I. VOLUME REQUIRED

PRESENT CONDITION Td = 20 DESIGN TIME C = 0.35 I = 8.30 IN/HR A = 16.09 ACRES Q = C*I*A = 46.74 CFS	PROPOSED CONDITION Td = 10 DESIGN TIME C = 0.90 I = 9.80 IN/HR A = 16.09 ACRES Q = C*I*A = 141.91 CFS
---	---


MAX. RELEASE RATE = PRESENT CONDITION-DIRECT DISCHARGE
 MAX. RELEASE RATE = 46.74 - 0.32 = 46.42 CFS

TIME	INTENSITY	DISCHARGE	INFLOW	OUTFLOW	STORAGE
10	9.80	142.88	85,730.40	28,236.80	57,493.60
15	9.00	131.22	118,098.00	35,295.75	82,802.25
20	8.30	121.01	145,216.80	42,354.90	102,861.90
25	7.50	109.35	164,025.00	49,414.05	114,610.95
30	7.10	103.52	185,332.40	56,473.20	129,859.20
35	6.40	93.31	195,365.20	63,532.35	132,422.85
40	5.90	86.02	208,452.80	70,591.50	135,861.30
45	5.40	78.73	212,576.40	77,650.65	134,925.75
50	5.00	72.90	216,700.00	84,709.80	133,990.20
55	4.60	69.98	230,947.20	91,768.95	139,178.25
60	4.50	65.61	236,196.00	98,828.10	137,367.90
70	4.00	56.32	244,944.00	112,946.40	131,997.60
80	3.70	53.95	256,940.80	127,064.70	131,876.10
90	3.40	49.57	267,888.80	141,183.00	126,505.80

II. VOLUME PROVIDED

POND # 2

ELEV	AREA	AVE. AREA	VOLUME	CUM. VOL.
541	55,831.71	53,465.45	53,465.45	170,439.65
540	51,299.18	49,244.35	49,244.35	116,974.20
539	47,189.52	45,249.81	45,249.81	67,729.85
538	43,310.09	22,480.05	22,480.05	22,480.05
537	1,850.01			

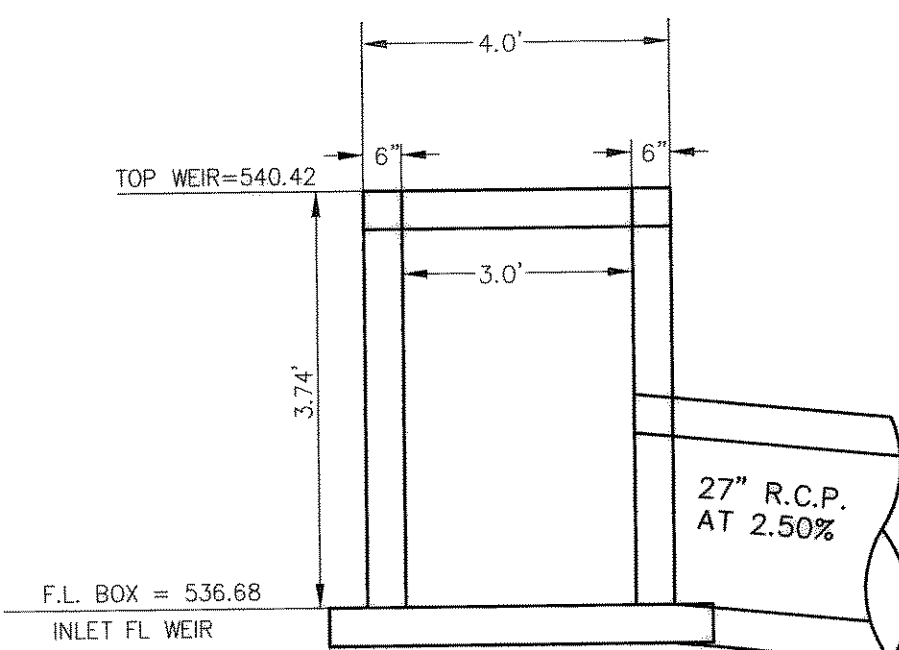


SECTION "B-B"
NTS

$$H = \text{TOTAL HEAD} = 540.42 - 536.68 = 3.74$$

$$Q = 2.5 \cdot 3.74^{2.5} \cdot \tan 68.9/2 = 46.42 \text{ CFS}$$

REVISED TO CONFORM TO CONSTRUCTION RECORDS.

DATE: 5/21/04

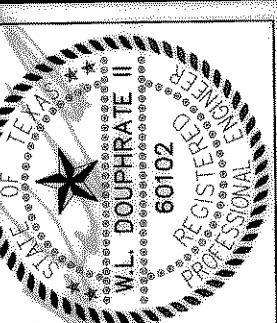

DOUPHRATE & ASSOCIATES, INC.
 ENGINEERING - PROJECT MANAGEMENT - SURVEYING
 2225 RIDGE RD., # 200 ROCKWALL, TEXAS 75087
 PHONE: (972) 771-9004 FAX: (972) 771-9005

DETENTION POND CALCULATIONS (POND # 2)
 ROCKWALL CROSSING
 CITY OF ROCKWALL
 ROCKWALL COUNTY, TEXAS

2	12/9/04
1	10/22/04
REVISION	
W.L.D.	
CHECKED	
K.E.B.	
DRAWN	
DATE	10/15/04
PROJECT	0242
	5A
	OF
	21