

LINE : "A"

Line	ToLine	LineLength (ft)	Incr.Area (ca)	TotalArea (ca)	RunoffCoeff. (C)	IncrC x A	TotalC x A	InletTime (min)	TimeConc (min)	Rnfallnt (in/hr)	TotalRunoff (cfs)	AdnlFlow (cfs)	TotalFlow (cfs)	CapacFull (cfs)	Veloc (ft/s)	PipeSize (in)	PipeSlope (%)	Inv ElevUp (ft)	Inv ElevDn (ft)	HGLUp (ft)	HGLDn (ft)	Grnd/RimUp (ft)	Grnd/RimDn (ft)	Line ID
1	Outfall	194.74	6.54	6.54	0.9	5.89	5.89	10	10	9.8	57.69	0	57.69	56.61	11.77	30	1.91	545.59	541.88	548.06	544.38	551	0	A-1


Line	PipeSize (in)	Q (cfs)	Inv ElevDn (ft)	HGLDn (ft)	DepthDn (ft)	AreaDn (sqft)	VelocDn (ft/s)	Vel HdDn (ft)	EGLDn (ft)	SfDn (%)	LineLength (ft)	Inv ElevUp (ft)	HGLUp (ft)	DepthUp (ft)	AreaUp (sqft)	VelocUp (ft/s)	Vel HdUp (ft)	EGLUp (ft)	SfUp (%)	SfAve (%)	EnergyLoss (ft)	JLCCoeff (K)	MinorLoss (ft)	Line ID
1	30	57.69	541.88	544.38	2.5	4.91	11.75	2.15	546.53	1.979	194.74	545.59	548.06	2.47	4.9	11.78	2.16	550.22	1.808	1.894	3.688	1	2.16	A-1


LINE : "B"

Line	ToLine	LineLength (ft)	Incr.Area (ac)	TotalArea (ac)	RunoffCoeff. (C)	IncrC x A	TotalC x A	InletTime (min)	TimeConc (min)	Rnfallnt (in/hr)	TotalRunoff (cfs)	AdnlFlow (cfs)	TotalFlow (cfs)	CapacFull (cfs)	Veloc (ft/s)	PipeSize (in)	PipeSlope (%)	Inv ElevUp (ft)	Inv ElevDn (ft)	HGLUp (ft)	HGLDn (ft)	Grnd/RimUp (ft)	Grnd/RimDn (ft)	Line ID
1	Outfall	38.04	0.83	2.87	0.9	0.75	2.58	10	11.2	9.6	24.73	0	24.73	23.03	5.04	27	0.32	542.33	542.21	544.83	544.71	546.83	0	B-1(0+38.04)G.I
2	1	58.13	0	1.89	0.9	0	1.7	10	11	9.6	16.35	0	16.35	16.24	4.11	27	0.28	542.74	542.58	545.58	545.42	547.95	546.83	B-2(0+96.17)LAT
3	2	107.52	0	1.71	0.9	0	1.54	10	10.6	9.7	14.89	0	14.89	20.23	4.74	24	0.8	543.86	543	546.25	545.78	550.98	547.95	B-3(2+03.69)LAT
4	3	146.4	0.85	1.31	0.9	0.77	1.18	10	10.2	9.7	11.47	0	11.47	9.39	6.49	18	0.8	545.53	544.36	548.26	546.51	549.32	550.98	B-4(3+50.09)G.I
5	4	31.56	0.46	0.46	0.9	0.41	0.41	10	10	9.8	4.04	0	4.04	5.61	2.29	18	0.29	545.62	545.53	549.29	549.24	551	549.32	B-5(3+81.65)PLG
6	1	32.93	0.15	0.15	0.9	0.14	0.14	10	10	9.8	1.32	0	1.32	26.96	1.91	18	6.59	545	542.83	545.44	545.42	549	546.83	B-1-1.PLG
7	2	40.41	0.18	0.18	0.9	0.16	0.16	10	10	9.8	1.58	0	1.58	27.54	2.07	18	6.88	546.73	543.95	547.21	545.78	550.73	547.95	B-2-1.PLG
8	3	18.33	4.0	4.0	9.0	63.0	63.0	01	01	8.9	25.3	0	25.3	79.12	11.3	81	83.4	64.845	89.645	81.945	84.845	64.255	89.055	GLP-1-3-B

LineNo.	Inlet ID	Area (ac)	InletTime (min)	Int. (in/hr)	RunoffCoeff. (C)	Q =CIA (cfs)	Q Carry-over (cfs)	QCaptured (cfs)	QBypassed (cfs)	JunctType	CurbHeight (in)	CurbLength (ft)	GrateArea (sqft)	GrateLength (ft)	GrateWidth (ft)	GutterSlope (ft/ft)	GutterWidth (ft)	CrossSlope, Sw (ft/ft)	CrossSlope, Sx (ft/ft)	LocalDepr. (in)	InletDepth (in)	InletSpread (ft)	GutterDepth (ft)	GutterSpread (ft)	BypassLine No.
1	B-1-G.I	0.83	10	9.77	0.9	7.3	0	7.3	0	Grate	....	....	5.21	2.29	2.96	Sag	2	0.1	0.03	2	0.44	9.25	0.42	9.25	Sag
2	B-2-LAT	0	10	0	0.9	0	....	....	....	None	....	....	....	....	....	....	....	....	....	....	....	....	....	....	....
3	B-3-LAT	0	10	0	0.9	0	....	....	....	None	....	....	....	....	....	....	....	....	....	....	....	....	....	....	Sag
4	B-4-G.I	0.85	10	9.77	0.9	7.47	0	7.47	0	Grate	....	....	5.21	2.29	2.96	Sag	2	0.1	0.03	2	0.45	9.49	0.42	9.49	Sag
5	B-5-PLG	0.46	10	9.77	0.9	4.04	....	....	....	None	....	....	....	....	....	....	....	....	....	....	....	....	....	....	....
6	B-1-1.PLG	0.15	10	9.77	0.9	1.32	....	....	....	None	....	....	....	....	....	....	....	....	....	....	....	....	....	....	....
7	B-2-1.PLG	0.18	10	9.77	0.9	1.58	....	....	....	None	....	....	....	....	....	....	....	....	....	....	....	....	....	....	....
8	B-3-1.PLG	0.4	10	9.77	0.9	3.52	....	....	....	None	....	....	....	....	....	....	....	....	....	....	....	....	....	....	....

Line	PipeSize (in)	Q (cfs)	Inv ElevDn (ft)	HGLDn (ft)	DepthDn (ft)	AreaDn (sqft)	VelocDn (ft/s)	Vel HdDn (ft)	EGLDn (ft)	SfDn (%)	LineLength (ft)	Inv ElevUp (ft)	HGLUp (ft)	DepthUp (ft)	AreaUp (sqft)	VelocUp (ft/s)	Vel HdUp (ft)	EGLUp (ft)	SfUp (%)	SfAve (%)	EnergyLoss (ft)	JLCCoeff (K)	MinorLoss (ft)	Line ID
1	30	24.73	542.21	544.71	2.5	4.91	5.04	0.39	545.1	0.364	38.04	542.33	544.83	2.5	4.91	5.04	0.39	545.22	0.361	0.363	0.138	1.5	0.59	B-1(0+38.04)G.I
2	27	16.35	542.58	545.42	2.25	3.98	4.11	0.26	545.68	0.279	58.13	542.74	545.58	2.25	3.98	4.11	0.26	545.85	0.279	0.279	0.162	0.75	0.26	B-2(0+96.17)LAT
3	24	14.89	543	545.78	2	3.14	4.74	0.35	546.13	0.433	107.52	543.86	546.25	2	3.14	4.74	0.35	546.6	0.433	0.433	0.466	0.75	0.26	B-3(2+03.69)LAT
4	18	11.47	544.36	546.51	1.5	1.77	6.49	0.66	547.16	1.194	146.4	545.53	548.26	1.5	1.77	6.49	0.66	548.91	1.194	1.194	1.748	1.5	0.98	B-4(3+50.09)G.I
5	18	4.04	545.53	549.24	1.5	1.77	2.29	0.08	549.32	0.148	31.56	545.62	549.29	1.5	1.77	2.29	0.08	549.37	0.148	0.148	0.047	1	0.08	B-5(3+81.65)PLG
6	81	23.1	38.245	24.545	5.1	77.1	10.0	545.45	610.0	39.23	545	44.545	**44.0	34.0	70.3	51.0	0.16	85.545	654.0	632.0	870.0	1	51.0	GLP-1-1-B
7	18	1.58	543.95	545.78	1.5	1.77	0.9	0.01	545.79	0.023	40.41	546.73	547.21	0.48**	0.49	3.24	0.16	547.37	0.461	0.242	0.098	1	0.16	B-2-1.PLG
8	18	3.52	546.98	548.48	1.5	1.77	1.99	0.06	548.54	0.112	33.81	548.46	549.18	0.72**	0.83	4.23	0.28	549.45	0.527	0.319	0.108	1	0.28	B-3-1.PLG

REVISED TO CONFORM TO CONSTRUCTION RECORDS.  
 DATE: 5/21/04

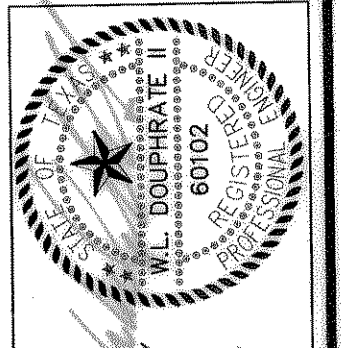

**DOUPHRADE & ASSOCIATES, INC.**  
 ENGINEERING - PROJECT MANAGEMENT - SURVEYING  
 2235 RIDGE RD., # 200 ROCKWALL, TEXAS 75087  
 PHONE: (972)771-9004 FAX: (972)771-9005

**STORM CALCULATIONS**  
**ROCKWALL CROSSING**  
 26.09 AC.  
 CITY OF ROCKWALL, ROCKWALL COUNTY, TEXAS

REVISION	
CHECKED	W.L.D.
DRAWN	Y.B.
DATE	10/15/04
PROJECT	0242
	10 OF 21