


DOUPHRADE & ASSOCIATES, INC.
 ENGINEERING - PROJECT MANAGEMENT - SURVEYING
 2235 RIDGE RD., # 200 ROCKWALL, TEXAS 75087
 PHONE: (972) 771-0004 FAX: (972) 771-0005

DIMENSIONAL CONTROL PLAN
 ROCKWALL CROSSING
 CITY OF ROCKWALL
 ROCKWALL COUNTY, TEXAS

REVISION	DATE	PROJECT
11	05/15/04	11
CHECKED		OF
W.L.D.		21
DATE		
PROJECT		

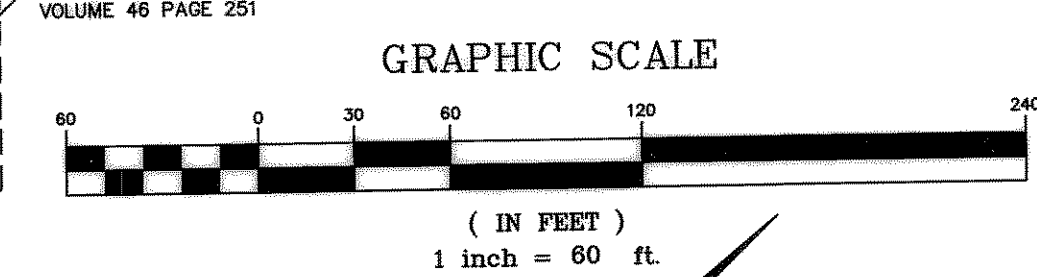

R=3970.90'
 L=1029.35'
 Δ=14°51'09"
 CD=1026.47'
 CB=N42°49'01"E

N28°17'25"W
 133.08'
 S43°31'18"W 304.49'

MIMS ROAD

650.45'

BARBED WIRE FENCE

- NOTE:
1. HEAD TO HEAD PARKING TO BE 20'
 2. ALL PARKING TO BE 18' MIN. WITH 2' OVERHANG

CURVE	LENGTH	RADIUS	DELTA	CD	CB
C1	30.83	20.00	88°18'46"	27.86	S89°16'59"W
C2	31.42	20.00	90°00'00"	28.28	S01°33'38"E
C3	32.25	30.00	92°23'33"	28.87	S87°14'36"W
C4	29.96	30.00	85°49'58"	27.24	S03°38'39"E
C5	33.88	30.00	97°03'46"	28.97	S84°54'29"W
C6	28.95	30.00	82°56'14"	26.49	S05°05'31"E
C7	47.09	30.00	89°58'35"	42.41	S72°27'47"E
C8	47.07	30.00	89°54'17"	42.39	N17°27'39"E
C9	37.22	30.00	71°04'42"	34.88	S82°05'58"E
C10	47.01	30.00	89°47'10"	42.35	N17°24'05"E
C11	30.17	20.00	88°25'43"	27.39	S89°32'38"E
C12	31.34	20.00	89°46'28"	28.23	N01°26'33"W
C13	22.37	20.00	64°05'41"	21.22	N11°37'23"E
C14	31.50	20.00	90°13'51"	28.34	S88°33'18"W

Number	Northing	Easting	Number	Northing	Easting	Number	Northing	Easting
1	7018015.23	2596102.49	101	7018011.22	2596098.09	200	7018014.09	2596104.95
2	7018014.95	2596102.49	102	7018011.44	2596098.09	201	7018014.21	2596104.95
3	7018014.67	2596102.49	103	7018011.66	2596098.09	202	7018014.43	2596104.95
4	7018014.39	2596102.49	104	7018011.88	2596098.09	203	7018014.65	2596104.95
86	7017991.43	2596102.49	186	7018029.92	2596098.09	285	7018032.69	2596104.95