


DOUPHRA
 & ASSOCIATES, INC.
 ENGINEERING - PROJECT MANAGEMENT - SURVEYING
 22305 RIDGE RD., # 200 ROCKWALL, TEXAS 75087
 PHONE: (972)771-8004 FAX: (972)771-9005


SANITARY SEWER PROFILE
 ROCKWALL CROSSING
 CITY OF ROCKWALL
 ROCKWALL COUNTY, TEXAS

REVISION	
CHECKED	W.L.D.
DRAWN	K.E.B.
DATE	10/15/04
PROJECT	0242
	16A OF 21


LINE : "WW"

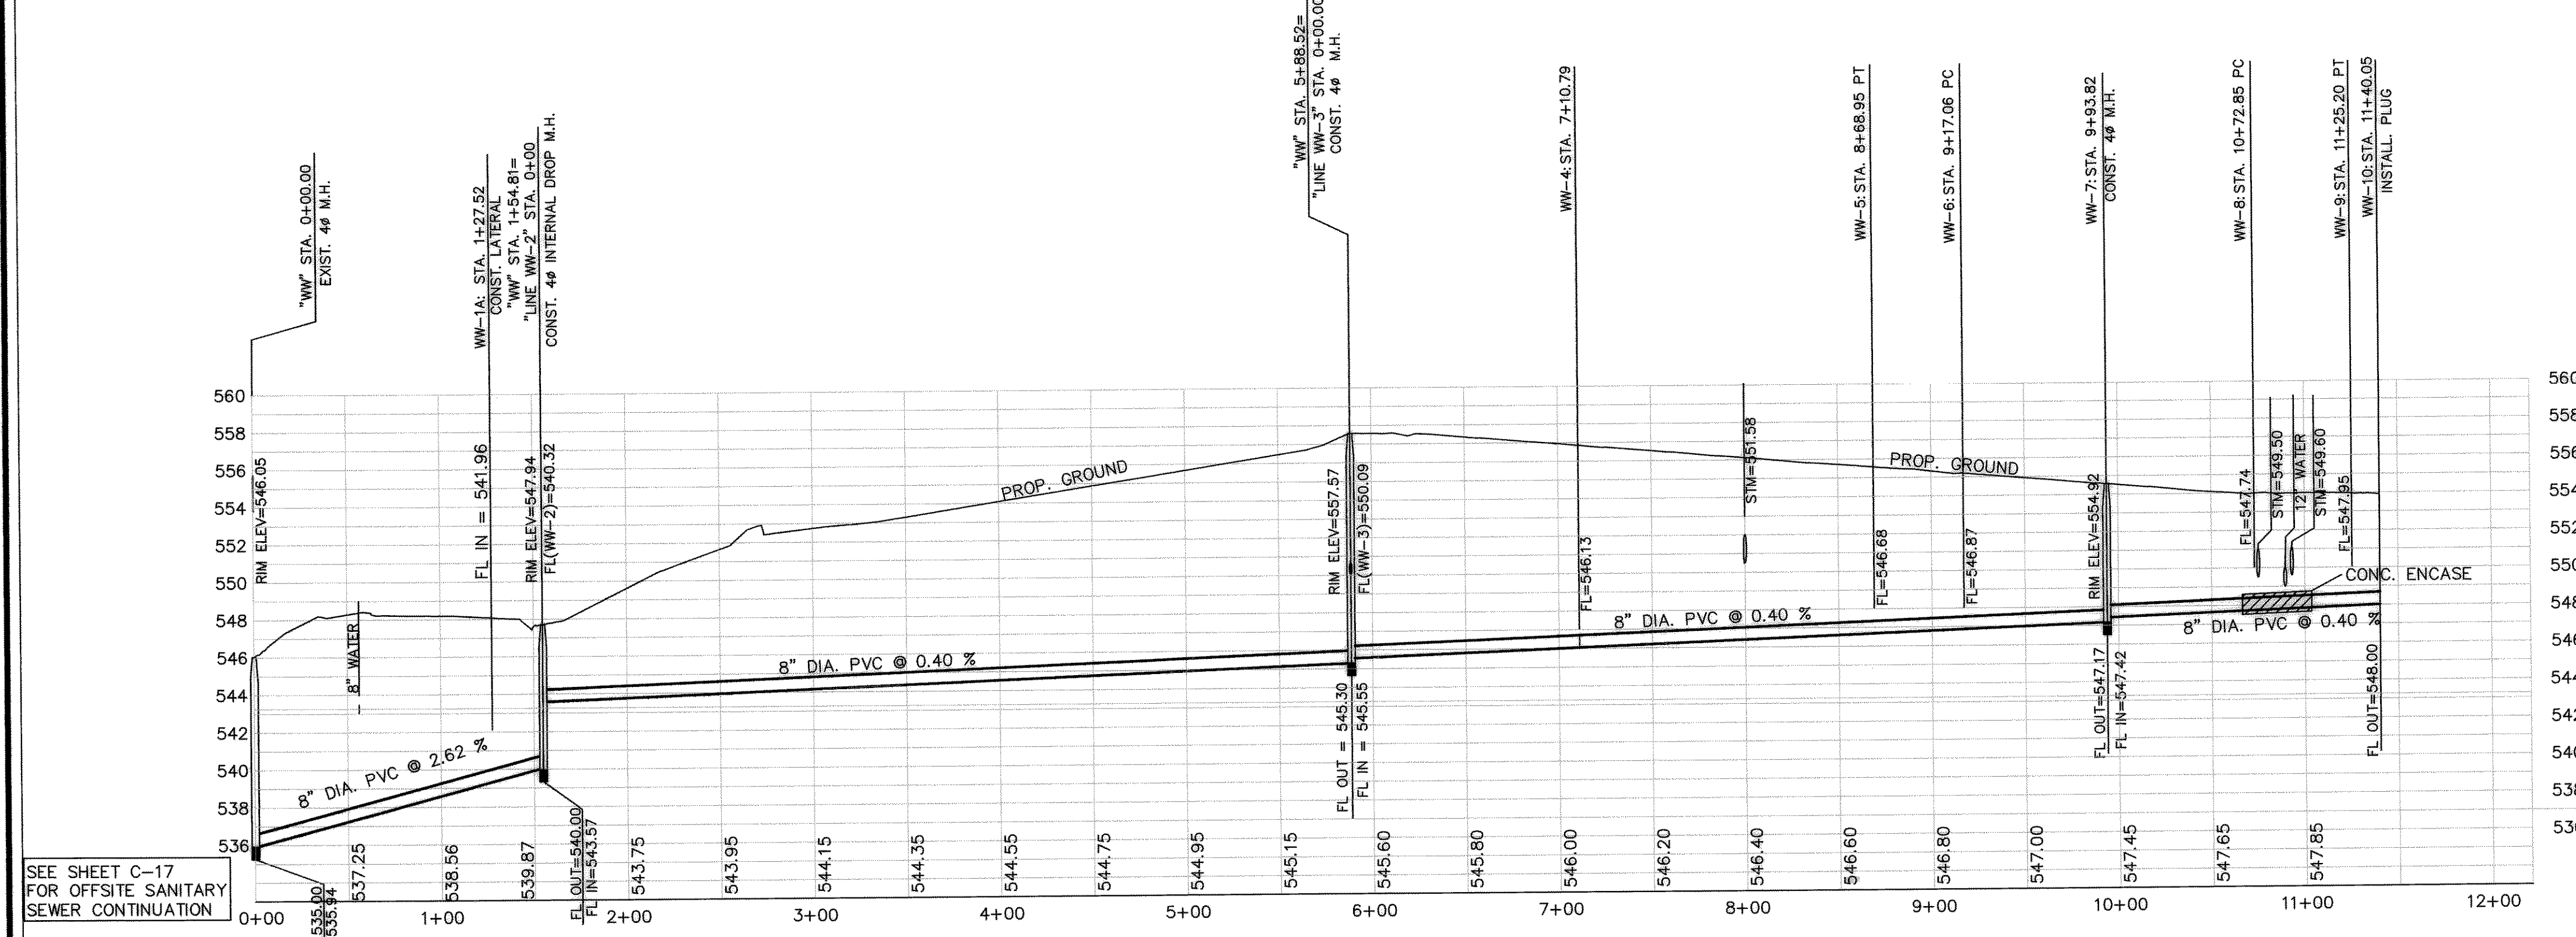


LINE : "WW-3"

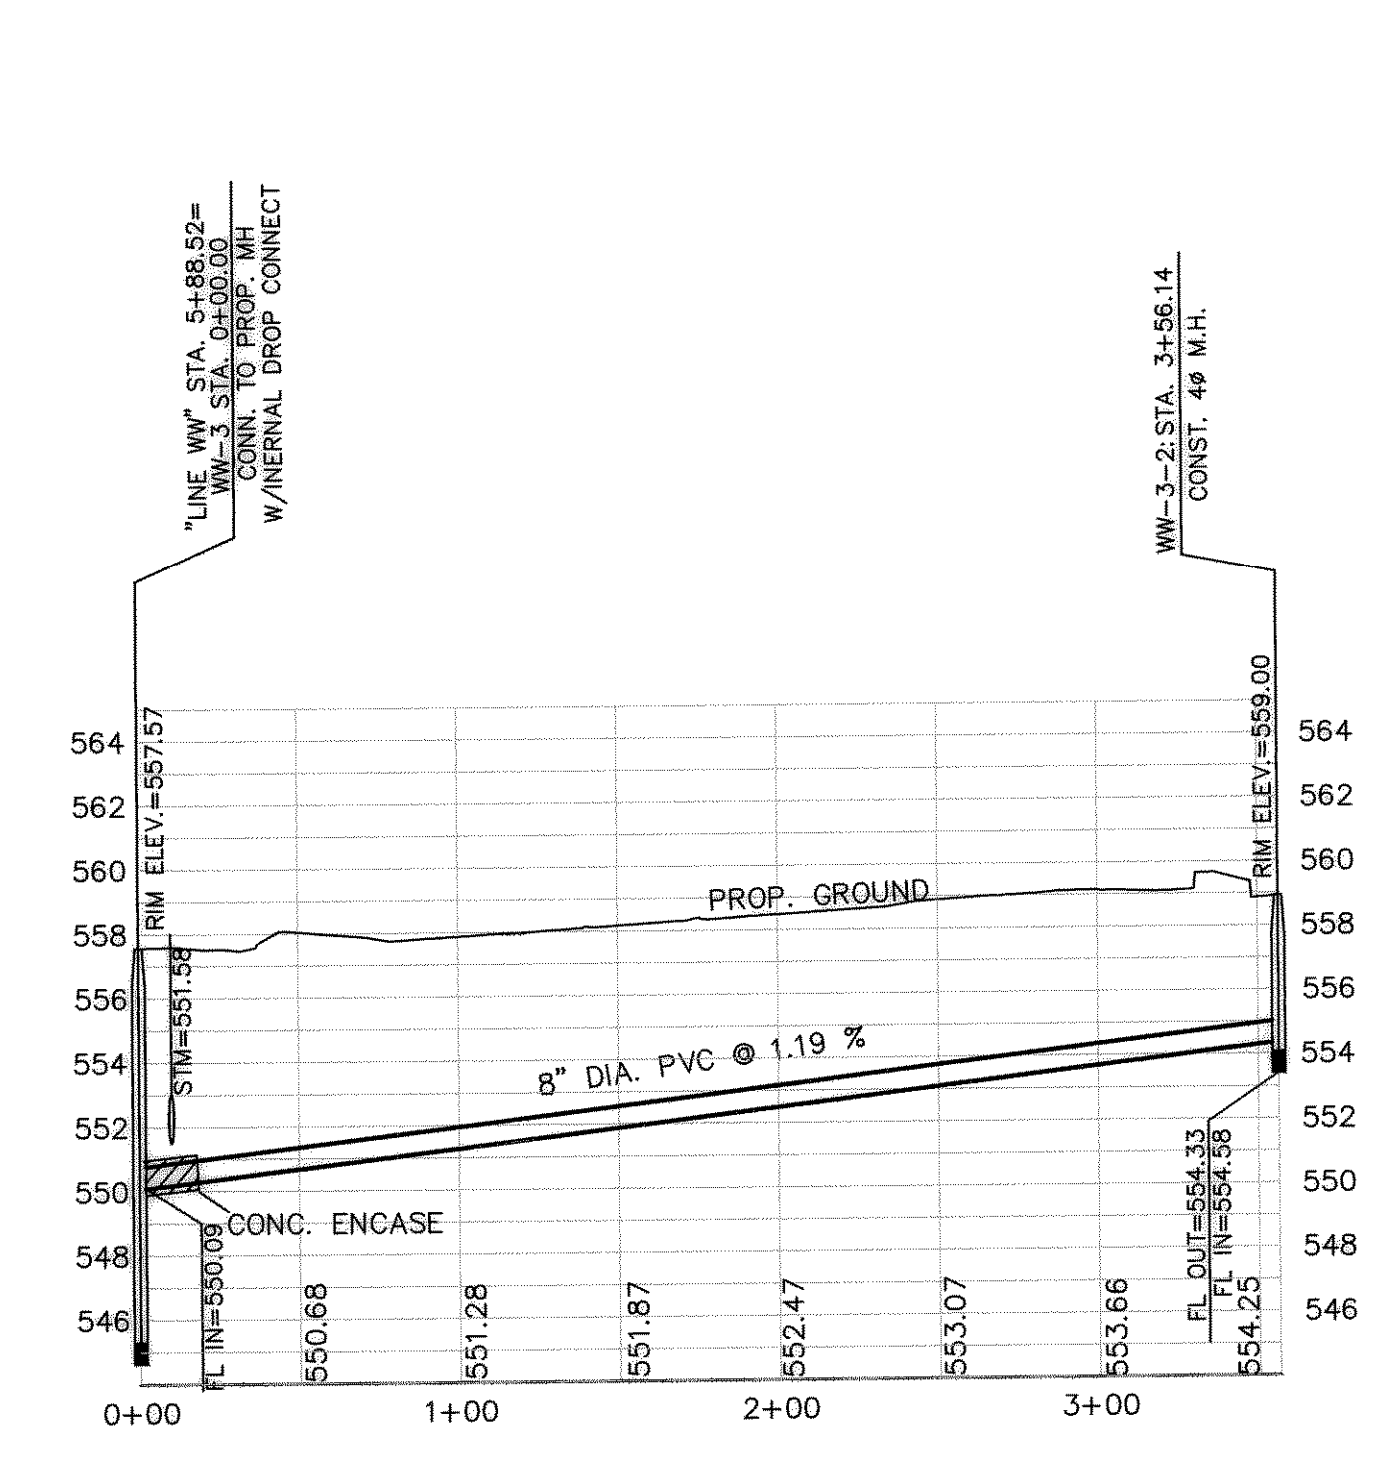


LINE : "WW-1"

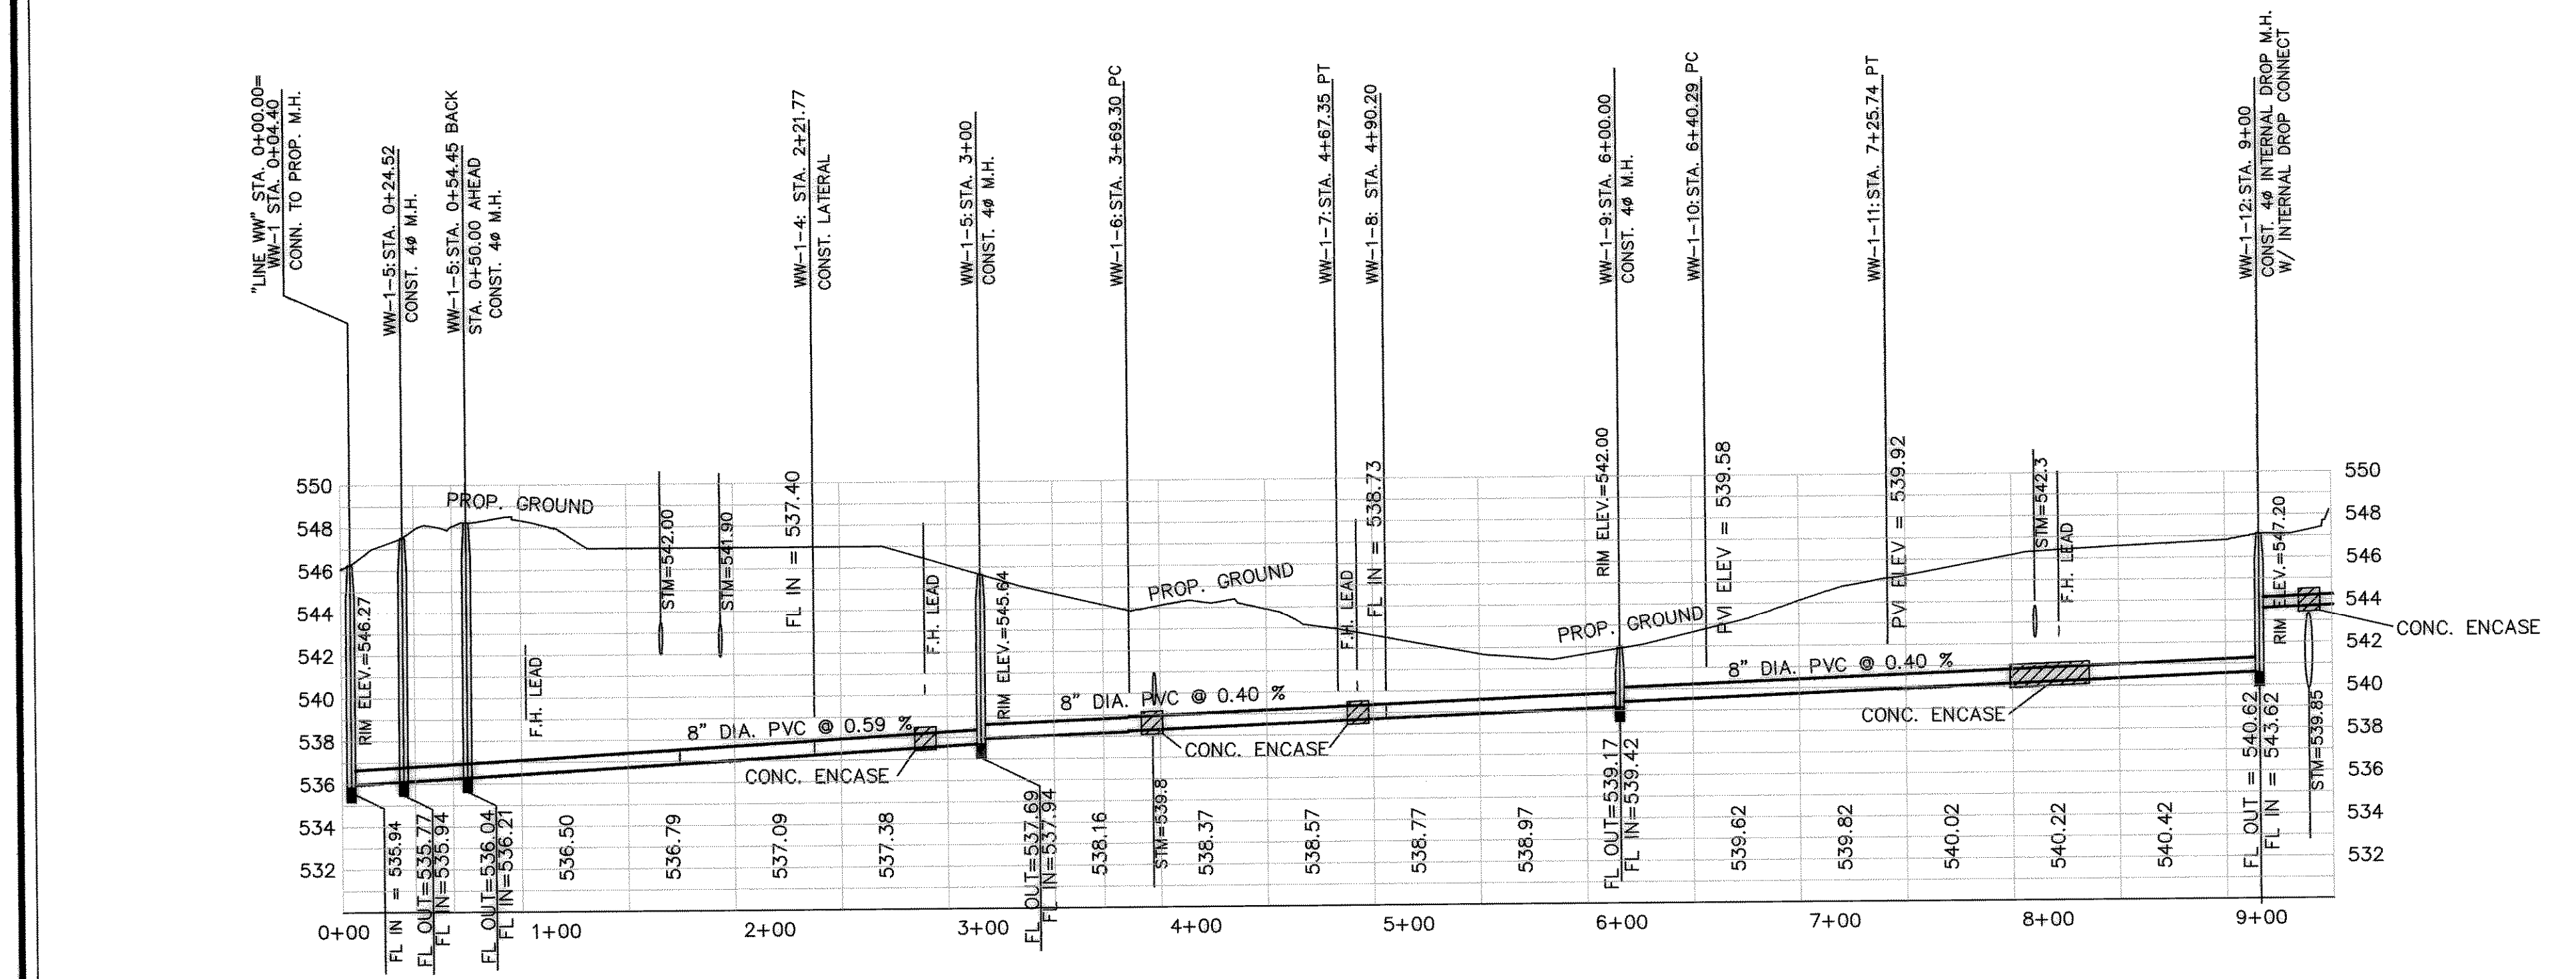

LINE : "WW-2"

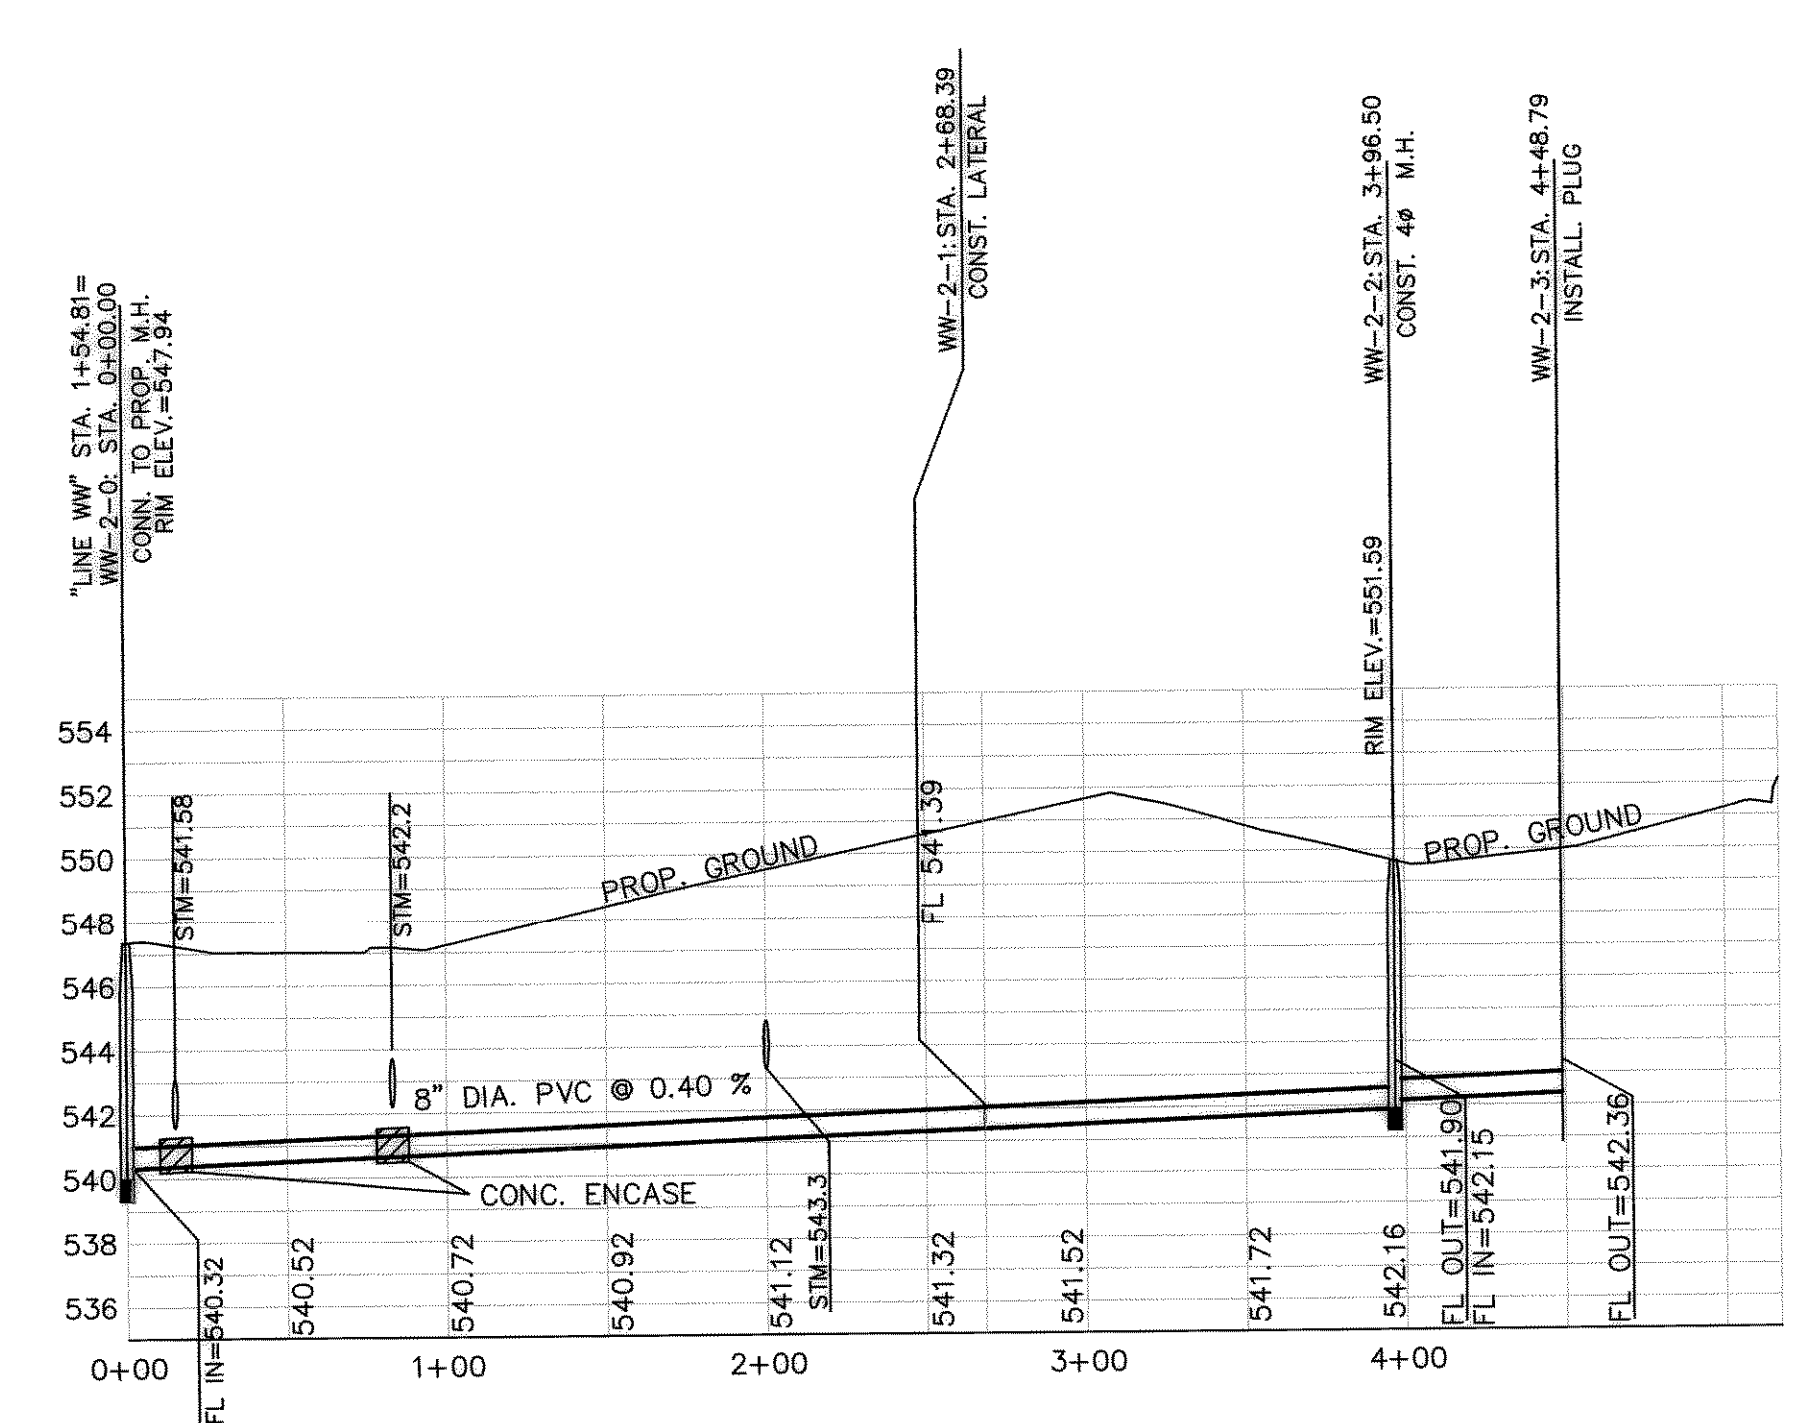

LEGEND

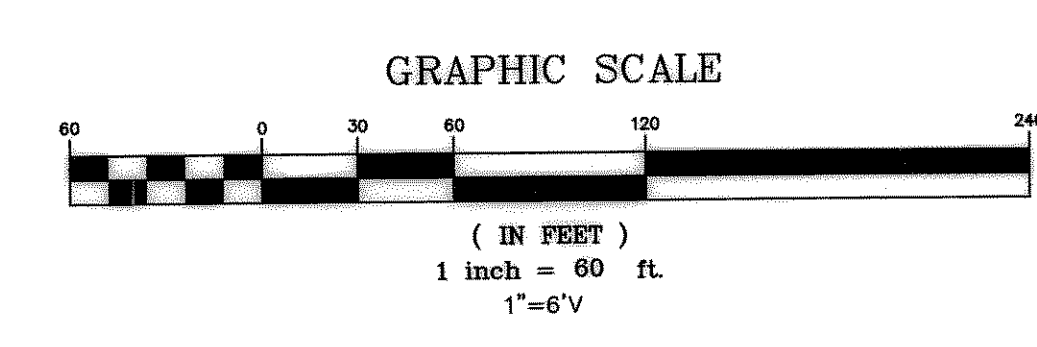

REVISED TO CONFORM TO CONSTRUCTION RECORDS.
 DATE: 5/2/04

SEE SHEET C-17 FOR OFFSITE SANITARY SEWER CONTINUATION