
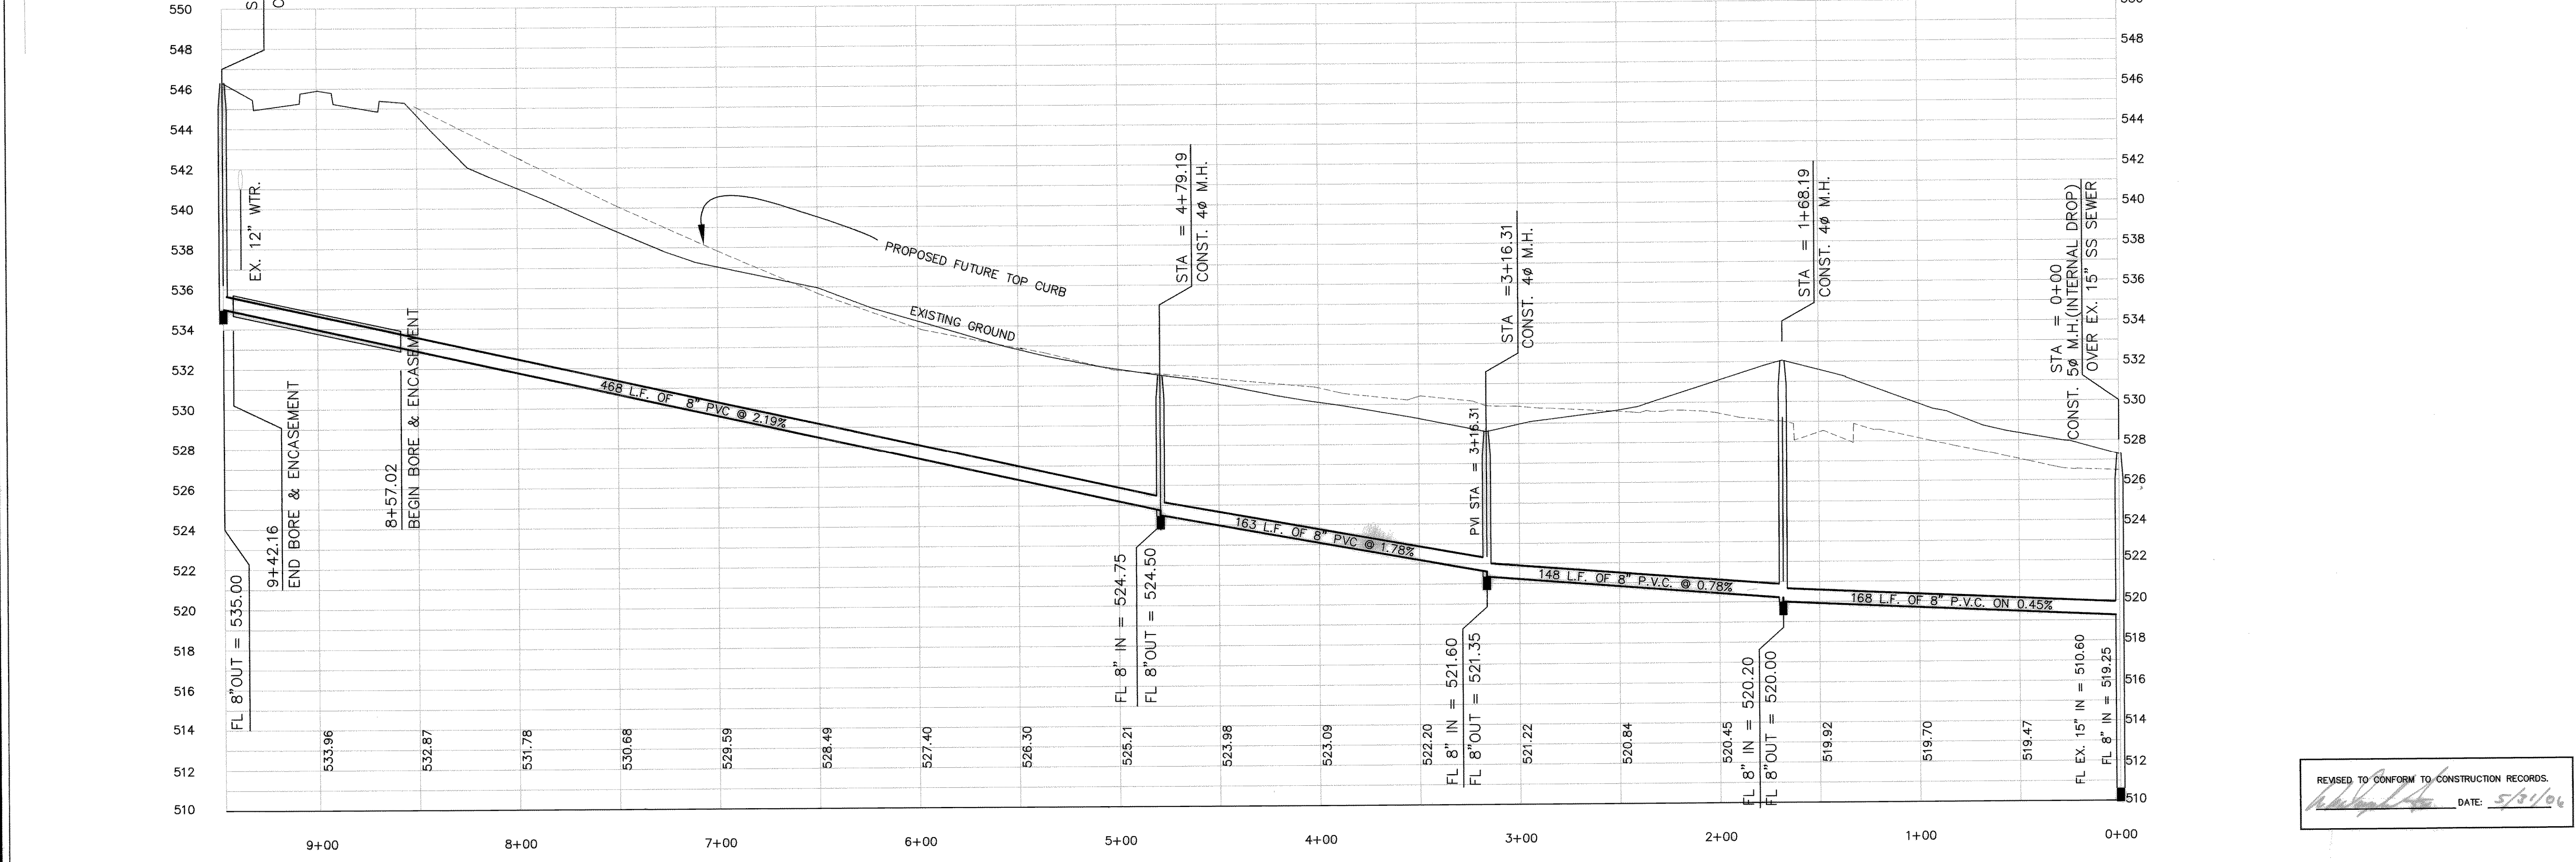


**DOUPHRADE & ASSOCIATES, INC.**  
 ENGINEERING • PROJECT MANAGEMENT • SURVEYING  
 2286 RIDGE RD., # 200 ROCKWALL, TEXAS 75087  
 PHONE: (972)771-9004 FAX: (972)771-9005

**OFFSITE SANITARY SEWER PLAN & PROFILE**  
**ROCKWALL CROSSING**  
 CITY OF ROCKWALL  
 ROCKWALL COUNTY, TEXAS

REVISION
W.L.D.
CHECKED
KEB.
DRAWN
10/15/04
DATE
0242OFFSITES
PROJECT
17
OF
21

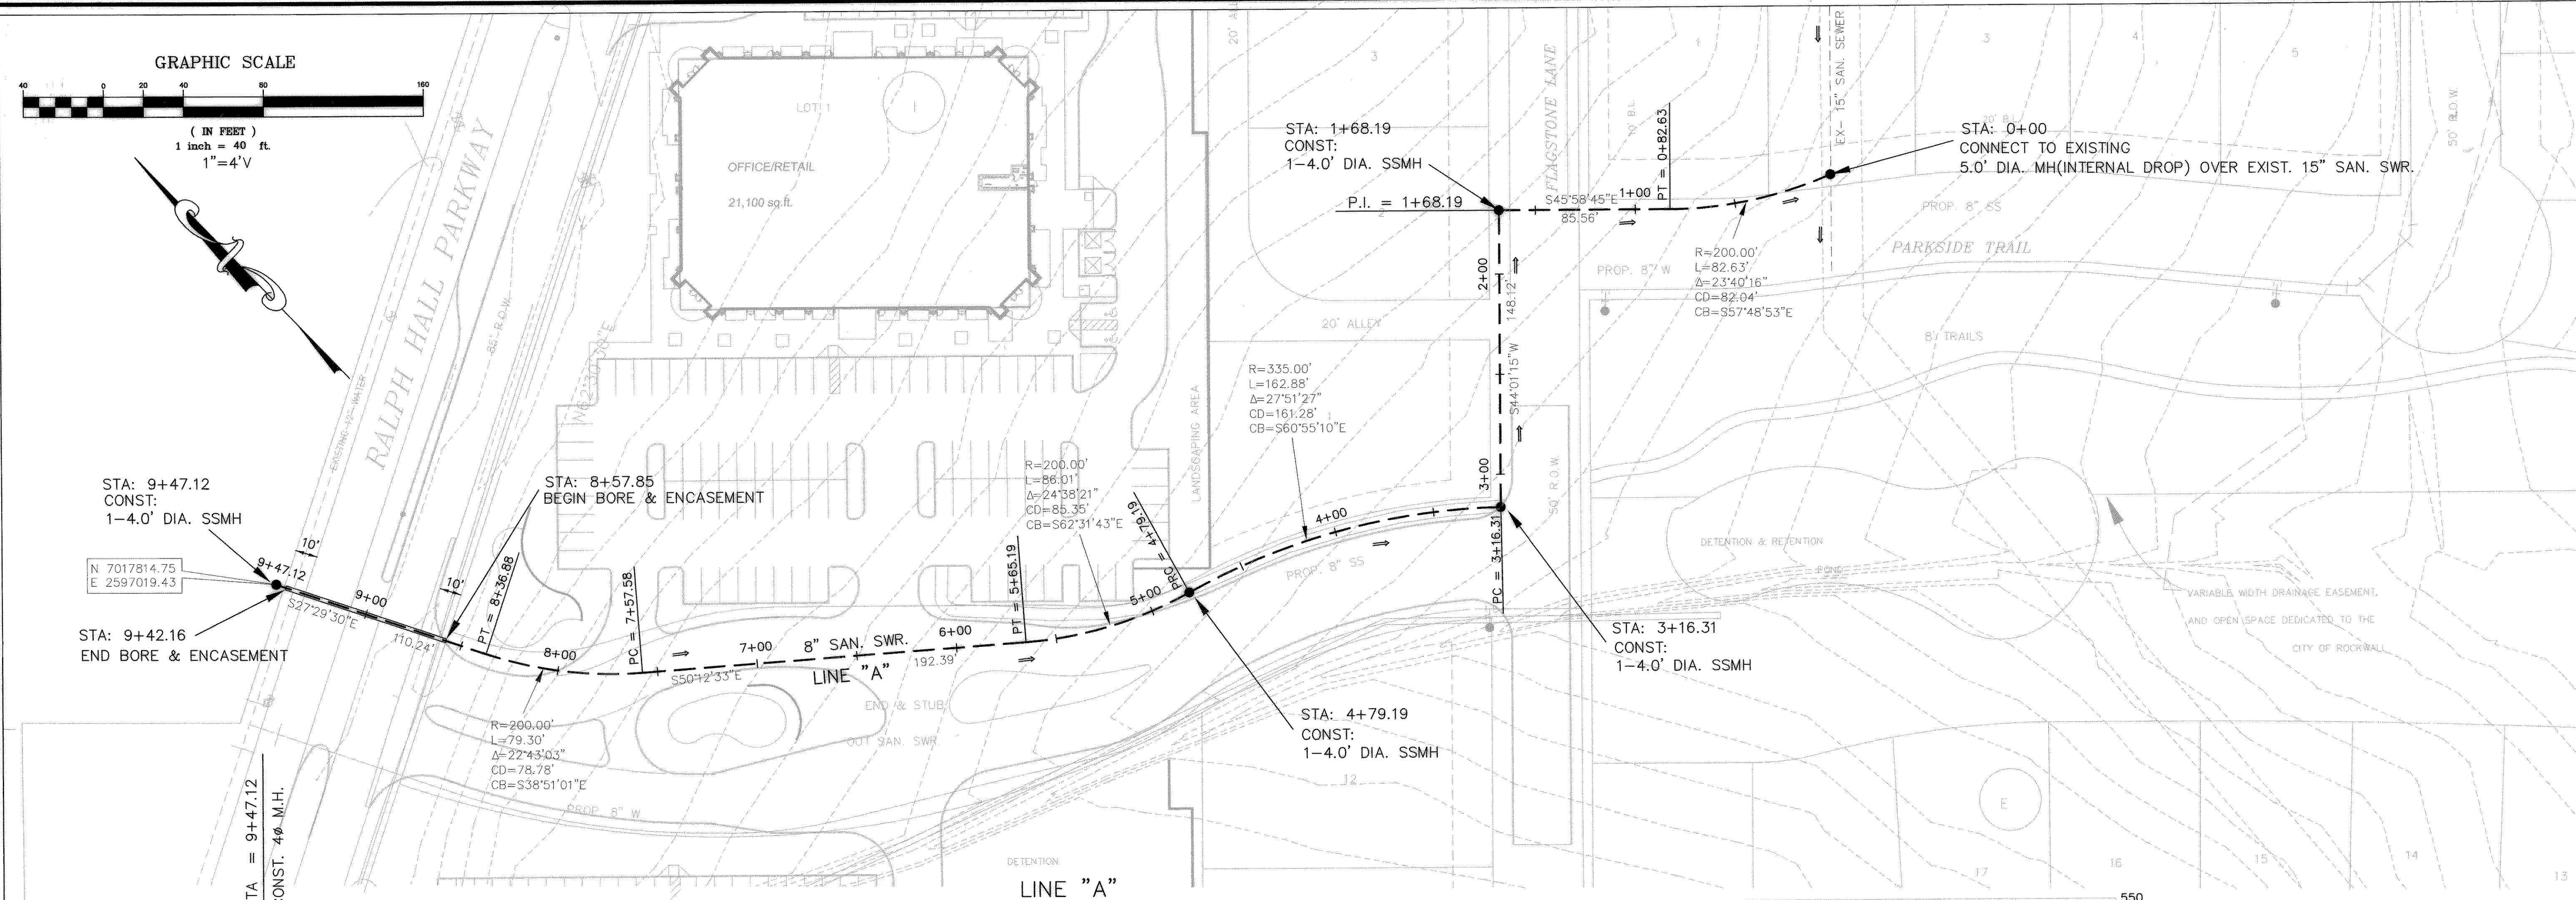

REVISED TO CONFORM TO CONSTRUCTION RECORDS.  
 DATE: 5/21/06