


**GENERAL NOTES:**  
REFER TO KEYED NOTES FOR SPECIFIC PLAN INFORMATION

1. NEW WATER LINES SHALL BE CLASS 200 MIN. PVC.
2. ALL WATER LINES & SEWER LINES SHALL HAVE A MINIMUM OF 10' LATERALLY.
3. ALL FIRE HYDRANTS SHALL FACE FIRE LANE.
4. UNDERGROUND FIRE SERVICE SHALL HAVE 10' SEPARATION FROM ADJACENT UTILITIES AND SHALL BE INSTALLED IN ITS OWN TRENCH.
5.
  - 6 — NEW WATER LINE
  - EXG 8" — EXISTING WATER LINE
  - F — NEW FIRE SERVICE
  - ◆ NEW FIRE HYDRANT
  - ⊕ NEW CUT-OFF VALVE
6. INSTALLATION OF ALL WATER UTILITIES AND APPURTENANCES SHALL BE PER CITY OF ROCKWALL STANDARDS.
7. ALL FIRE HYDRANTS SHALL HAVE 5'-0" CLEARANCE IN ALL DIRECTIONS (INCLUDING BOLLARDS).
8. ALL WATER SERVICES SHALL HAVE APPROVED BACKFLOW PREVENTERS.

- NOTES:**  
KEYED NOTES DESIGNATED BY: ○
1. INDICATES AREA OF WATER LINE MODIFICATIONS.
  2. WHERE UNDERGROUND UTILITY WORK REQUIRES REMOVAL OF CONCRETE FIRE LANE CONTRACTOR SHALL REMOVE ENTIRE CONCRETE PANEL AND REPLACE WITH 6" 3600 PSI CONCRETE.

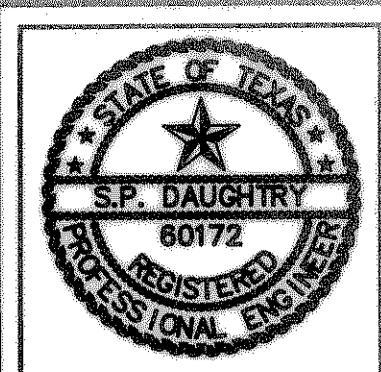

RECORD DRAWINGS  
02-28-07  
*S.P. Daughtry*

**CE ASSOCIATES**  
STRUCTURAL · MECHANICAL · ELECTRICAL  
2505 W. 74TH ST., SUITE 200  
LURBOCK, TX 79423  
TEL: (806) 745-1225  
FAX: (806) 745-1225

**Architectural Resources**  
2525 74TH ST., SUITE 200  
LURBOCK, TX 79423  
TEL: (806) 745-1103  
FAX: (806) 745-1225

**ADDITIONS TO ROCKWALL CHRYSLER JEEP DODGE DEALERSHIP**

PROJECT NO. P06-0105  
DATE: 2/26/2007  
DRAWN BY: SPD CHK BY: SPD  
REVISIONS: 05/16/06

SHEET NO.  
**2.3**  
OF 39

