


GENERAL NOTES:
REFER TO KEYED NOTES FOR SPECIFIC PLAN INFORMATION

1. NEW WATER LINES SHALL BE CLASS 200 MIN. PVC.
2. ALL WATER LINES & SEWER LINES SHALL HAVE A MINIMUM OF 10' LATERALLY.
3. ALL FIRE HYDRANTS SHALL FACE FIRE LANE.
4. UNDERGROUND FIRE SERVICE SHALL HAVE 10' SEPARATION FROM ADJACENT UTILITIES AND SHALL BE INSTALLED IN ITS OWN TRENCH.
5.
 - 6 — NEW WATER LINE
 - EXG 8" — EXISTING WATER LINE
 - F — NEW FIRE SERVICE
 - ◆ NEW FIRE HYDRANT
 - ⊕ NEW CUT-OFF VALVE
6. INSTALLATION OF ALL WATER UTILITIES AND APPURTENANCES SHALL BE PER CITY OF ROCKWALL STANDARDS.
7. ALL FIRE HYDRANTS SHALL HAVE 5'-0" CLEARANCE IN ALL DIRECTIONS (INCLUDING BOLLARDS).
8. ALL WATER SERVICES SHALL HAVE APPROVED BACKFLOW PREVENTERS.

- NOTES:**
KEYED NOTES DESIGNATED BY: ○
1. INDICATES AREA OF WATER LINE MODIFICATIONS.
 2. WHERE UNDERGROUND UTILITY WORK REQUIRES REMOVAL OF CONCRETE FIRE LANE CONTRACTOR SHALL REMOVE ENTIRE CONCRETE PANEL AND REPLACE WITH 6" 3600 PSI CONCRETE.

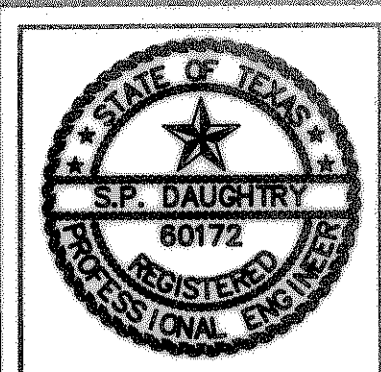

RECORD DRAWINGS
02-28-07
S.P. Daughtry

CE ASSOCIATES
STRUCTURAL · MECHANICAL · ELECTRICAL
2505 W. 74TH ST., SUITE 200
LURBOCK, TX 79423
TEL: (806) 745-1103
FAX: (806) 745-1225

Architectural Resources
2525 74TH ST., SUITE 200
LURBOCK, TX 79423
TEL: (806) 745-1103
FAX: (806) 745-1225

ADDITIONS TO ROCKWALL CHRYSLER JEEP DODGE DEALERSHIP

PROJECT NO. P06-0105
DATE: 2/26/2007
DRAWN BY: SPD CHK BY: SPD
REVISIONS: 05/16/06

SHEET NO.
2.3
OF 39



SITE UTILITY PLAN