


# DEVELOPMENT PLANS FOR ROCKWALL DOWNES PHASE 1

CITY OF ROCKWALL, TEXAS

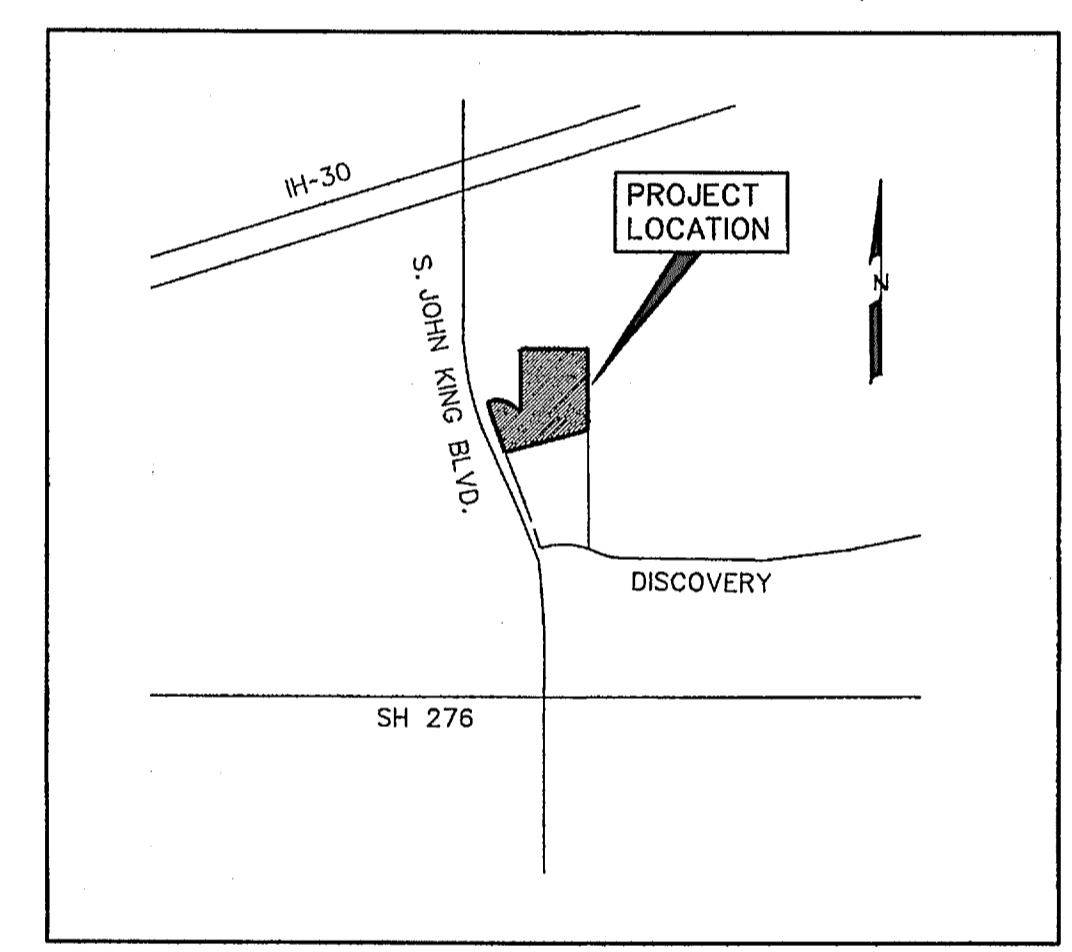

VICINITY MAP  
NOT TO SCALE

PREPARED FOR  
ROCKWALL DOWNES DEVELOPMENT, LLC.

8750 NORTH CENTRAL EXPRESSWAY, SUITE 1735, DALLAS, TEXAS 75231

CORWIN ENGINEERING, INC. — CONSULTING ENGINEERS

200 W. BELMONT, SUITE E

TBPE FIRM #5951

ALLEN, TEXAS 75013

## INDEX

1	TITLE
2	PLAT
3	DRAINAGE AREA MAP
4	PREAKNESS DRIVE
5	MIDDLEGROUND DRIVE, PILLORY DRIVE
6	LEFT TURN LANE S. JOHN KING BLVD.
7	WATER AND SANITARY SEWER PLAN
8	SANITARY SEWER PROFILES
9	12" WATERLINE
10	12" WATERLINE
11	12" WATERLINE
12	STORM SEWER PLAN AND PROFILE LINES 'D-1' & 'D-3'
13	STORM SEWER PLAN AND PROFILE LINE 'D-2'
14	DETENTION POND DRAINAGE AREA MAP
15	DETENTION POND PLAN
16	GRADING PLAN
17	EROSION CONTROL PLAN
1 of 1	STREET SIGN AND LIGHT PLAN
<u>LANDSCAPE PLANS</u>	
TS1	TREE SURVEY & MITIGATION PLAN
L1	OPEN SPACE LANDSCAPE PLAN
L2	OPEN SPACE LANDSCAPE PLAN
SP1	OPEN SPACE SITE PLAN
SP2	OPEN SPACE SITE PLAN
SP3	SITE PLAN DETAILS

NOTE:  
CITY OF ROCKWALL STANDARDS  
AND NCTCOG 3rd ADDITION STANDARDS  
SHALL BE USED FOR REFERENCE.


AS-BUILT JULY 2015  
INFORMATION PROVIDED  
BY CONTRACTORS  
(NOT FIELD VERIFIED)



The seal appearing on  
this document was  
authorized by  
Brandon Davidson  
P.E. 87682, on  
September 26, 2014

NO.	REVISIONS	BY	DATE

SEPTEMBER 2014

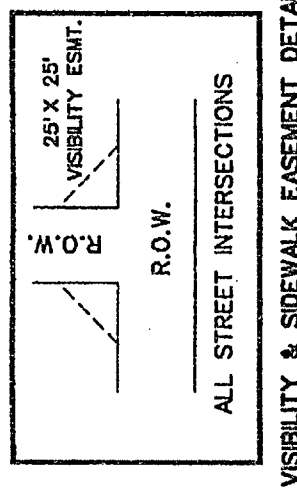

VISIBILITY & SIDEWALK EASEMENT DETAIL  
N.T.S.

$\Delta = 18^{\circ}39'41''$   
 $R = 1890.00'$   
 $T = 310.54'$   
 $L = 615.58'$   
 $C = 612.86'$   
 $B = N11^{\circ}19'40''W$

LINE NO.	BEARING	DISTANCE
1.	N 74°30'05" E	37.37'
2.	S 39°01'57" W	43.42'
3.	S 45°24'35" E	28.38'
4.	N 89°46'54" W	204.99'
5.	N 00°13'26" W	95.13'
6.	S 89°24'13" W	50.00'
7.	S 00°35'47" E	39.68'
8.	N 55°07'28" W	79.24'
9.	N 55°07'28" W	79.24'
10.	N 56°04'48" E	12.59'
11.	S 50°58'03" W	29.34'
12.	S 50°45'45" E	51.62'
13.	S 59°45'45" E	51.62'
14.	S 45°35'47" E	14.14'
15.	S 45°35'47" E	14.14'
16.	S 39°01'57" E	37.62'

NOTES  
1. Bearing are referenced to Stone Creek Phase I (Vol. C, Pg. 359-365).

2. All lot lines are radial or perpendicular to the street unless otherwise noted by bearing.


3. 1/2" fire roads with ROCKWALL ENGR. INC. caps set at all boundary corners, block corners, points of curvature, drains, easements and public places shown on the purpose and consideration herein.

4. All open spaces, drainage areas and other common areas shall be maintained by the Homeowners Association.

5. All open spaces, drainage areas and other common areas shall be maintained by the Homeowners Association.


CURVE TABLE

CURVE NO.	DELTA	RADIUS	LENGTH	TANGENT	CHORD	BEARING
1.	50°42'18"	153.50'	136.10'	72.73'	131.69'	S80°11'40"E
2.	74°14'20"	150.00'	194.36'	113.52'	181.04'	N88°05'13"E
3.	74°14'19"	175.00'	226.75'	132.44'	211.22'	N88°05'13"E
4.	38°26'10"	100.00'	50.31'	26.14'	49.37'	N19°48'52"W
5.	51°33'50"	100.00'	50.00'	48.30'	86.99'	N25°11'08"E
6.	141°18'40"	50.00'	123.32'	94.35'	94.35'	N45°24'56"W
7.	142°03'23"	50.00'	123.32'	94.35'	94.35'	N45°24'56"W
8.	62°04'54"	285.00'	506.78'	171.50'	253.90'	N82°00'20"E

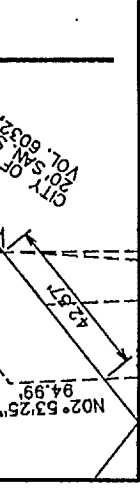

INSET 'A'  
SCALE: 1"=50'

TOTAL LOTS 34  
TOTAL ACRES 15.135

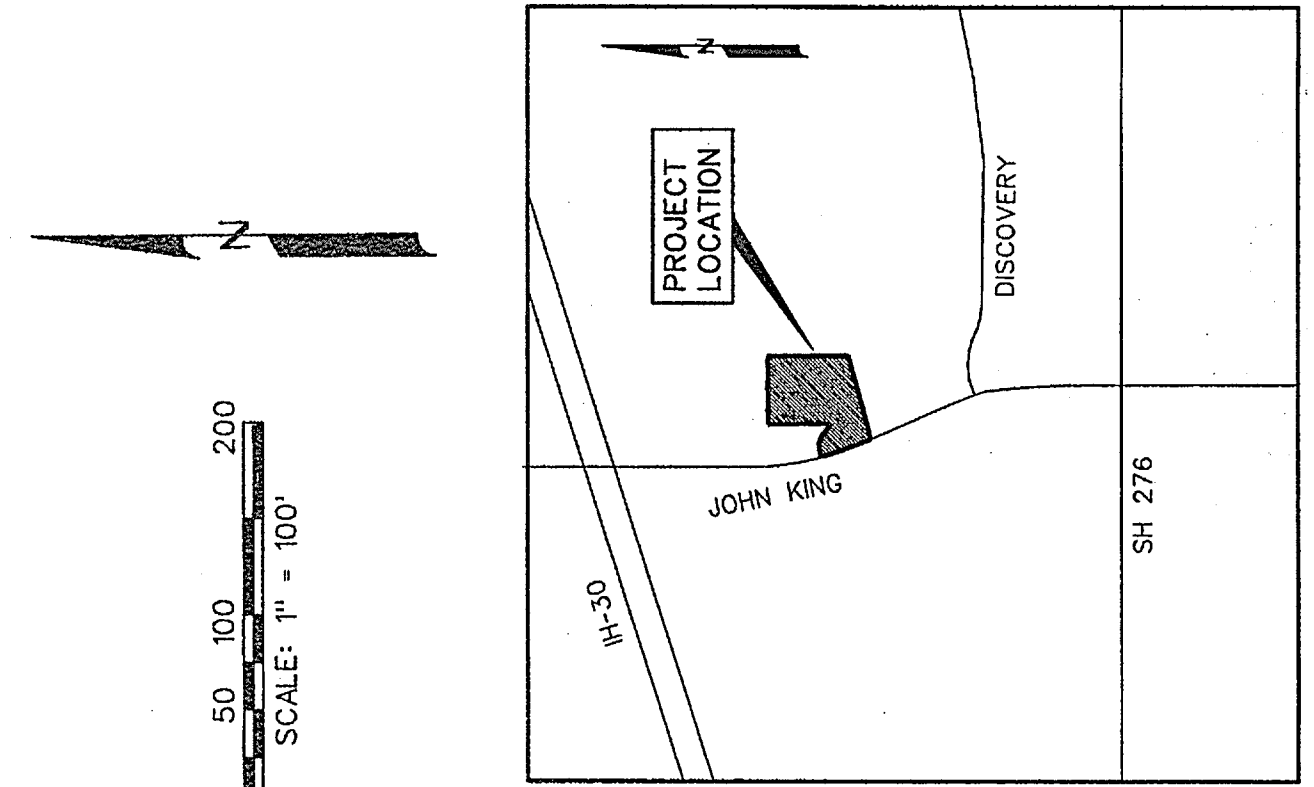

LOCATION MAP  
N.T.S.

FINAL PLAT  
OF  
**ROCKWALL DOWNS  
PHASE 1**  
OUT OF THE

J.M ALLEN SURVEY, ABSTRACT NO. 2  
IN THE  
CITY OF ROCKWALL  
ROCKWALL COUNTY, TEXAS  
OWNER  
ROCKWALL DOWNS DEVELOPMENT, LLC.  
8750 NORTH CENTRAL EXPRESSWAY, SUITE 1735  
DALLAS, TEXAS 75231  
214-691-2556

PREPARED BY  
**CORWIN ENGINEERING, INC.**  
200 W. BELMONT, SUITE E  
ALLEN, TEXAS 75015  
972-366-1200

JANUARY 2014  
SCALE 1" = 100'  
CASE#P2014-XXX SHEET 1 OF 2

OWNERS CERTIFICATE

NOW, THEREFORE, KNOW ALL MEN BY THESE PRESENTS: STATE OF TEXAS COUNTY OF ROCKWALL, Texas, do hereby certify that the plat shown hereon accurately represents the results of a survey conducted by the City of Rockwall, Texas, and being more particularly described as follows: BEGINNING, at a 1/2 inch iron rod found at the southwest corner of Lafon Subdivision, an addition to the City of Rockwall, as described in Cds. B, Pg. 42, in the Plat Records of Rockwall County, Texas, and being in the north line of said Cambridge Company, Inc. tract;

THENCE, North 89°49'34" East, along south line of said Lafon Subdivision and the north line of said Cambridge Company, Inc. tract, for a distance of 666.87 feet, to a 1/2 inch iron rod set at the northeast corner of said Cambridge Company, Inc. tract;

THENCE, South 00°35'47" East, departing said south line and along the east line of said Cambridge Company, Inc. tract, for a distance of 678.27 feet, to a 1/2 inch iron rod set with a yellow cap stamped Corwin Eng. Inc.;

THENCE, South 74°50'31" West, departing said east line, for a distance of 734.88 feet, to a 1/2 inch iron rod set with a yellow cap stamped Corwin Eng. Inc., being in the east line of John King Boulevard;

THENCE, North 20°39'31" West, along the east line of said John King Boulevard, for a distance of 243.49 feet, to a 1/2 inch iron rod set with a yellow cap stamped Corwin Eng. Inc. at the point of curvature of a curve to the right, having a radius of 1890.00 feet, a central angle of 18°39'41", and a tangent of 310.54 feet;

THENCE, continuing along said east line and with said curve, to the right for an arc distance of 615.58 feet (Chord Bearing North 11°19'40" West - 612.86 feet), to a 1/2 inch iron rod set with a yellow cap stamped Corwin Eng. Inc.;

THENCE, North 44°03'38" East, departing said east line, for a distance of 20.88 feet to a 1/2 inch iron rod set with a yellow cap stamped Corwin Eng. Inc.;

THENCE, North 89°50'54" East, for a distance of 42.58 feet, to a 1/2 inch iron rod set with a yellow cap stamped Corwin Eng. Inc.;

THENCE, North 73°37'49" East, for a distance of 83.87 feet, to a 1/2 inch iron rod set with a yellow cap stamped Corwin Eng. Inc.;

THENCE, North 89°50'54" East, for a distance of 102.10 feet, to the POINT OF BEGINNING and containing 15.135 acres of land.

LEGAL DESCRIPTION

WHEREAS, CAMBRIDGE COMPANY, INC., is the owner of a tract of land situated in the J.M. Allen Survey, Abstract No. 2 in the City of Rockwall, Rockwall County, Texas, being part of a tract of land as described in deed to Cambridge Company, Inc., in Volume 89, Page 1022 in the Deed Records of Rockwall County, Texas, and being more particularly described as follows: BEGINNING, at a 1/2 inch iron rod found at the southwest corner of Lafon Subdivision, an addition to the City of Rockwall, as described in Cds. B, Pg. 42, in the Plat Records of Rockwall County, Texas, and being in the north line of said Cambridge Company, Inc. tract;

THENCE, North 89°49'34" East, along south line of said Lafon Subdivision and the north line of said Cambridge Company, Inc. tract, for a distance of 666.87 feet, to a 1/2 inch iron rod set at the northeast corner of said Cambridge Company, Inc. tract;

THENCE, South 00°35'47" East, departing said south line and along the east line of said Cambridge Company, Inc. tract, for a distance of 678.27 feet, to a 1/2 inch iron rod set with a yellow cap stamped Corwin Eng. Inc.;

THENCE, South 74°50'31" West, departing said east line, for a distance of 734.88 feet, to a 1/2 inch iron rod set with a yellow cap stamped Corwin Eng. Inc., being in the east line of John King Boulevard;

THENCE, North 20°39'31" West, along the east line of said John King Boulevard, for a distance of 243.49 feet, to a 1/2 inch iron rod set with a yellow cap stamped Corwin Eng. Inc. at the point of curvature of a curve to the right, having a radius of 1890.00 feet, a central angle of 18°39'41", and a tangent of 310.54 feet;

THENCE, continuing along said east line and with said curve, to the right for an arc distance of 615.58 feet (Chord Bearing North 11°19'40" West - 612.86 feet), to a 1/2 inch iron rod set with a yellow cap stamped Corwin Eng. Inc.;

THENCE, North 44°03'38" East, departing said east line, for a distance of 20.88 feet to a 1/2 inch iron rod set with a yellow cap stamped Corwin Eng. Inc.;

THENCE, North 89°50'54" East, for a distance of 42.58 feet, to a 1/2 inch iron rod set with a yellow cap stamped Corwin Eng. Inc.;

THENCE, North 73°37'49" East, for a distance of 83.87 feet, to a 1/2 inch iron rod set with a yellow cap stamped Corwin Eng. Inc.;

THENCE, North 89°50'54" East, for a distance of 102.10 feet, to the POINT OF BEGINNING and containing 15.135 acres of land.

Recommended for Final Approval:

Planning & Zoning Commission

Date

APPROVED

I hereby certify that the above and foregoing plat of an addition to the City of Rockwall, Texas, was approved by the City Council of the City of Rockwall on the \_\_\_\_\_ day of \_\_\_\_\_, 2014.

This approval shall be invalid unless the approved plat for such addition is recorded in the office of the County Clerk of Rockwall, County, Texas, within one hundred eighty (180) days from said date of final approval.

WITNESS OUR HANDS, this \_\_\_\_\_ day of \_\_\_\_\_, 2014.

Mayor, City of Rockwall

City Secretary

City Engineer

SURVEYOR CERTIFICATE

I, WARREN L. CORWIN, do hereby certify that the plat shown hereon accurately represents the results of an on-the-ground survey made under my direction and supervision and all corners are as shown thereon and there are no encroachments, conflicts, protrusions or visible utilities on the ground except as shown and said plat has been prepared in accordance with the plotting rules and regulations of the City Plan Commission of the City of Rockwall, Texas.

DATED the this \_\_\_\_\_ day of \_\_\_\_\_, 2014.

WARREN L. CORWIN  
R.P.L.S. No. 4621

THE STATE OF TEXAS  
COUNTY OF COLLIN

BEFORE ME, the undersigned, a Notary Public in and for the State of Texas, on this \_\_\_\_\_ day of \_\_\_\_\_, 2014, personally appeared WARREN L. CORWIN, who is known to me to be the person whose name is subscribed to the foregoing instrument, and acknowledged to me that he executed the same for the purpose and consideration therein stated and for the purposes and considerations therein expressed.

WITNESS MY HAND AND SEAL OF OFFICE, this the \_\_\_\_\_ day of \_\_\_\_\_, 2014.

Notary Public in and for the State of Texas

RockwallDownes Development, LLC.

Mortgage or Lien Interest

STATE OF TEXAS COUNTY OF DALLAS

Before me, the undersigned authority, on this \_\_\_\_\_ day of \_\_\_\_\_, 2014, personally appeared \_\_\_\_\_, known to me to be the person whose name is subscribed to the foregoing instrument, and acknowledged to me that he executed the same for the purpose and consideration therein stated. Given upon my hand and seal of office this \_\_\_\_\_ day of \_\_\_\_\_, 2014.

Notary Public in and for the State of Texas My Commission Expires: \_\_\_\_\_


NOTE: It shall be the policy of the City of Rockwall to withhold issuing building permits until all conditions of a plat by the City does not constitute any representation, assurance or guarantee that any building within such plat shall be approved, authorized or permit therefore issued, nor shall such approval constitute any representation, assurance or guarantee by the City of the adequacy and conformity for water, for personnel and fire protection within such plat, as required under Ordinance 85-04.

FINAL PLAT  
OF  
**ROCKWALL DOWNS  
PHASE 1**  
OUT OF THE

J.M ALLEN SURVEY, ABSTRACT NO. 2  
IN THE  
CITY OF ROCKWALL  
ROCKWALL COUNTY, TEXAS  
OWNER  
ROCKWALL DOWNS DEVELOPMENT, LLC.  
8750 NORTH CENTRAL EXPRESSWAY, SUITE 1735  
DALLAS, TEXAS 75231  
214-691-2556

PREPARED BY  
**CORWIN ENGINEERING, INC.**  
200 W. BELMONT, SUITE E  
ALLEN, TEXAS 75015  
972-366-1200

JANUARY 2014  
SCALE 1" = 100'  
CASE#P2014-XXX SHEET 1 OF 2

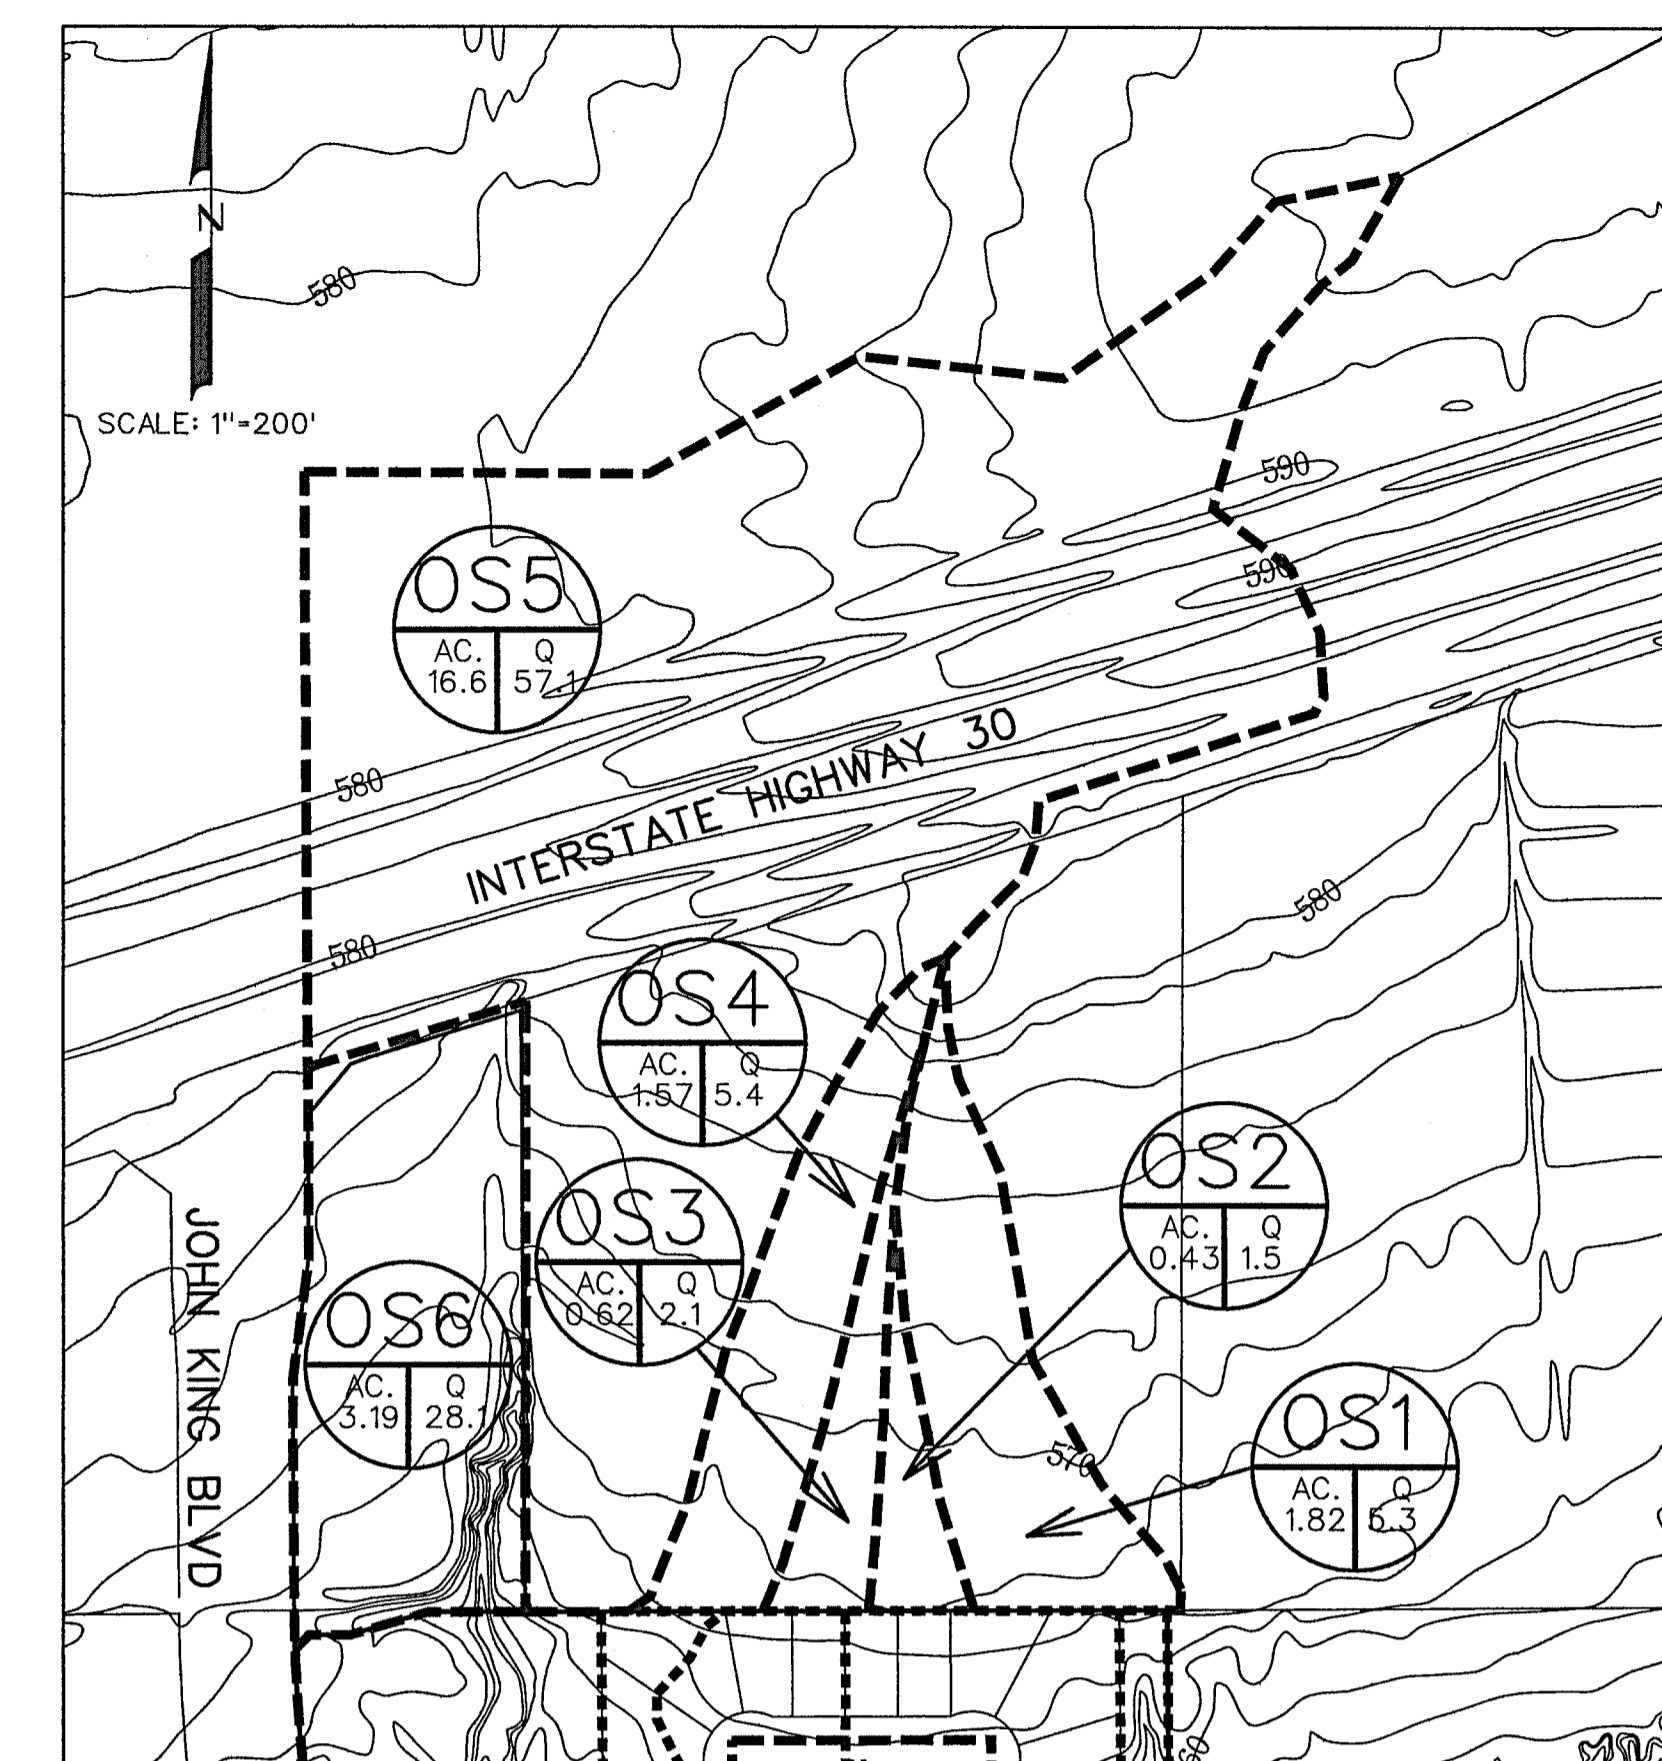

OFFSITE DRAINAGE AREA MAP  
SCALE: 1"=200'

RUNOFF COMPUTATIONS									
#	Area (sf)	Area (acres)	Runoff Coefficient	CA (min)	Tc (min)	Q(100) (cfs)	Q(100) (mgd)	Drains to	
1	34547	0.80	0.50	0.40	10	9.80	3.9	Inlet 1	
2	83504	1.92	0.50	0.96	10	9.80	9.4	Inlet 2	
3	33643	0.77	0.50	0.39	10	9.80	3.8	Inlet 3	
4	46019	1.06	0.50	0.53	10	9.80	5.2	Inlet 4	
5A	32313	0.74	0.50	0.37	10	9.80	3.6	Inlet 5	
5B	7370	0.17	0.35	0.06	20	8.30	0.5	Inlet 5	
6	35523	0.82	0.50	0.41	10	9.80	4.0	Inlet 6	
7	40835	0.94	0.50	0.47	10	9.80	4.6	Creek	
8	125057	2.95	0.35	1.04	10	9.80	10.2	Detention Pond	
9	28493	0.65	0.50	0.33	10	9.80	3.2	Detention Pond	
10	190253	4.37	0.35	1.53	20	8.30	12.7	Creek	
OS1	78223	1.82	0.35	0.64	20	8.30	5.3	Creek	
OS2	18637	0.43	0.35	0.15	10	9.80	1.5	Detention Pond	
OS3	26872	0.62	0.35	0.22	10	9.80	2.1	Detention Pond	
OS4	68344	1.57	0.35	0.56	10	9.80	5.4	Detention Pond	
OS5	72490	1.64	0.35	0.58	10	9.80	5.7	Detention Pond	
OS6	138840	3.19	0.30	2.87	10	9.80	28.1	Detention Pond	

LEGEND

- PROP. STORM SEWER
- PROP. CURB INLETS
- PROP. CONC. HEADWALL
- EXIST. STORM SEWER
- DRAINAGE AREA DIVIDE
- FLOW ARROW
- DRAINAGE AREA NO.

BENCHMARK \*1  
PK NAIL FOUND IN CENTER OF S. JOHN KING BLVD.  
20' ± NORTH OF MEDIAN OPENING NEAR NORTHWEST  
CORNER OF PROPERTY.  
ELEV. -564.12  
N. 7021747.513  
E. 2602779.713

BENCHMARK \*2  
"X" FOUND ON NORTH END OF TOP OF HEADWALL ON  
WEST SIDE OF S. JOHN KING BLVD. AT BUFFALO CREEK.  
ELEV. -550.82  
N. 7020725.306  
E. 2602982.310


AS-BUILT JULY 2015  
INFORMATION PROVIDED  
BY CONTRACTORS  
(NOT FIELD VERIFIED)



The seal appearing on  
this document was  
authorized by  
Brandon Davidson  
P.E. 87682, on  
October 9, 2014

INLET CALCULATIONS

No.	Inlet Location	Design Storm Freq. (years)	Area Runoff: Q=CIA				Carry-Over from Upstream (cfs)	Total Gutter Flow (cfs)	Gutter Capacity (cfs)	Gutter Slope (ft/100 ft)	Crown Type	Length L (ft)	Selected Inlet			
			Tc (min)	"I" (in/hr)	Coeff. "C"	Area "A" (acres)							Q (cfs)	Inlet Capacity (cfs)	Carry-Over to Downstream Inlet (cfs)	
1	6+04.75 Preakness	100	10	9.8	0.5	0.80	3.9	0.0	3.9	20.5	1.84%	6" pbl	10	STD.	6.5	0.0
2	6+04.75 Preakness	100	10	9.8	0.5	1.92	9.4	0.0	9.4	20.5	1.84%	6" pbl	10	STD.	6.5	2.9
3	0+72.53 Middleground	100	10	9.8	0.5	0.77	3.8	0.0	3.8	26.2	3.00%	6" pbl	10	STD.	5.7	0.0
4	0+72.53 Middleground	100	10	9.8	0.5	1.06	5.2	0.0	5.2	26.2	3.00%	6" pbl	10	STD.	5.6	0.0
5	4+00.00 Preakness	100	10	9.8	0.47	0.91	4.2	0.0	4.2	10.7	Low Pt	6" pbl	10	STD.	21.0	0.0
6	4+00.00 Preakness	100	10	9.8	0.5	0.82	4.0	2.9	6.9	10.7	Low Pt	6" pbl	10	STD.	21.0	0.0



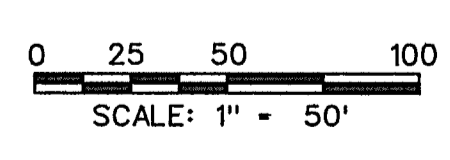


DRAWN BY	DESIGNED BY	CHECKED BY	SHEET NO.
14046	JANUARY 2015	1"=50'	3 OF 17

**CORWIN ENGINEERING, INC.**  
200 W. BELMONT, SUITE E  
ALLEN, TEXAS 75013 (972)396-1200  
TBPE FIRM #5951




DEVELOPMENT PLANS FOR  
**ROCKWALL DOWNS**  
PHASE 1  
ROCKWALL, TEXAS

DRAINAGE AREA MAP

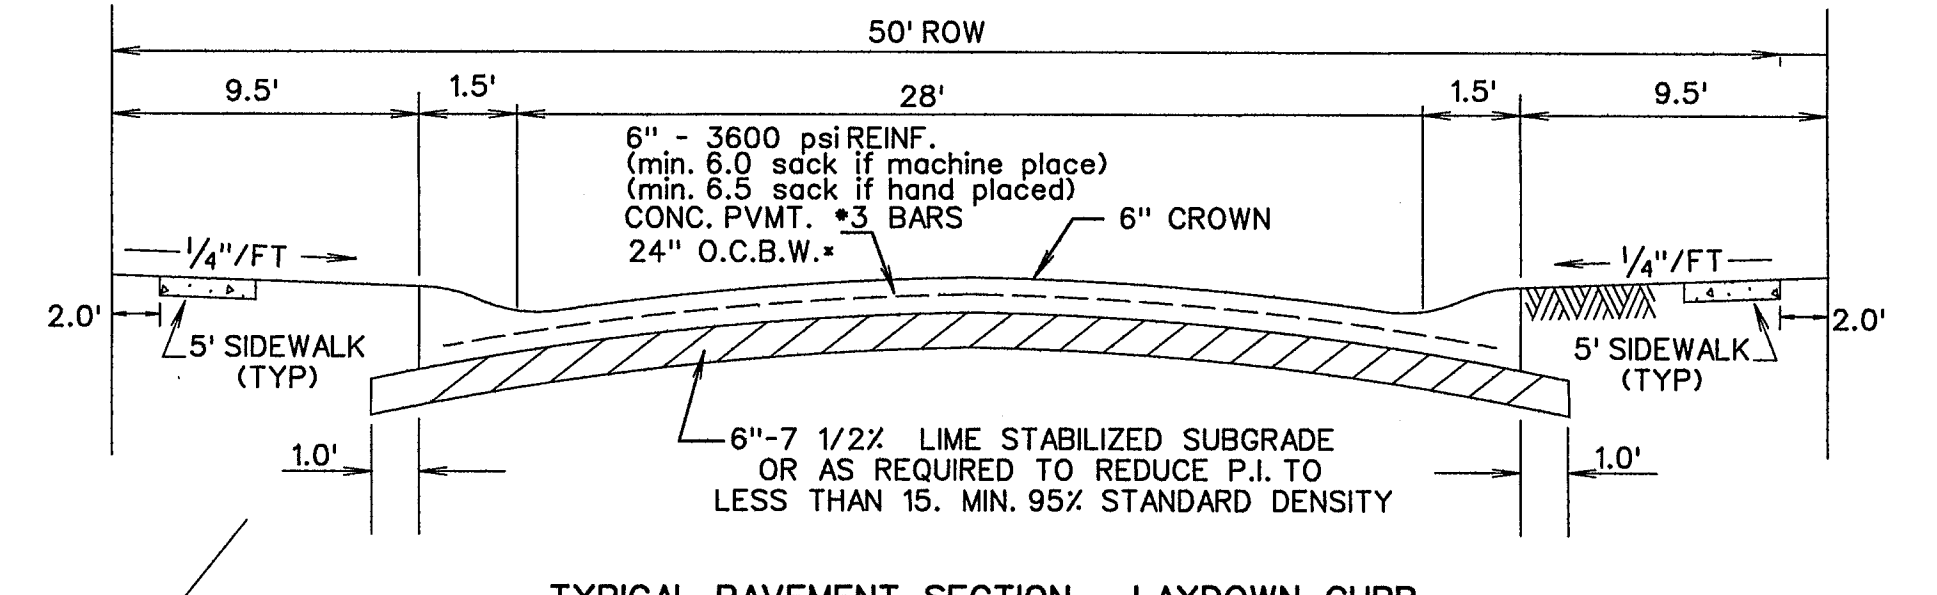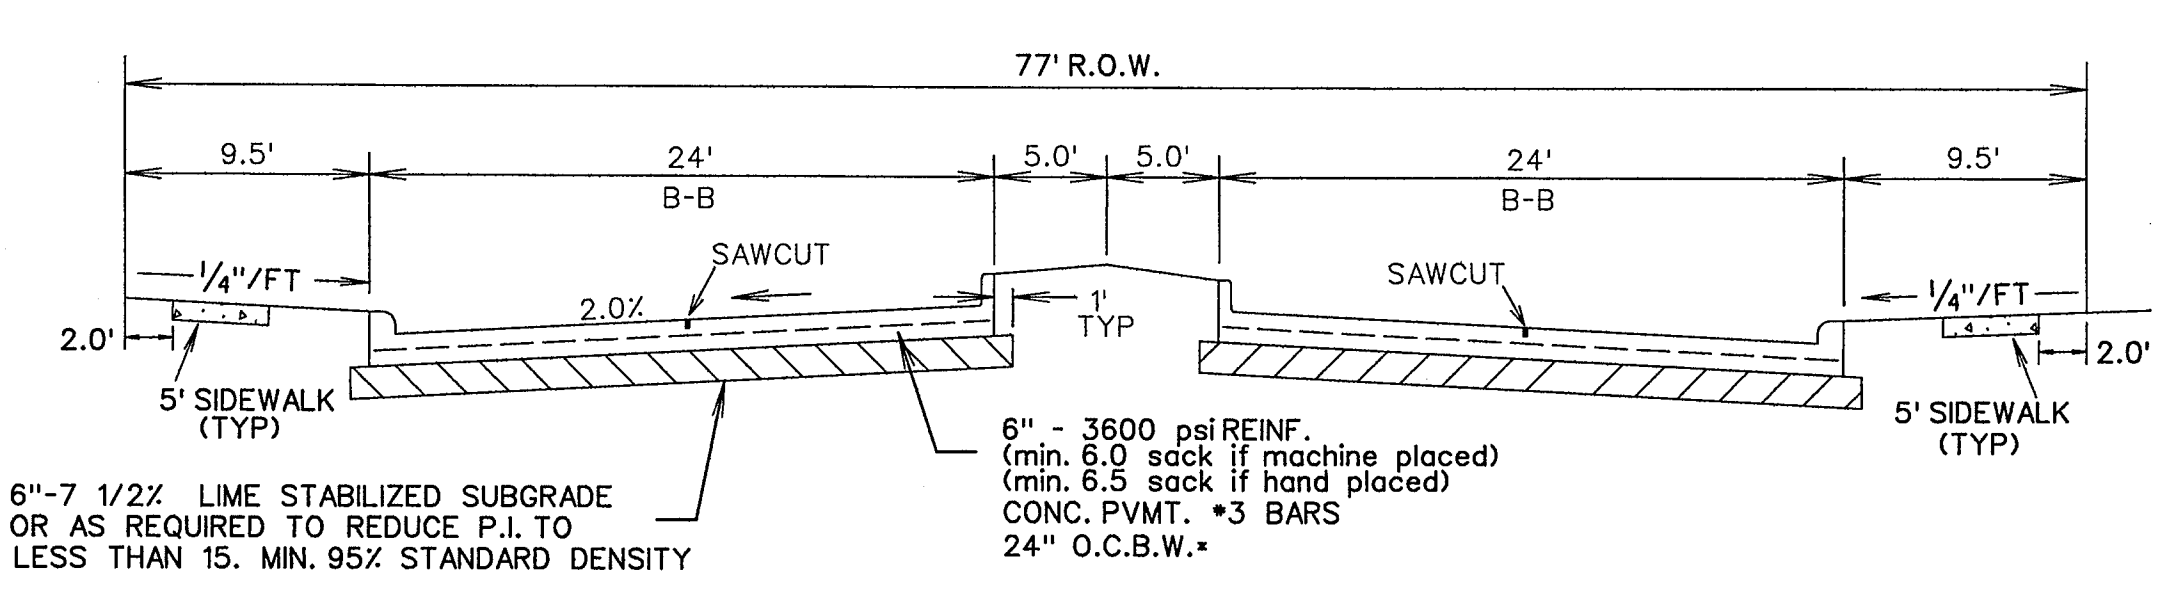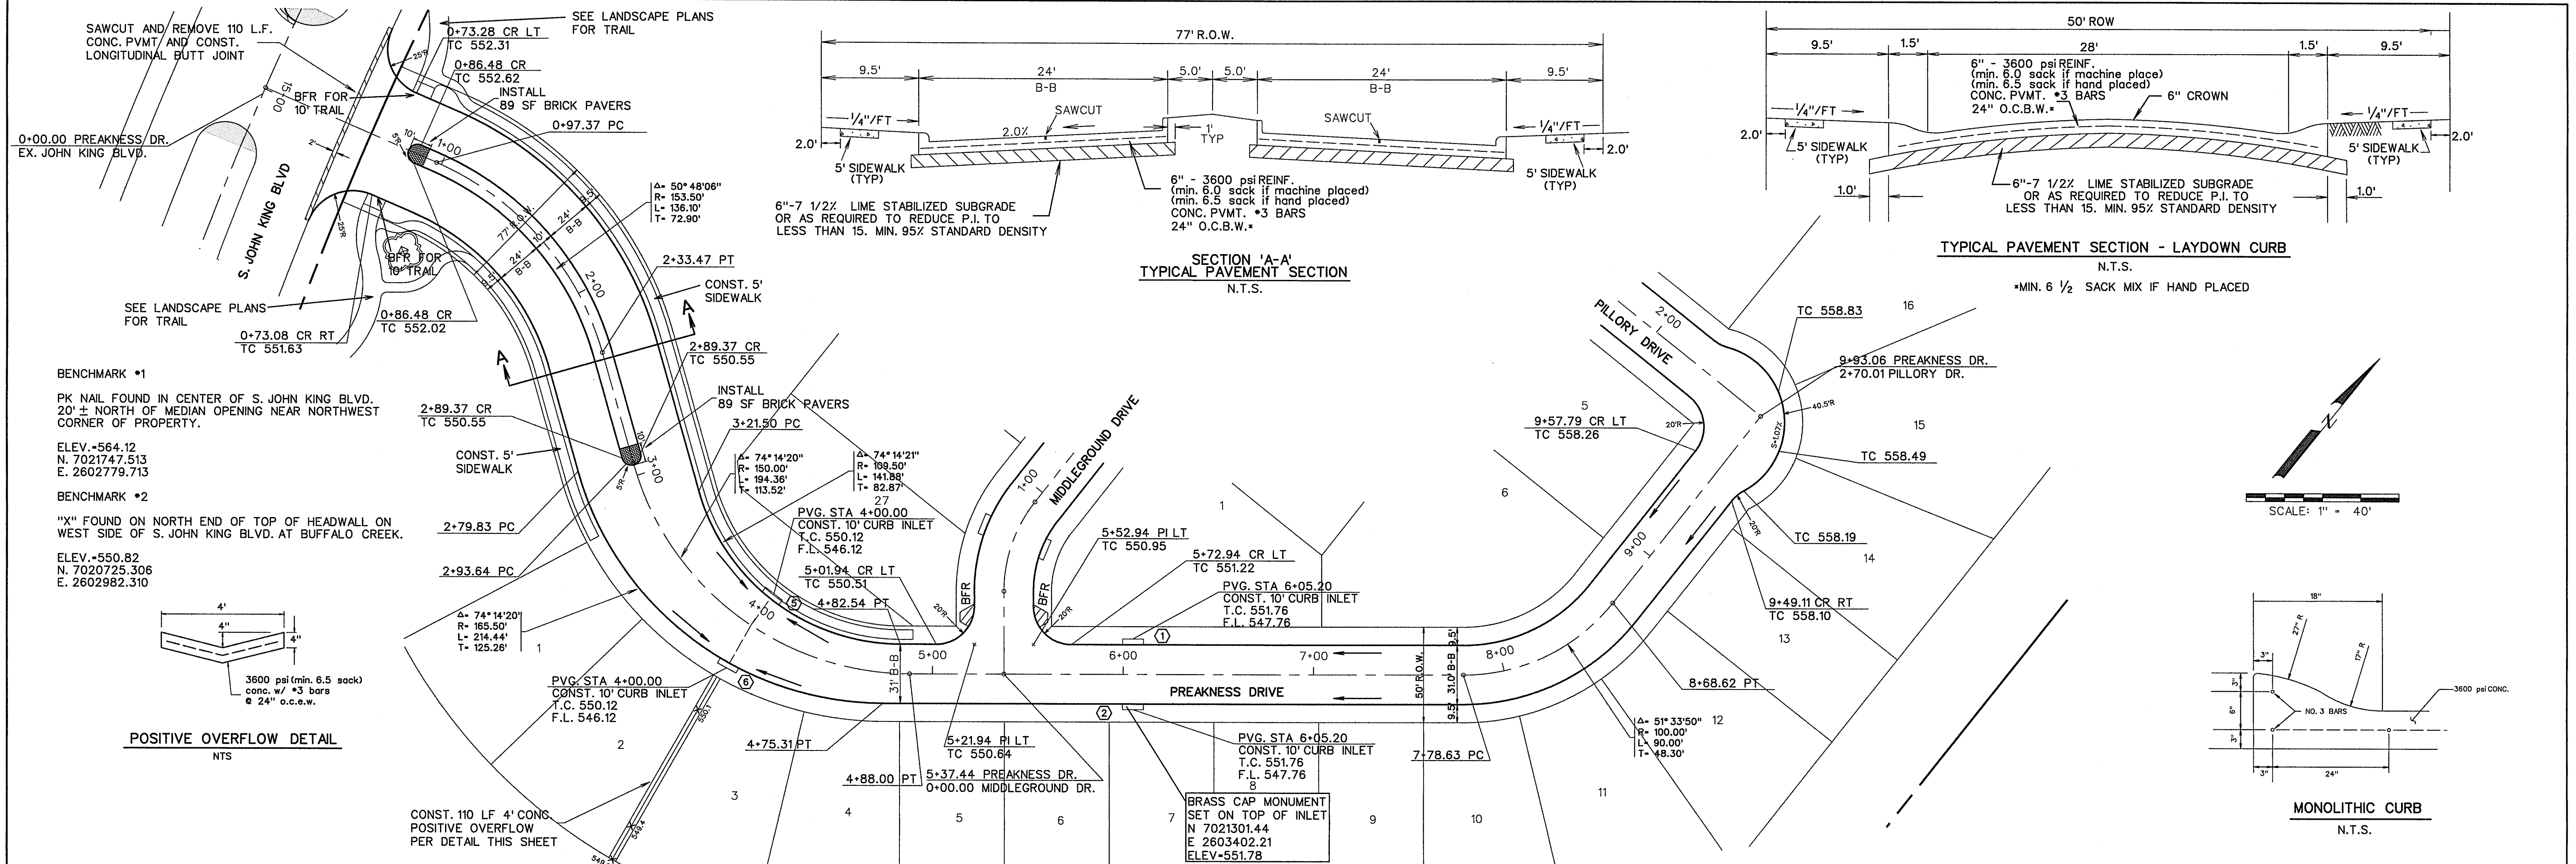

**BENCHMARK #1**  
 PK NAIL FOUND IN CENTER OF S. JOHN KING BLVD.  
 20' ± NORTH OF MEDIAN OPENING NEAR NORTHWEST  
 CORNER OF PROPERTY.  
 ELEV. +564.12  
 N. 7021747.513  
 E. 2602779.713

**BENCHMARK #2**  
 "X" FOUND ON NORTH END OF TOP OF HEADWALL ON  
 WEST SIDE OF S. JOHN KING BLVD. AT BUFFALO CREEK.  
 ELEV. +550.82  
 N. 7020725.306  
 E. 2602982.310

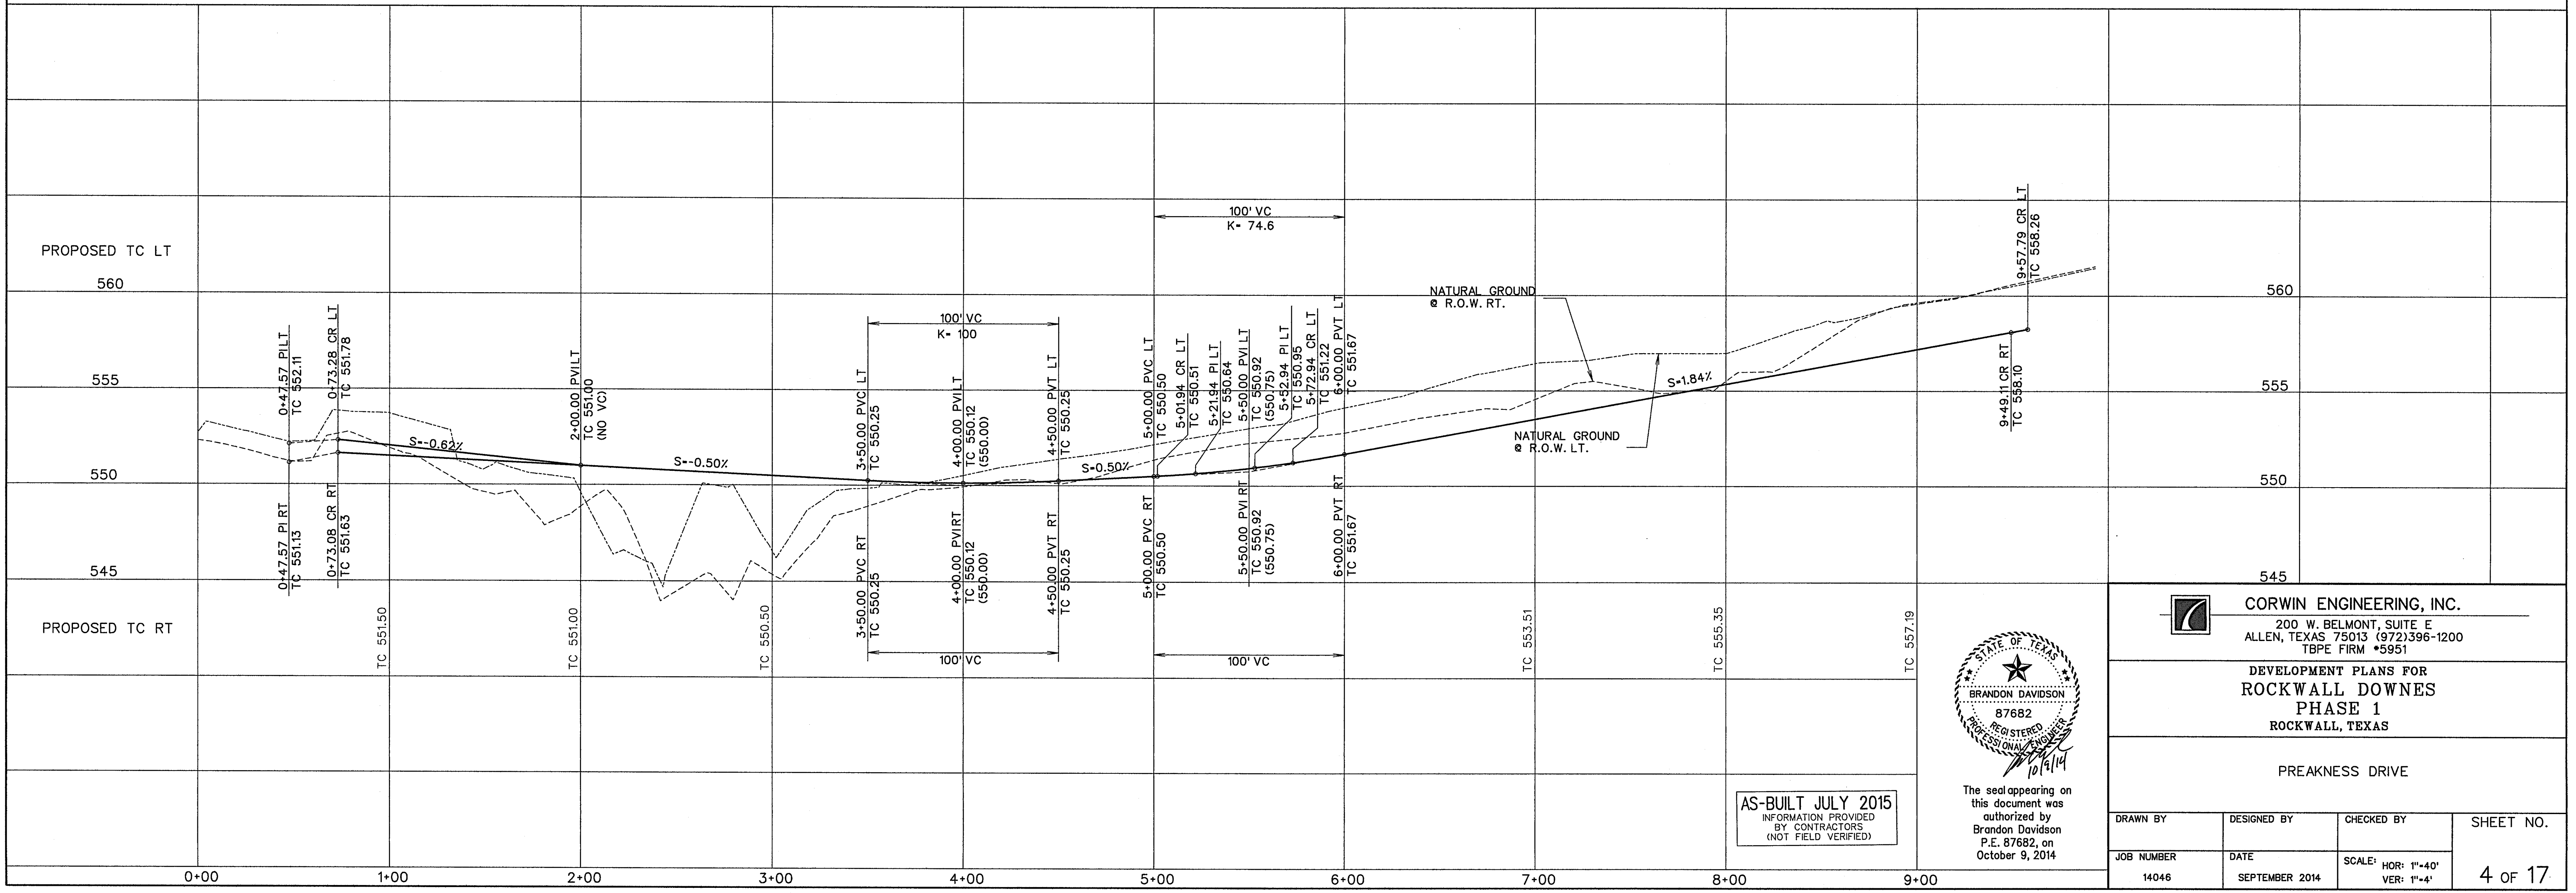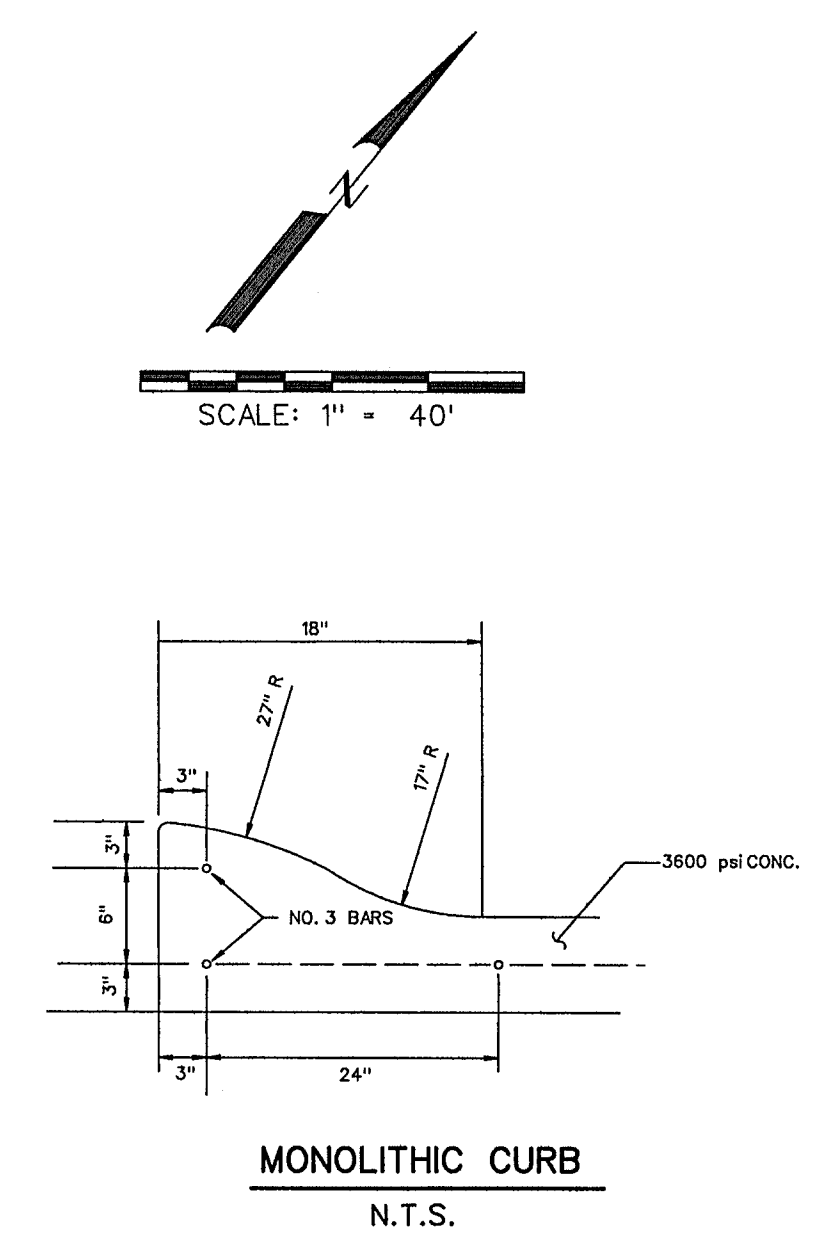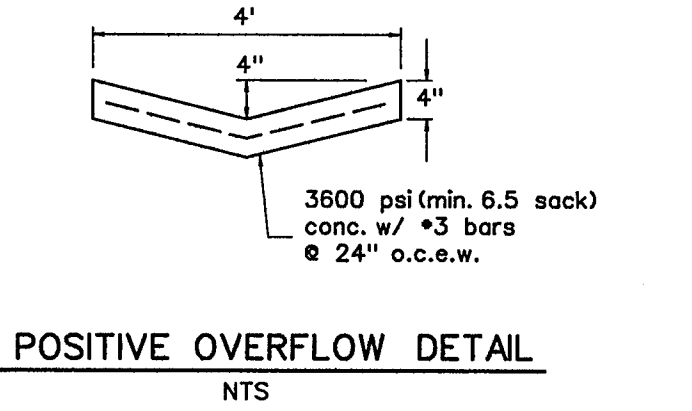

**AS-BUILT JULY 2015**  
 INFORMATION PROVIDED  
 BY CONTRACTORS  
 (NOT FIELD VERIFIED)



The seal appearing on  
 this document was  
 authorized by  
 Brandon Davidson  
 P.E. 87682, on  
 October 9, 2014



**CORWIN ENGINEERING, INC.**  
 200 W. BELMONT, SUITE E  
 ALLEN, TEXAS 75013 (972)396-1200  
 TBPE FIRM #5951

**DEVELOPMENT PLANS FOR  
 ROCKWALL DOWNS  
 PHASE 1  
 ROCKWALL, TEXAS**


**PREAKNESS DRIVE**

DRAWN BY	DESIGNED BY	CHECKED BY	SHEET NO.
JOB NUMBER	DATE	SCALE: HOR: 1"=40' VER: 1"=4'	4 OF 17
14046	SEPTEMBER 2014		



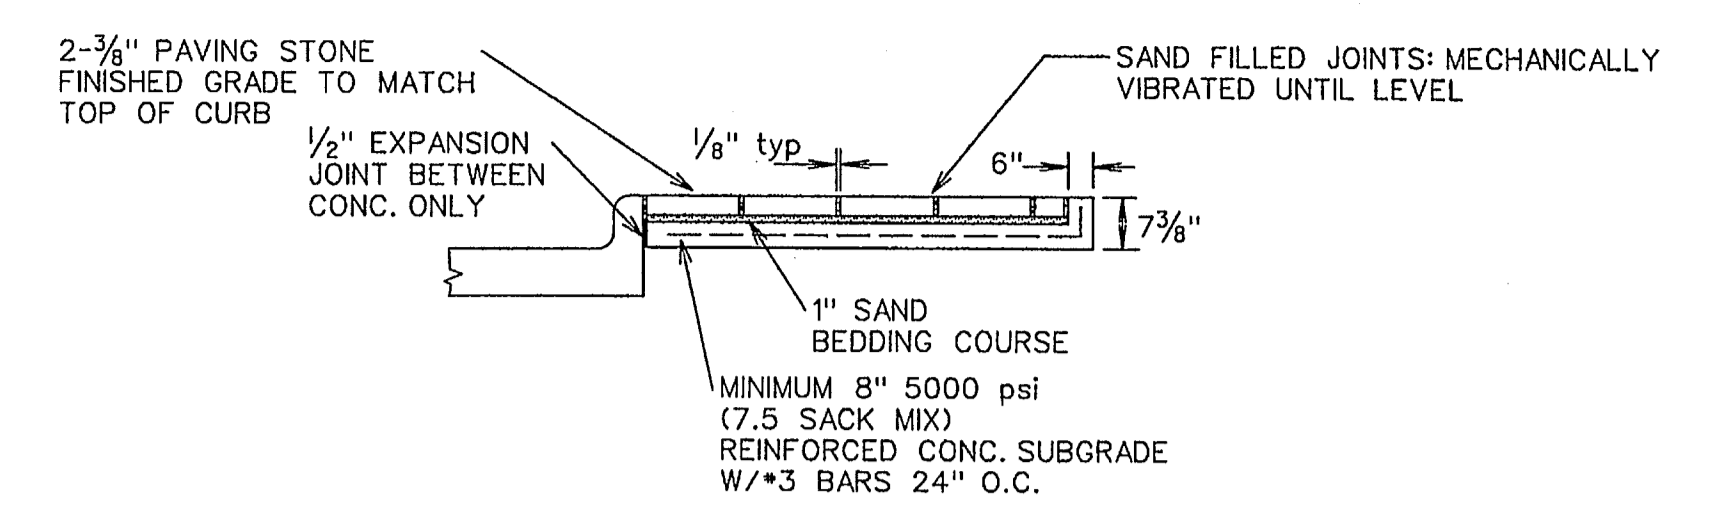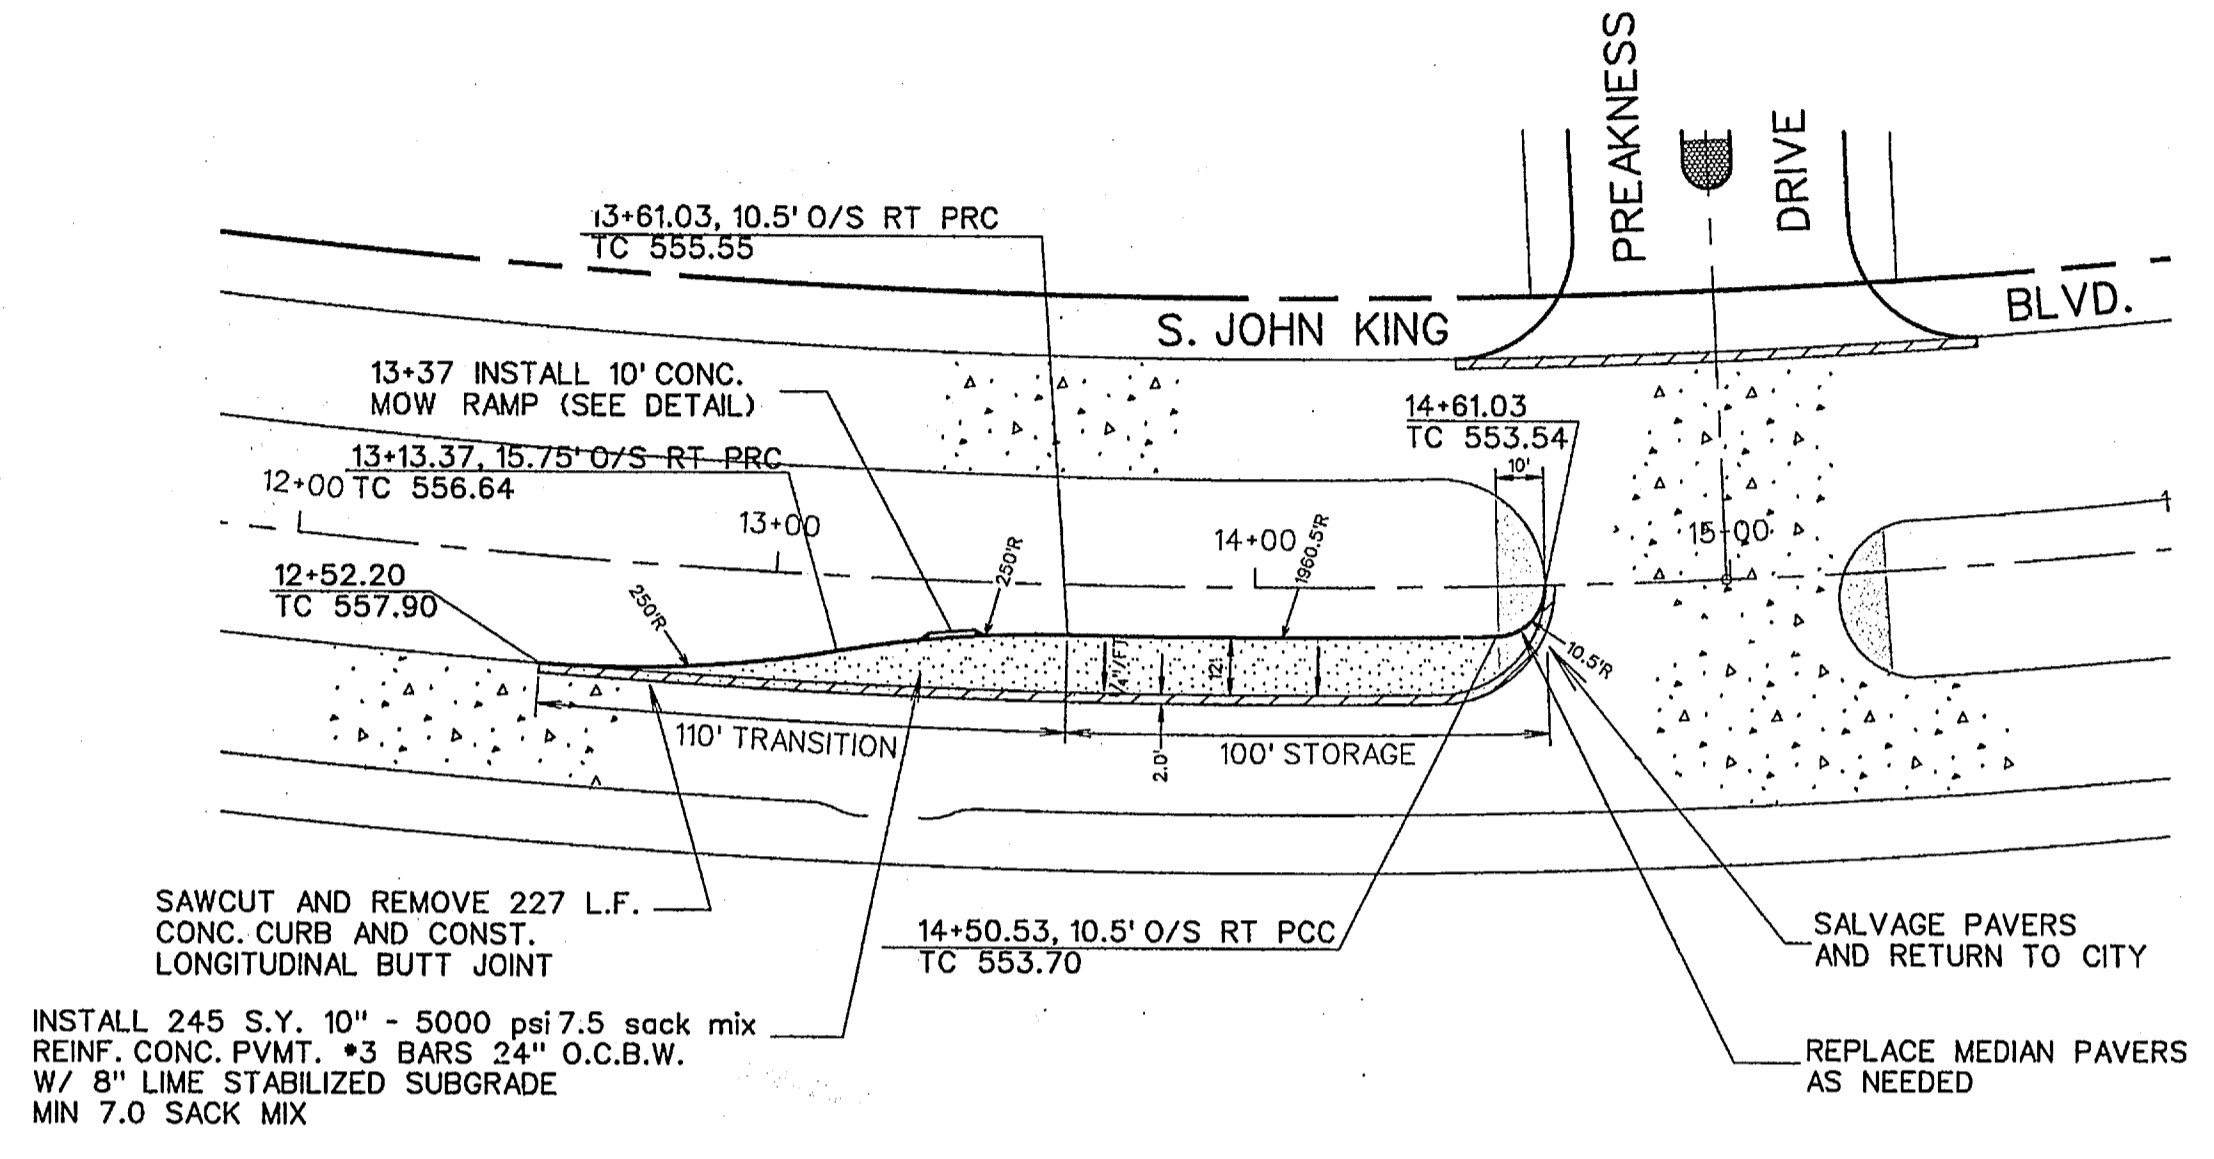


MEDIAN PAVING STONE DETAIL  
N.T.S.

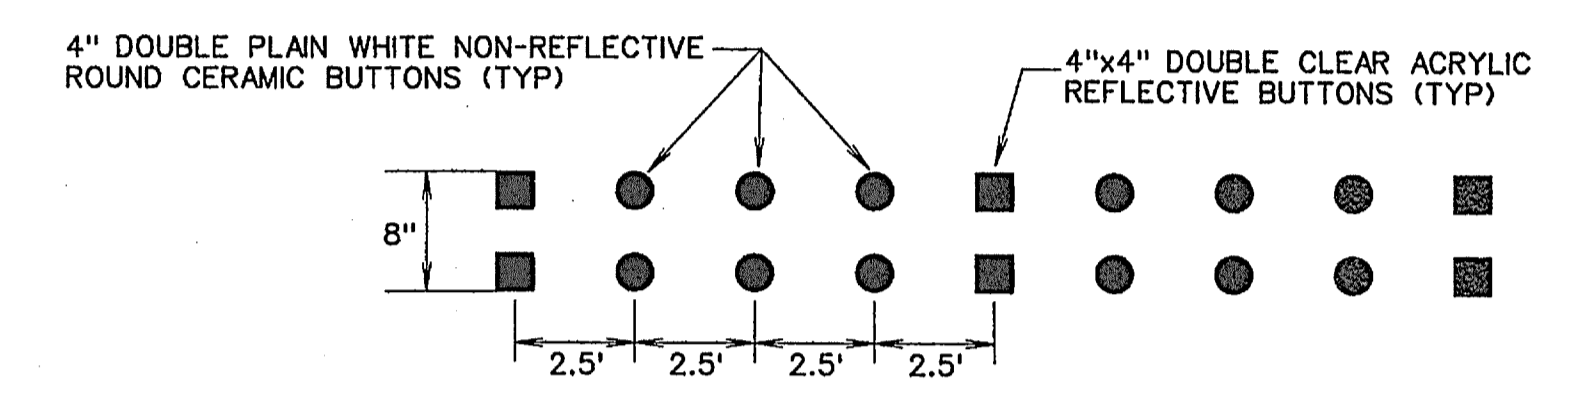


BUTTON TURN BAY LINE MARKING DETAIL  
N.T.S.

BENCHMARK #1  
PK NAIL FOUND IN CENTER OF S. JOHN KING BLVD.  
20' ± NORTH OF MEDIAN OPENING NEAR NORTHWEST  
CORNER OF PROPERTY.  
ELEV. -564.12  
N. 7021747.513  
E. 2602779.713


BENCHMARK #2  
"X" FOUND ON NORTH END OF TOP OF HEADWALL ON  
WEST SIDE OF S. JOHN KING BLVD. AT BUFFALO CREEK.  
ELEV. -550.82  
N. 7020725.306  
E. 2602982.310

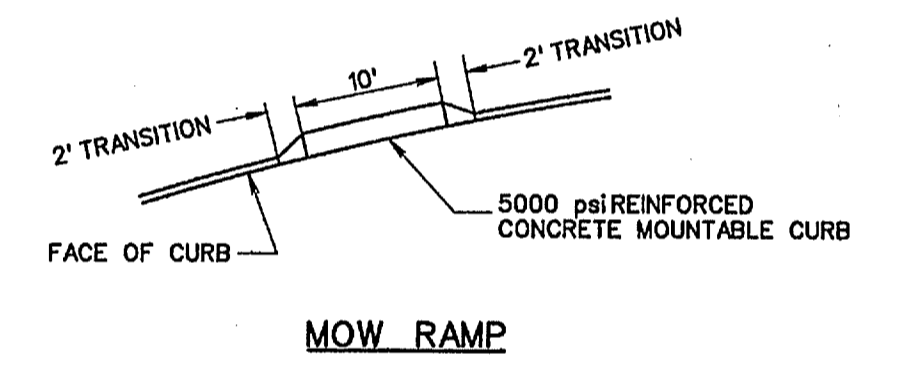


MOW RAMP

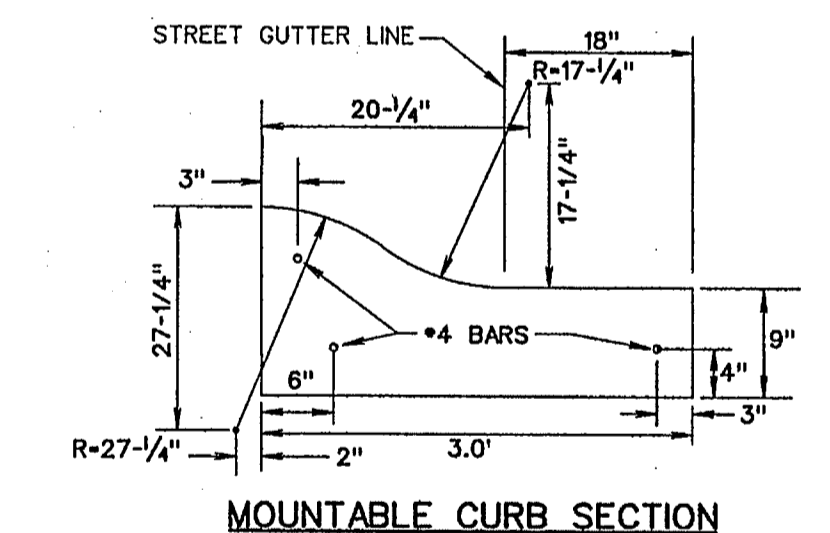


MOUNTABLE CURB SECTION

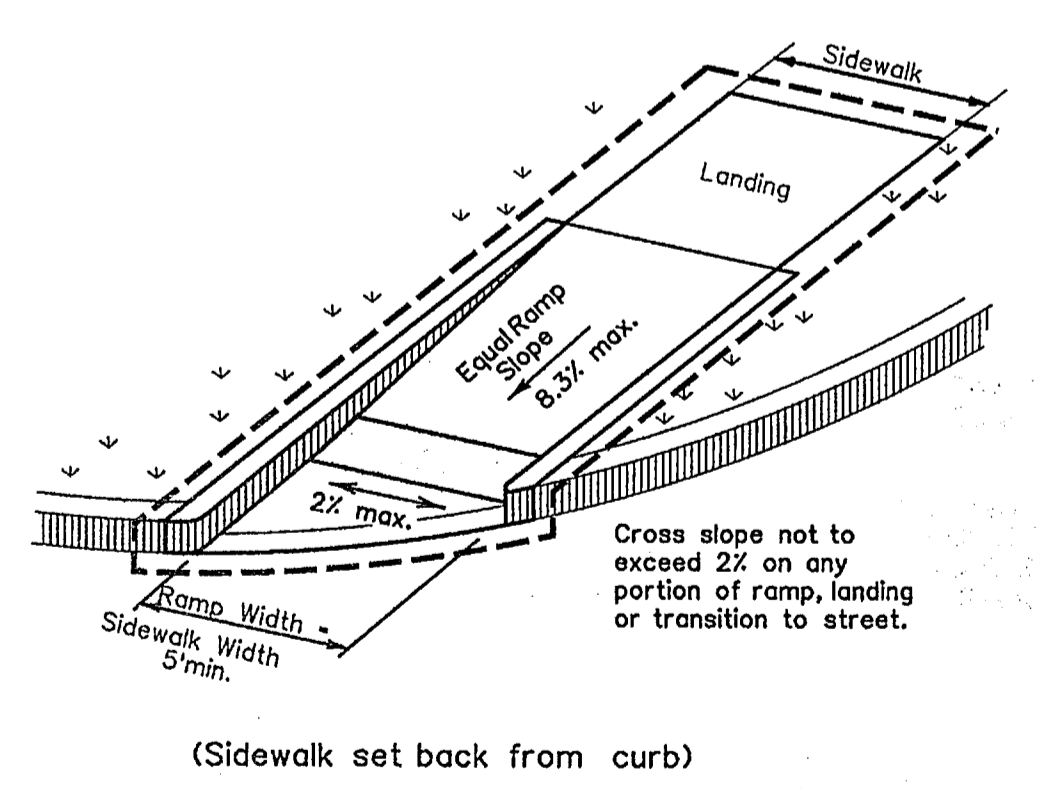


BFR DETAIL

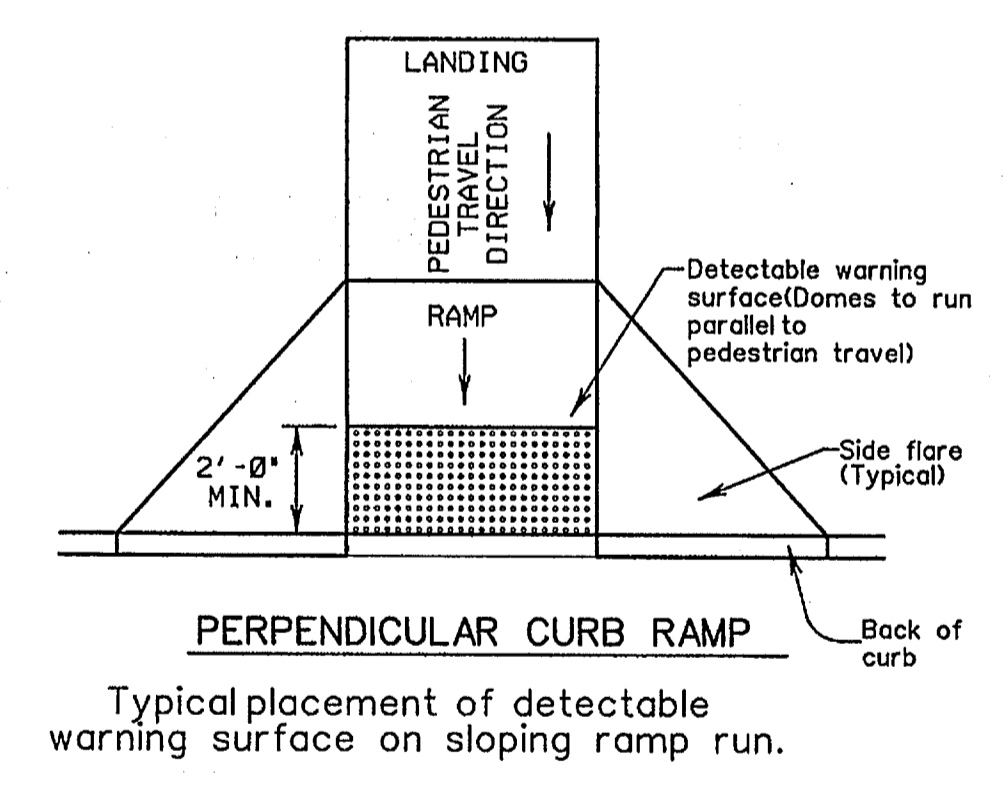


PERPENDICULAR CURB RAMP  
Typical placement of detectable warning surface on sloping ramp run.

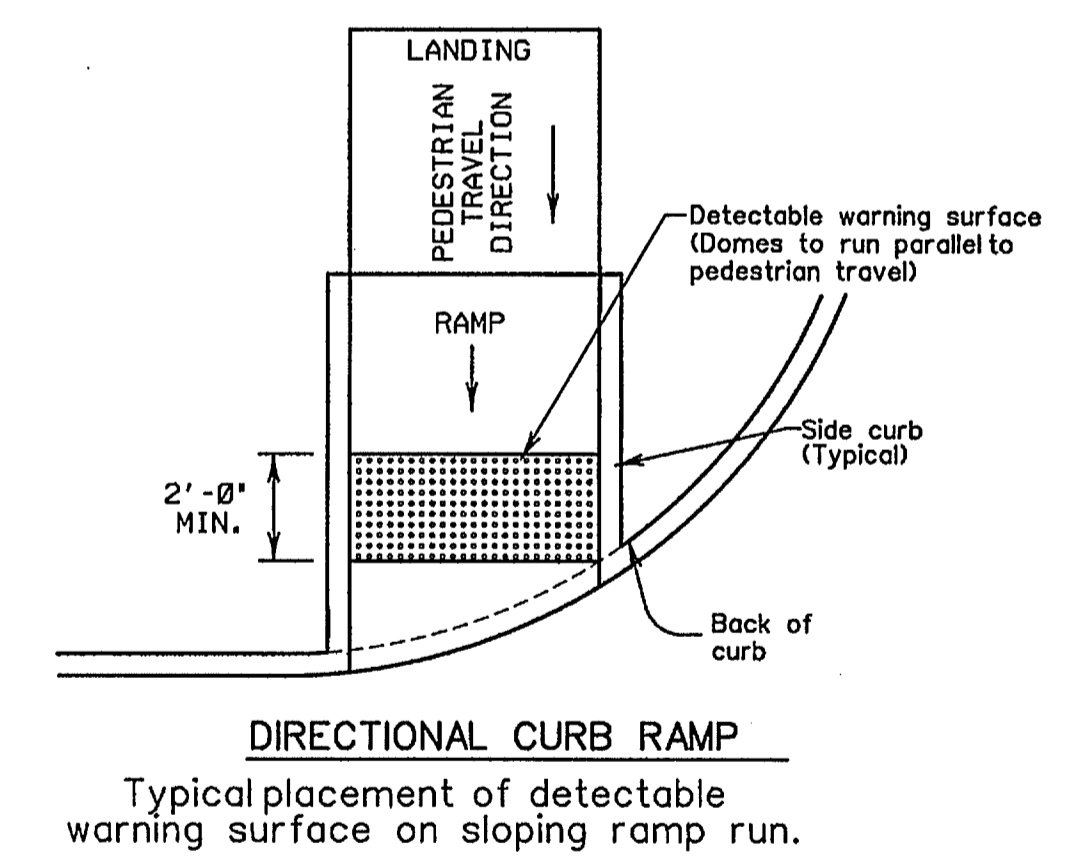

DIRECTIONAL CURB RAMP  
Typical placement of detectable warning surface on sloping ramp run.

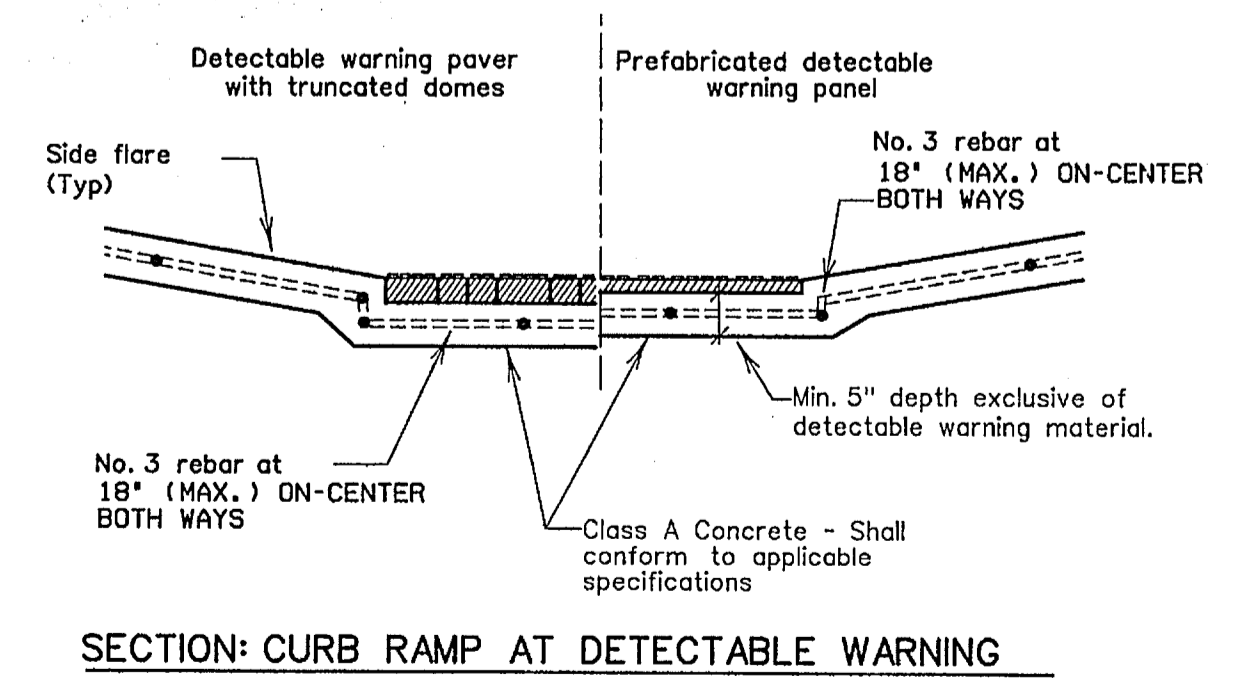

SECTION: CURB RAMP AT DETECTABLE WARNING

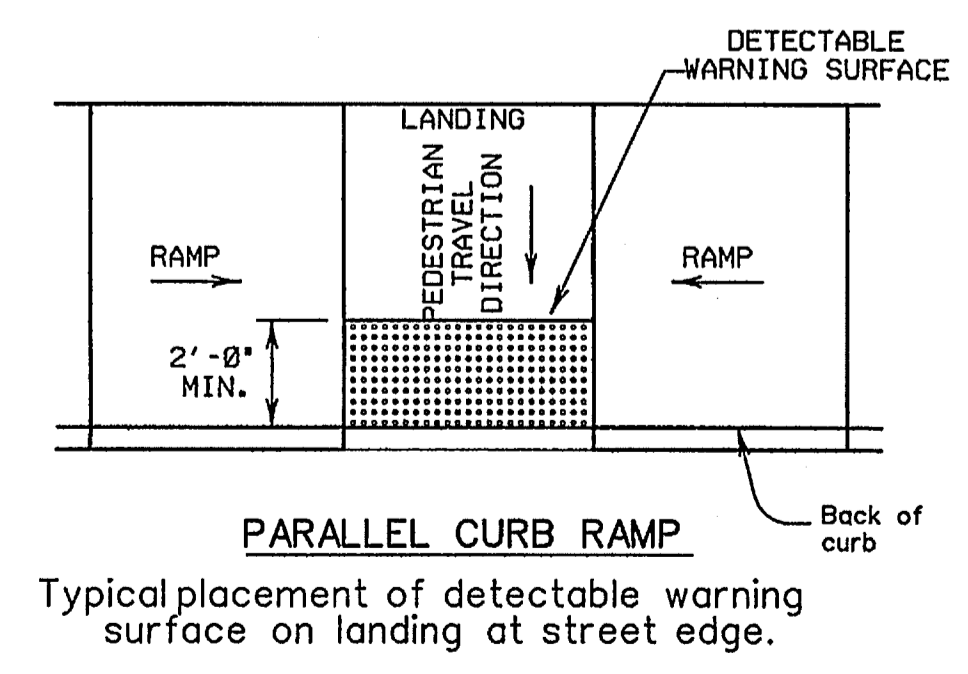

PARALLEL CURB RAMP  
Typical placement of detectable warning surface on landing at street edge.

DETECTABLE WARNINGS


AS-BUILT JULY 2015  
INFORMATION PROVIDED  
BY CONTRACTORS  
(NOT FIELD VERIFIED)

STATE OF TEXAS  
WARREN L. CORWIN  
57875  
REGISTERED PROFESSIONAL ENGINEER  
9-3-2014

The seal appearing on this document was authorized by Warren L. Corwin, P.E. 57875, on September 3, 2014

<p>CORWIN ENGINEERING, INC. 200 W. BELMONT, SUITE E ALLEN, TEXAS 75013 (972)396-1200 TBPE FIRM #5951</p>			
<p>DEVELOPMENT PLANS FOR ROCKWALL DOWNS PHASE 1 ROCKWALL, TEXAS</p>			
<p>LEFT TURN LANE S. JOHN KING BLVD.</p>			
DRAWN BY	DESIGNED BY	CHECKED BY	SHEET NO.
JOB NUMBER	DATE	SCALE: HOR: 1"=40' VER: 1"=4'	6 of 17
14046	SEPTEMBER 2014		

SCALE: 1" = 50'

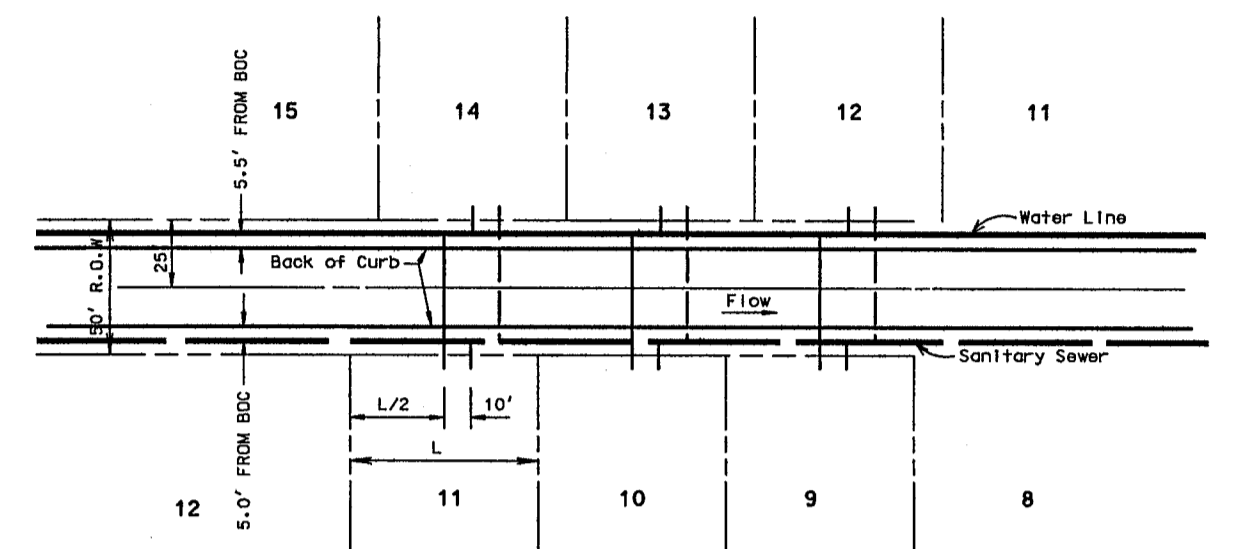

TYPICAL WATER & SEWER SERVICE LAYOUT  
N.T.S.

NOTE:  
 ALL WATER LINES TO BE CLASS 200 PIPE SDR 14.  
 ALL SANITARY SEWER PIPE TO BE SDR 35 FOR 5'-10" DEEP AND SDR 26 FOR 10' AND GREATER. 10" SANITARY SEWER TO BE SDR 26.  
 INSTALL BLUE "EMS" DISK ON WATER LINE AT EVERY CHANGE IN DIRECTION, VALVE, AND SERVICE.  
 INSTALL GREEN "EMS" DISK ON SANITARY SEWER LINE AT EVERY CHANGE IN DIRECTION, MANHOLE, CLEANOUT, AND SERVICE.  
 ALL MANHOLES TO BE RAVEN EPOXY LINED (OR APPROVED EQUAL) AND SEALED IF LOCATED IN STREET PAVEMENT.  
 ALL HOMES TO BE SPRINKLERED

BENCHMARK \*1  
 PK NAIL FOUND IN CENTER OF S. JOHN KING BLVD. 20' ± NORTH OF MEDIAN OPENING NEAR NORTHWEST CORNER OF PROPERTY.  
 ELEV. -564.12  
 N. 7021747.513  
 E. 2602779.713  
 BENCHMARK \*2  
 "X" FOUND ON NORTH END OF TOP OF HEADWALL ON WEST SIDE OF S. JOHN KING BLVD. AT BUFFALO CREEK.  
 ELEV. -550.82  
 N. 7020725.306  
 E. 2602982.310

LEGEND

	PROP. WATER LINE
	PROP. FIRE HYDRANT AND VALVE
	PROP. GATE VALVE
	PROP. FLUSH VALVE
	EXIST. WATER LINE
	EXIST. FIRE HYDRANT AND VALVE
	PROP. SANITARY SEWER
	PROP. MANHOLE
	PROP. CLEANOUT
	EXIST. SANITARY SEWER
	EXIST. MANHOLE
	PROP. STORM SEWER
	PROP. CURB INLETS
	PROP. CONC. HEADWALL

SANITARY SEWER CURVE DATA

CURVE NO.	①	②	③	④
Δ	57° 57' 19"	30° 50' 41"	11° 02' 43"	17° 33' 45"
R	200.00'	250.00'	250.00'	200.00'
T	110.76'	68.97'	24.17'	30.89'
L	202.30'	134.58'	48.19'	61.30'

SERVICE SCHEDULE

TYPE	SIZE	NO.
SANITARY	4"	34
WATER	1"	34

AS-BUILT JULY 2015  
 INFORMATION PROVIDED BY CONTRACTORS (NOT FIELD VERIFIED)




The seal appearing on this document was authorized by Brandon Davidson, P.E. 87682, on October 9, 2014.

**CORWIN ENGINEERING, INC.**  
 200 W. BELMONT, SUITE E  
 ALLEN, TEXAS 75013 (972)396-1200  
 TBPE FIRM #5951

DEVELOPMENT PLANS FOR  
**ROCKWALL DOWNES**  
 PHASE 1  
 ROCKWALL, TEXAS


WATER & SANITARY SEWER PLAN

DRAWN BY	DESIGNED BY	CHECKED BY	SHEET NO.
JOB NUMBER	DATE	SCALE:	7 OF 17
14046	JANUARY 2015	HOR: 1"=50'	

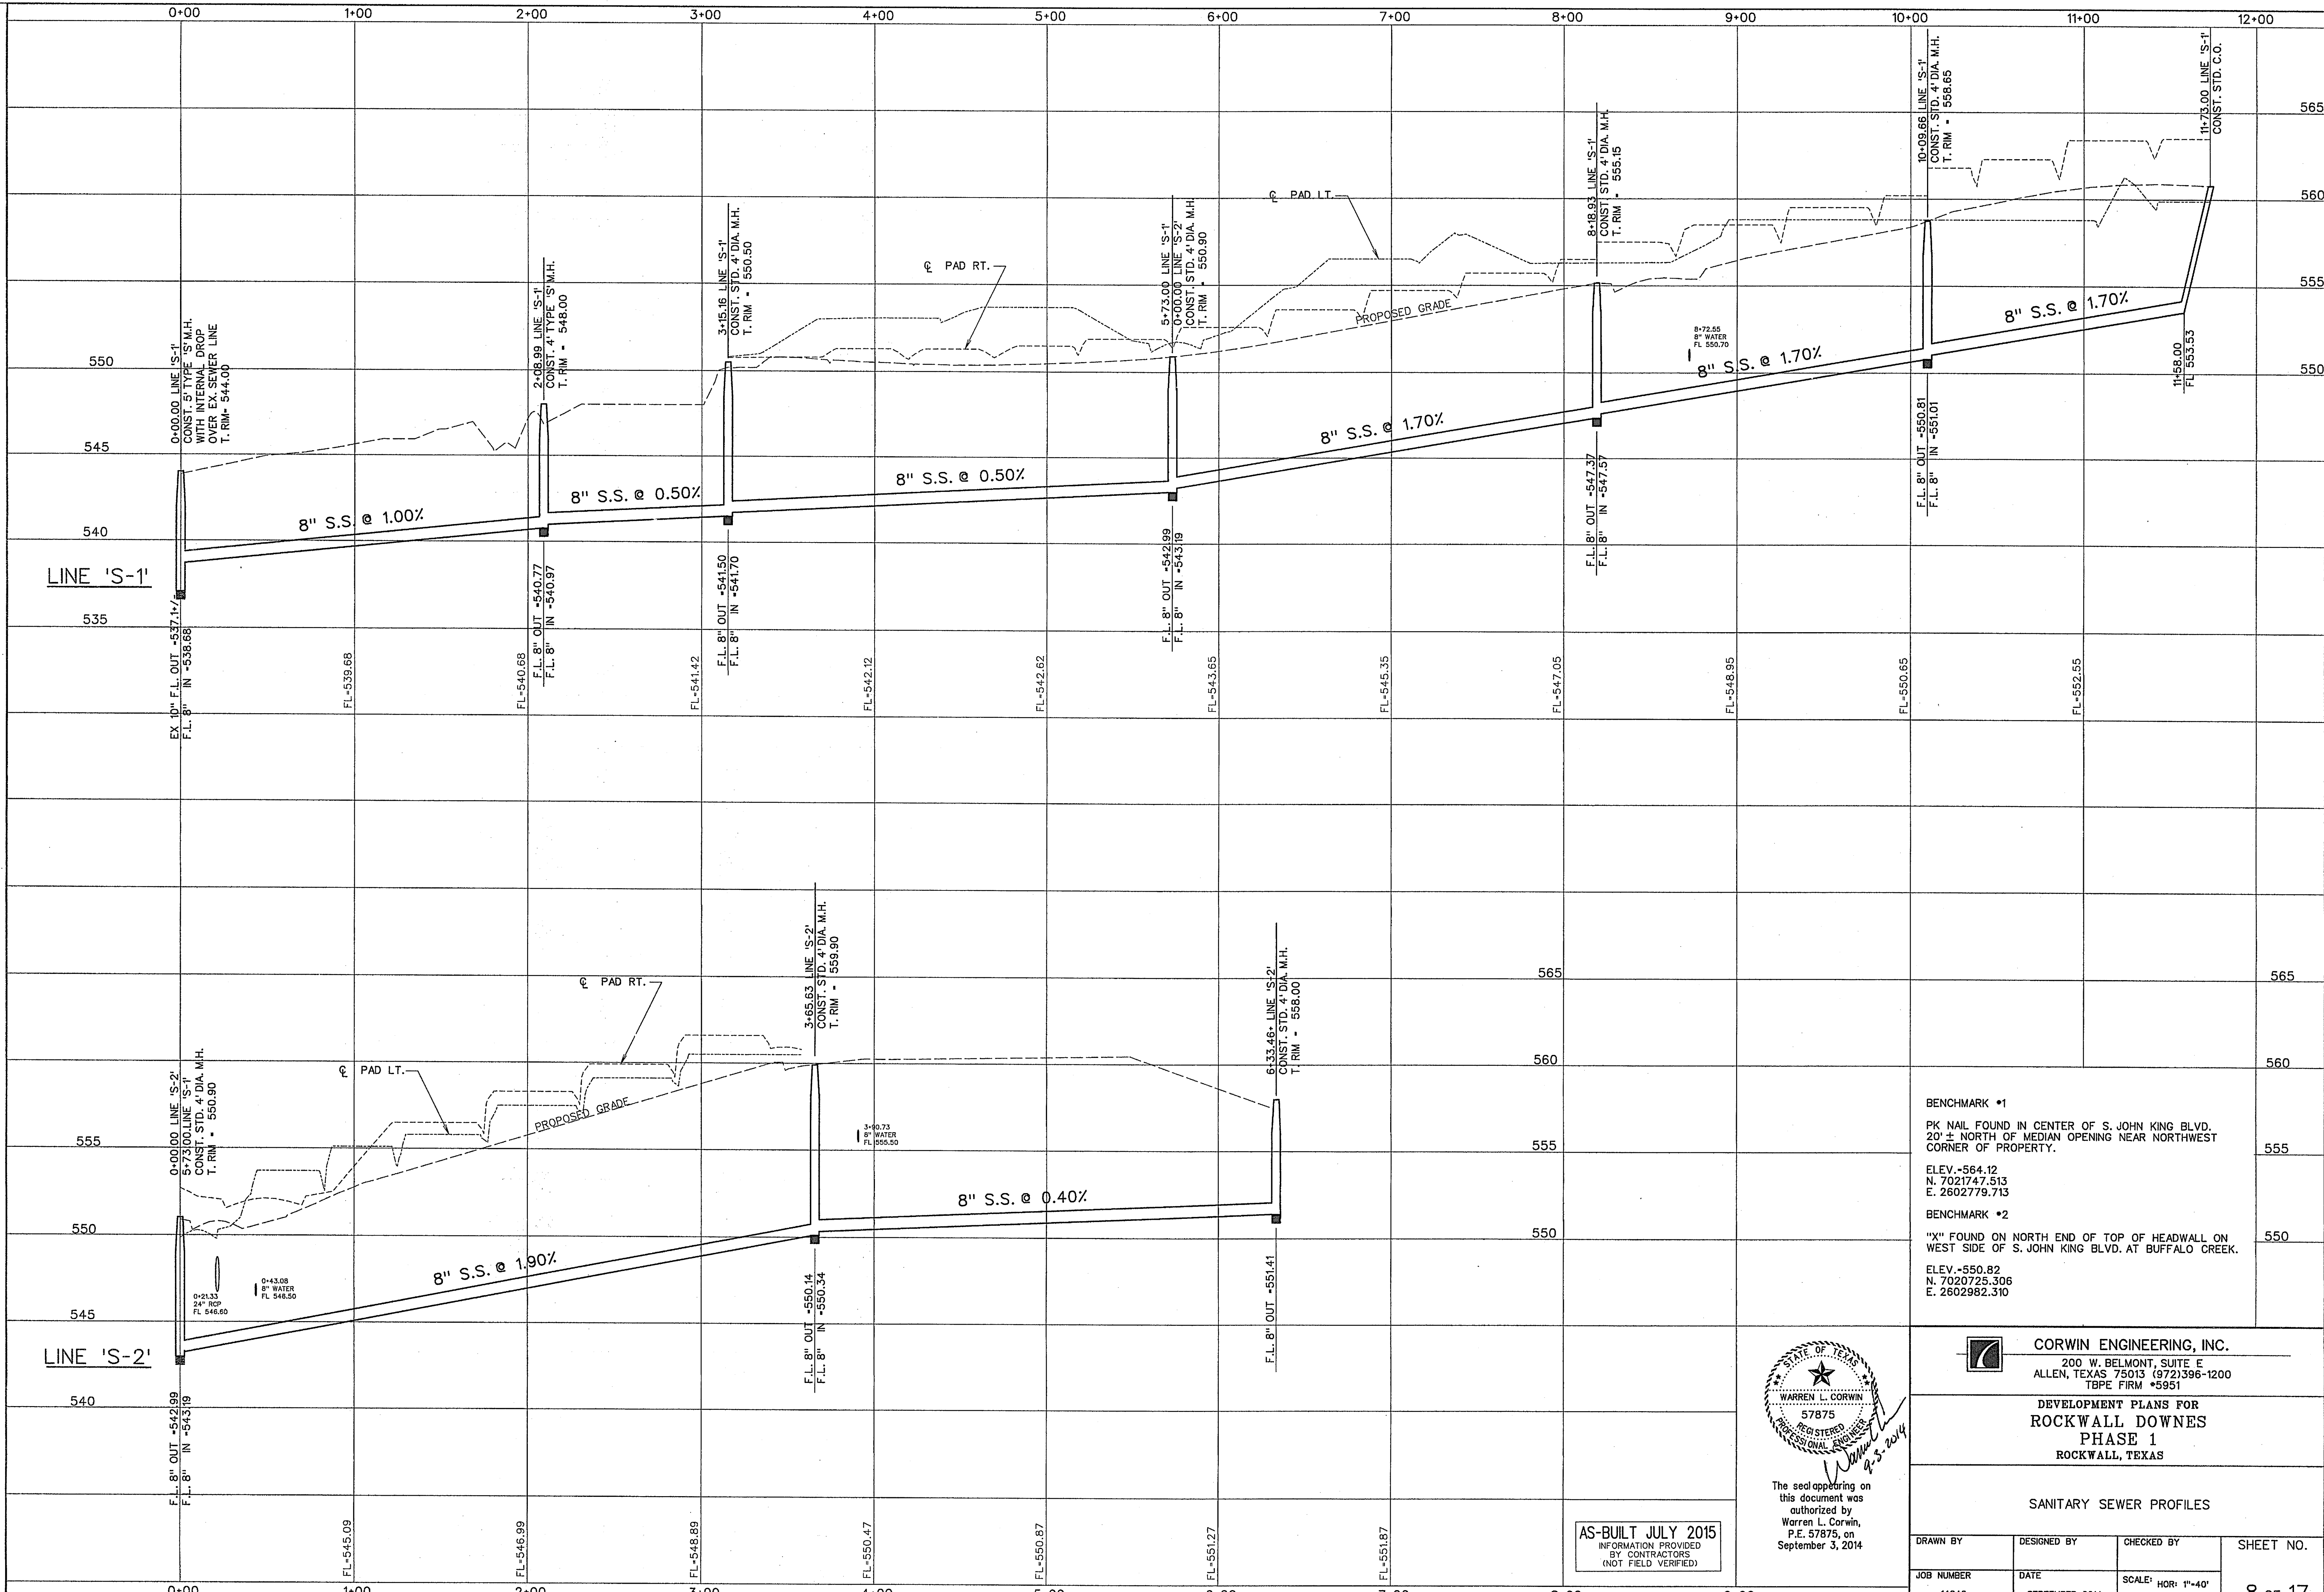

BENCHMARK \*1  
 PK NAIL FOUND IN CENTER OF S. JOHN KING BLVD.  
 20' ± NORTH OF MEDIAN OPENING NEAR NORTHWEST  
 CORNER OF PROPERTY.  
 ELEV. -564.12  
 N. 7021747.513  
 E. 2602779.713

BENCHMARK \*2  
 "X" FOUND ON NORTH END OF TOP OF HEADWALL ON  
 WEST SIDE OF S. JOHN KING BLVD. AT BUFFALO CREEK.  
 ELEV. -550.82  
 N. 7020725.306  
 E. 2602982.310

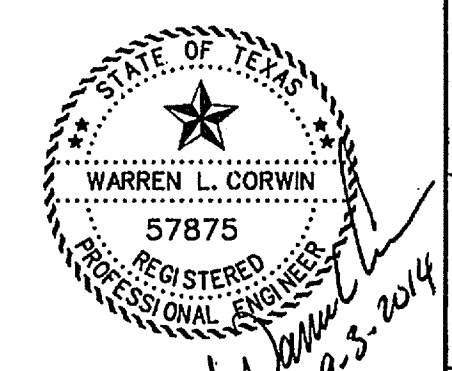

The seal appearing on  
 this document was  
 authorized by  
 Warren L. Corwin,  
 P.E. 57875, on  
 September 3, 2014

AS-BUILT JULY 2015  
 INFORMATION PROVIDED  
 BY CONTRACTORS  
 (NOT FIELD VERIFIED)

**CORWIN ENGINEERING, INC.**  
 200 W. BELMONT, SUITE E  
 ALLEN, TEXAS 75013 (972)396-1200  
 TBPE FIRM #5951

DEVELOPMENT PLANS FOR  
**ROCKWALL DOWNS**  
 PHASE 1  
 ROCKWALL, TEXAS


SANITARY SEWER PROFILES

DRAWN BY	DESIGNED BY	CHECKED BY	SHEET NO.
JOB NUMBER	DATE	SCALE	8 OF 17
14046	SEPTEMBER 2014	HOR: 1"=40' VER: 1"=4'	




BENCHMARK #1  
 PK NAIL FOUND IN CENTER OF S. JOHN KING BLVD.  
 20' ± NORTH OF MEDIAN OPENING NEAR NORTHWEST  
 CORNER OF PROPERTY.  
 ELEV. -564.12  
 N. 7021747.513  
 E. 2602779.713

BENCHMARK #2  
 "X" FOUND ON NORTH END OF TOP OF HEADWALL ON  
 WEST SIDE OF S. JOHN KING BLVD. AT BUFFALO CREEK.  
 ELEV. -550.82  
 N. 7020725.306  
 E. 2602982.310

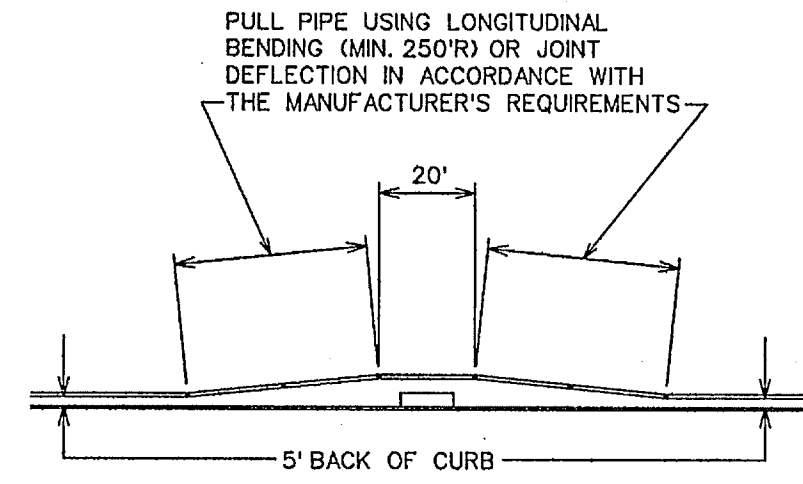


WATER LINE AT INLET DETAIL  
 N.T.S.

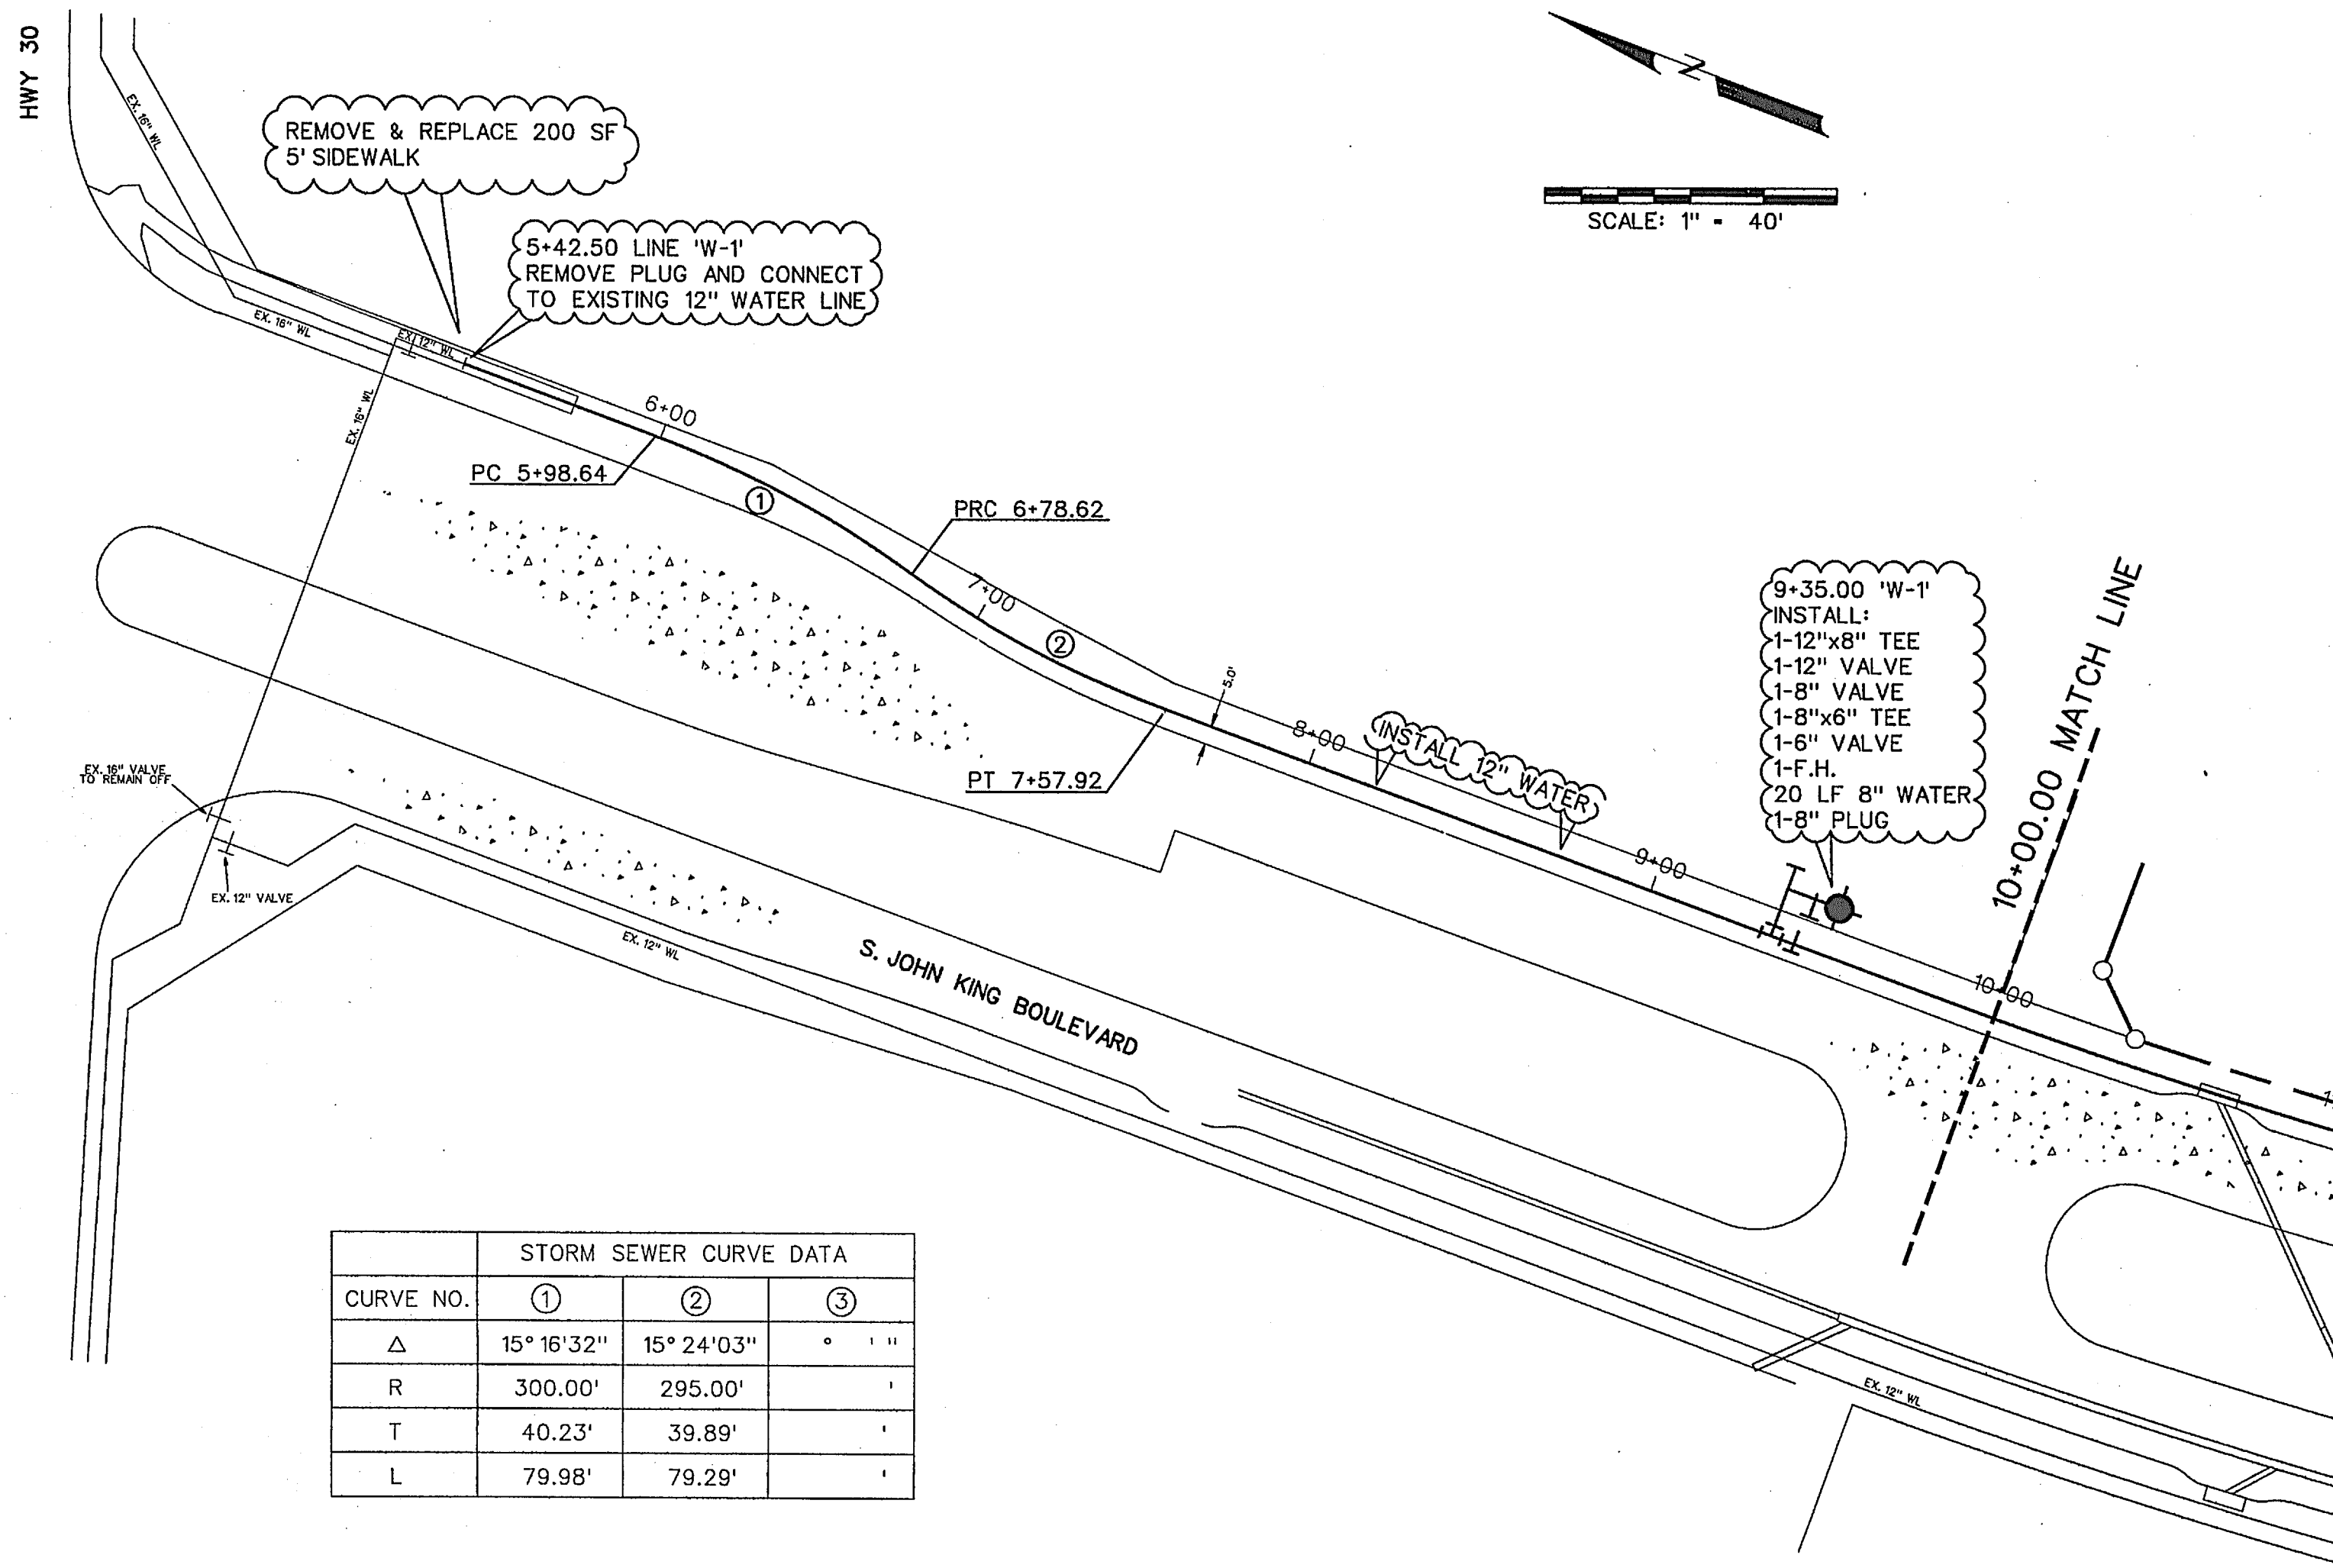

STORM SEWER CURVE DATA			
CURVE NO.	①	②	③
Δ	15° 16' 32"	15° 24' 03"	0° 11"
R	300.00'	295.00'	'
T	40.23'	39.89'	'
L	79.98'	79.29'	'

NOTE:  
 CONTRACTOR SHALL PULL PIPE AROUND  
 EXISTING INLETS. 2' SEPARATION BETWEEN  
 EDGE OF PIPE AND EXISTING INLET.

NOTE:  
 CONTRACTOR SHALL VERIFY ALL EXISTING  
 UTILITIES PRIOR TO CONSTRUCTION. EXISTING  
 UTILITY LOCATION AND ELEVATION ARE BASED ON  
 AS-BUILT DRAWINGS AND MAY DIFFER IN ACTUAL  
 LOCATION AND ELEVATION.

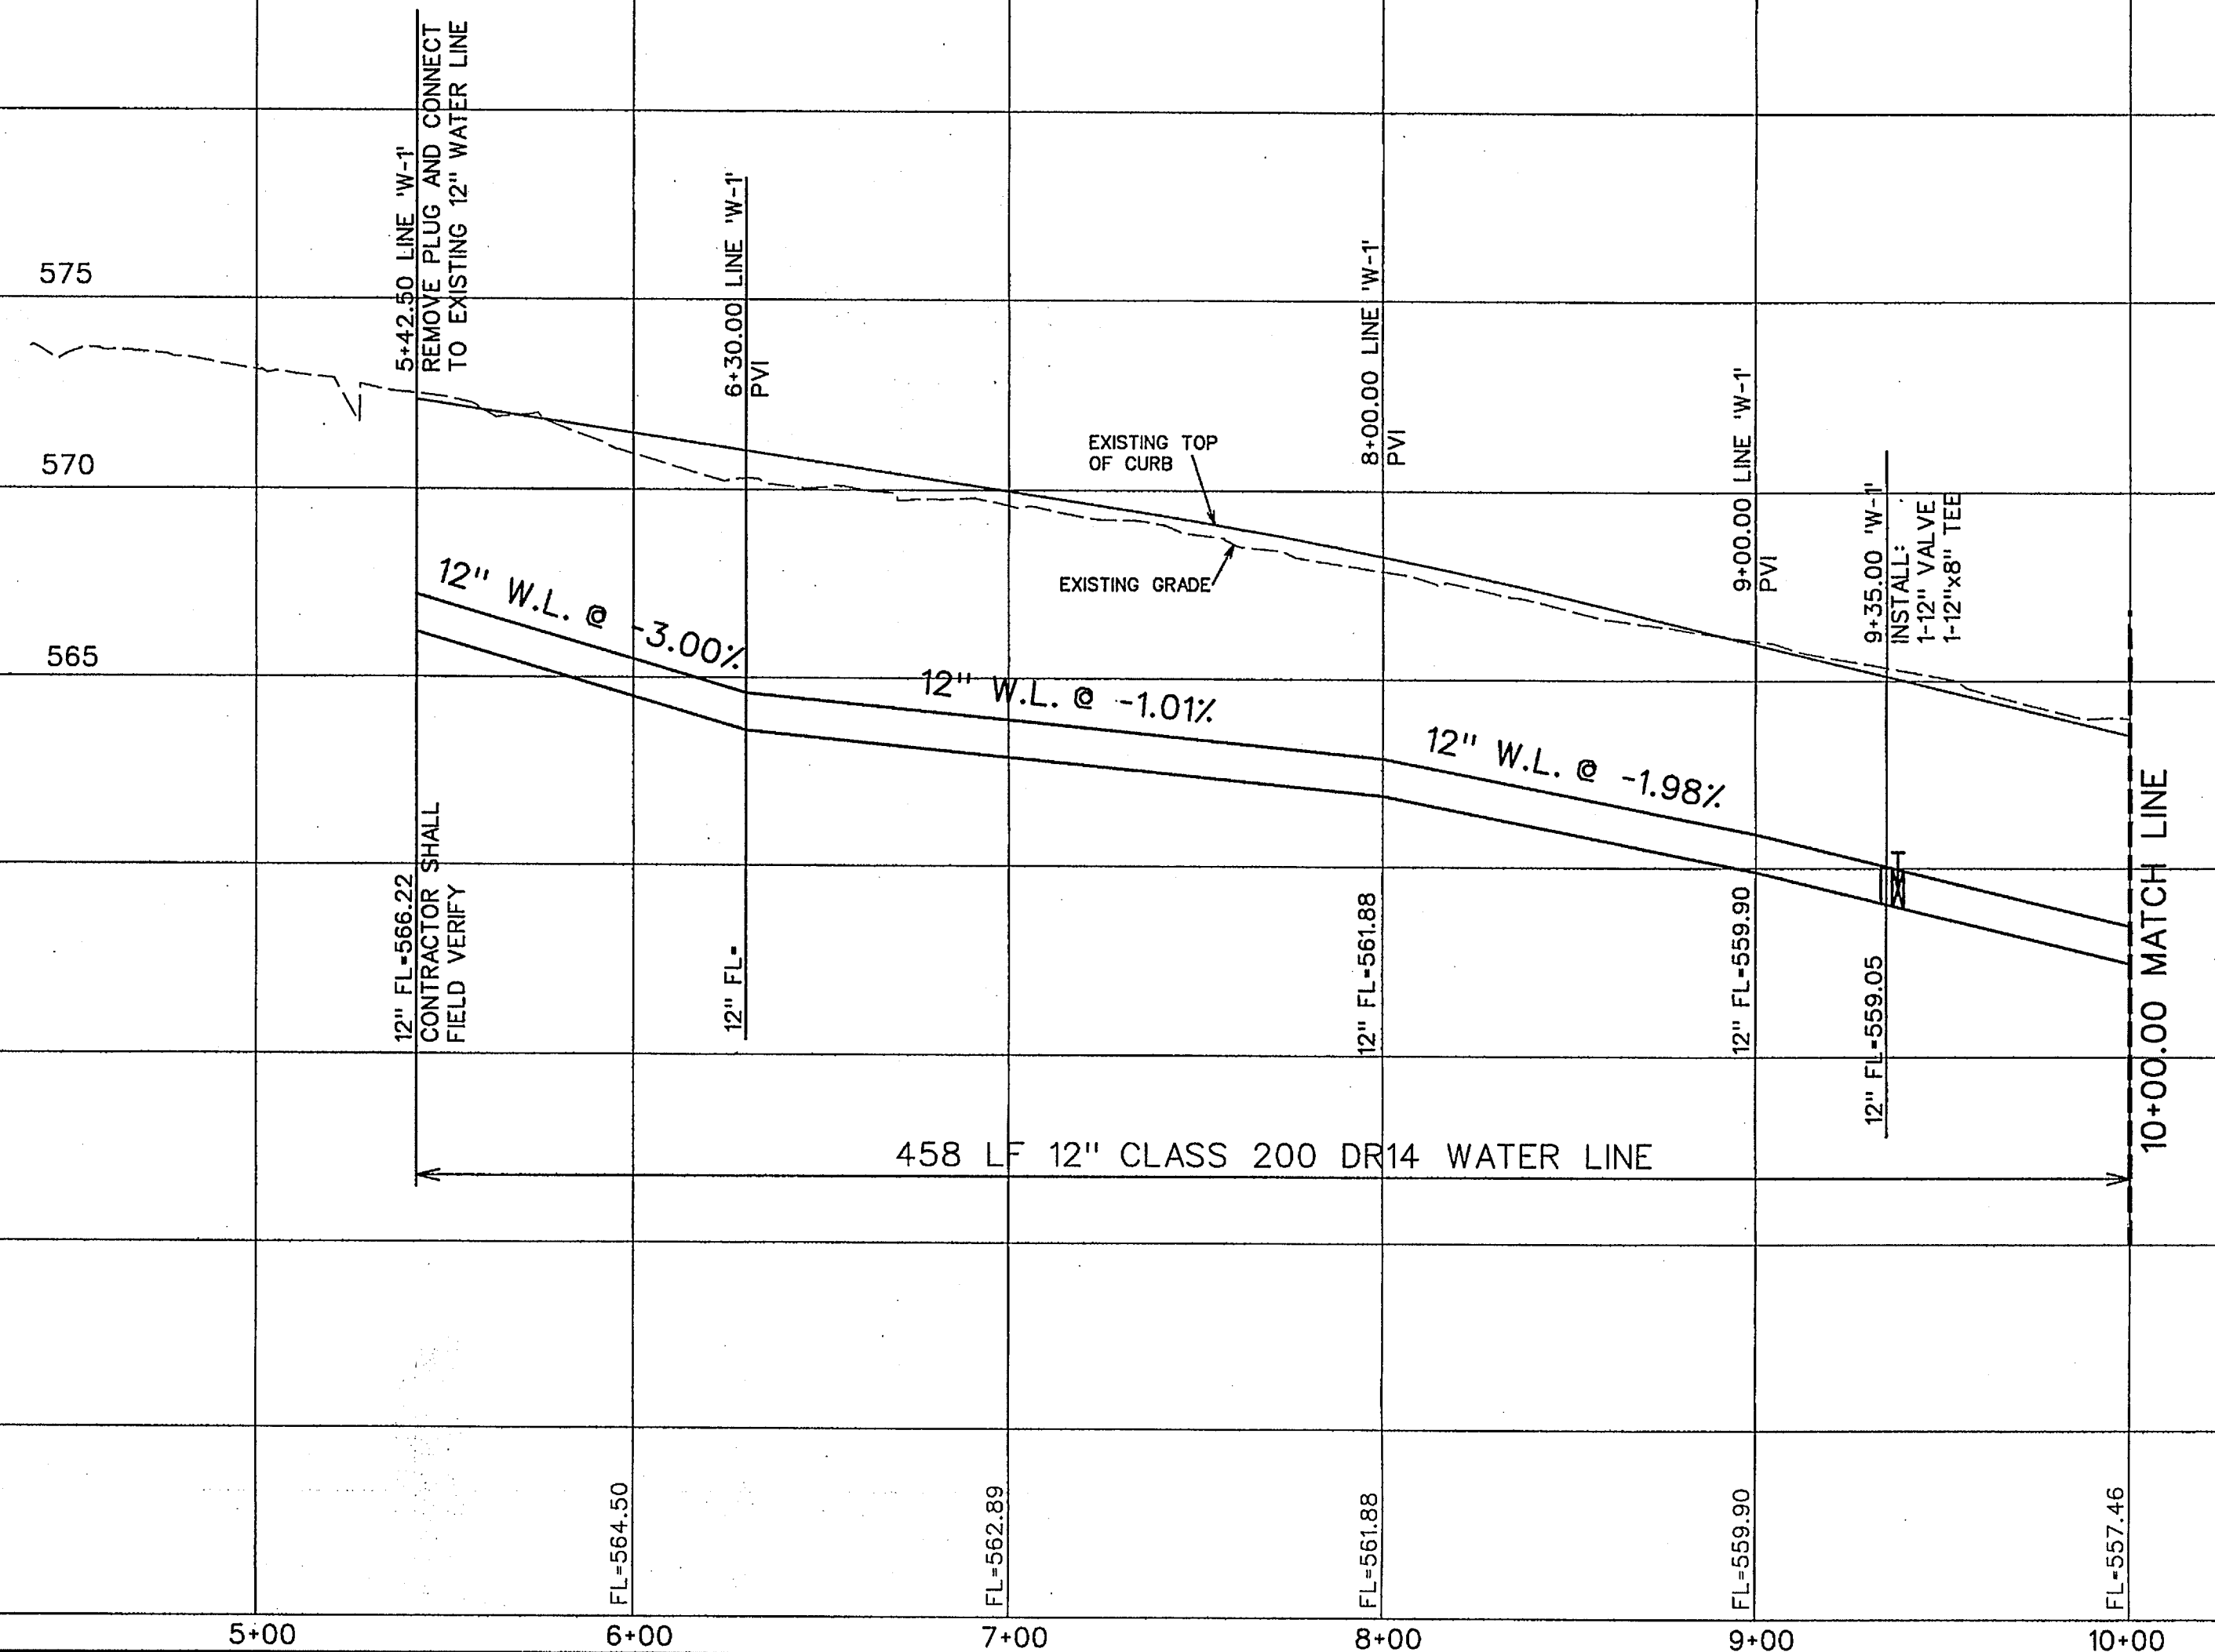

458 LF 12" CLASS 200 DR14 WATER LINE

AS-BUILT JULY 2015  
 INFORMATION PROVIDED  
 BY CONTRACTORS  
 (NOT FIELD VERIFIED)

STATE OF TEXAS  
 BRANDON DAVIDSON  
 87682  
 REGISTERED PROFESSIONAL ENGINEER  
 10/13/14  
 The seal appearing on  
 this document was  
 authorized by  
 Brandon Davidson  
 P.E. 87682, on  
 October 13, 2014


CORWIN ENGINEERING, INC.  
 200 W. BELMONT, SUITE E  
 ALLEN, TEXAS 75013 (972)396-1200  
 TBPE FIRM #5951

DEVELOPMENT PLANS FOR  
 ROCKWALL DOWNS  
 PHASE 1  
 ROCKWALL, TEXAS

12" WATERLINE



DRAWN BY	DESIGNED BY	CHECKED BY	SHEET NO. 9 of 17
JOB NUMBER 14046	DATE SEPTEMBER 2014	SCALE: HOR: 1"=40' VER: 1"=4'	



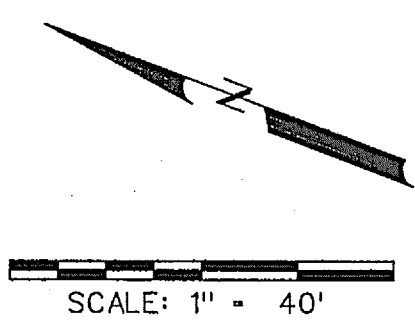


BENCHMARK \*1  
 PK NAIL FOUND IN CENTER OF S. JOHN KING BLVD.  
 20' ± NORTH OF MEDIAN OPENING NEAR NORTHWEST  
 CORNER OF PROPERTY.  
 ELEV. -564.12  
 N. 7021747.513  
 E. 2602779.713

BENCHMARK \*2  
 "X" FOUND ON NORTH END OF TOP OF HEADWALL ON  
 WEST SIDE OF S. JOHN KING BLVD. AT BUFFALO CREEK.  
 ELEV. -550.82  
 N. 7020725.306  
 E. 2602982.310

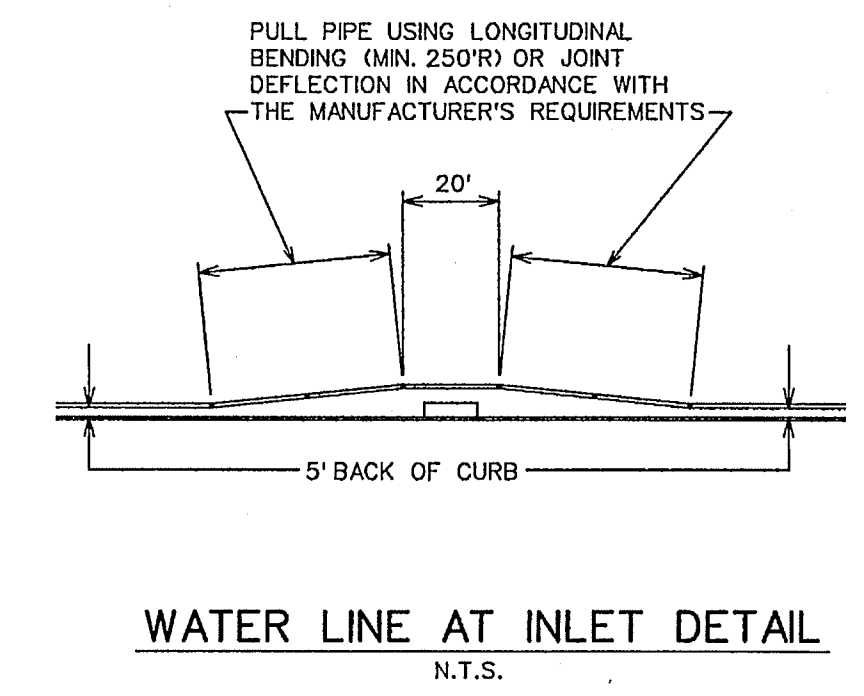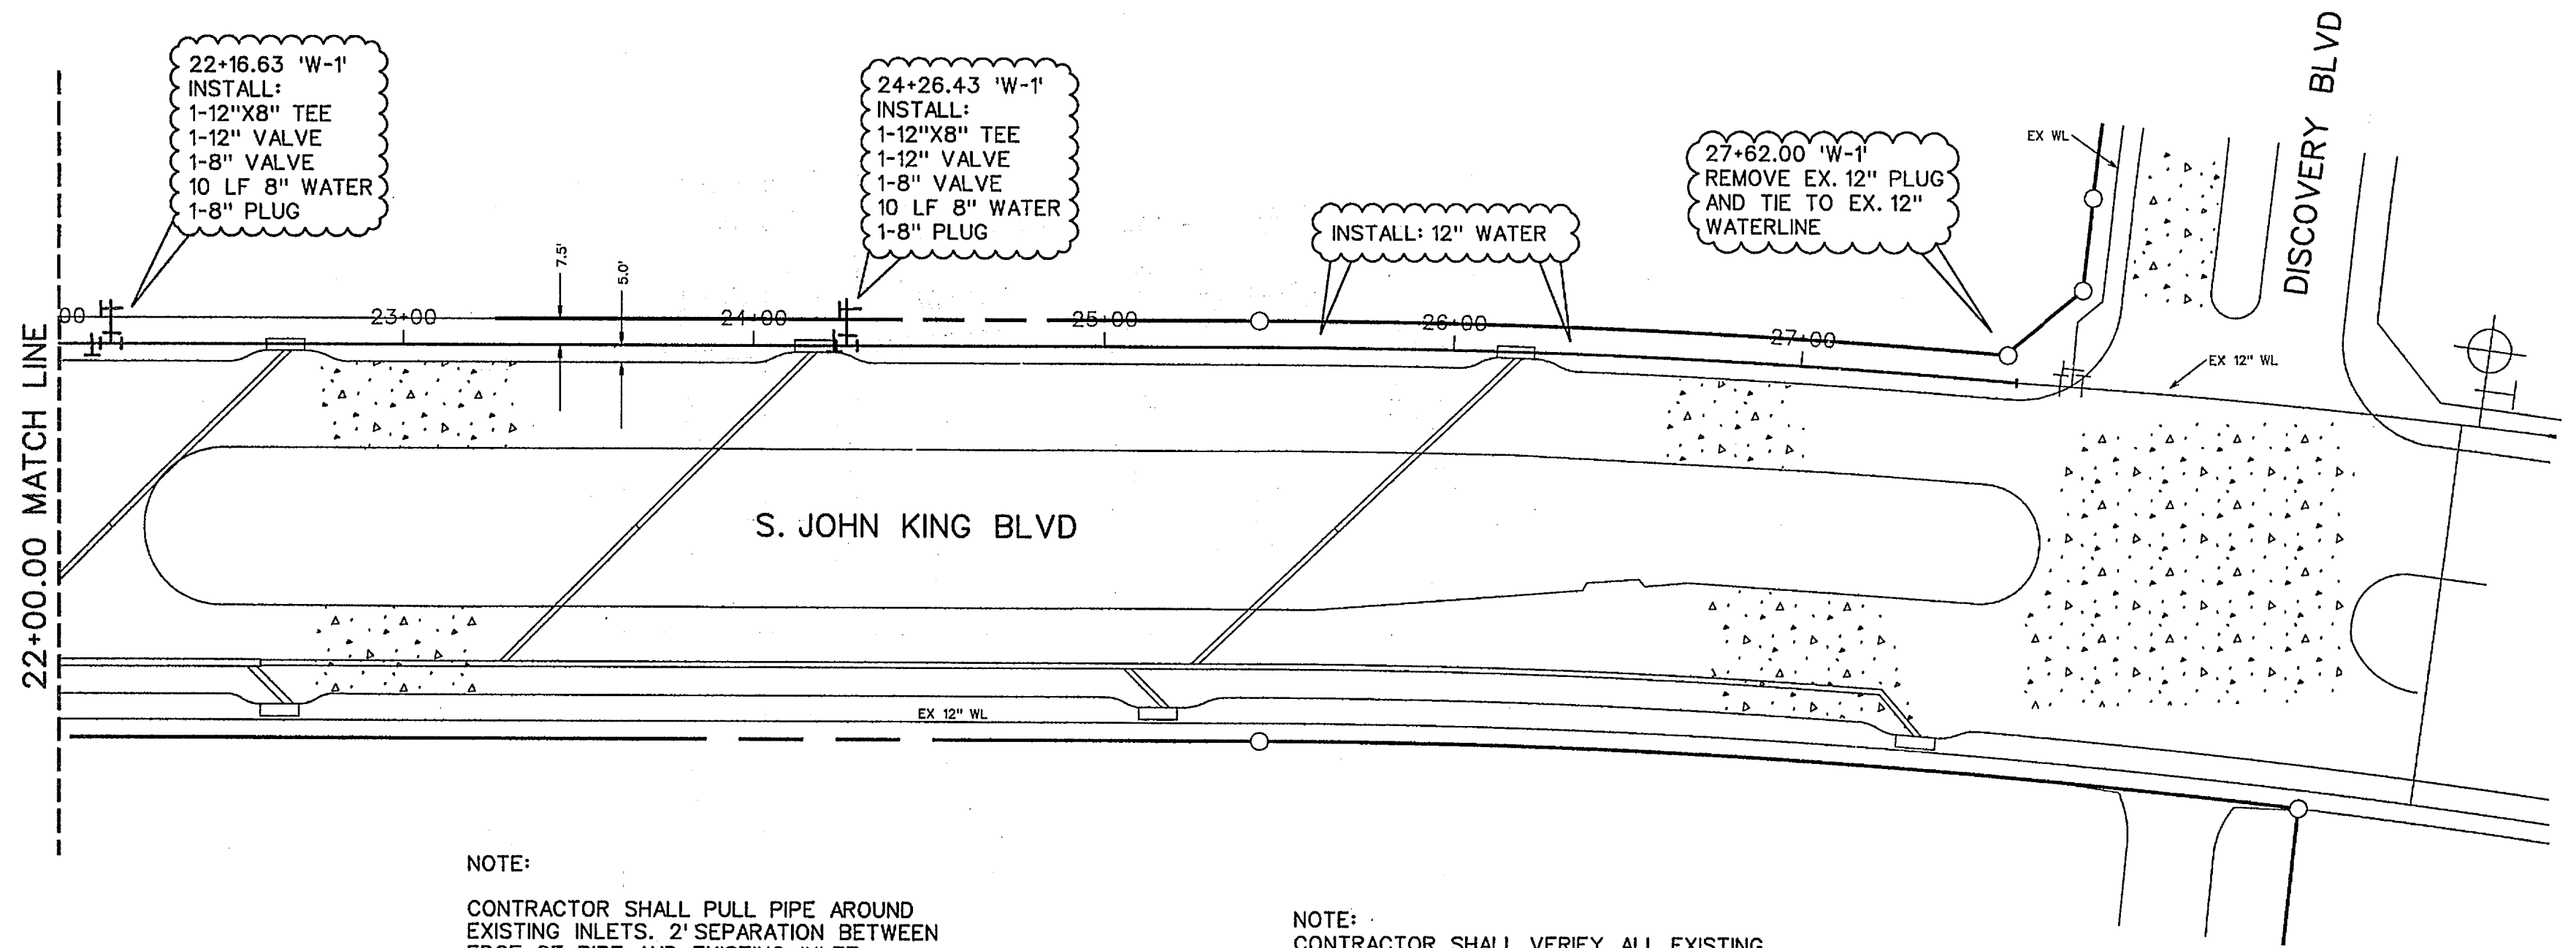


NOTE:  
 CONTRACTOR SHALL PULL PIPE AROUND EXISTING INLETS. 2' SEPARATION BETWEEN EDGE OF PIPE AND EXISTING INLET.

NOTE:  
 CONTRACTOR SHALL VERIFY ALL EXISTING UTILITIES PRIOR TO CONSTRUCTION. EXISTING UTILITY LOCATION AND ELEVATION ARE BASED ON AS-BUILT DRAWINGS AND MAY DIFFER IN ACTUAL LOCATION AND ELEVATION.

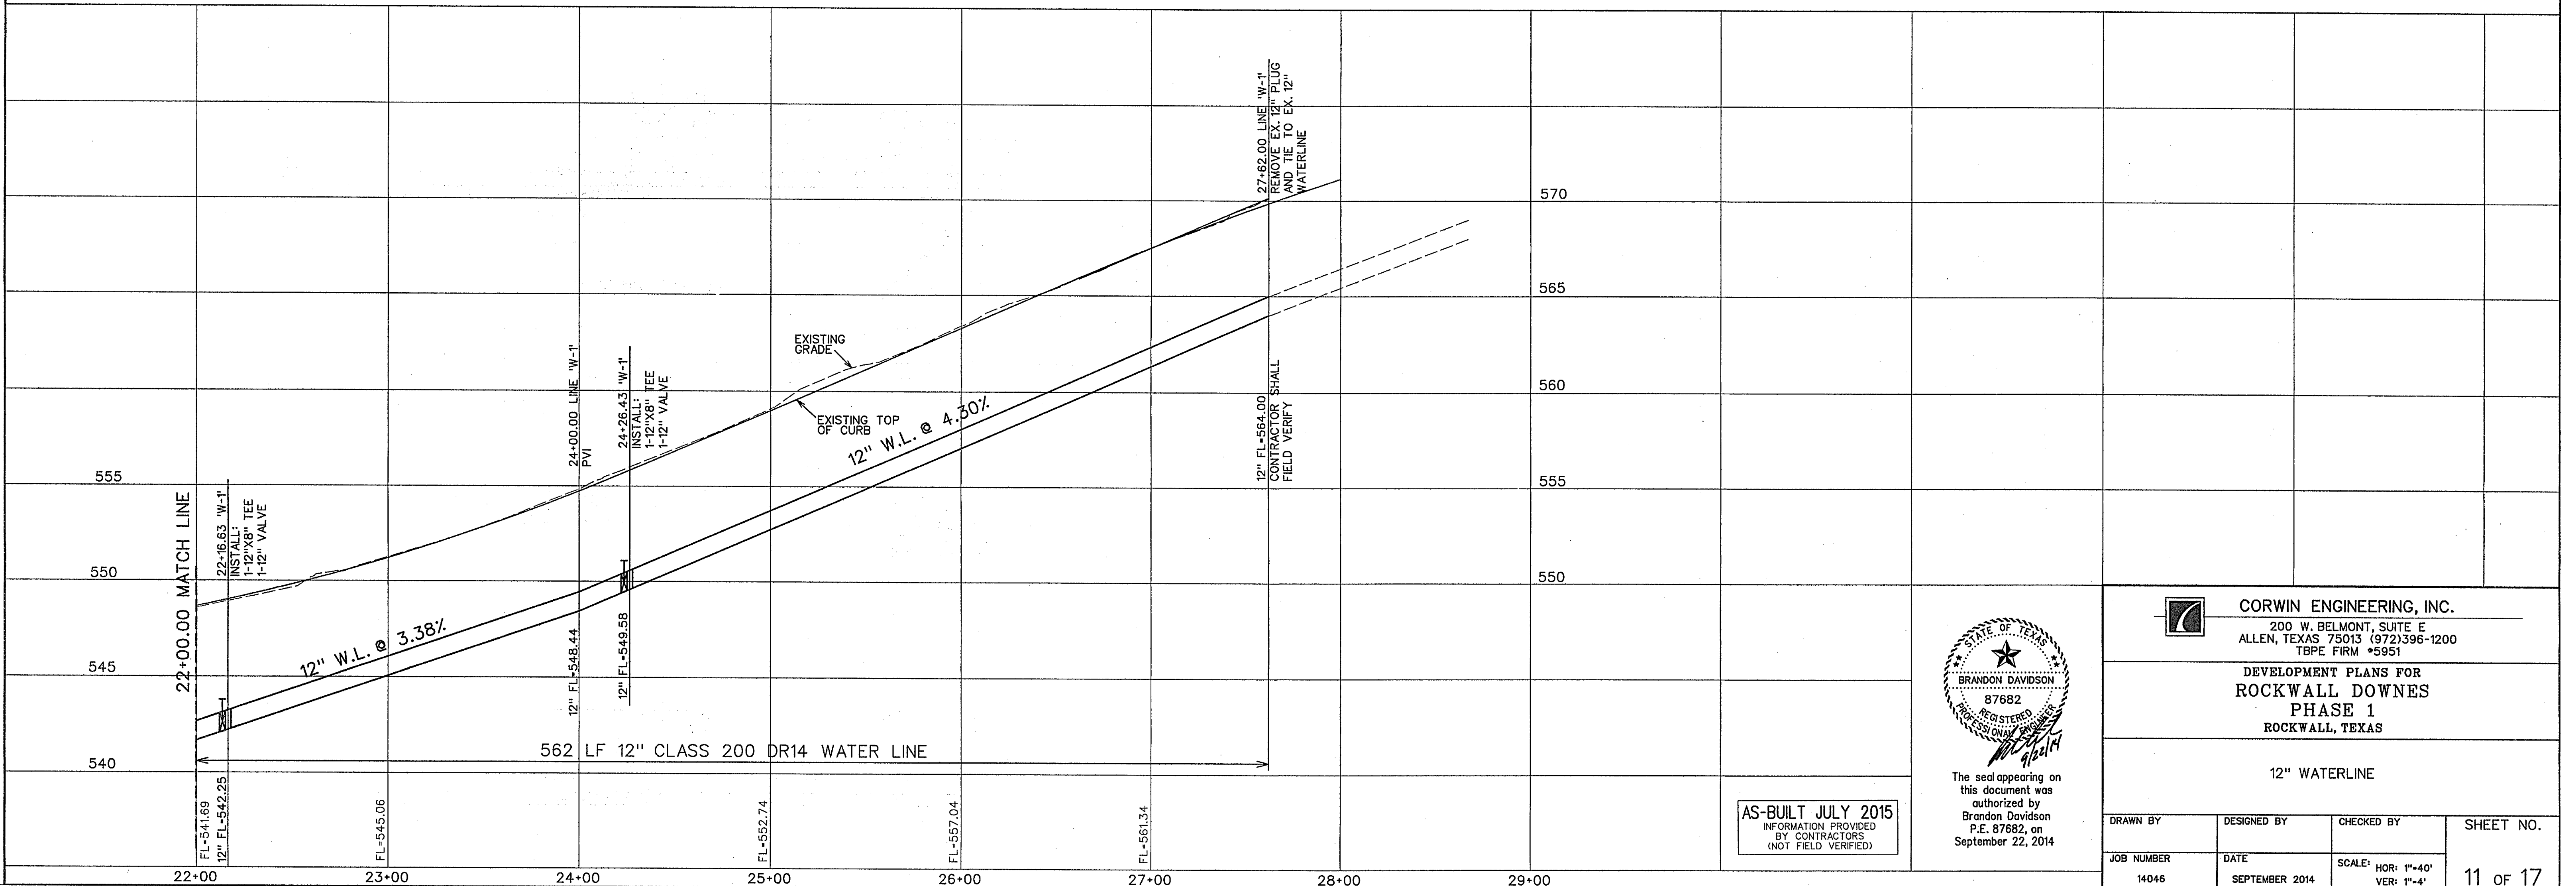

AS-BUILT JULY 2015  
 INFORMATION PROVIDED BY CONTRACTORS (NOT FIELD VERIFIED)

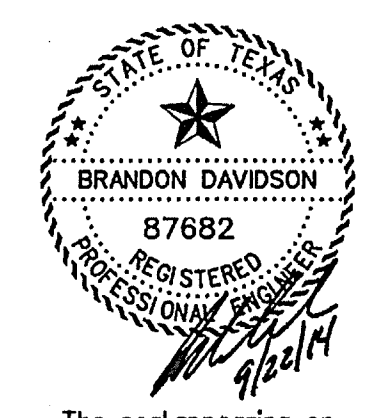



The seal appearing on this document was authorized by Brandon Davidson P.E. 87682, on September 22, 2014

CORWIN ENGINEERING, INC.  
 200 W. BELMONT, SUITE E  
 ALLEN, TEXAS 75013 (972)396-1200  
 TBPE FIRM #5951

DEVELOPMENT PLANS FOR  
 ROCKWALL DOWNES  
 PHASE 1  
 ROCKWALL, TEXAS

12" WATERLINE

DRAWN BY	DESIGNED BY	CHECKED BY	SHEET NO.
JOB NUMBER	DATE	SCALE: HOR: 1"=40' VER: 1"=4'	11 of 17
14046	SEPTEMBER 2014		

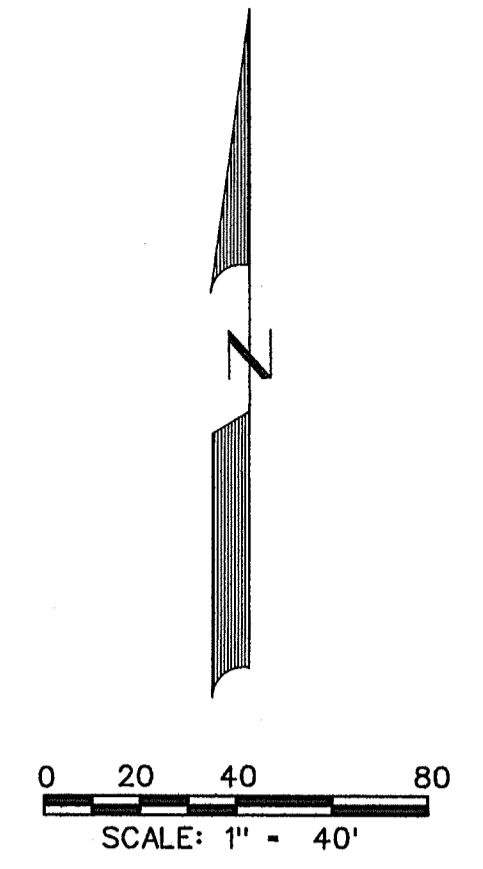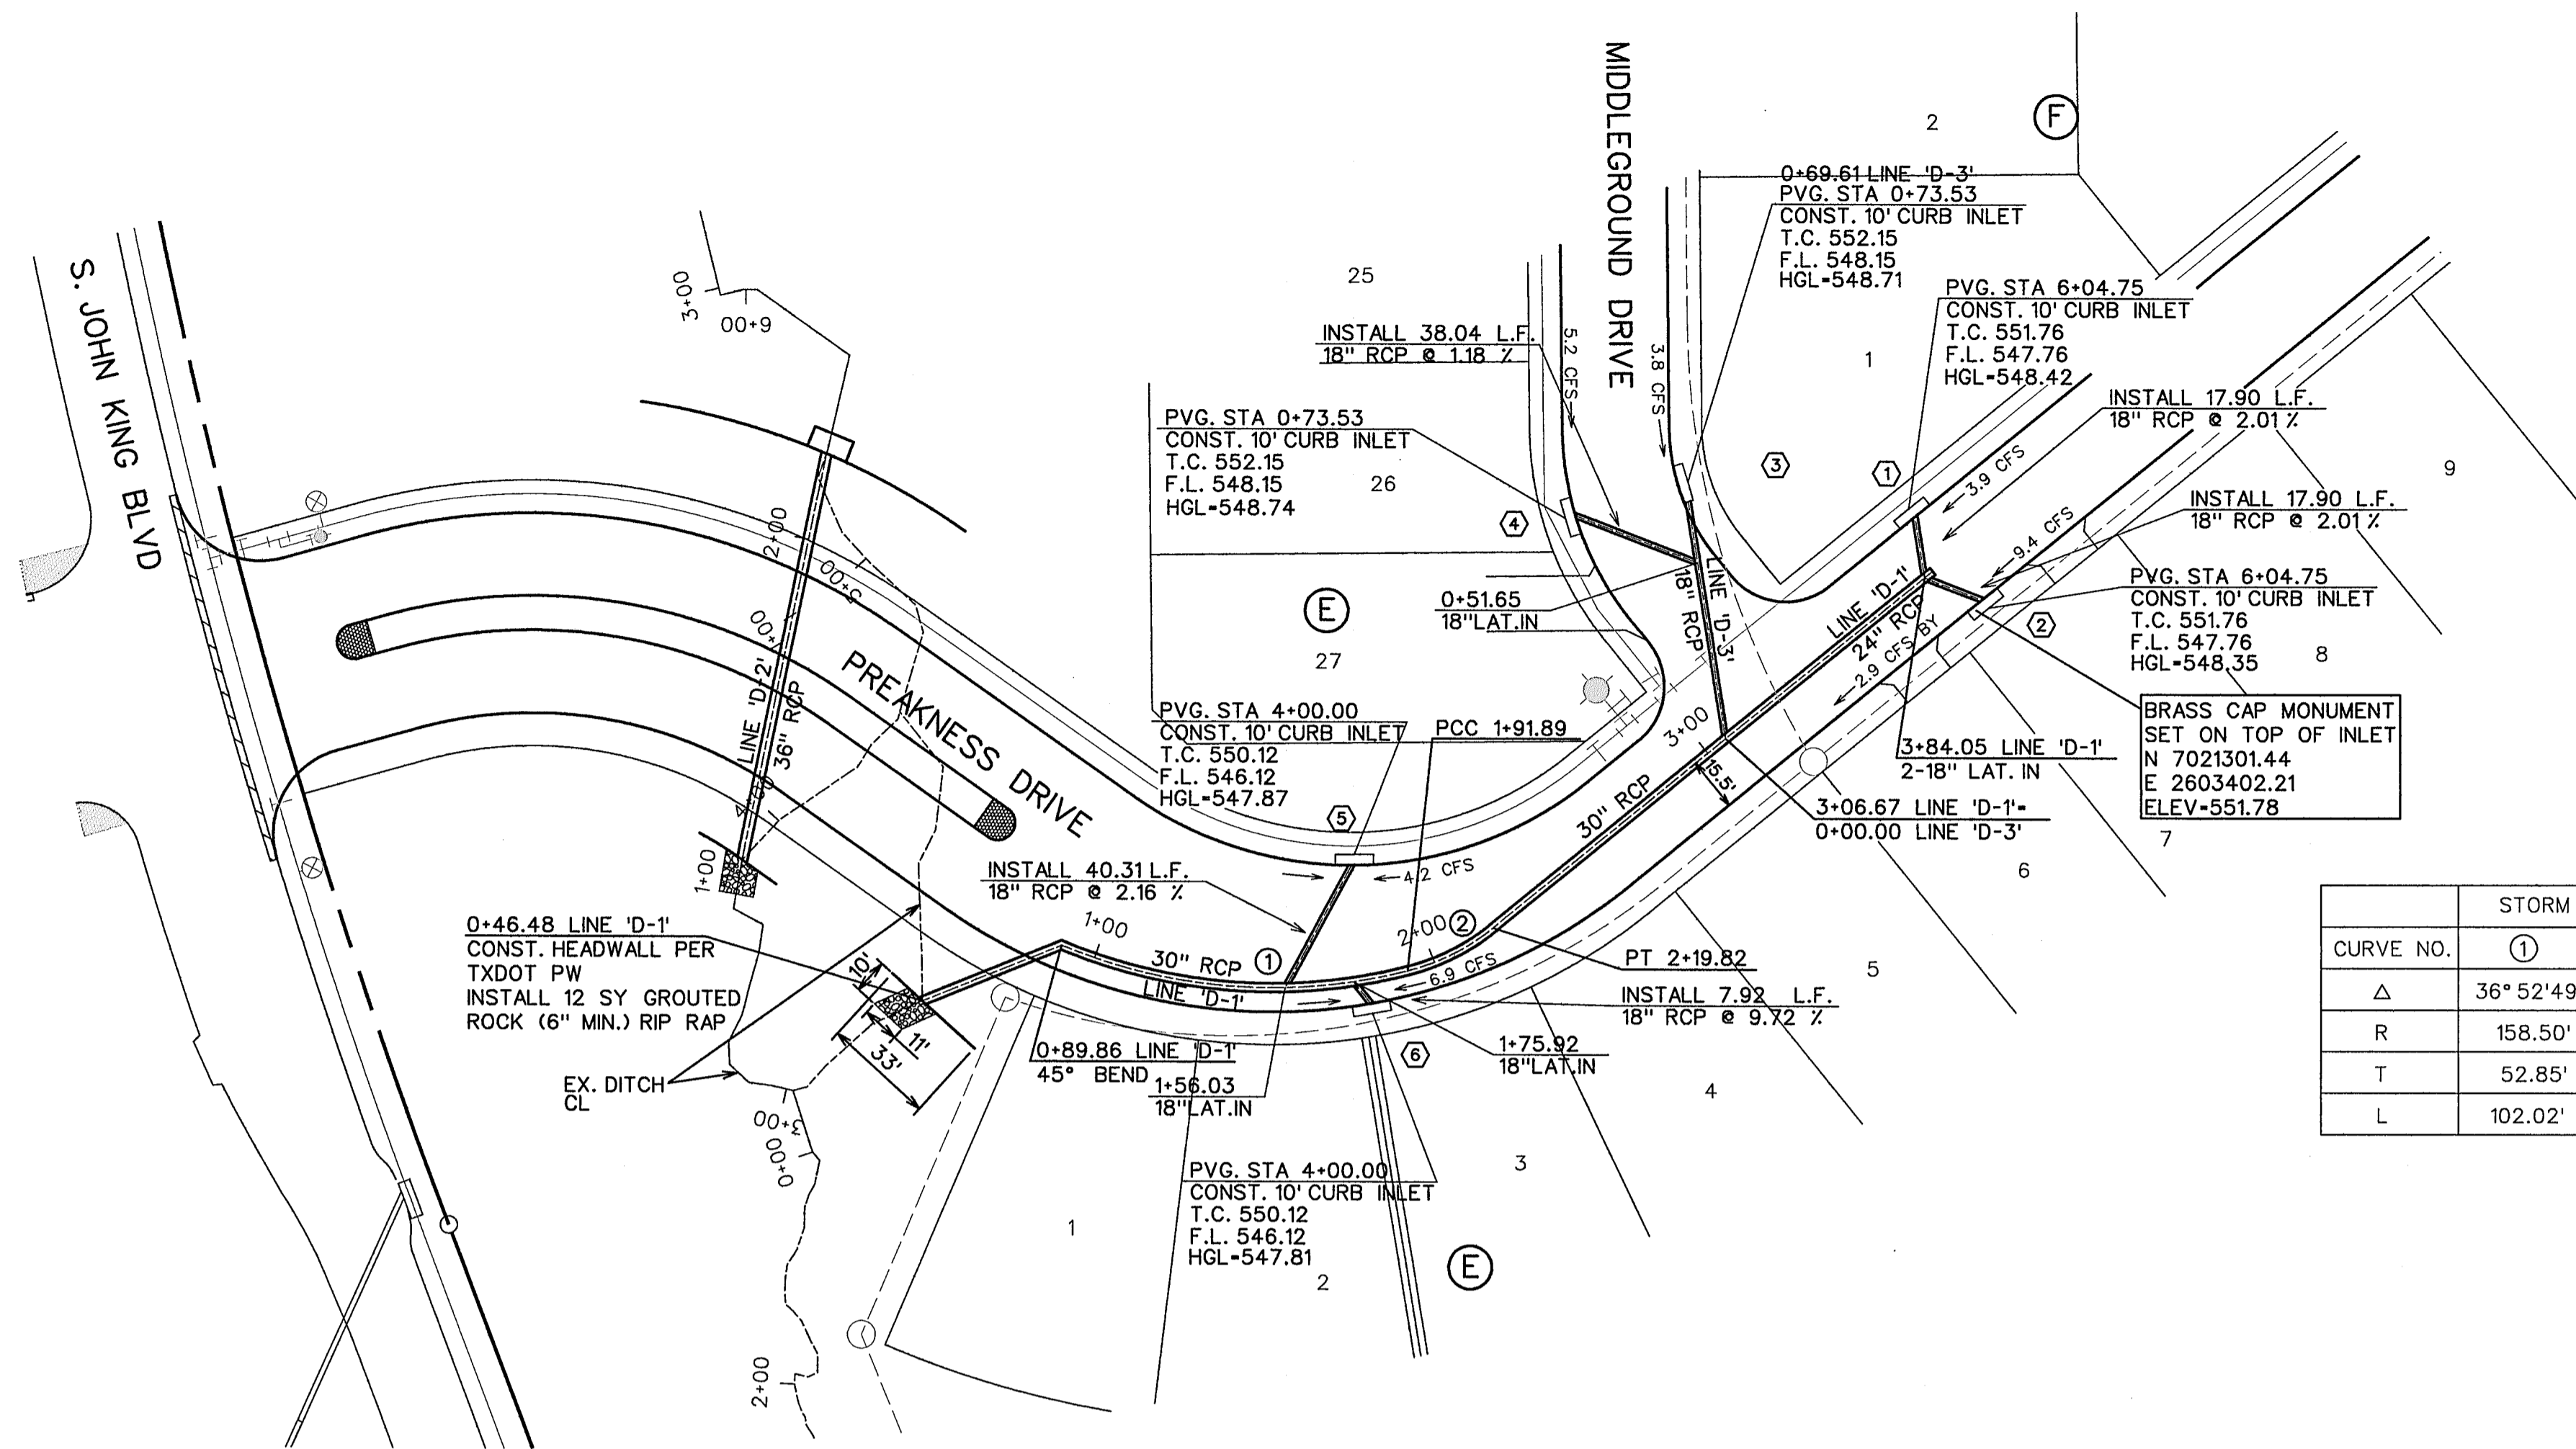

STORM SEWER CURVE DATA			
CURVE NO.	①	②	③
Δ	36° 52' 49"	24° 37' 12"	° ' "
R	158.50'	65.00'	'
T	52.85'	14.18'	'
L	102.02'	27.93'	'

BENCHMARK \*1  
 PK NAIL FOUND IN CENTER OF S. JOHN KING BLVD.  
 20' ± NORTH OF MEDIAN OPENING NEAR NORTHWEST  
 CORNER OF PROPERTY.

ELEV. -564.12  
 N. 7021747.513  
 E. 2602779.713


BENCHMARK \*2  
 "X" FOUND ON NORTH END OF TOP OF HEADWALL ON  
 WEST SIDE OF S. JOHN KING BLVD. AT BUFFALO CREEK.

ELEV. -550.82  
 N. 7020725.306  
 E. 2602982.310

- LEGEND**
- ⓑ - BLOCK LABEL
  - Ⓜ - INLET NUMBER
  - ① - CURVE NUMBER
  - - SANITARY SEWER
  - +— - WATER
  - ||— - PROPOSED STORM SEWER



AS-BUILT JULY 2015  
 INFORMATION PROVIDED  
 BY CONTRACTORS  
 (NOT FIELD VERIFIED)

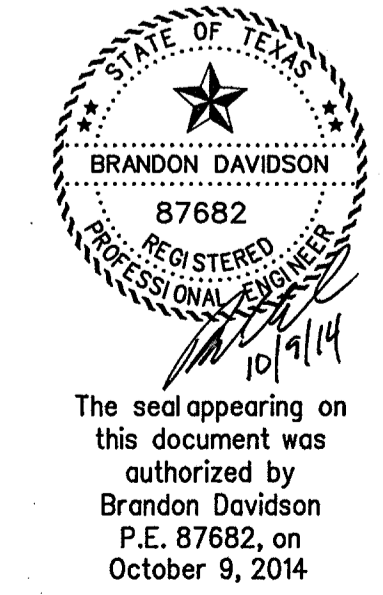


**CORWIN ENGINEERING, INC.**  
 200 W. BELMONT, SUITE E  
 ALLEN, TEXAS 75013 (972)396-1200  
 TBPE FIRM #5951

**DEVELOPMENT PLANS FOR  
 ROCKWALL DOWNS  
 PHASE 1  
 ROCKWALL, TEXAS**

STORM SEWER PLAN AND PROFILE  
 LINES 'D-1' & 'D-3'

DRAWN BY	DESIGNED BY	CHECKED BY	SHEET NO.
JOB NUMBER	DATE	SCALE: HOR: 1"=40' VER: 1"=4'	12 OF 17

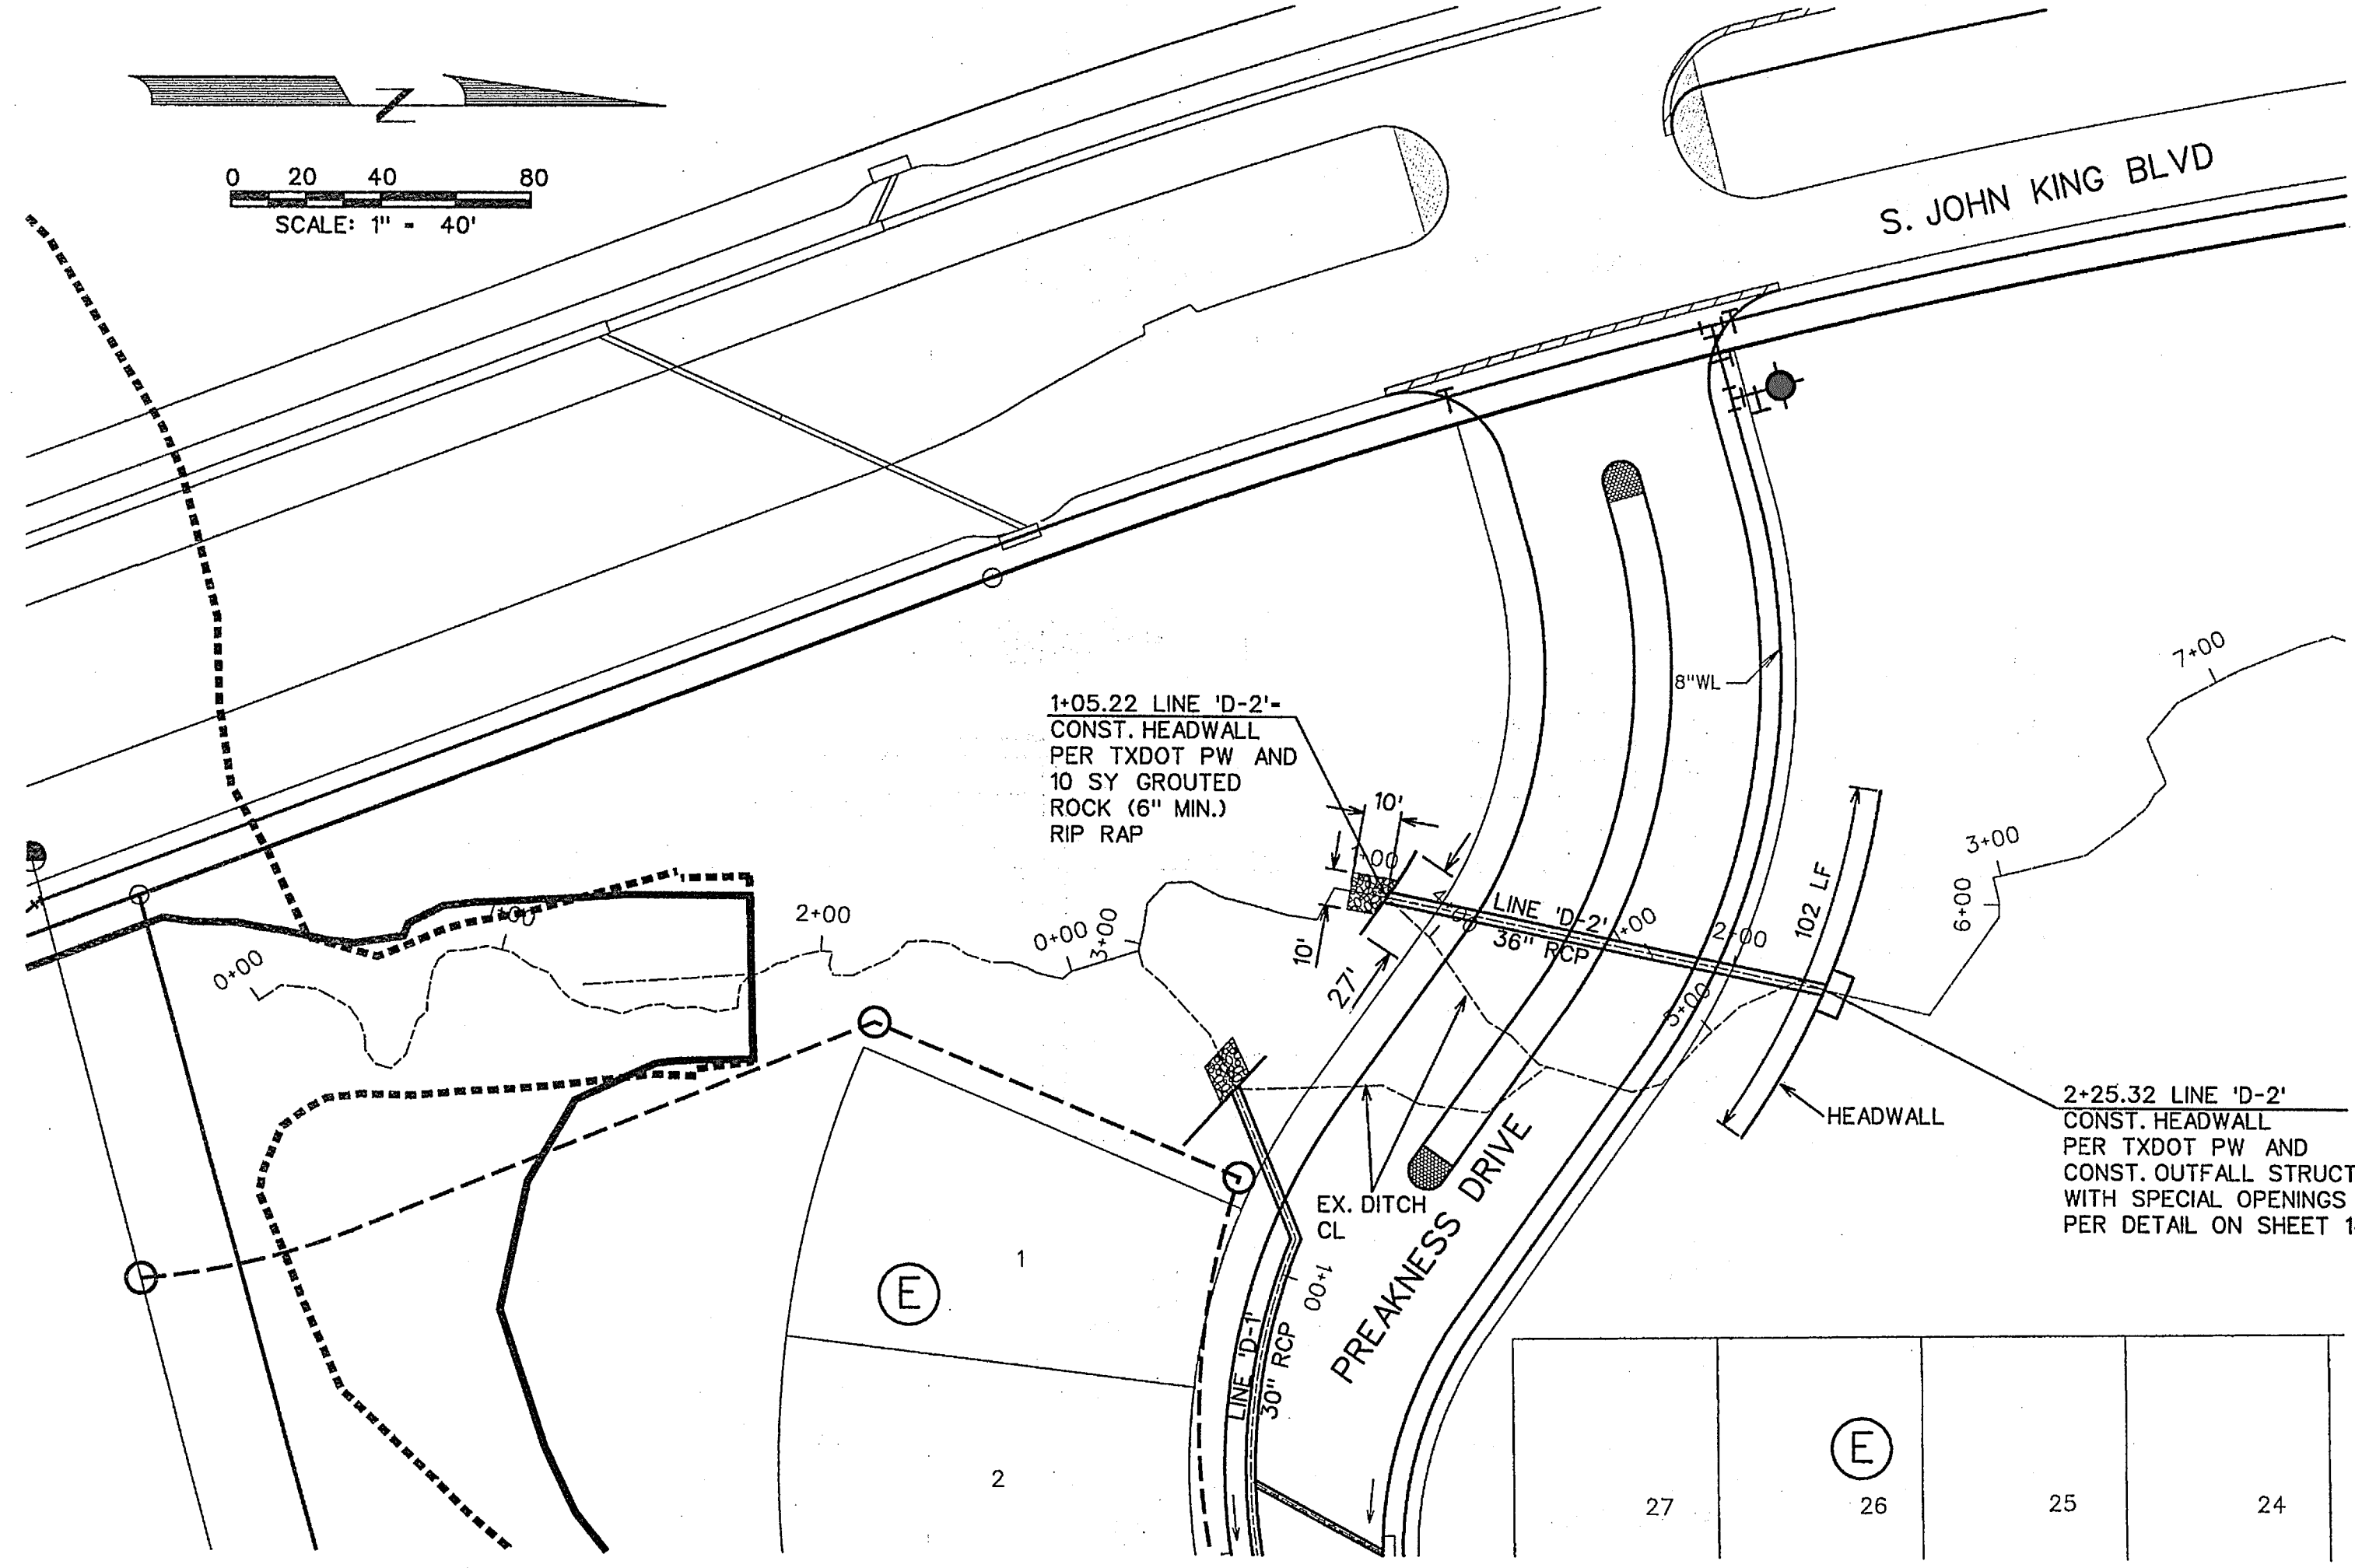


Upstream Station	Downstream Station	Distance (ft)	AREA NO.	Total Area (Acres)	Roaded Up (Acres)	C	CA	Accumulated CA	Tc (Min)	Design Storm (Years)	I (in/hr)	Q (CFS)	S (ft/ft)	Pipe Size (in)	Velocity (fps)	Head Loss (ft)	Flow Time (Min)	Time at D/S (Min)	ΔVelocity Head (ft)	Hydraulic Grade Upstream	Hydraulic Grade Downstream	Proposed Grade
Line D1																						
3+07.05	3+06.67	80.38	1,2	2.71	2.10	0.50	1.05	1.05	10.00	100	9.89	10.3	0.0021	24	3.3	0.17	0.41	10.41	0.17	548.27	548.27	551.76
3+06.67	1+75.92	130.75	9	1.03	1.83	0.50	0.91	1.96	10.00	100	9.89	19.3	0.0022	30	3.9	0.24	0.56	10.56	0.07	548.10	548.03	550.75
1+75.92	1+56.03	19.89	6	0.82	1.41	0.50	0.71	2.67	10.00	100	9.89	26.3	0.0041	30	5.3	0.44	0.56	10.56	0.20	547.74	547.54	550.12
1+56.03	0+46.48	109.55	5A,5B	0.91	0.91	0.47	0.43	3.10	10.00	100	9.89	30.4	0.0055	30	6.2	0.60	0.29	10.29	0.16	547.46	547.30	550.12
0+46.48																						
Line D2																						
2+25.32	1+05.22	120.10	Pond	26.05	26.05	0.50	13.03	13.03	10.00	100	9.89	33.0	0.0025	36	4.7	0.34	0.43	10.43	0.34	547.30	547.59	
1+05.22																						
Line D3																						
0+59.61	0+51.65	17.96	3	0.77	0.77	0.50	0.39	0.39	10.00	100	9.89	3.8	0.0013	18	2.2	0.08	0.14	10.14	0.08	548.60	548.60	552.22
0+51.65	0+00.00	51.65	4	1.06	1.06	0.50	0.53	0.92	10.00	100	9.89	9.0	0.0074	18	5.1	0.40	0.17	10.17	0.22	548.65	548.33	551.76
0+00.00																						

BENCHMARK #1  
 PK NAIL FOUND IN CENTER OF S. JOHN KING BLVD.  
 20' ± NORTH OF MEDIAN OPENING NEAR NORTHWEST  
 CORNER OF PROPERTY.  
 ELEV.-564.12  
 N. 7021747.513  
 E. 2602779.713

BENCHMARK #2  
 "X" FOUND ON NORTH END OF TOP OF HEADWALL ON  
 WEST SIDE OF S. JOHN KING BLVD. AT BUFFALO CREEK.  
 ELEV.-550.82  
 N. 7020725.306  
 E. 2602982.310

- LEGEND**
- (B) - BLOCK LABEL
  - (IN) - INLET NUMBER
  - (C) - CURVE NUMBER
  - (S) - SANITARY SEWER
  - (W) - WATER
  - (SS) - PROPOSED STORM SEWER

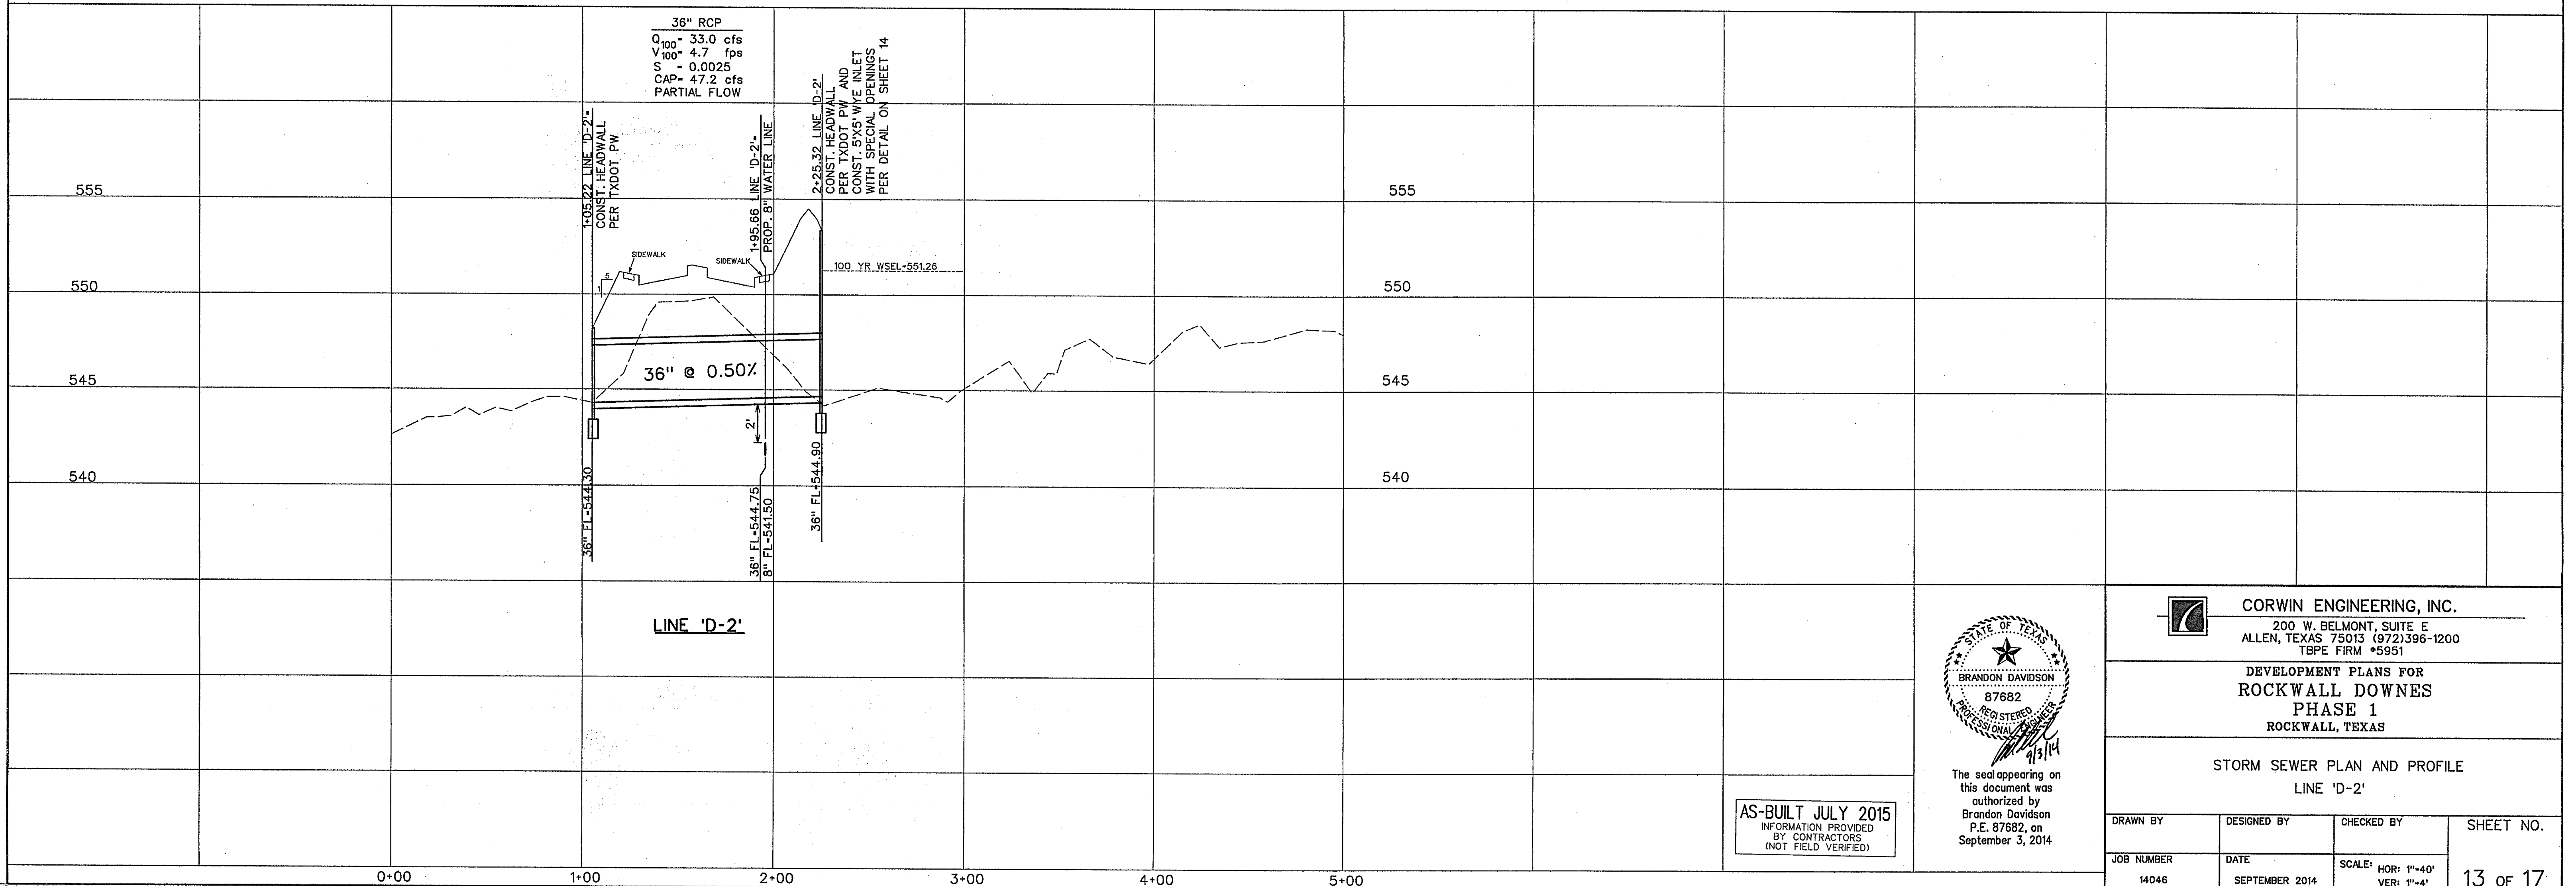

36" RCP  
 Q<sub>100</sub> = 33.0 cfs  
 V<sub>100</sub> = 4.7 fps  
 S = 0.0025  
 CAP = 47.2 cfs  
 PARTIAL FLOW

1+05.22 LINE 'D-2'  
 CONST. HEADWALL  
 PER TXDOT PW

1-95.66 LINE 'D-2'  
 PROP. 8" WATER LINE

2+25.32 LINE 'D-2'  
 CONST. HEADWALL  
 PER TXDOT PW AND  
 CONST. 5X5' WVE INLET  
 WITH SPECIAL OPENINGS  
 PER DETAIL ON SHEET 14

36" FL=544.30

36" FL=544.75  
 8" FL=541.50

36" FL=544.90

100 YR WSEL-551.26

LINE 'D-2'

AS-BUILT JULY 2015  
 INFORMATION PROVIDED  
 BY CONTRACTORS  
 (NOT FIELD VERIFIED)



The seal appearing on  
 this document was  
 authorized by  
 Brandon Davidson  
 P.E. 87682, on  
 September 3, 2014

**CORWIN ENGINEERING, INC.**  
 200 W. BELMONT, SUITE E  
 ALLEN, TEXAS 75013 (972)396-1200  
 TBPE FIRM #5951

DEVELOPMENT PLANS FOR  
**ROCKWALL DOWNES**  
 PHASE 1  
 ROCKWALL, TEXAS

STORM SEWER PLAN AND PROFILE  
 LINE 'D-2'

DRAWN BY	DESIGNED BY	CHECKED BY	SHEET NO.
JOB NUMBER	DATE	SCALE: HOR: 1"=40' VER: 1"=4'	13 OF 17
14046	SEPTEMBER 2014		

**DETENTION ALLOWABLE RELEASE RATE CALCULATIONS**

THE DETENTION POND FOR PHASE 1 ALSO PROVIDES DETENTION FOR PHASES 2 AND 3 AND AREA OS6 BY OVERTAINING RUNOFF FROM DRAINAGE AREAS 8, 9, AND OS2-OS6 SO THAT THE PEAK RUNOFF WILL NOT BE INCREASED WHEN AREA OS6 IS DEVELOPED AND DRAINS INTO THE DETENTION POND AND PHASES 2 AND 3 ARE CONSTRUCTED AND DRAIN DIRECTLY INTO BUFFALO CREEK. THIS ANALYSIS ASSUMES OS1-OS5 WILL PROVIDE THEIR OWN DETENTION

**Rockwall Downs**  
**2-Year Storm**  
**Pre-Project Runoff Calculations**

Area #	Area (sf)	Area (acres)	Runoff Coefficient	Tc (min)	Rainfall Intensity (in/hr)	Q (cfs)
Phase 1	334983	7.69	0.5	10	5.3	20.4
Phase 2	264179	6.06	0.35	20	3.9	15.9
Phase 3	252067	5.79	0.35	20	3.9	15.2
OS6	138840	3.19	0.35	20	3.9	4.4
Total=						47.1
Allowed Release=						31.0

**Post-Project Runoff Calculations**

Area #	Area (sf)	Area (acres)	Runoff Coefficient	Tc (min)	Rainfall Intensity (in/hr)	Q (cfs)
Phase 1	334983	7.69	0.5	10	5.3	20.4
Phase 2	264179	6.06	0.5	10	5.3	18.1
Phase 3	252067	5.79	0.5	10	5.3	16.3
OS6	138840	3.19	0.9	10	5.3	15.2
Total=						67.0
Peak Flow Must Be Reduced By (Developed-Allowed)						36.0

**10-Year Storm**  
**Pre-Project Runoff Calculations**

Area #	Area (sf)	Area (acres)	Runoff Coefficient	Tc (min)	Rainfall Intensity (in/hr)	Q (cfs)
Phase 1	334983	7.69	0.35	20	5.9	12.9
Phase 2	264179	6.06	0.35	20	5.9	15.9
Phase 3	252067	5.79	0.35	20	5.9	15.9
OS6	138840	3.19	0.35	20	5.9	6.6
Total=						46.9
Allowed Release=						28.5

**Post-Project Runoff Calculations**

Area #	Area (sf)	Area (acres)	Runoff Coefficient	Tc (min)	Rainfall Intensity (in/hr)	Q (cfs)
Phase 1	334983	7.69	0.5	10	7.1	27.3
Phase 2	264179	6.06	0.5	10	7.1	21.5
Phase 3	252067	5.79	0.5	10	7.1	20.5
OS6	138840	3.19	0.9	10	7.1	20.4
Total=						89.7
Peak Flow Must Be Reduced By (Developed-Allowed)						42.8

**25-Year Storm**  
**Pre-Project Runoff Calculations**

Area #	Area (sf)	Area (acres)	Runoff Coefficient	Tc (min)	Rainfall Intensity (in/hr)	Q (cfs)
Phase 1	334983	7.69	0.35	20	6.6	17.8
Phase 2	264179	6.06	0.35	20	6.6	14.0
Phase 3	252067	5.79	0.35	20	6.6	13.4
OS6	138840	3.19	0.35	20	6.6	7.4
Total=						52.6
Allowed Release=						32.7

**Post-Project Runoff Calculations**

Area #	Area (sf)	Area (acres)	Runoff Coefficient	Tc (min)	Rainfall Intensity (in/hr)	Q (cfs)
Phase 1	334983	7.69	0.5	10	8.3	31.9
Phase 2	264179	6.06	0.5	10	8.3	25.2
Phase 3	252067	5.79	0.5	10	8.3	23.8
OS6	138840	3.19	0.9	10	8.3	23.8
Total=						104.9
Peak Flow Must Be Reduced By (Developed-Allowed)						52.4

**50-Year Storm**  
**Pre-Project Runoff Calculations**

Area #	Area (sf)	Area (acres)	Runoff Coefficient	Tc (min)	Rainfall Intensity (in/hr)	Q (cfs)
Phase 1	334983	7.69	0.35	20	7.5	20.2
Phase 2	264179	6.06	0.35	20	7.5	15.9
Phase 3	252067	5.79	0.35	20	7.5	15.2
OS6	138840	3.19	0.35	20	7.5	8.4
Total=						59.7
Allowed Release=						37.7

**Post-Project Runoff Calculations**

Area #	Area (sf)	Area (acres)	Runoff Coefficient	Tc (min)	Rainfall Intensity (in/hr)	Q (cfs)
Phase 1	334983	7.69	0.5	10	9	34.6
Phase 2	264179	6.06	0.5	10	9	27.3
Phase 3	252067	5.79	0.5	10	9	26.0
OS6	138840	3.19	0.9	10	9	25.8
Total=						113.8
Peak Flow Must Be Reduced By (Developed-Allowed)						54.1

**100-Year Storm**  
**Pre-Project Runoff Calculations**

Area #	Area (sf)	Area (acres)	Runoff Coefficient	Tc (min)	Rainfall Intensity (in/hr)	Q (cfs)
Phase 1	334983	7.69	0.35	20	8.3	22.3
Phase 2	264179	6.06	0.35	20	8.3	17.8
Phase 3	252067	5.79	0.35	20	8.3	16.8
OS6	138840	3.19	0.35	20	8.3	9.3
Total=						66.0
Allowed Release=						37.7

**Post-Project Runoff Calculations**

Area #	Area (sf)	Area (acres)	Runoff Coefficient	Tc (min)	Rainfall Intensity (in/hr)	Q (cfs)
Phase 1	334983	7.69	0.5	10	9.8	37.7
Phase 2	264179	6.06	0.5	10	9.8	29.7
Phase 3	252067	5.79	0.5	10	9.8	28.4
OS6	138840	3.19	0.9	10	9.8	28.1
Total=						123.9
Peak Flow Must Be Reduced By (Developed-Allowed)						57.8

**Elevation-Storage Table**

Elevation (cf)	Volume (cfs)
545	0
546	612
547	1113
548	14330
549	30321
550	56171
551	91574
552	124107
553	163795

**Stage-Discharge Table**

Stage	H	Area	Discharge	Weir Length	Depth of Flow Over Weir	Weir Discharge	Total Discharge	Allowable Discharge	Above (Below)
545.00	0	1.00	3.7	20.0	0.0	0.0	3.7		
546.00	0.60	0.92	5.6	20.0	0.0	0.0	5.6		
547.00	1.60	0.92	7.1	20.0	0.0	0.0	7.1		
548.00	2.60	0.92	8.4	20.0	0.0	0.0	8.4		
549.00	3.60	0.92	9.5	20.0	0.0	0.0	9.5		
550.00	4.60	0.92	9.5	20.0	0.0	0.0	9.5		
550.22	4.82	0.92	9.7	20.0	0.0	0.0	9.7	11.3	(1.6)
550.98	5.58	0.92	10.4	20.0	0.27	7.6	18.0	25.8	(7.7)
551.00	5.60	0.92	10.4	20.0	0.30	8.6	19.1		
551.10	5.70	0.92	10.6	20.0	0.39	13.1	23.6	25.4	(1.8)
551.21	5.81	0.92	10.6	20.0	0.51	19.1	29.7	33.0	(3.2)
551.27	5.87	0.92	10.7	20.0	0.58	22.3	33.0	38.0	(5.0)
552.00	6.60	0.92	11.3	20.0	1.30	78.0	89.3		
553.00	7.60	0.92	12.2	20.0	2.30	183.5	195.6		

AS-BUILT JULY 2015  
INFORMATION PROVIDED BY CONTRACTORS (NOT FIELD VERIFIED)

**DETENTION STORAGE REQUIREMENT CALCULATIONS**

**DETENTION CALCULATIONS - 2 Year**

Storm Duration	Outflow Duration	Area (AC.)	Future "C"	Future "K"	Future "CA"	Rainfall Intensity	Inflow (cfs)	Volume (cubic ft.)	Volume (cubic ft.)	Volume (cubic ft.)	Volume (cubic ft.)	Outflow (cfs)
10	20	26.05	0.41	1.00	10.64	5.30	56.4	33846	5811	28635	0.64	9.7
20	30	26.05	0.41	1.00	10.64	3.90	41.5	49811	8717	41095	0.84	9.7
30	40	26.05	0.41	1.00	10.64	3.30	35.1	63222	11622	51600	1.16	9.7
40	50	26.05	0.41	1.00	10.64	2.80	27.7	86415	14528	71887	1.19	9.7
50	60	26.05	0.41	1.00	10.64	2.30	23.0	109439	17433	92006	1.29	9.7
60	70	26.05	0.41	1.00	10.64	1.90	20.2	127201	20339	106862	1.20	9.7
70	80	26.05	0.41	1.00	10.64	1.60	18.2	140844	23244	117600	1.31	9.7
80	90	26.05	0.41	1.00	10.64	1.40	16.0	150559	26150	126509	1.39	9.7
90	100	26.05	0.41	1.00	10.64	1.20	14.0	156659	29055	134504	1.44	9.7
100	110	26.05	0.41	1.00	10.64	1.00	12.0	159761	31961	141500	1.47	9.7
110	120	26.05	0.41	1.00	10.64	0.90	10.9	160863	34866	147500	1.46	9.7
120	130	26.05	0.41	1.00	10.64	0.80	9.8	161965	37772	152500	1.42	9.7
130	140	26.05	0.41	1.00	10.64	0.70	8.7	163067	40677	157500	1.36	9.7
140	150	26.05	0.41	1.00	10.64	0.60	7.6	164169	43583	162500	1.26	9.7




**DETENTION CALCULATIONS - 10 Year**

Storm Duration	Outflow Duration	Area (AC.)	Future "C"	Future "K"	Future "CA"	Rainfall Intensity	Inflow (cfs)	Volume (cubic ft.)	Volume (cubic ft.)	Volume (cubic ft.)	Volume (cubic ft.)	Outflow (cfs)
10	20	26.05	0.41	1.00	10.64	7.10	75.6	45341	10804	34537	0.79	18.0
20	30	26.05	0.41	1.00	10.64	5.90	62.8	57355	16236	41119	1.36	18.0
30	40	26.05	0.41	1.00	10.64	4.90	51.1	69369	21668	47581	1.82	18.0
40	50	26.05	0.41	1.00	10.64	4.00	42.6	81383	27100	54043	1.73	18.0
50	60	26.05	0.41	1.00	10.64	3.50	37.3	93397	32532	60505	1.82	18.0
60	70	26.05	0.41	1.00	10.64	3.00	31.9	105411	37964	67067	1.77	18.0
70	80	26.05	0.41	1.00	10.64	2.60	28.0	117425	43396	73629	1.68	18.0
80	90	26.05	0.41	1.00	10.64	2.20	24.1	129439	48828	80191	1.63	18.0
90	100	26.05	0.41	1.00	10.64	2.00	22.0	138553	54260	86753	1.60	18.0
100	110	26.05	0.41	1.00	10.64	1.80	20.0	147667	59692	93315	1.58	18.0
110	120	26.05	0.41	1.00	10.64	1.60	18.0	156781	65124	99877	1.56	18.0
120	130	26.05	0.41	1.00	10.64	1.50	16.5	165895	70556	106439	1.54	18.0
130	140	26.05	0.41	1.00	10.64	1.40	15.0	175009	76088	113001	1.52	18.0
140	150	26.05	0.41	1.00	10.64	1.30	13.5	184123	81520	119563	1.50	18.0

**DETENTION CALCULATIONS - 25 Year**

Storm Duration	Outflow Duration	Area (AC.)	Future "C"	Future "K"	Future "CA"	Rainfall Intensity	Inflow (cfs)	Volume (cubic ft.)	Volume (cubic ft.)	Volume (cubic ft.)	Volume (cubic ft.)	Outflow (cfs)
10	20	26.05	0.41	1.00	10.64	8.30	88.3	53004	14155	38849	0.89	23.6
20	30	26.05	0.41	1.00	10.64	6.60	70.2	64286	21232	46064	1.45	23.6
30	40	26.05	0.41	1.00	10.64	5.50	58.5	75568	28309	53180	1.77	23.6
40	50	26.05	0.41	1.00	10.64	4.60	49.0	86850	35387	60296	1.89	23.6
50	60	26.05	0.41	1.00	10.64	4.00	42.6	98132	42464	67412	1.96	23.6
60	70	26.05	0.41	1.00	10.64	3.50	37.3	109414	49541	74528	1.94	23.6
70	80	26.05	0.41	1.00	10.64	3.00	31.9	120696	56618	81644	1.91	23.6
80	90	26.05	0.41	1.00	10.64	2.60	28.0	131978	63695	88760	2.07	23.6
90	100	26.05	0.41	1.00	10.64	2.20	24.1	143260	70772	95876	2.19	23.6
100	110	26.05	0.41									



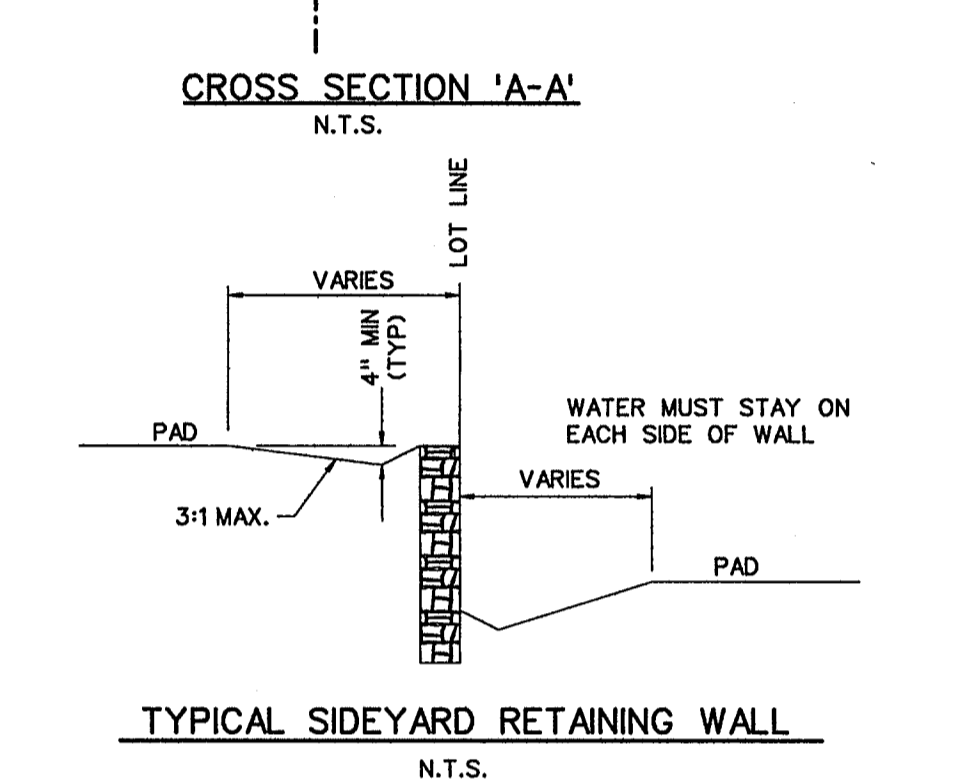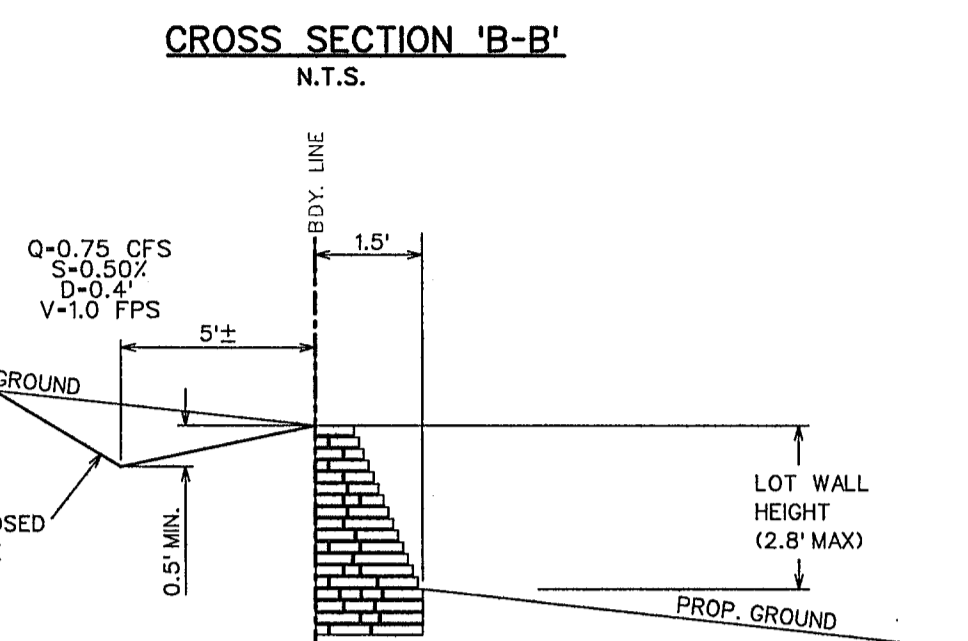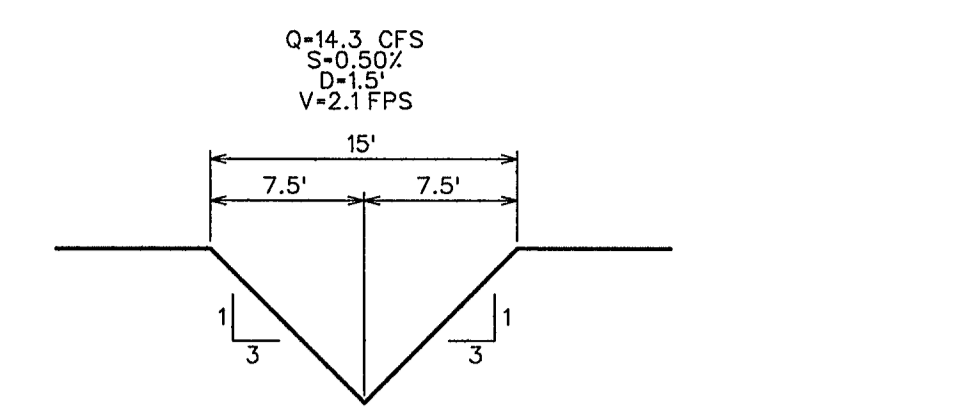

**Note:**  
 Each lot will need a detailed grading plan with building permit submittal. This is a general grading plan for site work only.  
 All driveways to be J-Swing.


**Wall Notes:**  
 1. No part of the wall (footing, tie back etc.) shall be const. offsite, in an easement or in the R.O.W. Walls must be on one property.  
 2. All walls 4' or taller shall require a signed/sealed set of engineered drawings. Wall engineer shall signed/sealed letter prior to acceptance stating that the walls were constructed per drawings.  
 3. All fill to be compacted to 95% std. density using a sheep's foot roller.

**NOTES:**  
 ☉ Driveway must be located on noted site.

1. Finish Floor Elevation to be 0.70 Feet above Finished Pad.(FP)  
 2. Additional Erosion Control to be installed in Parkways as determined by the City Inspector.  
 3. Finished Pad Elevations are within ± 0.3 Feet.  
 4. No lot to lot drainage allowed.



The seal appearing on this document was authorized by Brandon Davidson P.E. 87682, on October 9, 2014

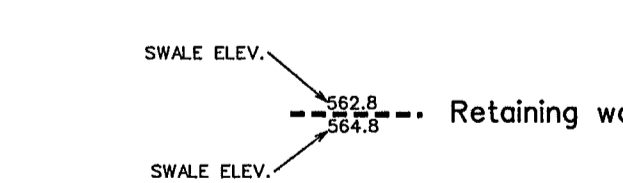

**BENCHMARK #1**  
 PK NAIL FOUND IN CENTER OF S. JOHN KING BLVD. 20' ± NORTH OF MEDIAN OPENING NEAR NORTHWEST CORNER OF PROPERTY.  
 ELEV. -564.12  
 N. 7021747.513  
 E. 2602779.713

**BENCHMARK #2**  
 "X" FOUND ON NORTH END OF TOP OF HEADWALL ON WEST SIDE OF S. JOHN KING BLVD. AT BUFFALO CREEK.  
 ELEV. -550.82  
 N. 7020725.306  
 E. 2602982.310

AS-BUILT JULY 2015  
 INFORMATION PROVIDED BY CONTRACTORS (NOT FIELD VERIFIED)

**CORWIN ENGINEERING, INC.**  
 200 W. BELMONT, SUITE E  
 ALLEN, TEXAS 75013 (972)396-1200  
 TBPE FIRM #5951

**DEVELOPMENT PLANS FOR ROCKWALL DOWNES PHASE 1 ROCKWALL, TEXAS**


GRADING PLAN

DRAWN BY	DESIGNED BY	CHECKED BY	SHEET NO.
JOB NUMBER	DATE	SCALE: HOR: 1"=40' VER: 1"=4'	16 OF 17
14046	JANUARY 2015		




**CONSTRUCTION SEQUENCE**

1. GRADING CONTRACTOR TO INSTALL TEMPORARY STABILIZED ENTRANCE.
2. INSTALL SILT FENCE AS SHOWN, (TS-600 POLY FELT) PER C.O.G. SPECIFICATIONS.
3. CONSTRUCT DETENTION POND AND OUTFALL STRUCTURE.
4. PERFORM GRADING AND UTILITY CONSTRUCTION.
5. AFTER THE INLET BOTTOMS ARE CONSTRUCTED, THE INLETS SHALL BE FILLED WITH STONE AND COVERED WITH A FILTER FABRIC (TS-600 POLY FELT OR EQUIVALENT) BY UTILITY CONTRACTOR.
6. PRIOR TO CITY RELEASING DIRT WORK, PAVING, SOD OR SEEDED CURLEX SHALL BE INSTALLED ON SIDES AND BOTTOM OF ALL DETENTION PONDS AND DETENTION FULLY FUNCTIONING.
7. AFTER PAVING AND COMPLETION OF INLETS, INLET FILTERS SHALL BE INSTALLED IN ALL INLETS AND MAINTAINED UNTIL RE-VEGETATION HAS BEEN COMPLETED BY PAVING CONTRACTOR.
8. SILT FENCE SHALL REMAIN IN PLACE UNTIL RE-VEGETATION HAS BEEN COMPLETED.
9. PAVING CONTRACTOR SHALL REMOVE TEMPORARY STABILIZED ENTRANCE.
10. PRIOR TO CITY ACCEPTANCE THE PAVING CONTRACTOR SHALL BE RESPONSIBLE FOR REMOVING ANY MUD OR SILT WHICH COLLECTS ON THE EXISTING AND NEW PAVEMENT.

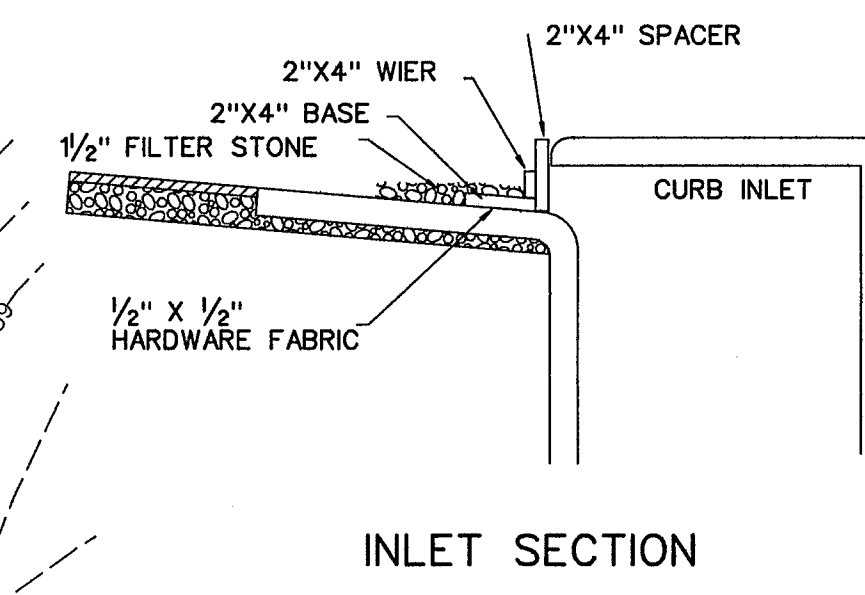


**INLET SECTION**

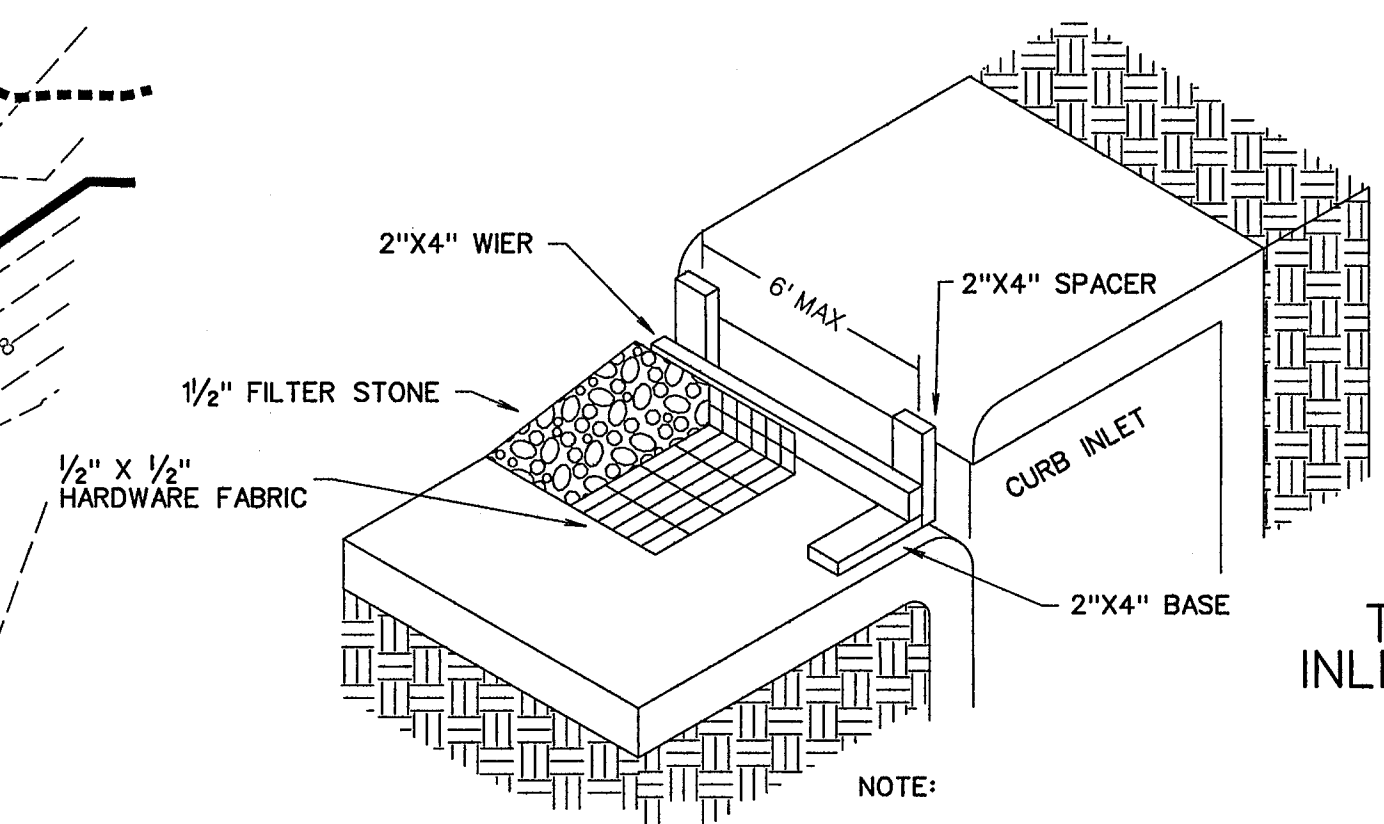


**TYPE B CURB INLET PROTECTION**

NOTE:

EXTEND FABRIC, FRAME AND FILTER STONE 12' BEYOND END OF INLET ON BOTH ENDS.

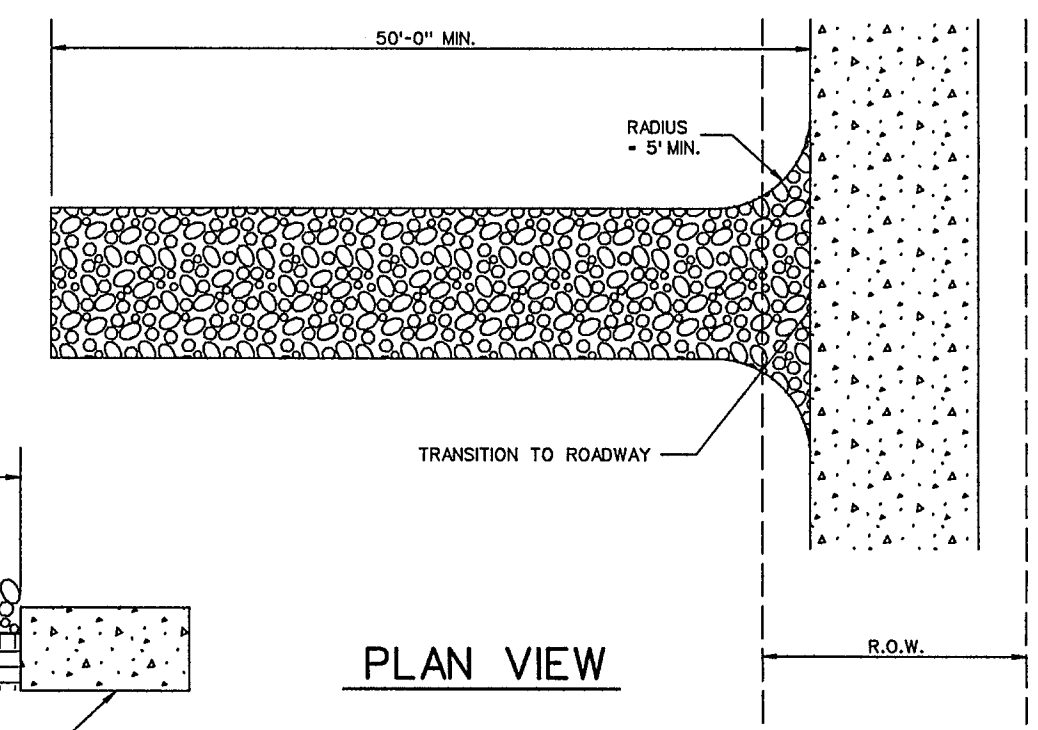

**PLAN VIEW**

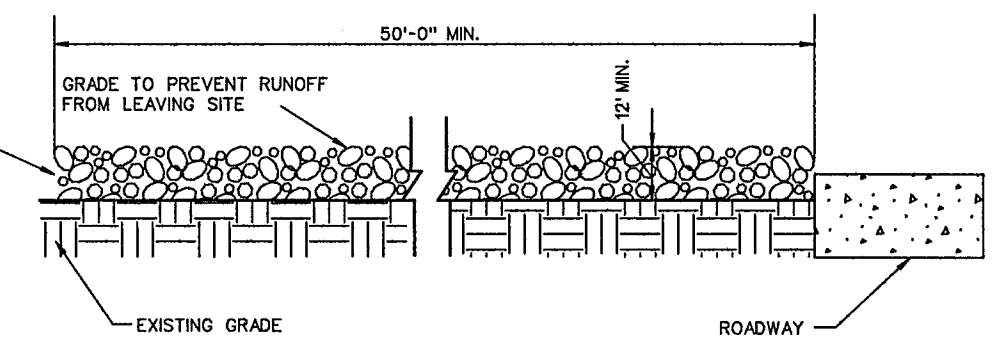

**PROFILE**

**STABILIZED ENTRANCE DETAIL**

**LEGEND**

- SILT FENCE (BEFORE CONSTRUCTION) - - - - -
- INLET PROTECTION [Symbol]


**CORWIN ENGINEERING, INC.**  
 200 W. BELMONT, SUITE E  
 ALLEN, TEXAS 75013 (972)396-1200  
 TBPE FIRM #5951

**DEVELOPMENT PLANS FOR  
 ROCKWALL DOWNES  
 PHASE 1  
 ROCKWALL, TEXAS**

**EROSION CONTROL PLAN**

DRAWN BY	DESIGNED BY	CHECKED BY	SHEET NO.
JOB NUMBER	DATE	SCALE:	17 OF 17
14046	JANUARY 2015	1"=50'	

**AS-BUILT JULY 2015**  
 INFORMATION PROVIDED  
 BY CONTRACTORS  
 (NOT FIELD VERIFIED)

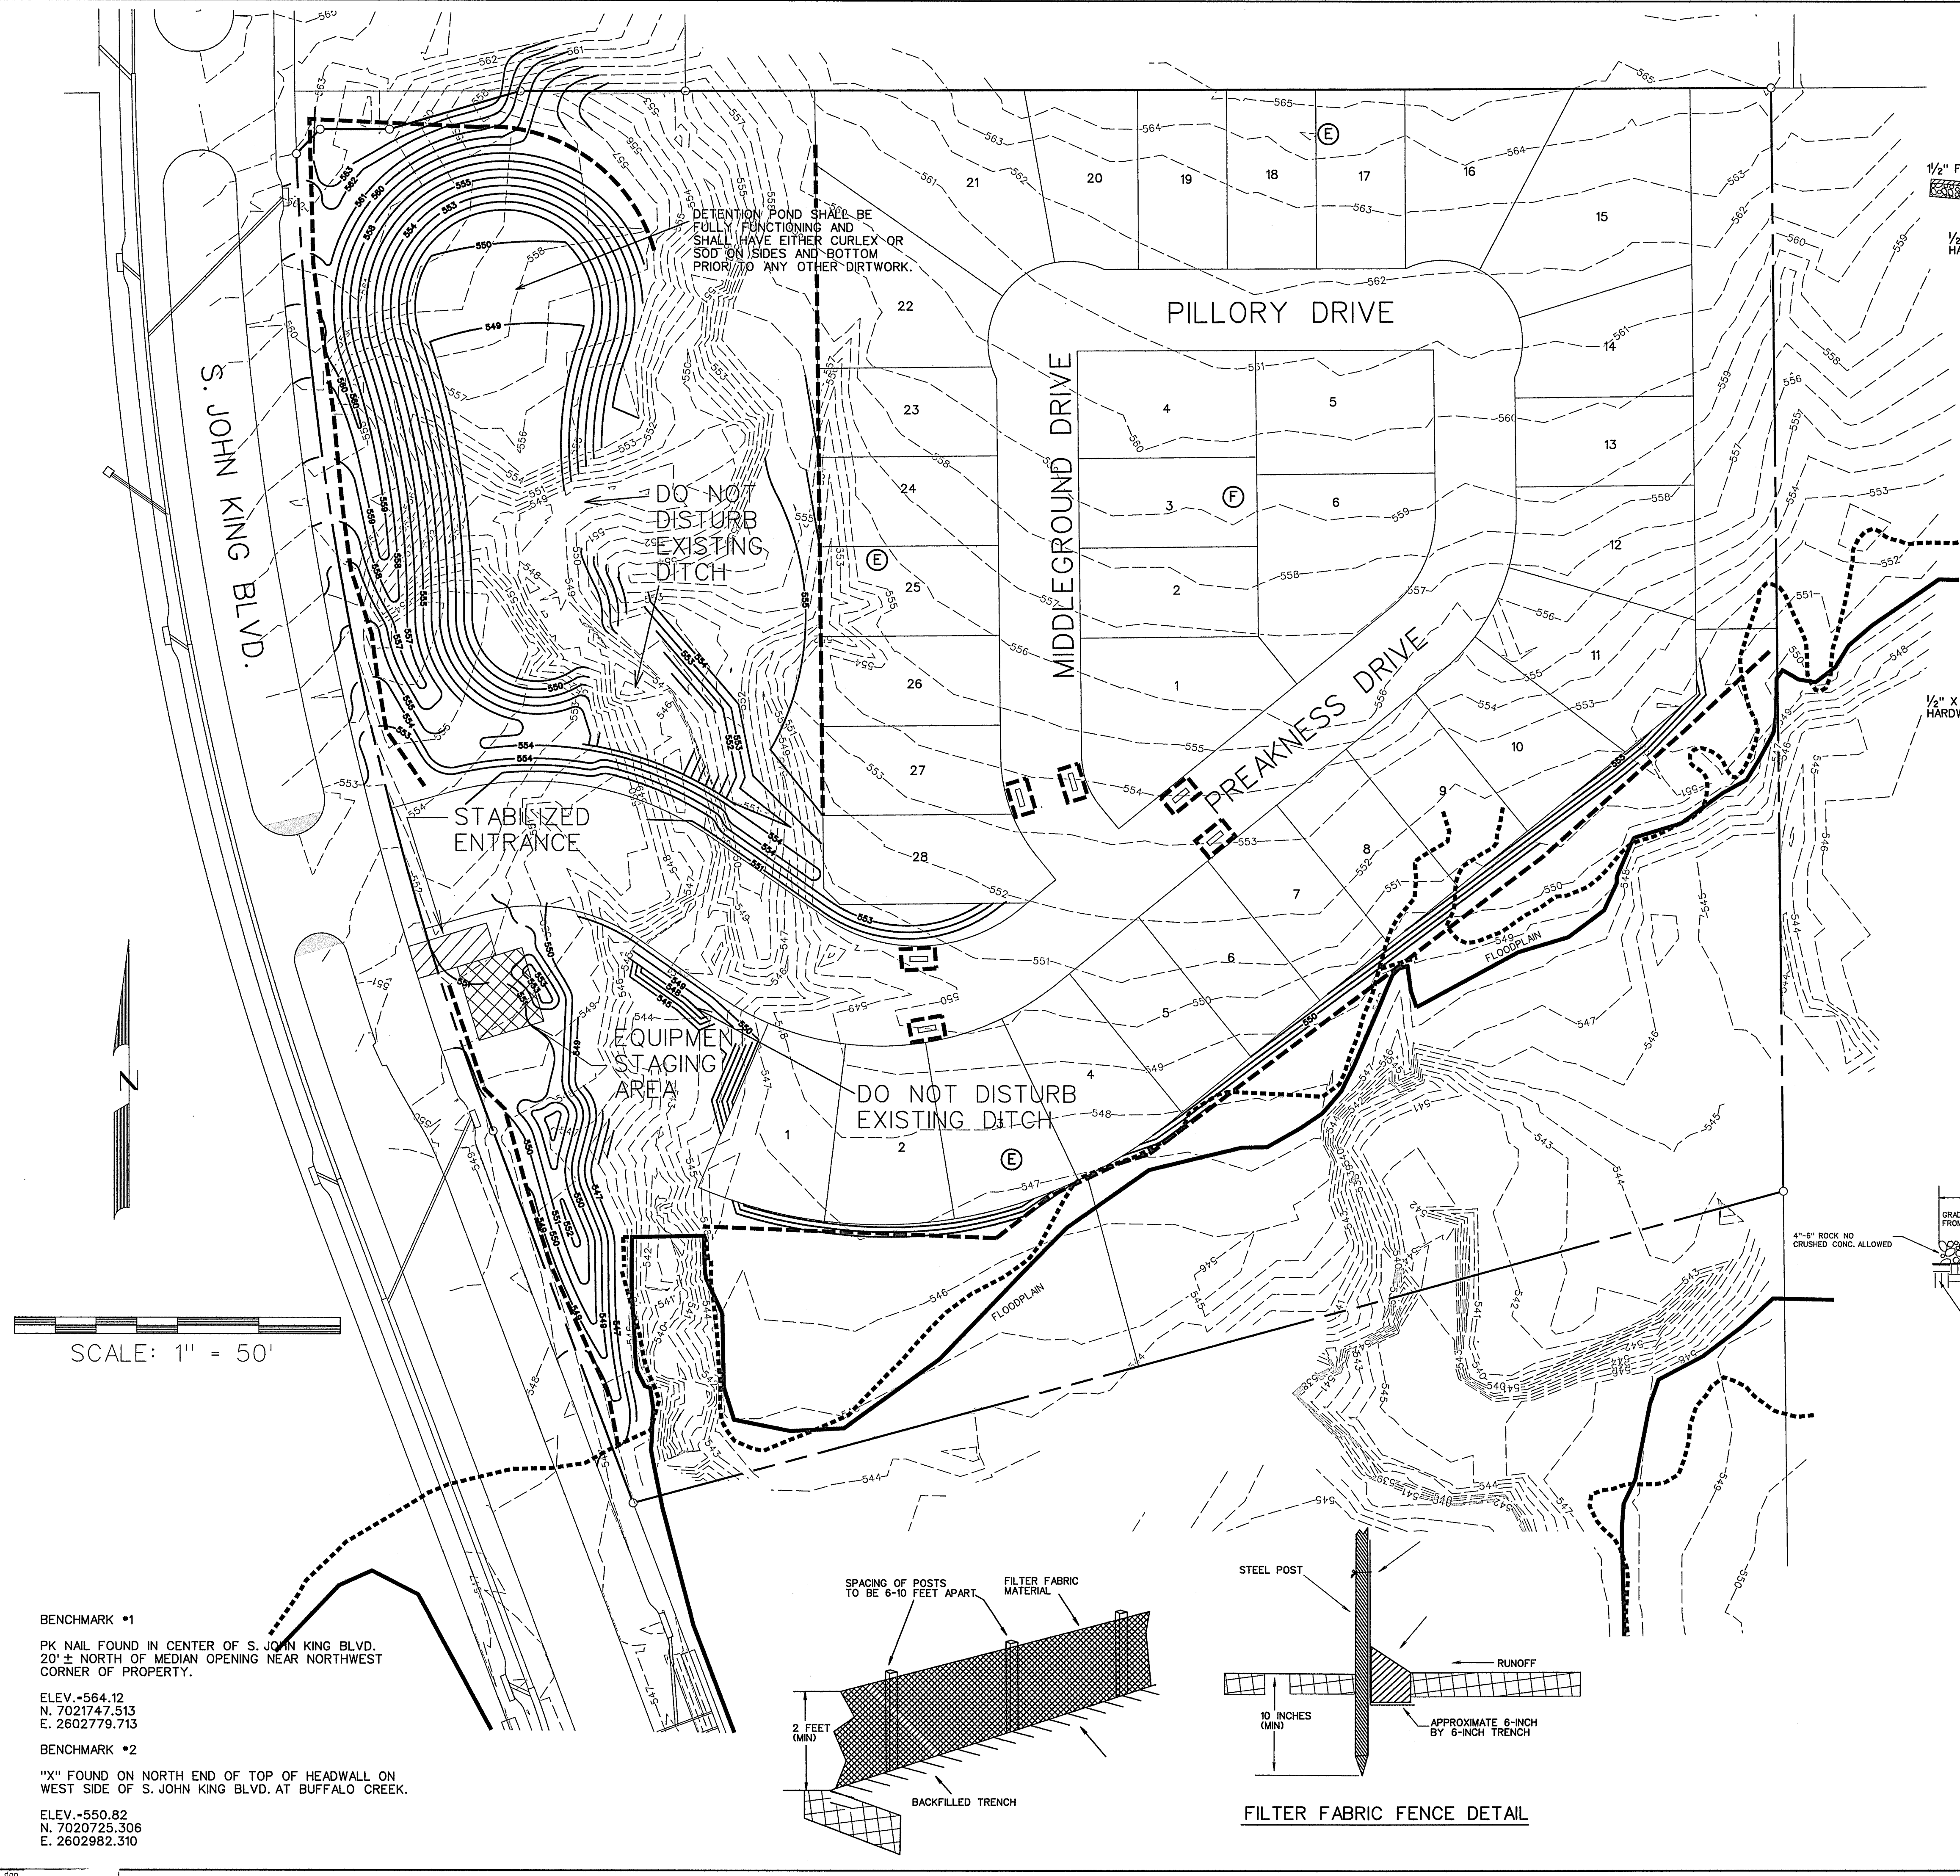



DETENTION POND SHALL BE FULLY FUNCTIONING AND SHALL HAVE EITHER CURLEX OR SOD ON SIDES AND BOTTOM PRIOR TO ANY OTHER DIRTWORK.

DO NOT DISTURB EXISTING DITCH

STABILIZED ENTRANCE

EQUIPMENT STAGING AREA

DO NOT DISTURB EXISTING DITCH

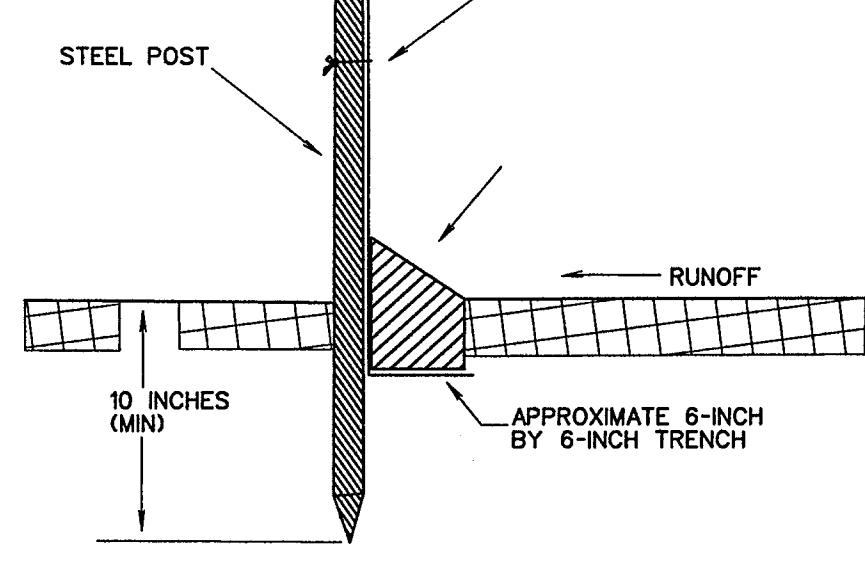
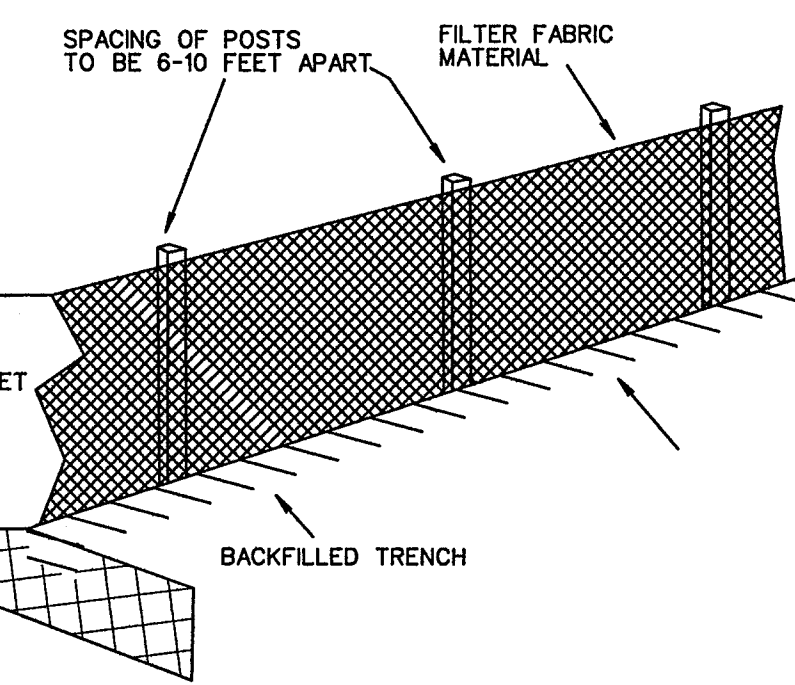


**FILTER FABRIC FENCE DETAIL**

SCALE: 1" = 50'


**BENCHMARK #1**  
 PK NAIL FOUND IN CENTER OF S. JOHN KING BLVD. 20' ± NORTH OF MEDIAN OPENING NEAR NORTHWEST CORNER OF PROPERTY.  
 ELEV. -564.12  
 N. 7021747.513  
 E. 2602779.713

**BENCHMARK #2**  
 "X" FOUND ON NORTH END OF TOP OF HEADWALL ON WEST SIDE OF S. JOHN KING BLVD. AT BUFFALO CREEK.  
 ELEV. -550.82  
 N. 7020725.306  
 E. 2602982.310

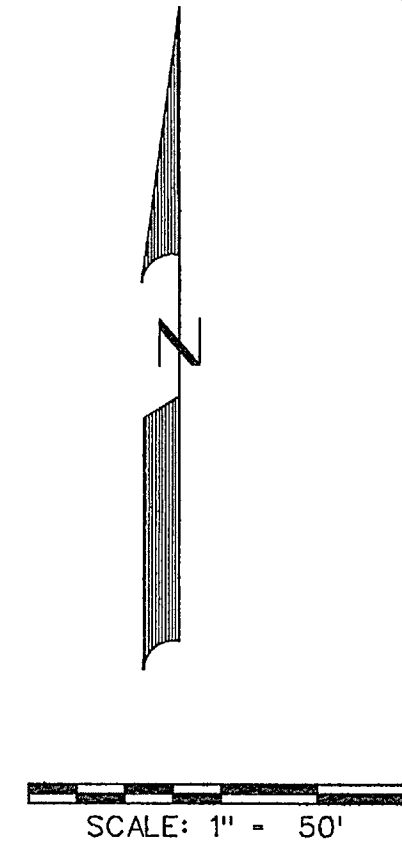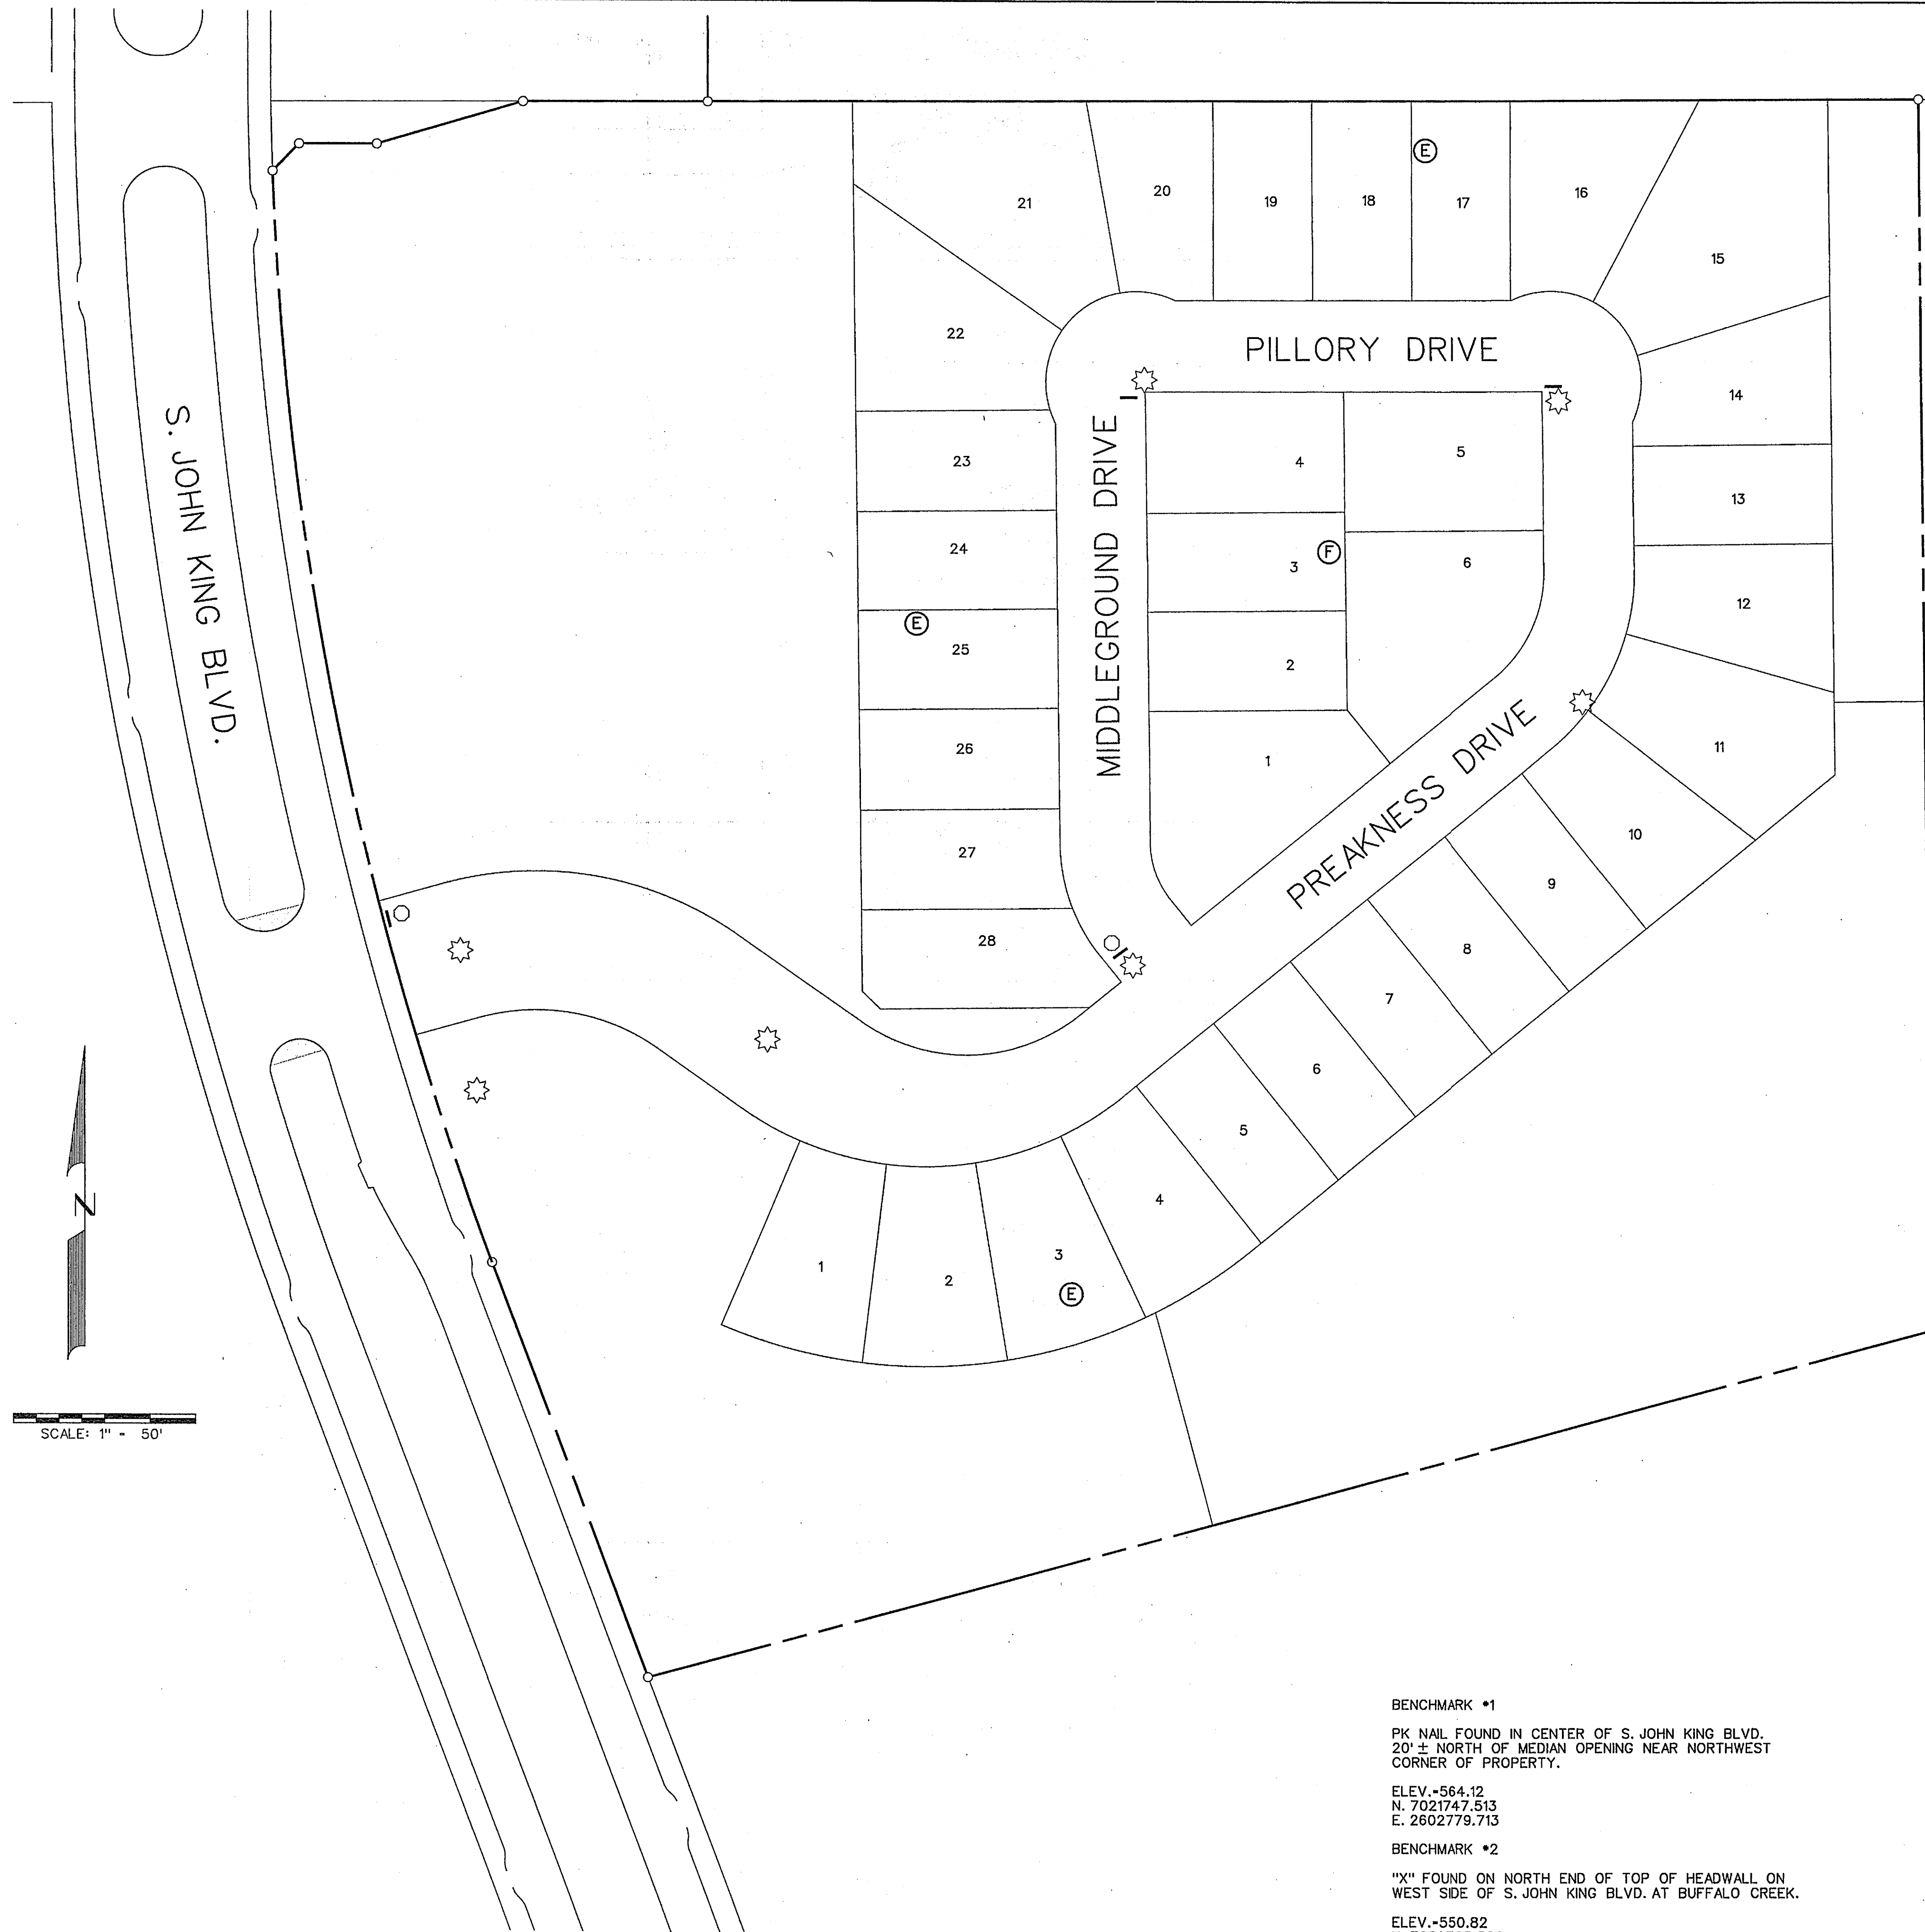

**BENCHMARK #1**  
 PK NAIL FOUND IN CENTER OF S. JOHN KING BLVD.  
 20' ± NORTH OF MEDIAN OPENING NEAR NORTHWEST  
 CORNER OF PROPERTY.  
 ELEV. -564.12  
 N. 7021747.513  
 E. 2602779.713

**BENCHMARK #2**  
 "X" FOUND ON NORTH END OF TOP OF HEADWALL ON  
 WEST SIDE OF S. JOHN KING BLVD. AT BUFFALO CREEK.  
 ELEV. -550.82  
 N. 7020725.306  
 E. 2602982.310

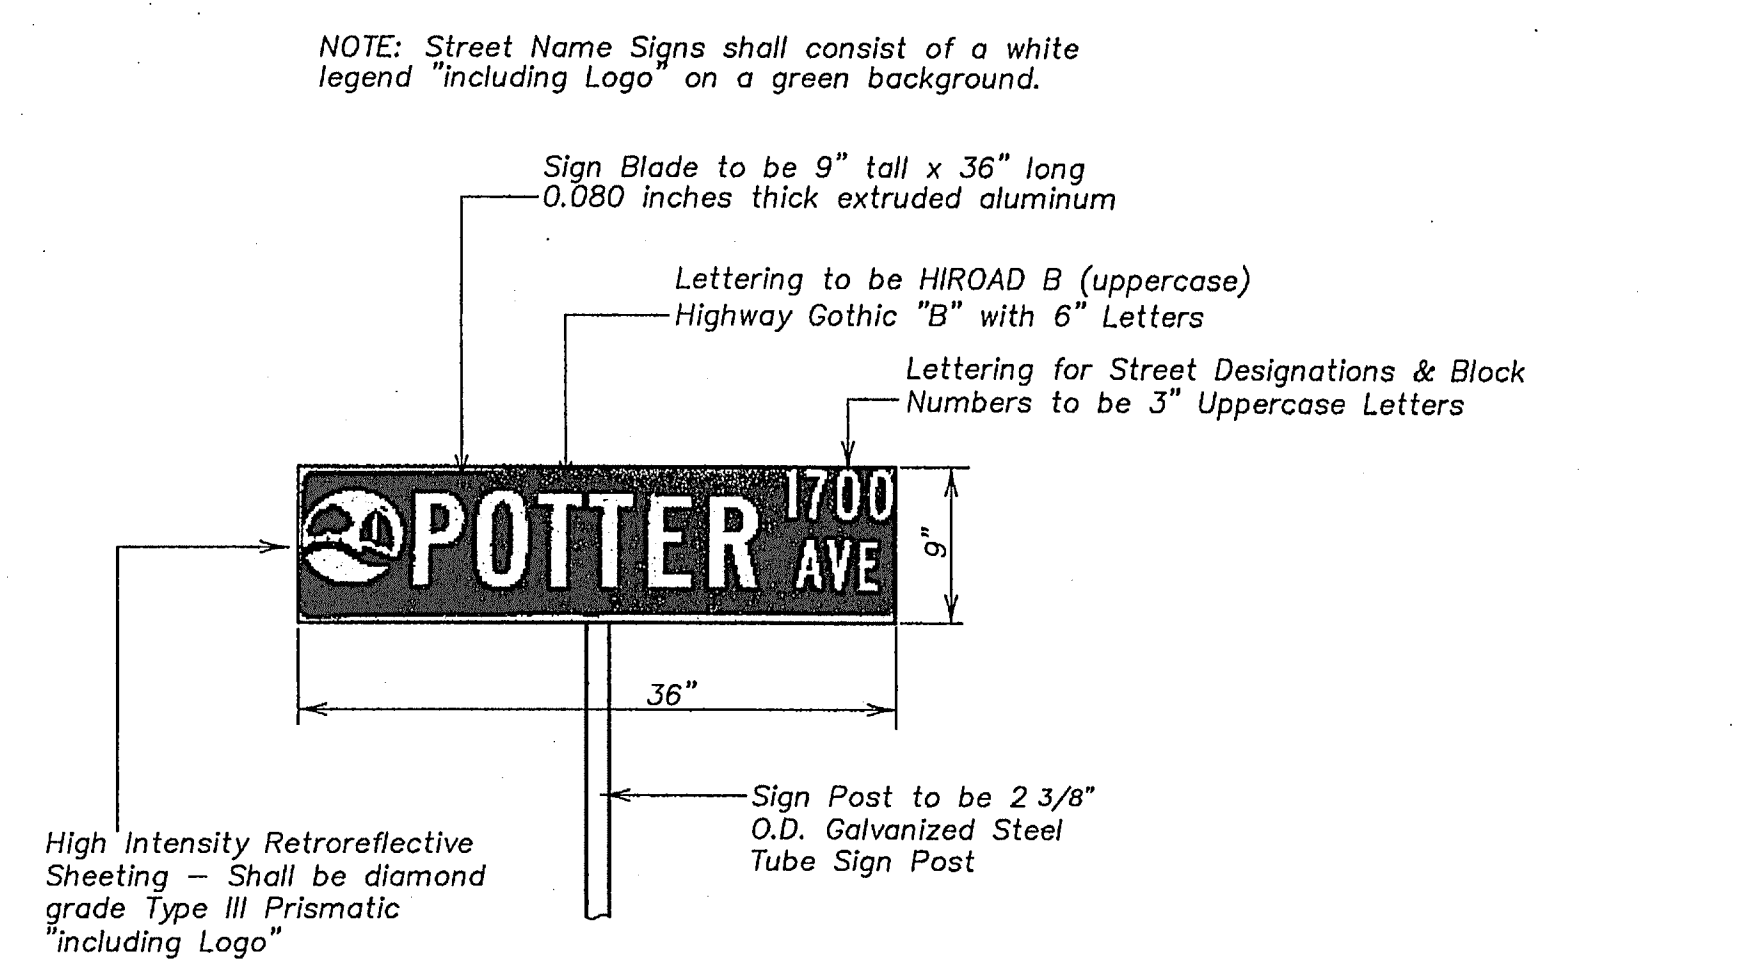

**STREET SIGN DETAIL**  
 NOT TO SCALE

**STREET SIGN NOTES**

All signage installed shall comply with the current "Texas Manual on Uniform Traffic Control Devices" and the "Standard Highway Sign Designs for Texas".

The developer shall be responsible for furnishing and installing all regulatory, warning and street name signs and sign mounts in accordance with the approved engineering plans.

Block Numbers are required on all street name blades.

Street Name Blades shall be nine inch (9") tall extruded aluminum. The blades shall be 0.080 inches thick.

High Intensity Retro reflective Sheeting for Street, Regulatory, and Warning Signs - shall be High Intensity diamond grade type III prismatic.

The Lettering for the street blades shall be HIROAD B with all uppercase fonts. "Highway Gothic B" with six-inch letters. Letters for abbreviated street designations shall be three inches (3") tall with all uppercase fonts (i.e., LN, PKWY, CT, etc.). Block numbers shall be three-inch (3") tall.

The street sign background shall be green and the legend shall be white.

The street sign blade must incorporate the current City of Rockwall logo.


For a street with a cul-de-sac end, a standard W 14-2a shall be mounted over the street name blade.

Sign posts shall be 2 3/8" O.D. galvanized steel tube sign post with a galvanized finish.

Sign clamps and brackets shall be high strength aluminum.


**STREET LIGHTS:**  
 Street lights shall be spaced at intervals no greater than 400 ft.

**STREET SIGN LOGO:**  
 The City logo on the street sign blade shall incorporate the current City of Rockwall Logo. The logo shall consist of high intensity retroreflective sheeting which is diamond grade type III prismatic with white legend.

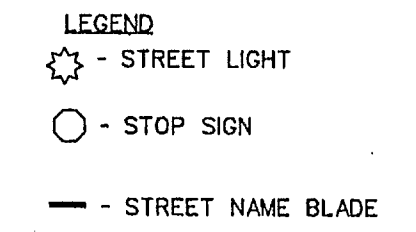

<b>CORWIN ENGINEERING, INC.</b> 200 W. BELMONT, SUITE E ALLEN, TEXAS 75013 (972)396-1200 TBPE FIRM #5951			
<b>DEVELOPMENT PLANS FOR          ROCKWALL DOWNES          PHASE 1          ROCKWALL, TEXAS</b>			
<b>STREET SIGN AND LIGHT PLAN</b>			
DRAWN BY 14046	DESIGNED BY SEPTEMBER 2014	CHECKED BY SCALE: 1"=50'	SHEET NO. 1 OF 1

**AS-BUILT JULY 2015**  
 INFORMATION PROVIDED  
 BY CONTRACTORS  
 (NOT FIELD VERIFIED)

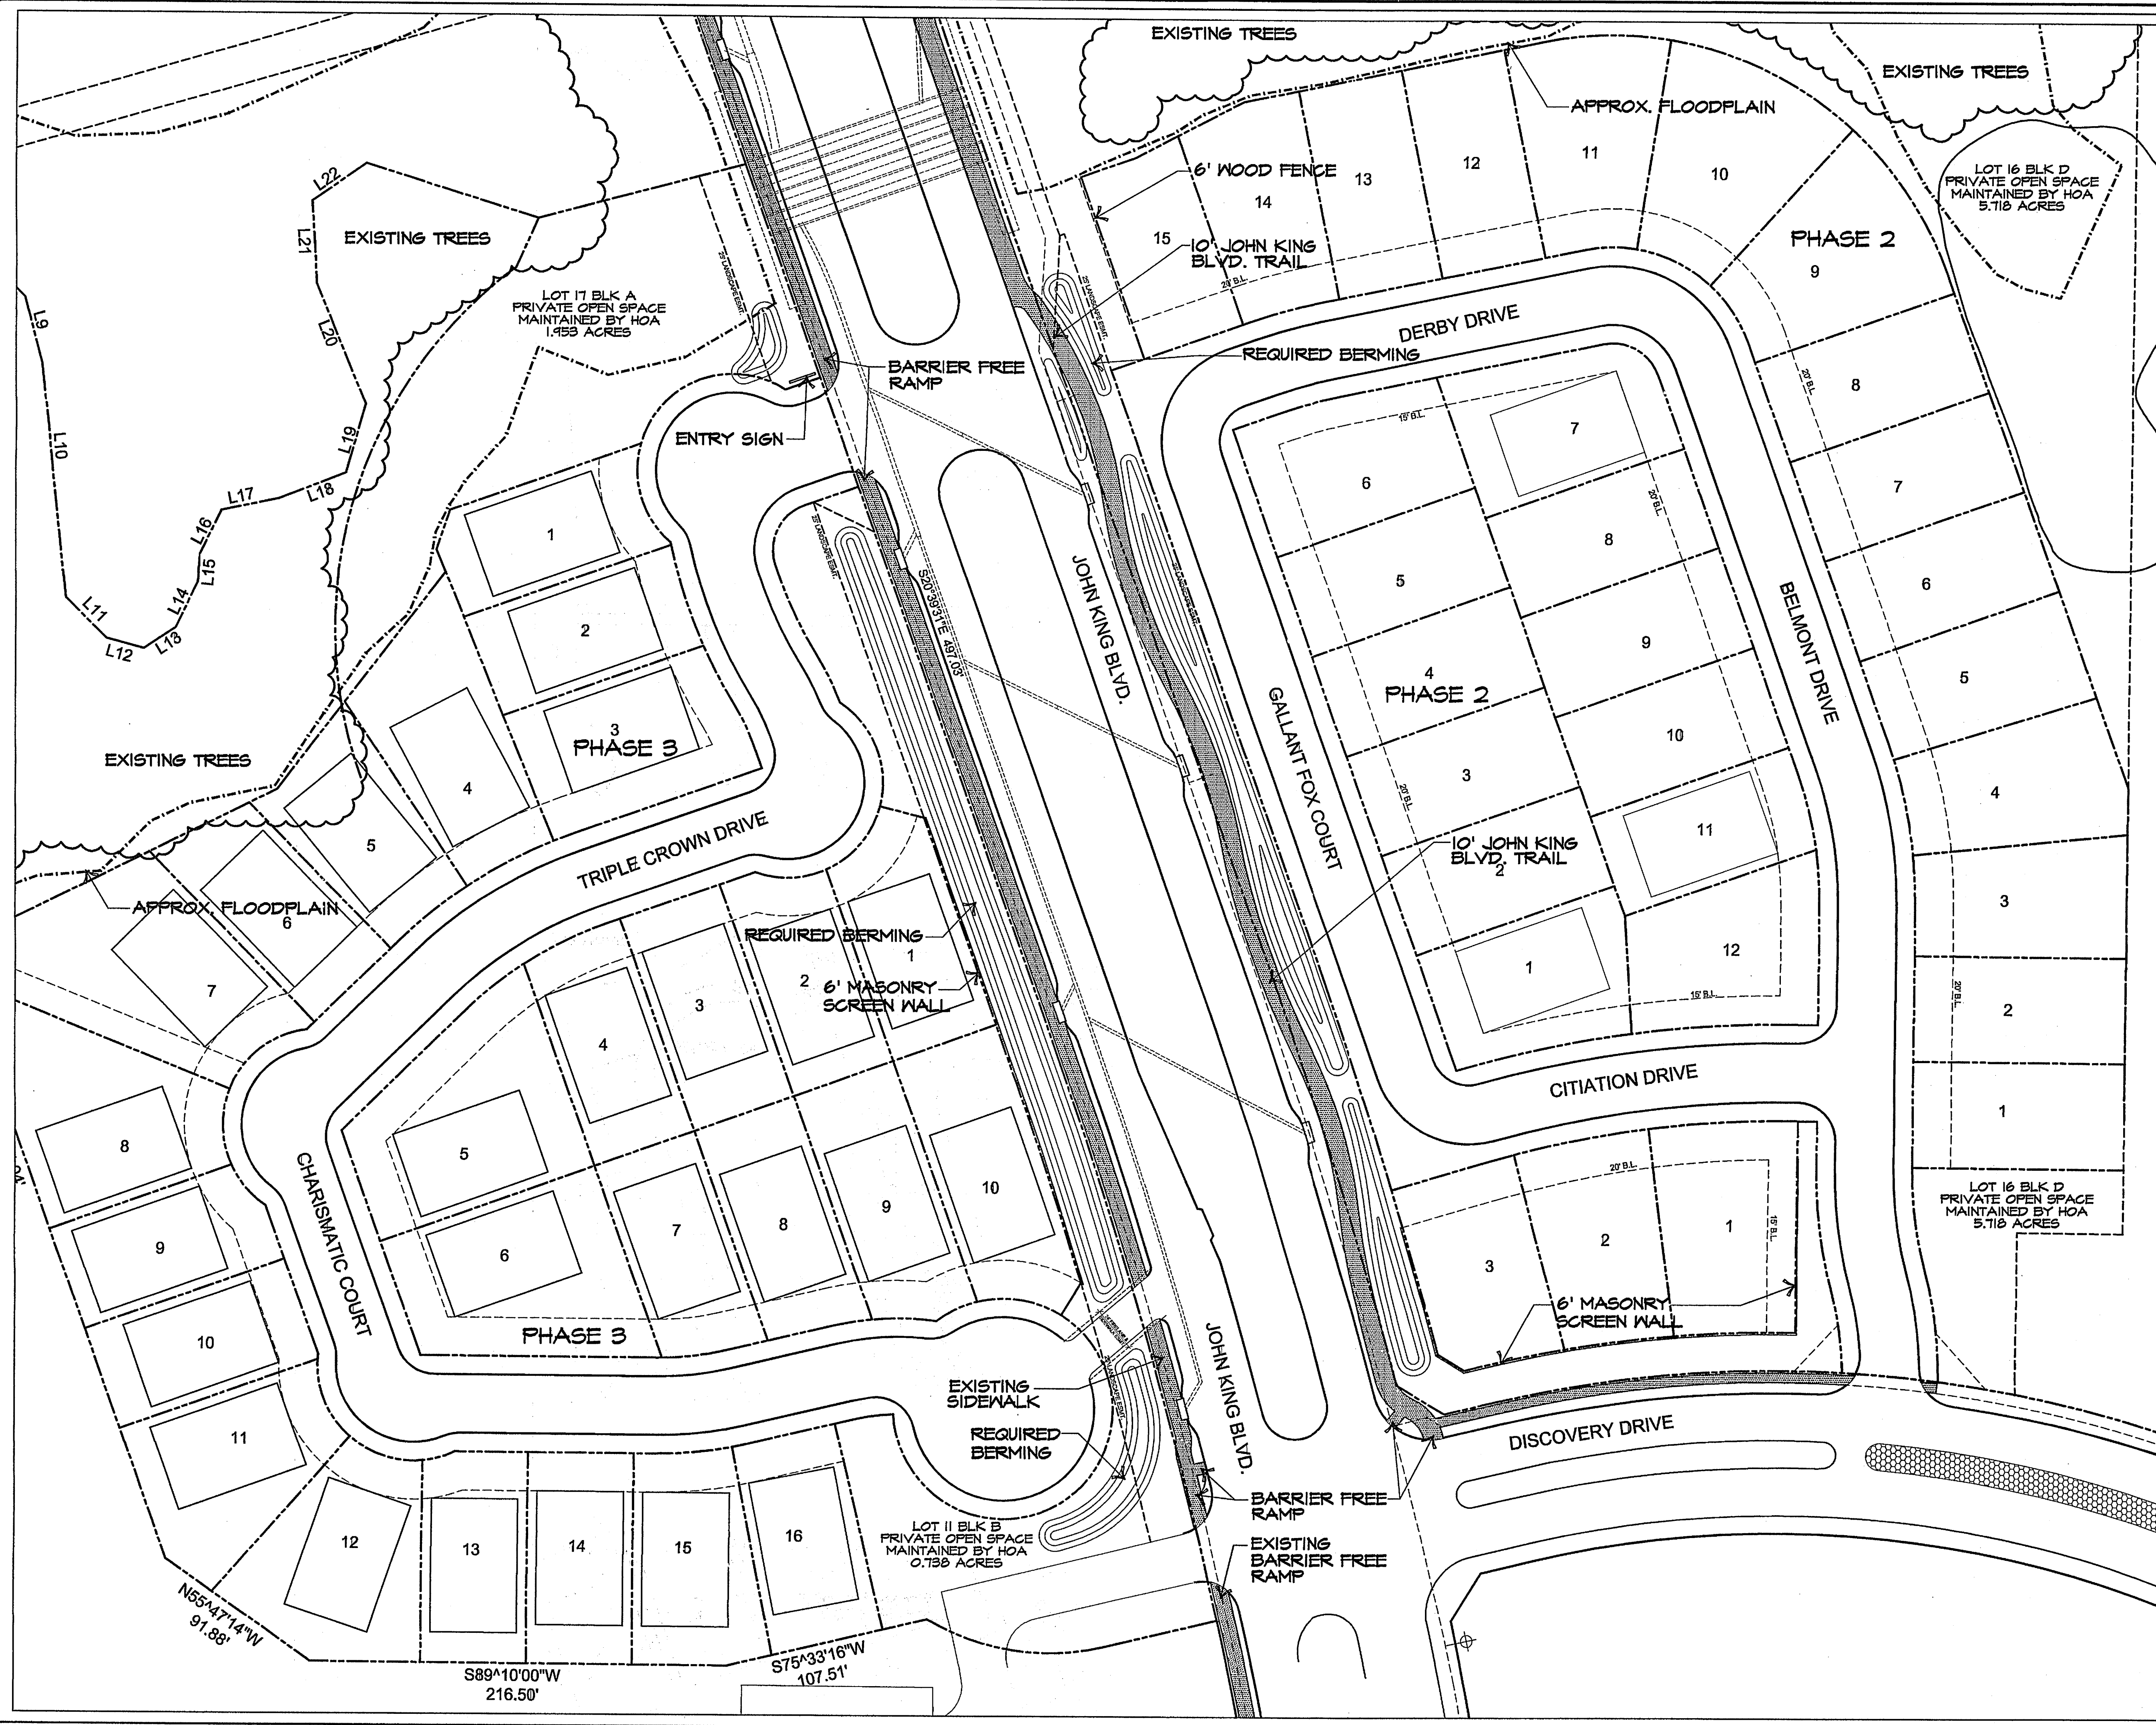


#	Revisions:	Date:

Issued For:  
**CONSTRUCTION**  
 Job No.  
 13133  
 Scale  
 1" = 40'-0"  
 Drawn By:  
 JDS  
 Date  
 9-2-2014

# Rockwall Downes

## Phase 2 & 3

Rockwall Texas

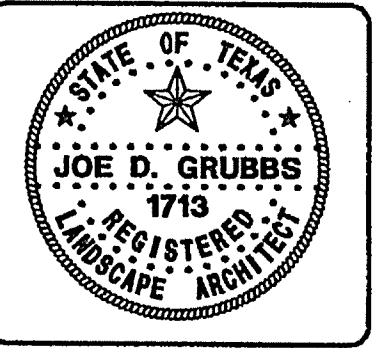

# Open Space

# Site Plan


Sheet Title:  
 Sheet Number:  
**SP2**  
 of SP3 Sheets

**PHASE 2 LOT DENSITY**  
 PROPOSED 30 LOTS  
 TOTAL LOT DENSITY = 2.52  
 TOTAL 40 LOTS 35.651 ACRES  
 35.651 ACRES


**PHASE 3 LOT DENSITY**  
 PROPOSED 26 LOTS  
 TOTAL LOT DENSITY = 2.52  
 TOTAL 40 LOTS 35.651 ACRES  
 35.651 ACRES




SP2014-014

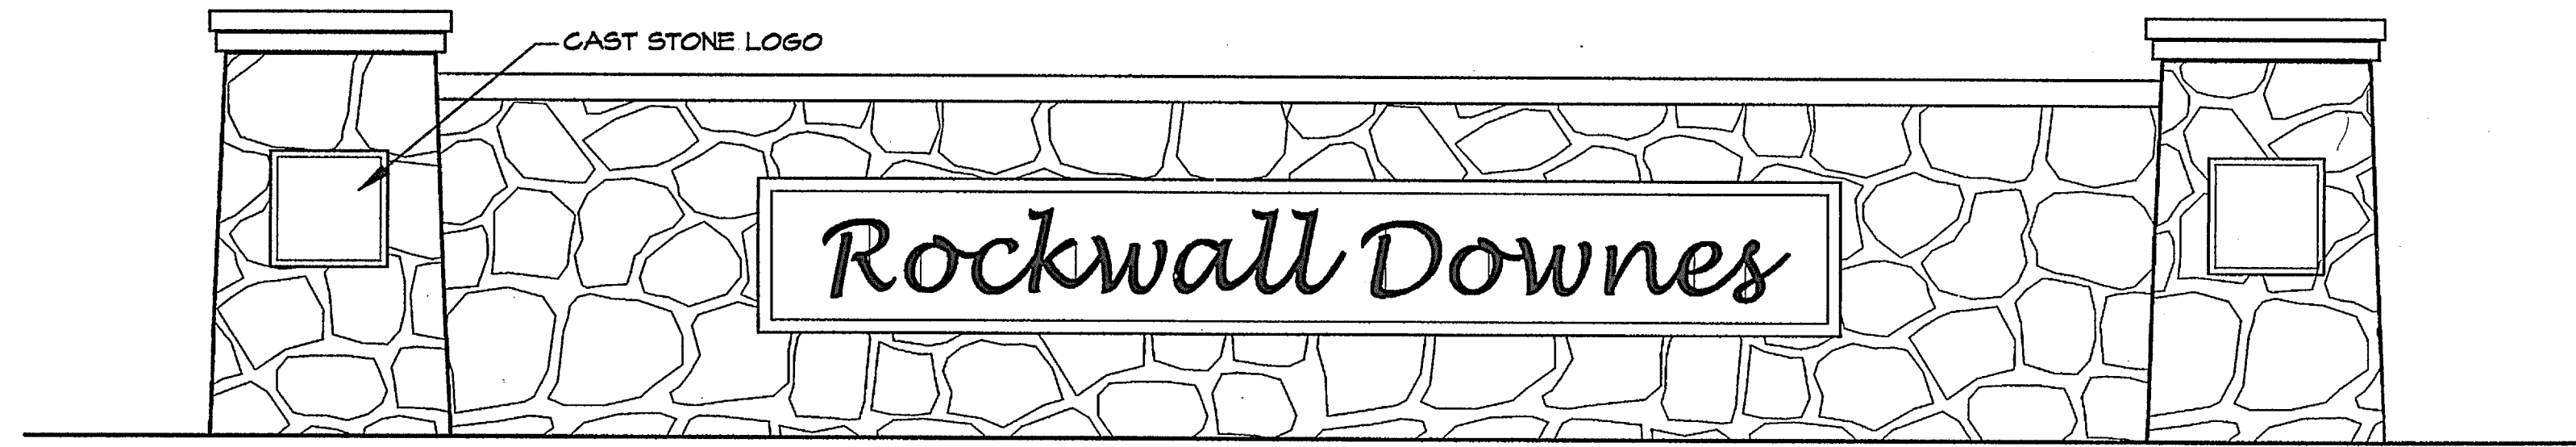


**A** ENTRY COLUMN & WALL  
FINAL DESIGN TO BE DETERMINED SCALE: 1/2" = 1'-0"

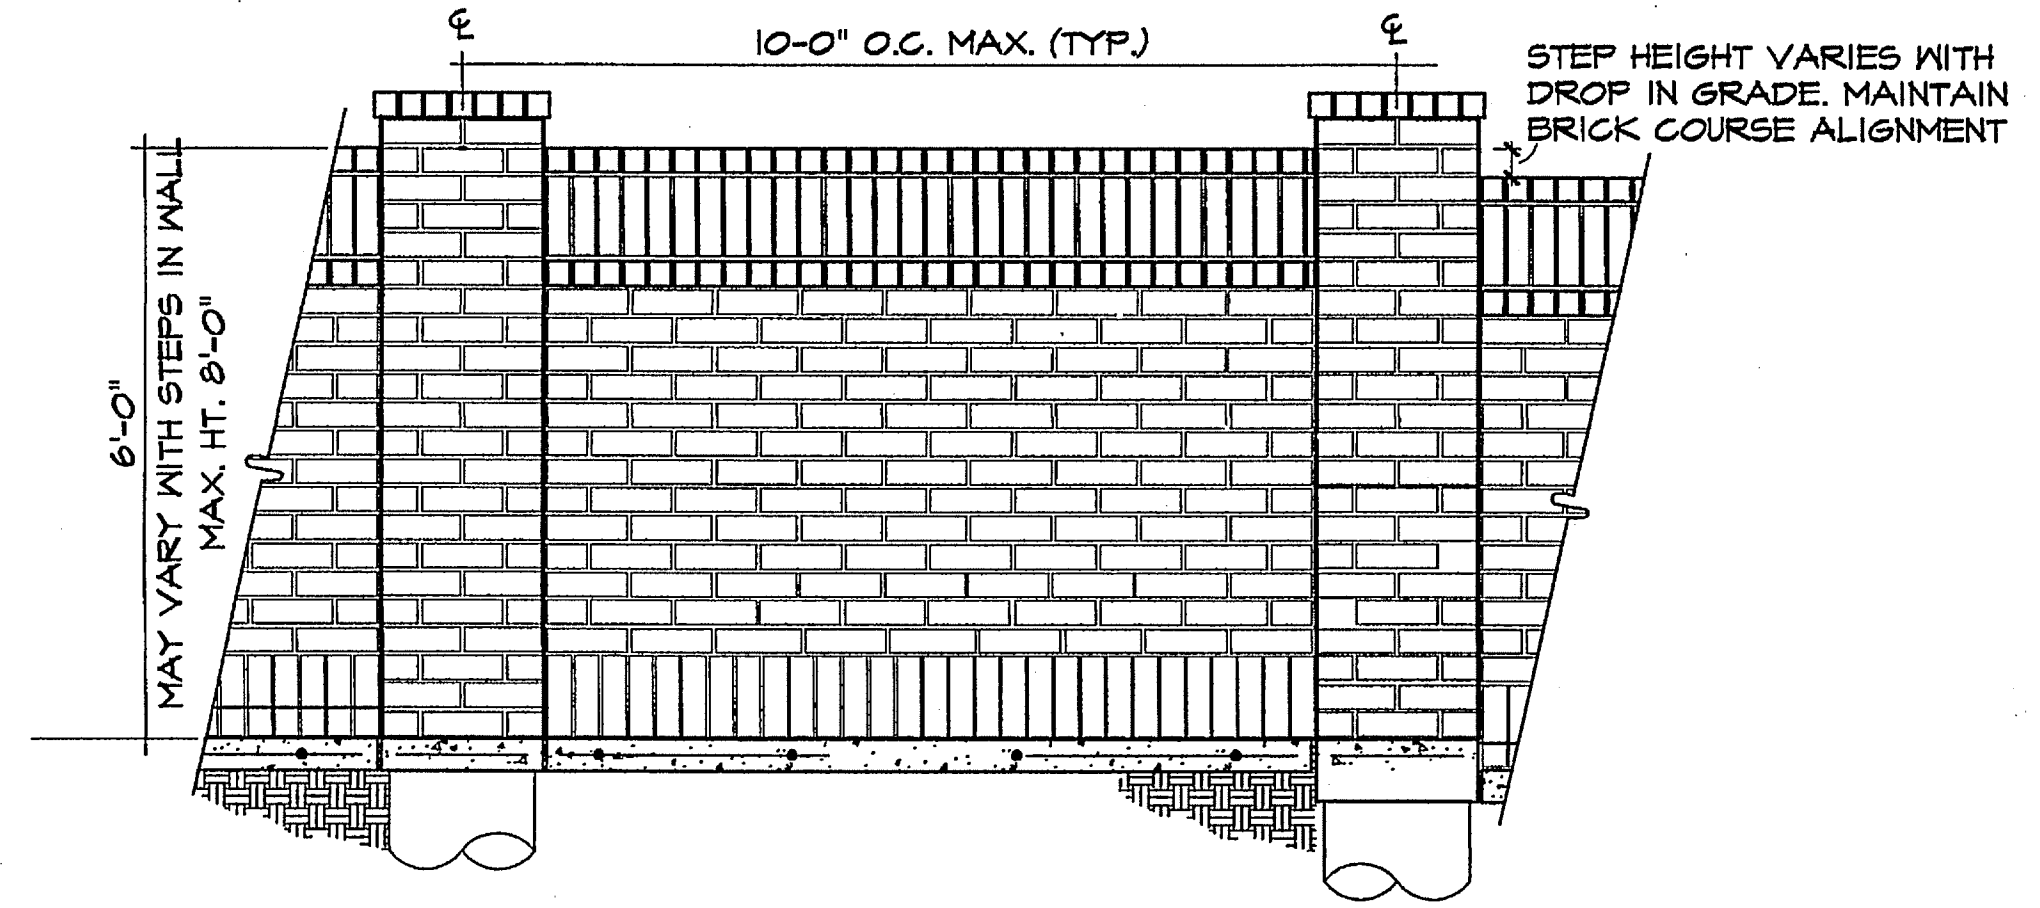

**B** BRICK SCREEN WALL ELEVATION  
FINAL DESIGN TO BE DETERMINED SCALE: 1/2" = 1'-0"

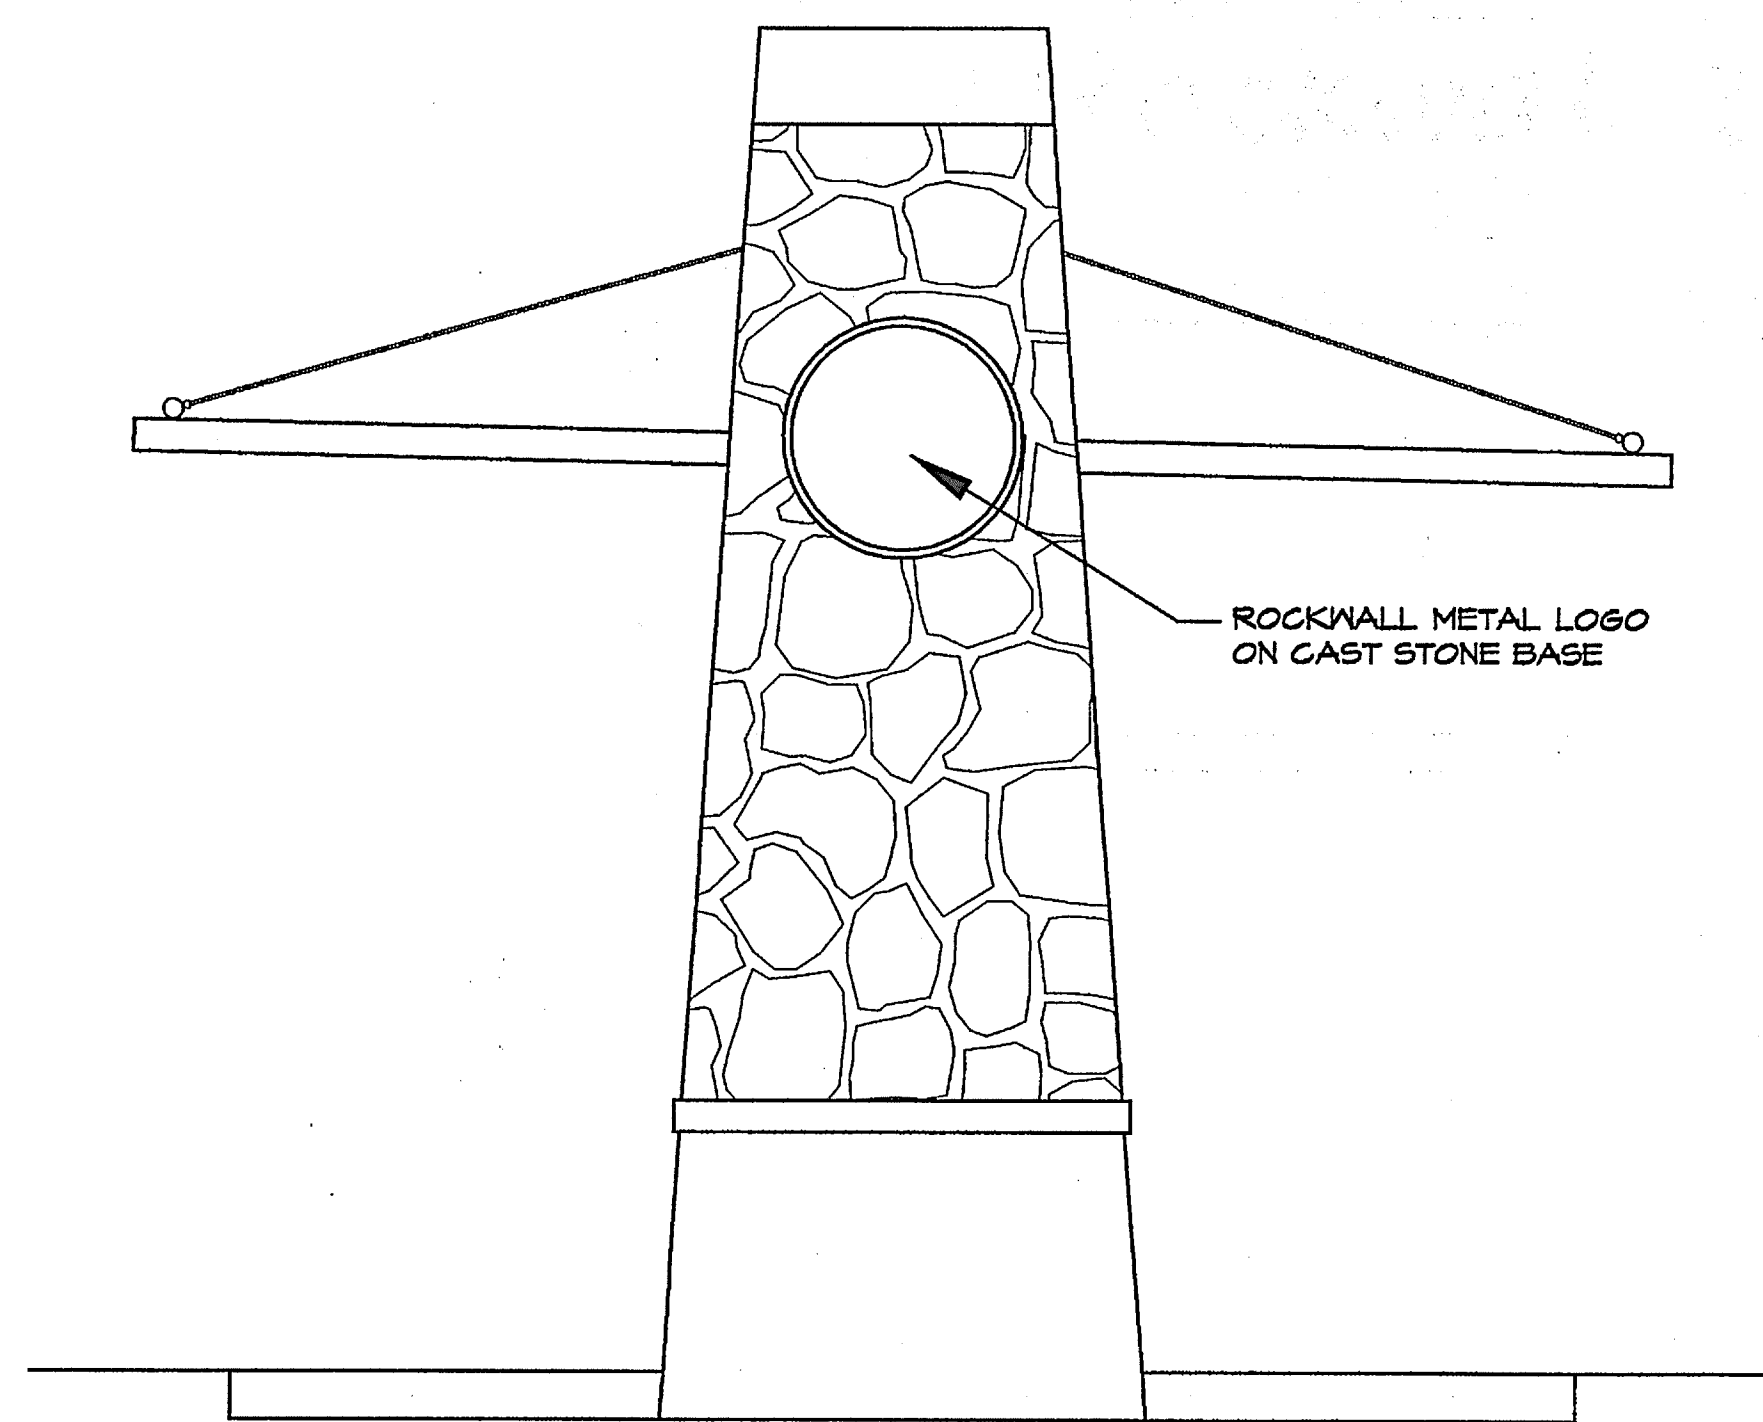

**B** REST STOP - PHASE I  
SCALE: 1/2" = 1'-0"

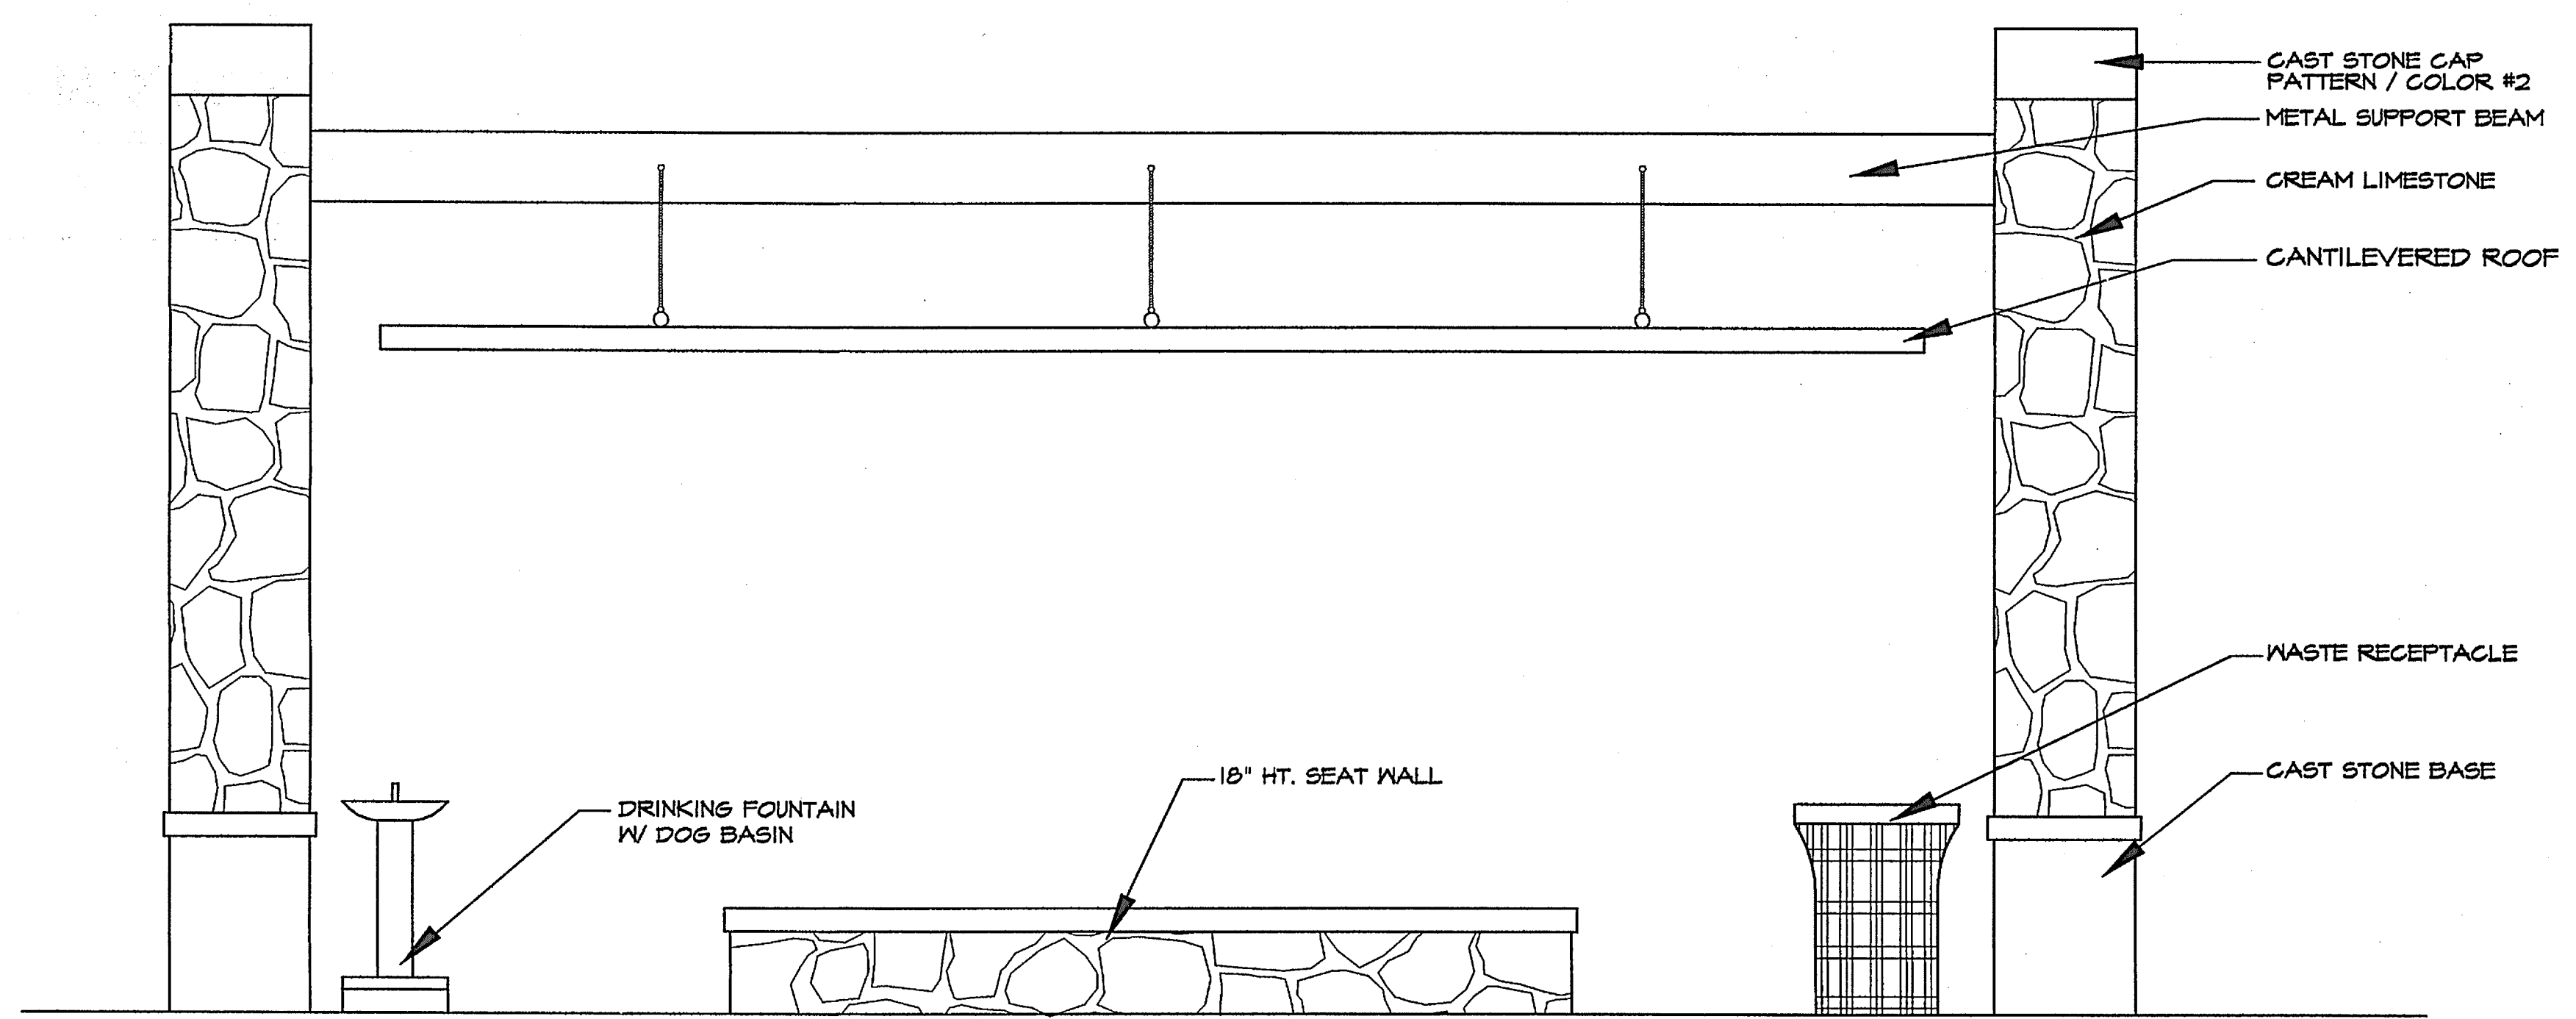


**C** REST STOP - PHASE I  
SCALE: 1/2" = 1'-0"

#	Revisions:	Date:

Issued For:  
**CONSTRUCTION**  
Job No.  
13138  
Scale  
Drawn By:  
JDS  
Date  
9-2-2014

**Rockwall Downes**  
Phase 1, 2 & 3  
Rockwall Texas

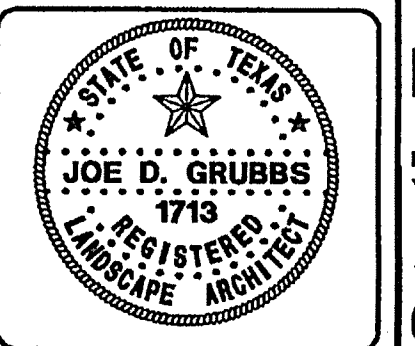

**Site Plan**  
**Details**

Sheet Title:

Sheet Number:  
**SP3**  
of SP3 Sheets

SP2014-014