


DEVELOPMENT PLANS FOR ROCKWALL DOWNES PHASE 1

CITY OF ROCKWALL, TEXAS

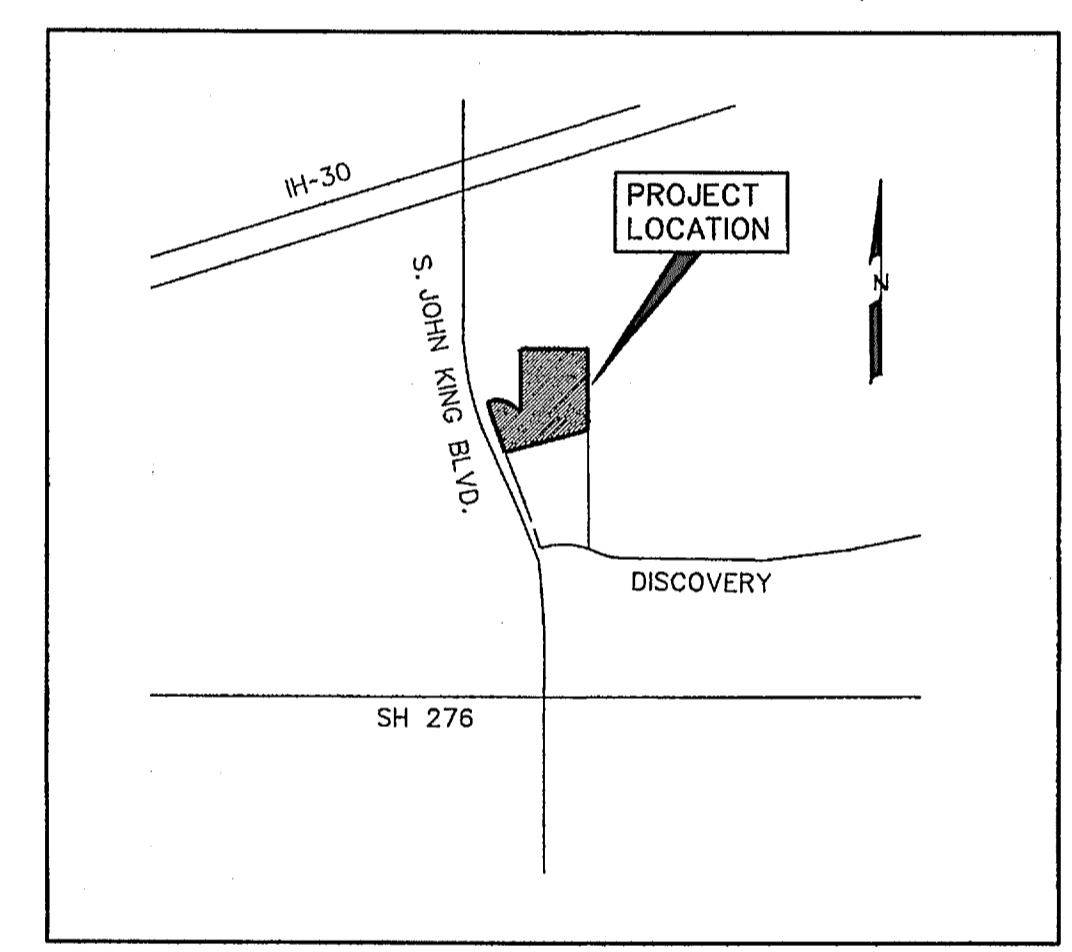

VICINITY MAP
NOT TO SCALE

PREPARED FOR
ROCKWALL DOWNES DEVELOPMENT, LLC.

8750 NORTH CENTRAL EXPRESSWAY, SUITE 1735, DALLAS, TEXAS 75231

CORWIN ENGINEERING, INC. — CONSULTING ENGINEERS

200 W. BELMONT, SUITE E

TBPE FIRM #5951

ALLEN, TEXAS 75013

INDEX

1	TITLE
2	PLAT
3	DRAINAGE AREA MAP
4	PREAKNESS DRIVE
5	MIDDLEGROUND DRIVE, PILLORY DRIVE
6	LEFT TURN LANE S. JOHN KING BLVD.
7	WATER AND SANITARY SEWER PLAN
8	SANITARY SEWER PROFILES
9	12" WATERLINE
10	12" WATERLINE
11	12" WATERLINE
12	STORM SEWER PLAN AND PROFILE LINES 'D-1' & 'D-3'
13	STORM SEWER PLAN AND PROFILE LINE 'D-2'
14	DETENTION POND DRAINAGE AREA MAP
15	DETENTION POND PLAN
16	GRADING PLAN
17	EROSION CONTROL PLAN
1 of 1	STREET SIGN AND LIGHT PLAN
<u>LANDSCAPE PLANS</u>	
TS1	TREE SURVEY & MITIGATION PLAN
L1	OPEN SPACE LANDSCAPE PLAN
L2	OPEN SPACE LANDSCAPE PLAN
SP1	OPEN SPACE SITE PLAN
SP2	OPEN SPACE SITE PLAN
SP3	SITE PLAN DETAILS

AS-BUILT JULY 2015
INFORMATION PROVIDED
BY CONTRACTORS
(NOT FIELD VERIFIED)



The seal appearing on
this document was
authorized by
Brandon Davidson
P.E. 87682, on
September 26, 2014

NOTE:
CITY OF ROCKWALL STANDARDS
AND NCTCOG 3rd ADDITION STANDARDS
SHALL BE USED FOR REFERENCE.

NO.	REVISIONS	BY	DATE

SEPTEMBER 2014