

STA. 14+50 ~ LINE "A"
CONSTRUCT STD. 4.0' DIA.
MANHOLE


STA. 11+00 ~ LINE "A"
CONSTRUCT STD. 4.0' DIA.
MANHOLE

STA. 6+00 ~ LINE "A"
CONSTRUCT STD. 4.0' DIA.
MANHOLE

STA. 0+97 ~ LINE "A"
CONSTRUCT STD. 4.0' DIA.
MANHOLE

STA. 0-28.20 ~ LINE "A"
CONNECT TO EX. STUB-
OUT FROM WET-WELL

LAKE RAY HUBBARD

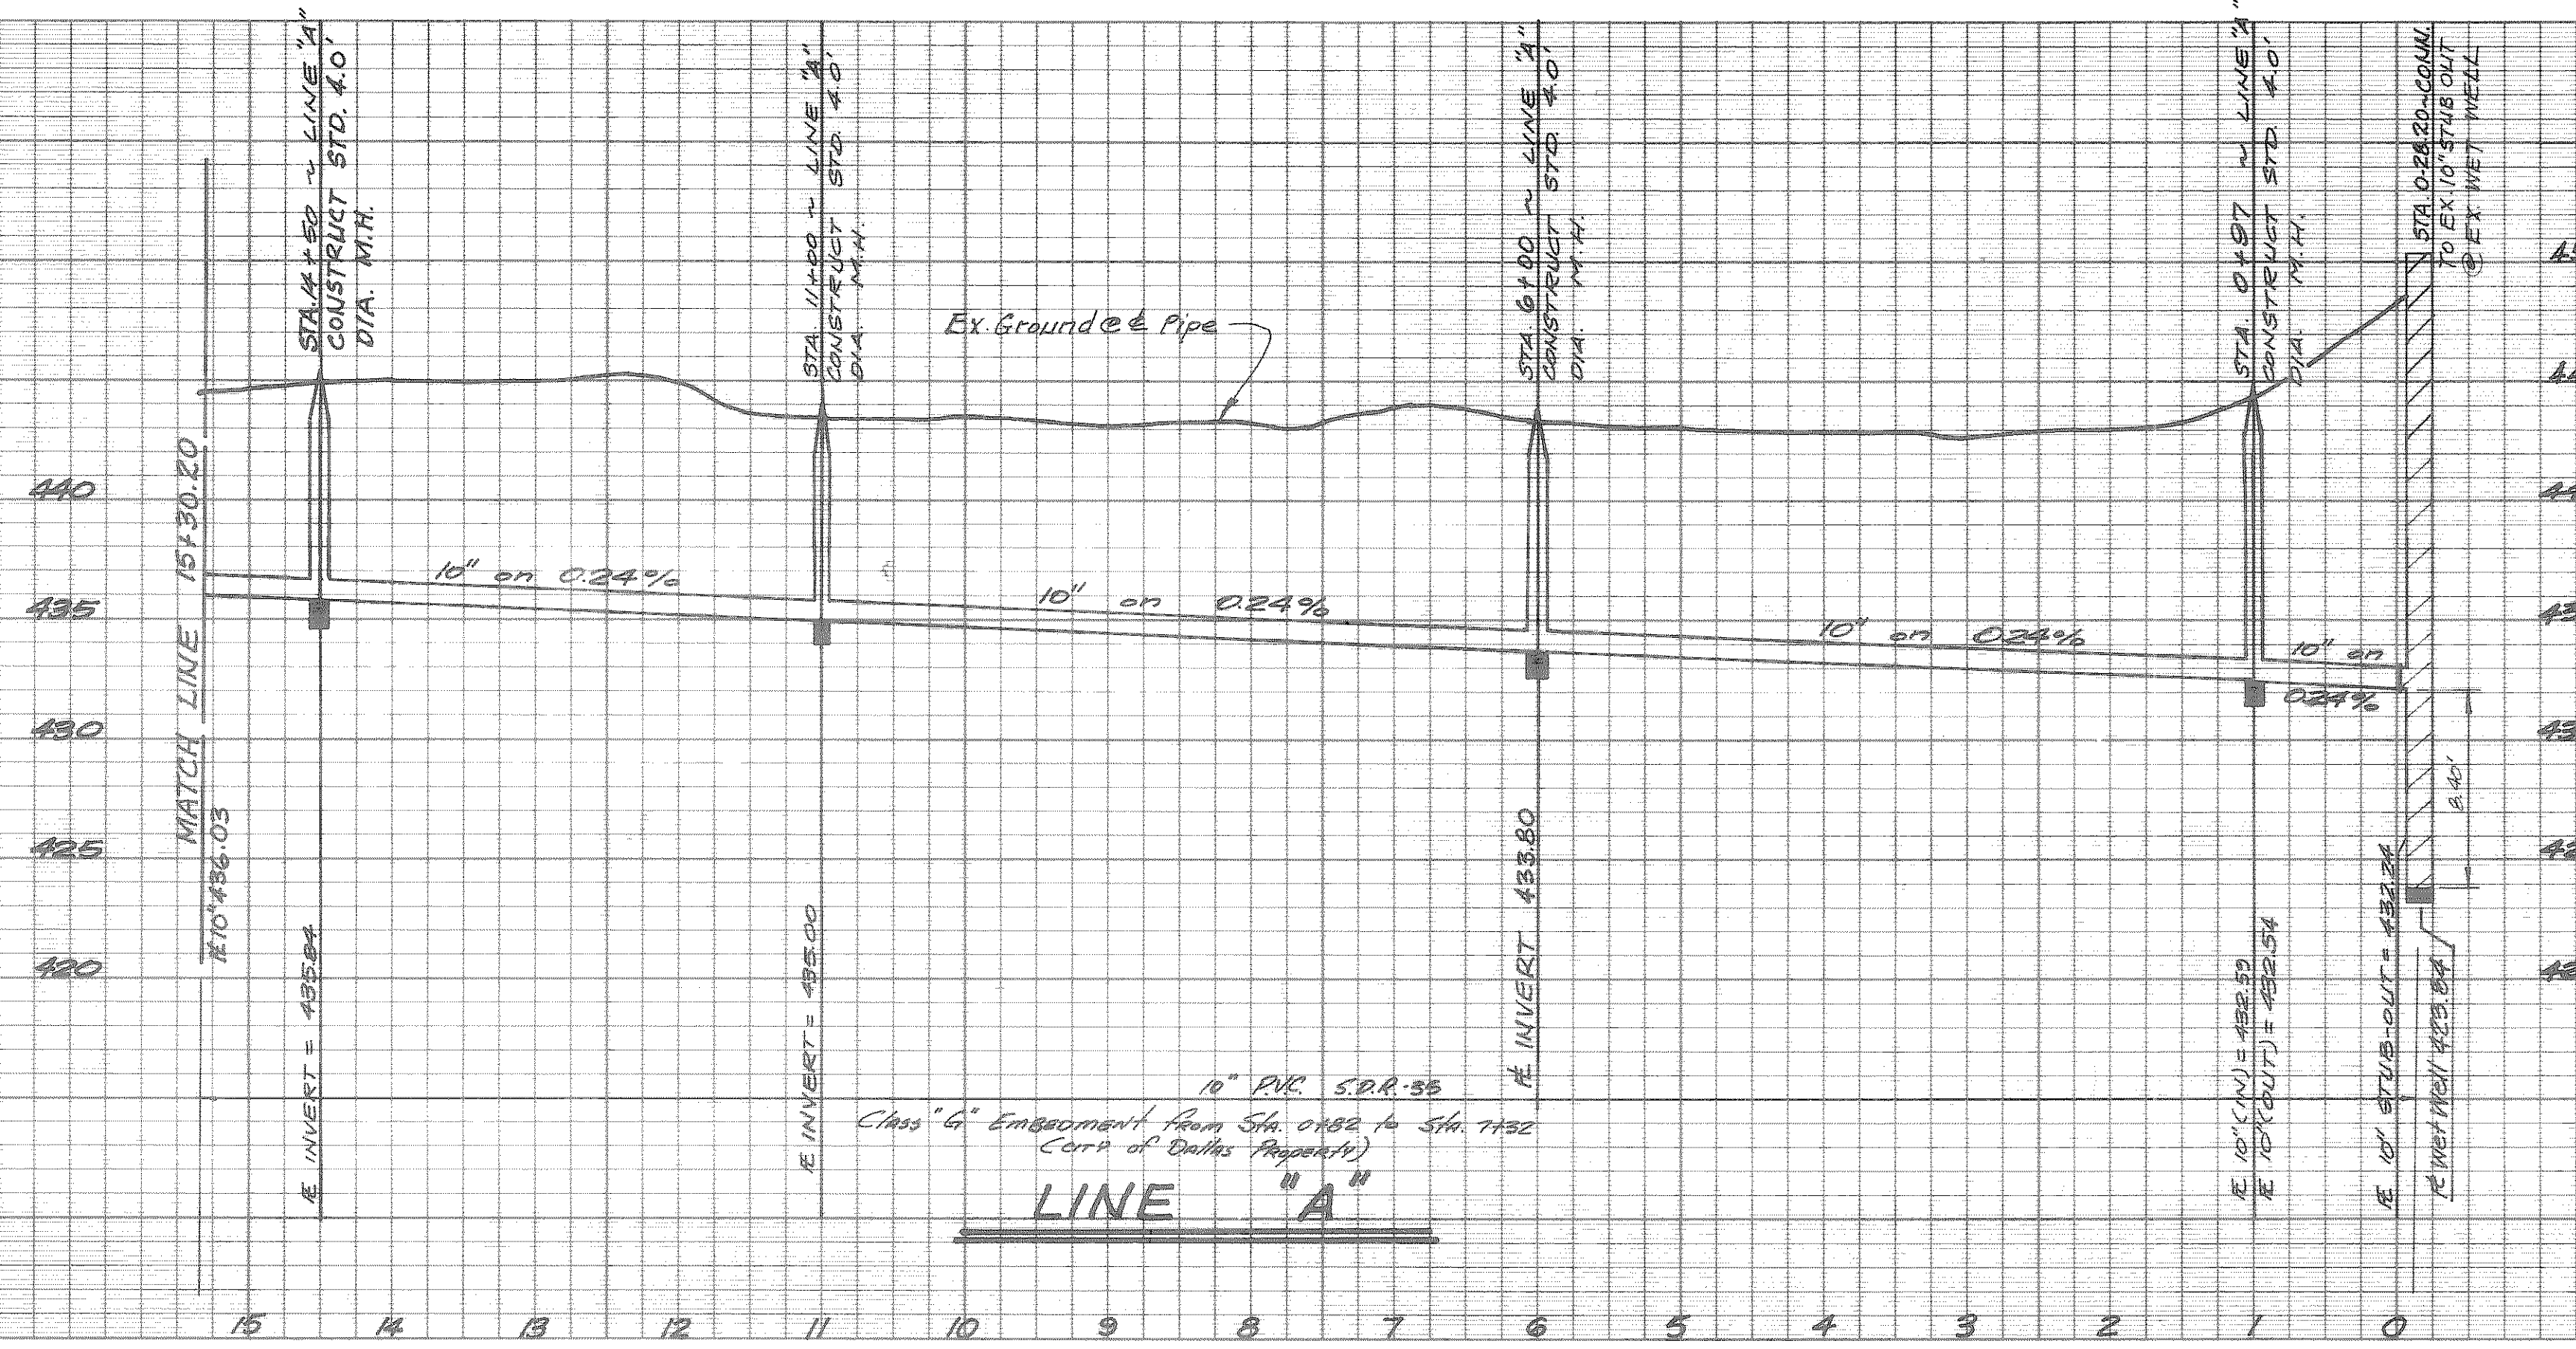

Revised: 5-16-88, 6-13-88, 6-16-88, 10-6-88

HAROLD L EVANS
CONSULTING ENGINEER
2331 GUS THOMASSON RD. SUITE 102
DALLAS, TEXAS 75228
PHONE (214) 328-8133

SANITARY SEWER IMPROVEMENTS
HARBOR PHASE ONE
CITY OF ROCKWALL
ROCKWALL COUNTY, TEXAS

SCALE	DATE	JOB NO.
1" = 100' H 1" = 6' V	3-28-88	8723