

PAVING, DRAINAGE, WATER AND SEWER IMPROVEMENTS

FOR THE

ROCKWALL IMAGING CENTER

PART OF LOT 1, BLOCK B

OF THE

HORIZON RIDGE ADDITION


IN

THE CITY OF ROCKWALL

ROCKWALL COUNTY, TEXAS

CIVIL ENGINEER: RKM CONSULTING ENGINEERS, INC.
 14673 MIDWAY ROAD, SUITE 203
 ADDISON, TEXAS 75001
 (214) 432-8070 PH
 (214) 432-6069 FAX
 ROBERT K. MANAOIS, P.E.

DEVELOPER: HANING CONSTRUCTION COMPANY
 1213 PINE BLUFF ST.
 PARIS, TEXAS 75460
 (903) 784-4034 OFFICE
 (903) 784-4034 FAX
 JERRY HANING

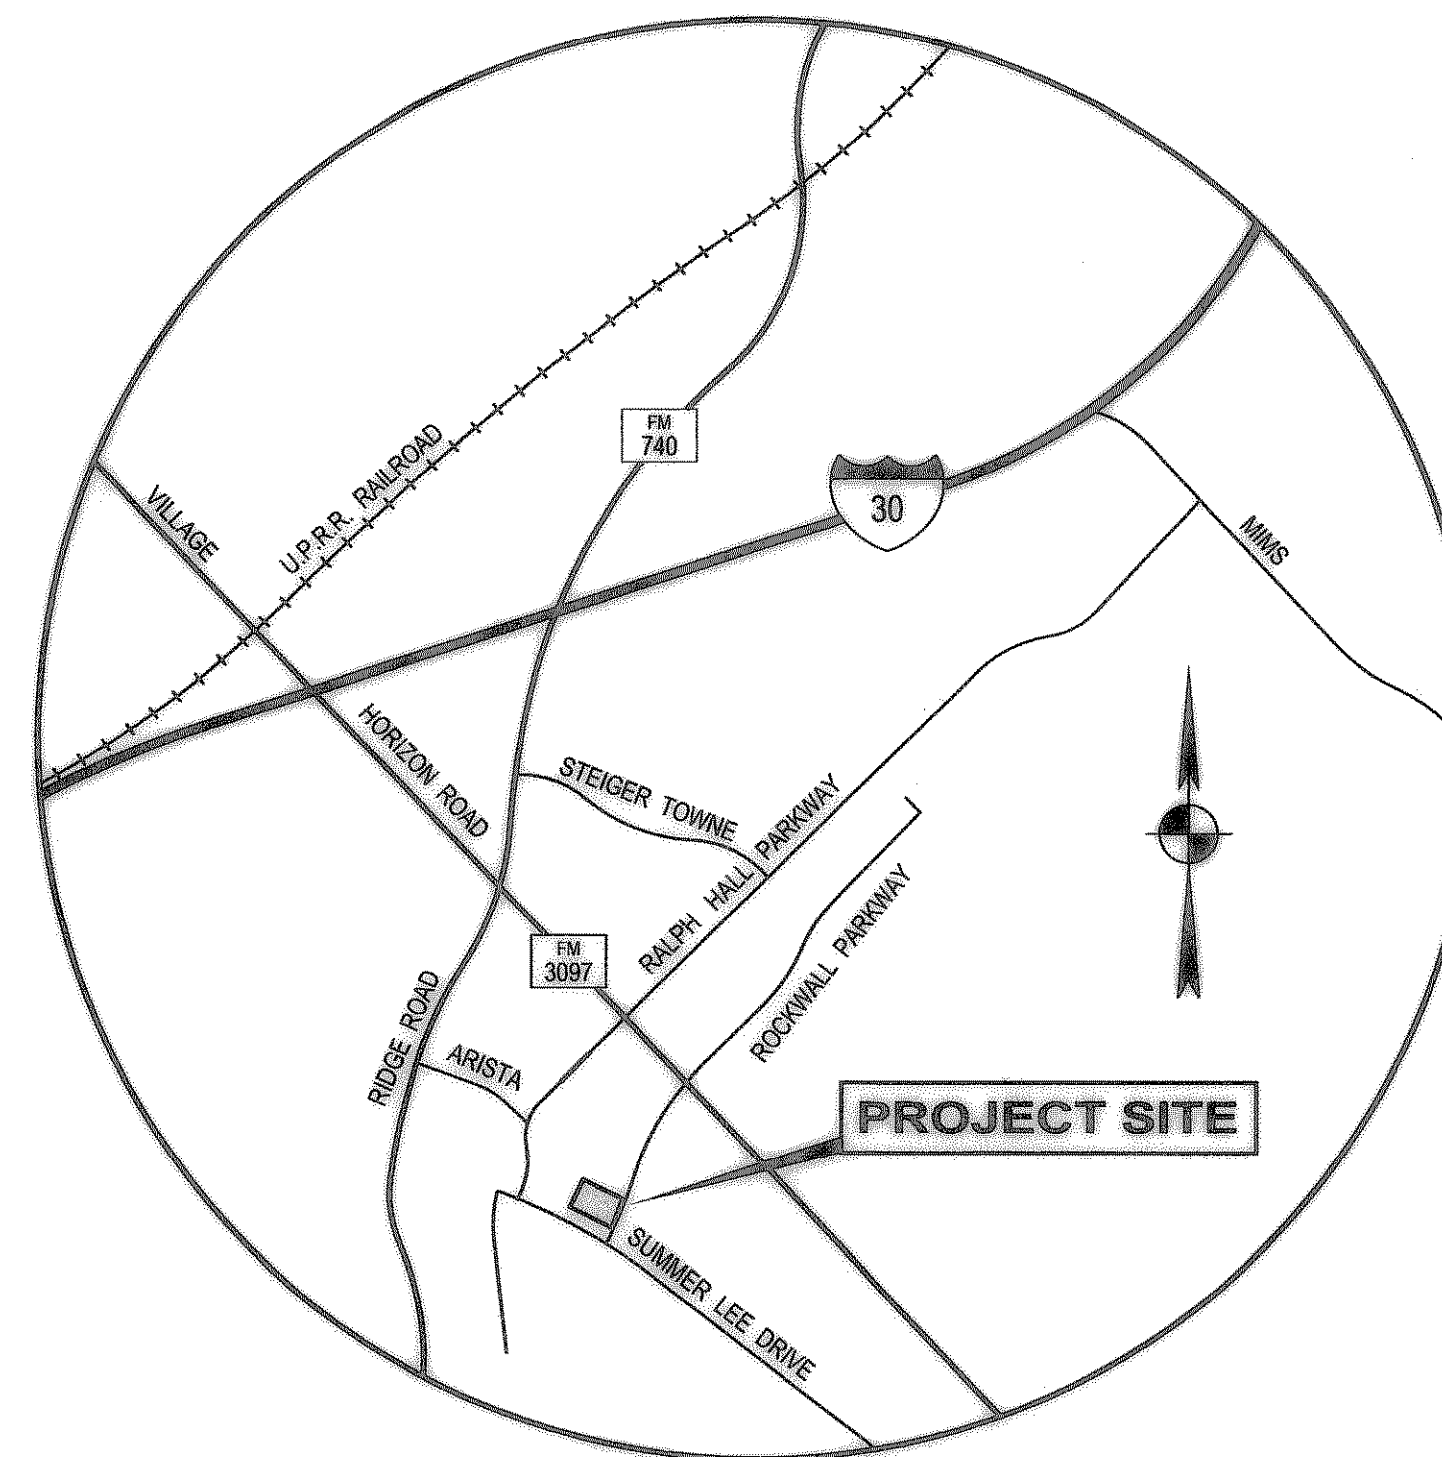

VICINITY MAP
 N.T.S.
 DALLAS MAPSCO 30C-K


SHEET INDEX

SHEET NO.	DESCRIPTION
1	COVER SHEET
2	FINAL PLAT
3	FINAL PLAT
4	GENERAL NOTES
5	DIMENSIONAL CONTROL PLAN
6	PAVING PLAN
7	GRADING PLAN
8	DRAINAGE AREA MAP
9	DRAINAGE CALCULATIONS
10	STORM SEWER PLAN
11	WATER & SANITARY SEWER PLAN
12	STORM & SANITARY PROFILES
13	EROSION CONTROL PLAN
14	EROSION CONTROL DETAILS
15	SITE DETAILS
16	LANDSCAPE PLAN

BENCHMARKS:

- #1: BOX CUT IN NW CURB RETURN AT THE INTERSECTION OF WESTWOOD AND ROCKWALL PARKWAY.
ELEVATION = 537.56
- #2: TOP OF N. CORNER OF CURB INLET APPROXIMATELY 100 FEET SOUTH OF THE PROPERTY ALONG THE EAST SIDE OF RALPH HALL PARKWAY.
ELEVATION = 543.18'

RECORD DRAWING
 RECORD INFORMATION PROVIDED BY HANING
 CONSTRUCTION COMPANY, PARIS, TEXAS
 ELEVATION VERIFICATION PERFORMED BY JMAC
 SURVEYING & MAPPING, INC. DENTON, TEXAS

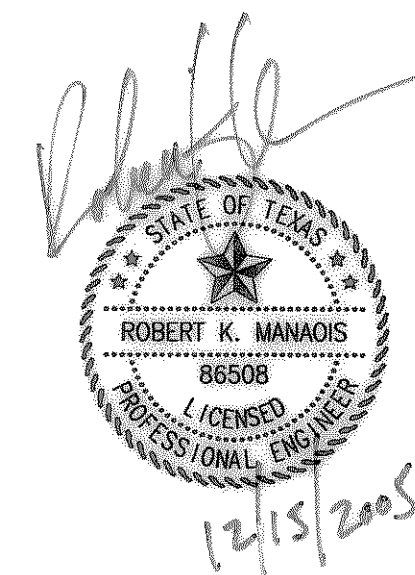

DECEMBER, 2005

RKM Consulting Engineers, Inc.
 14673 Midway Road, Ste 203 Addison, Texas 75001
 phone (214) 432-8070 fax (214) 432-8069