




**STORM LINE "A"  
PUBLIC**

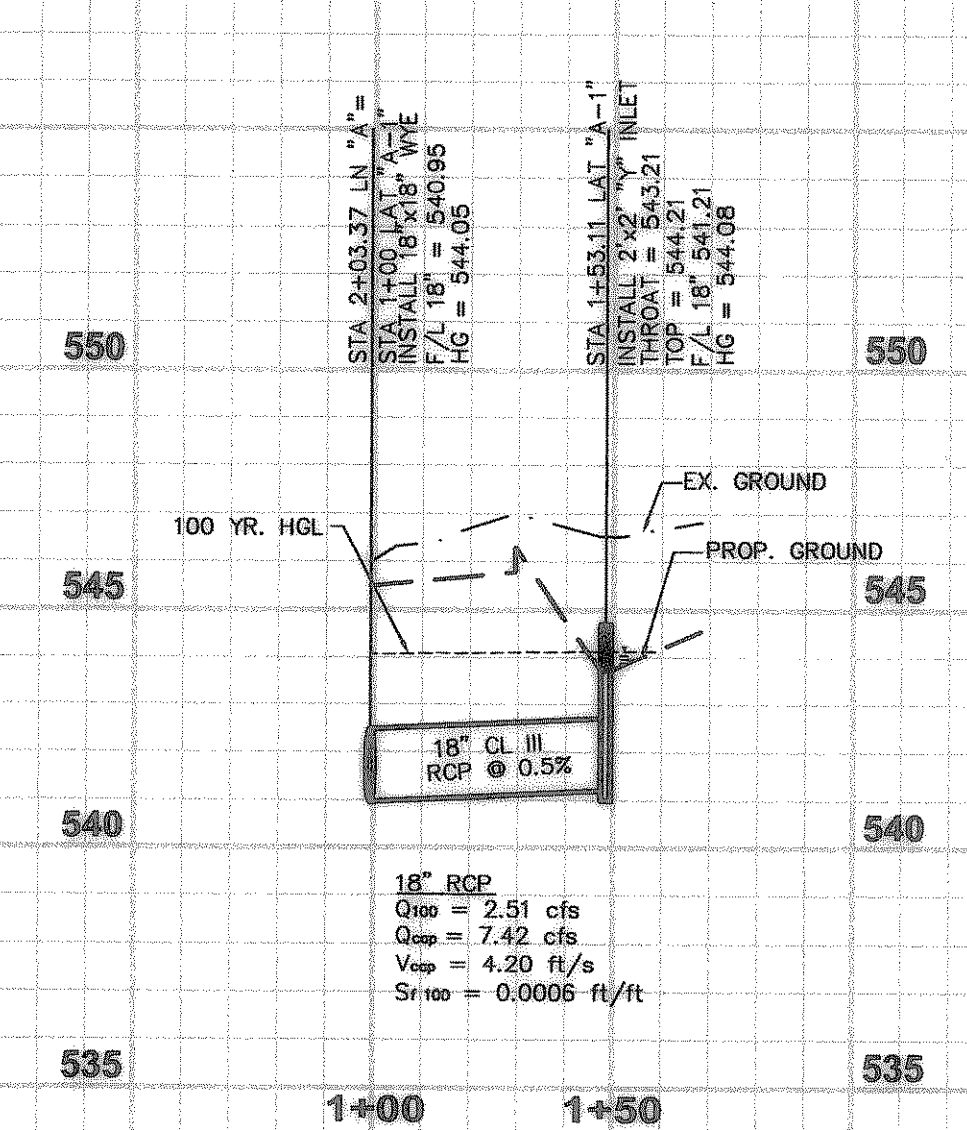

**STORM LAT "A-1"  
PUBLIC**

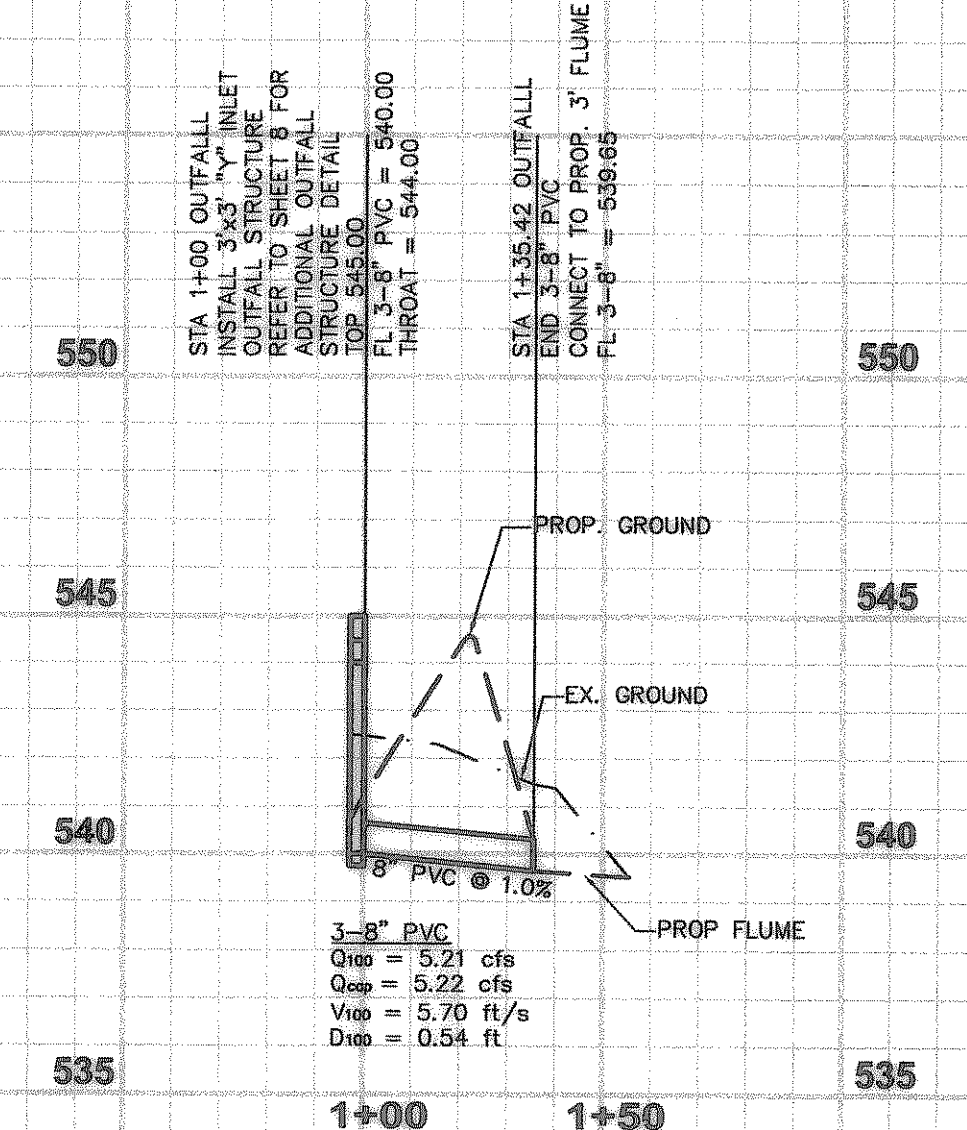


**OUTFALL  
PUBLIC**

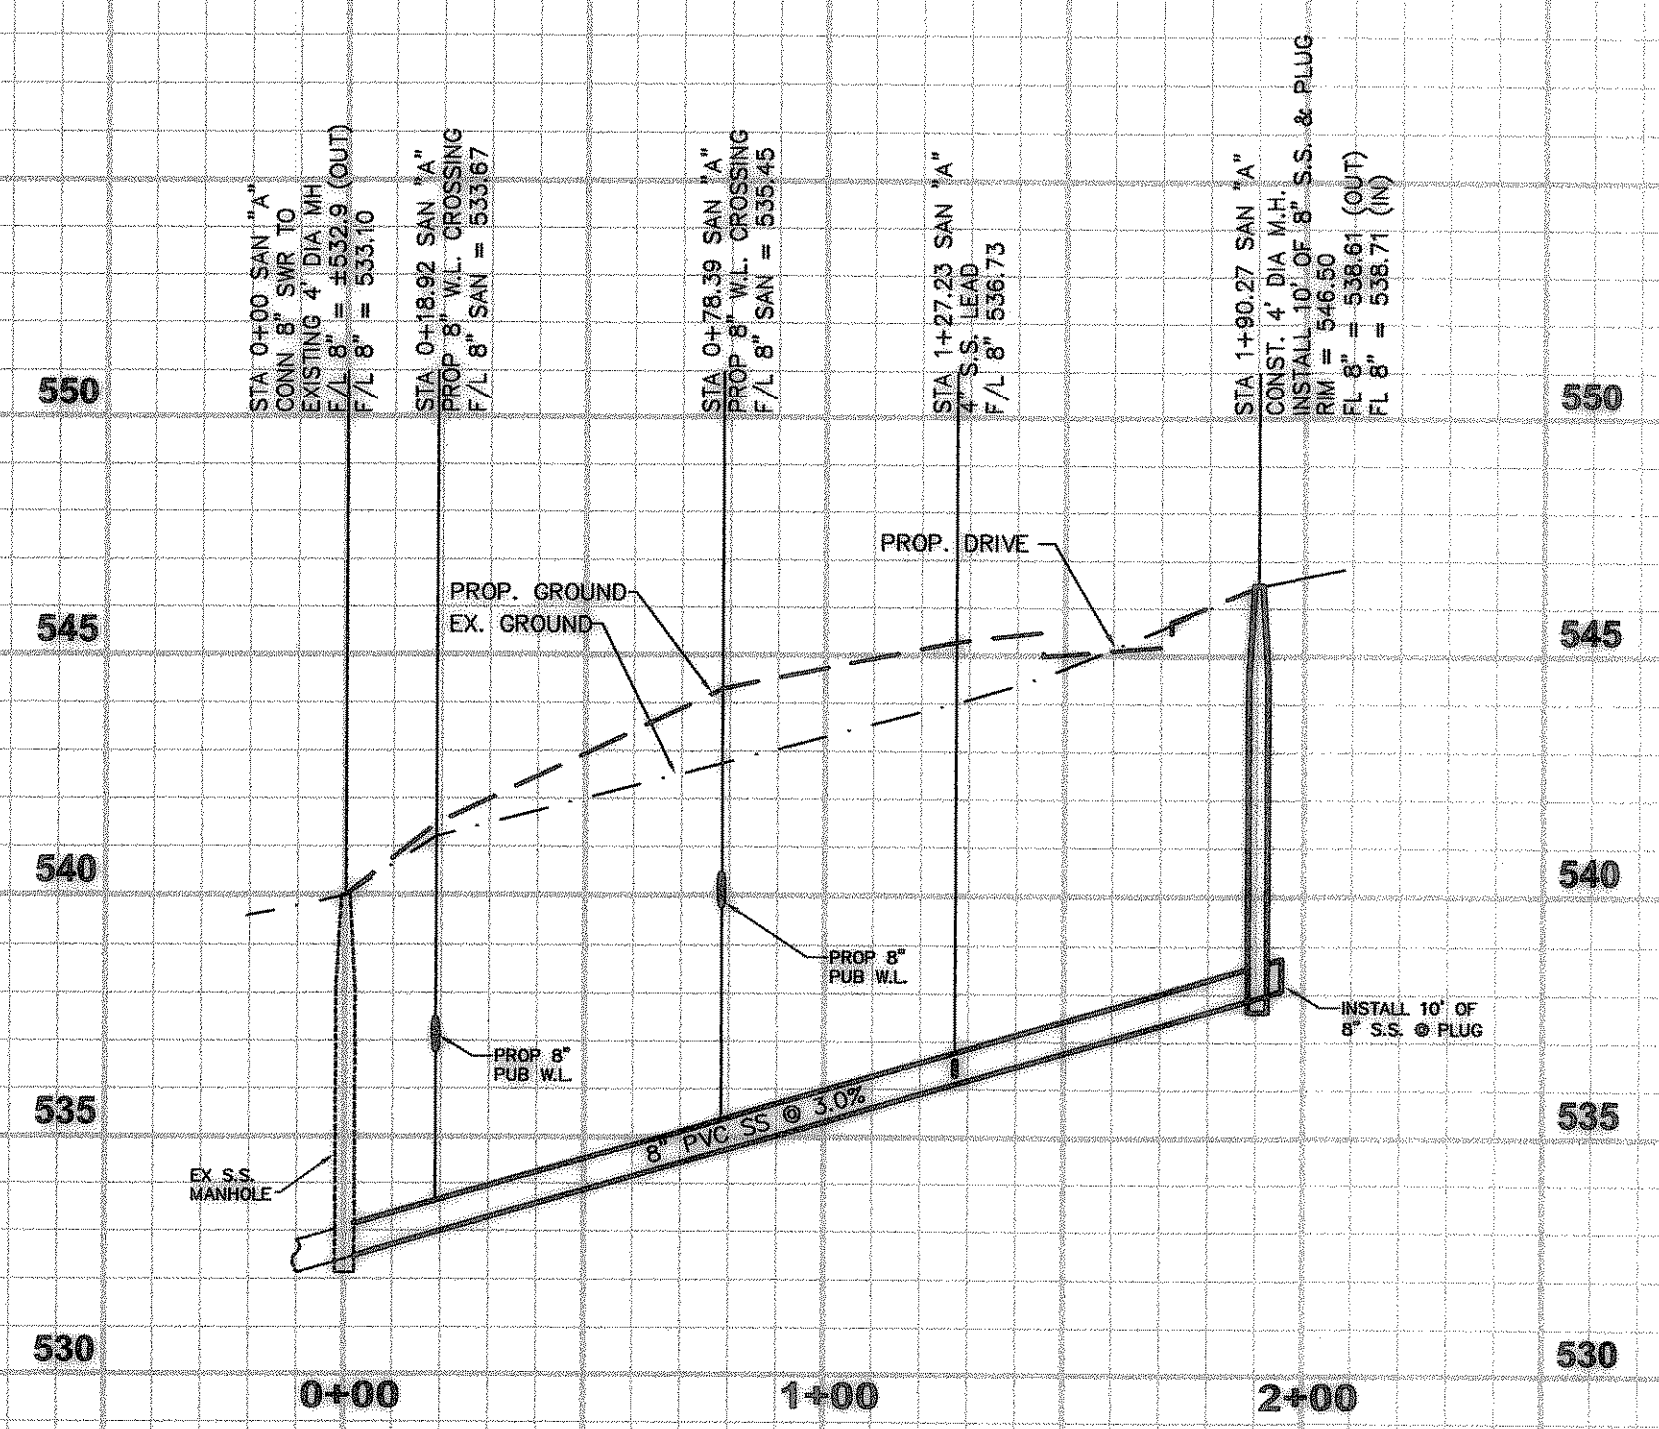

**8" SANITARY SEWER LINE  
PUBLIC**

**BENCHMARK:**  
BOX CUT IN NW CURB RETURN AT  
THE INTERSECTION OF WESTWOOD  
AND ROCKWALL PARKWAY.  
ELEVATION = 537.56

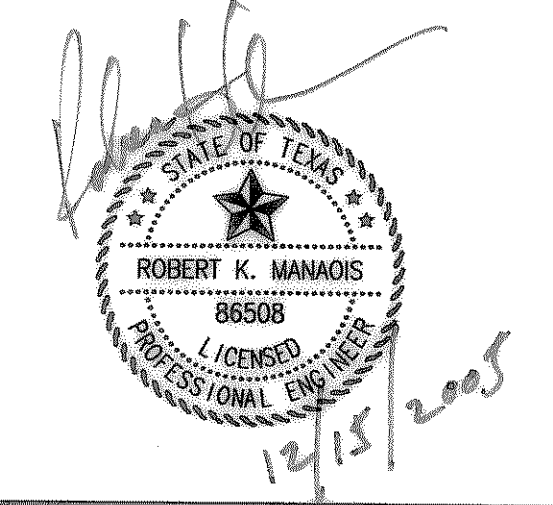

**RECORD DRAWING**  
RECORD INFORMATION PROVIDED BY HANING  
CONSTRUCTION COMPANY, PARIS, TEXAS  
ELEVATION VERIFICATION PERFORMED BY dMAC  
SURVEYING & MAPPING, INC, DENTON, TEXAS

REV.	DATE	REMARKS	BY

**STORM & SANITARY PROFILES**  
OPEN IMAGING OF ROCKWALL  
CITY OF ROCKWALL, TEXAS

**RKM Consulting Engineers, Inc.**  
14673 Midway Road, Ste 203 Addison, Texas 75001  
phone (214) 432-8070  
fax (214) 432-8099

CHECKED	DESIGN	DRAWN	JOB	DATE	SCALE	SHEET
RKM	RKM	RKM	1012-001	12/14/05	1"=40' H 1"=4' V	<b>12</b> OF 16