



REVISIONS

NO.	DESCRIPTION

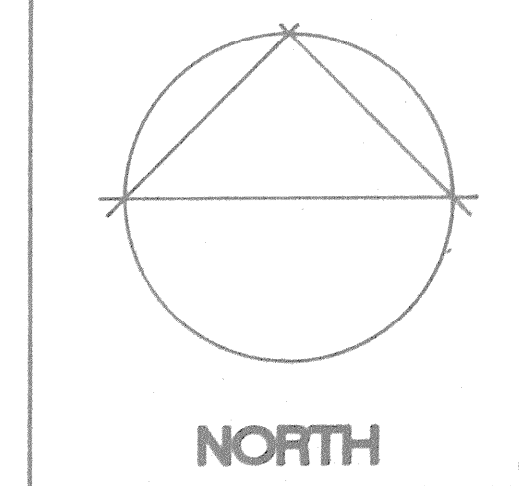

JOHN D. ZIMMERMAN, P.E. RPLS
609 West Main Street
Arlington,
Texas 76013
Telephone 817 461-0188
Facsimile 817 796-7880

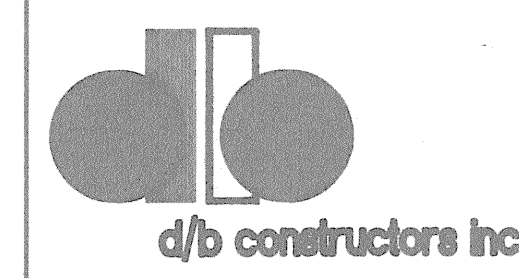

2400 Great Southwest Parkway
Fort Worth, TX

Continental
PET
Technologies, Inc.

700 Industrial Blvd.
Rockwall, Tx. 75087

GRADING AND
DRAINAGE PLAN

SCALE 1"=40'

PROJECT 18418	A1.2
DATE 10-17-94	
DRAWN AVN	
CHECKED JDZ	
	BINDING ORDER

