

2021 Customer Zone
 Project 20180
 Telephone 817 468-1288
 Facsimile 817 468-2818


AGRICULTURAL
 GSB/BATKHOFFST




REVISIONS

NO.	DESCRIPTION

PERMIT DRAWINGS

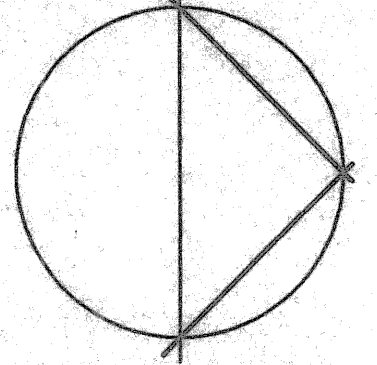

NORTH

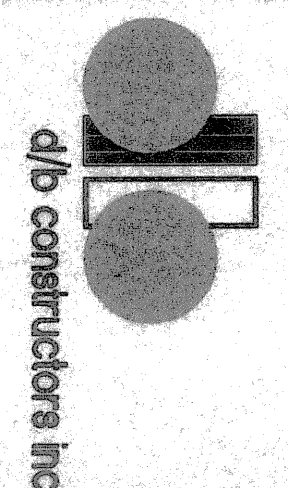

2400 Great Southwest Parkway
 Fort Worth, TX 76107

Continental
PET
 Technologies, Inc.

700 Industrial Blvd.
 Rockwall, TX 75087

GRADING PLAN

SCALE 1"=40'

PROJECT 9418
 DATE 8-18-94
 DRAWN BY TTB, JMW
 CHECKED BY TTB, JMW
A12

