

All materials and construction to be in accordance with City of Rockwall, Texas Standards and Specifications.

All pipe to be DR 18 Class 150 (AWWA C-900 CLASS 150).

Pressure Test at 150 psi for 4 hours or as required by the City of Rockwall, Texas.

See Standard Detail Sheet for Water Distribution System.

Blocking per Standard Detail Sheet.

Contact City of Rockwall Public Works for inspection (214) 771-7700.


Fire Flow Demand supplied by Lone Star Fire Sprinkler Inc. and approved by City of Rockwall, Texas.

7291 Glenview Drive
North Richland Hills,
Texas 76180
Telephone 817 668-1722
Facsimile 817 668-2816


Architects
GSB/BATENHORST

REVISIONS

NO.	DESCRIPTION

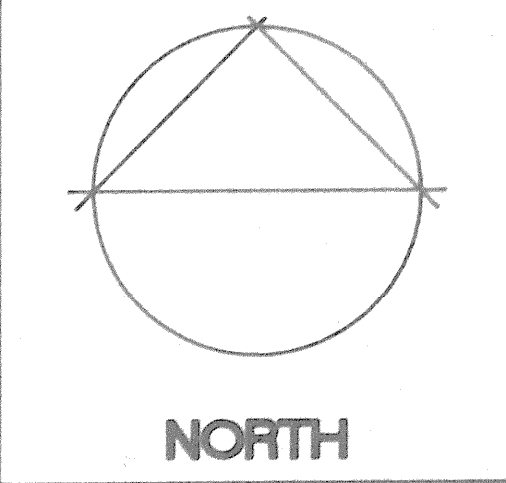

JOHN D. ZIMMERMAN, P.E. RPLS
800 West Main Street
Arlington,
Texas 76013
Telephone 817 481-0188
Facsimile 817 796-7680

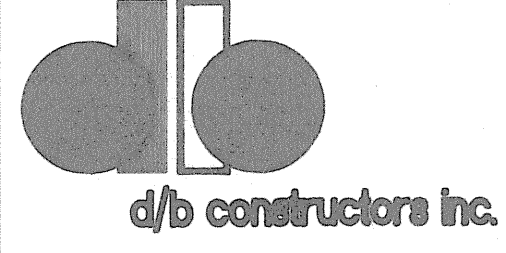

2400 Great Southwest Parkway
Fort Worth, TX

Continental
PET
Technologies, Inc.

700 Industrial Blvd.
Rockwall, Tx. 75087

FIRE PROTECTION PLAN
SCALE 1"=40'

PROJECT 18418	FP-1
DATE 10-17-94	
DRAWN AVN	
CHECKED JDZ	
	BINDING ORDER

