


FIRE PROTECTION SITE PLAN  
SCALE 1" = 40'

- UNDERGROUND NOTES
1. All underground piping shall be installed in accordance with N.E.P.A. 24 and the city of Rockwell, TX.
  2. Offsets shall be restrained with thrust blocks and mating retainer glands.
  3. All underground piping on 18" or 18" P.V.C. class 900 P.V.C.
  4. Underground piping shall be tested hydrostatically at 200 p.s.i. for 2 hours.
  5. Reuse existing valves and hydrants for relocation.
  6. Contact the city of Rockwell for inspections and testing @ 214-771-7760.

CONTACT NO.	BY THOMAS MINKER	SHEET NO.	1 OF 4
DATE	9-22-94		
CONTINENTAL PET TECHNOLOGIES 700 INDUSTRIAL BLVD. ROCKWELL, TX.			
LONE STAR FIRE SPRINKLER, INC. 648 PHYCOT LN KELLER, TX 76248 817-431-6685			

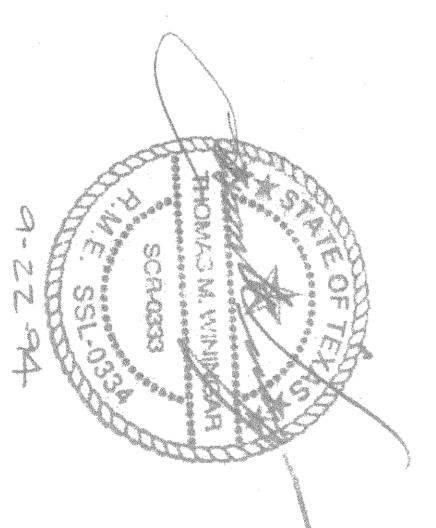

Continental <b>PET</b> Technologies, Inc. 700 Industrial Blvd. Rockwell, TX 75087		REVISIONS 9/21 CONTINENTAL PET TECHNOLOGIES
		FIRE SPRINKLER SITE PLAN SCALE 1" = 40' DATE 9-22-94 DRAWN BY THOMAS MINKER CHECKED BY [Signature] BRIDGING ORDER # [Blank]