


EXISTING TOPOGRAPHY

SCALE: 1" = 40'-0"

LEGEND	
-----570-----	EXISTING TOPOGRAPHY

g W C Engineering, LP

4201 Spring Valley Road Ste. 1120
Farmers Branch, Tx 75244
(tel) 469-374-0810 (fax) 469-374-0811
(email) production@gwceengineering.com

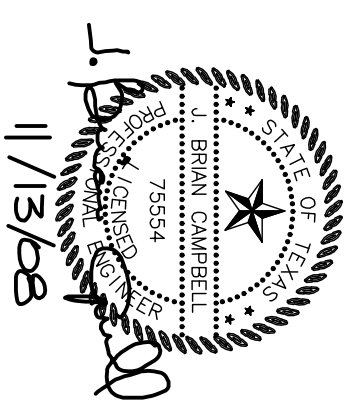

AS-BUILT DRAWINGS

REVISIONS:

11/13/08

DRAWN BY: IMH
CHECKED BY: JBC
ISSUE DATE: JUN 2008
JOB NUMBER: 50304


SHEET NO:

C-1

New Facility for New Car Dealership

Rockwall Kia

1790 East Interstate 30
Rockwall, Texas

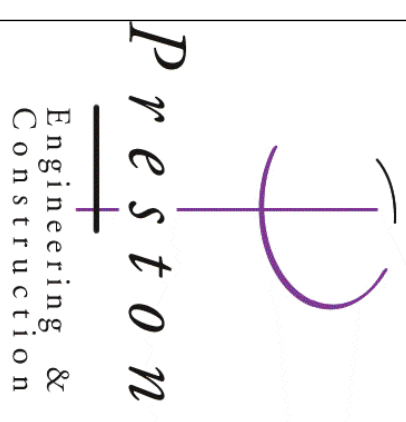

12770 Oak Rd, Suite # 902 Dallas, TX 75251
Phone 972-991-0498 Fax 972-991-0499