


PAVING PLAN
SCALE: 1" = 40'-0"

LEGEND


- EXPANSION JOINT SEE DTL. 1/C-6
- 8" 3600 PSI W/6" LIME STABILIZATION
- OR
- 10" 3600 PSI W/O LIME STABILIZATION

NOTE:

1. PLACE EXPANSION JOINTS AS SHOWN ON PLAN (60' O.C. MAX).
2. PLACE CONTROL JOINTS AT 20' O.C. MAX.
3. ALL PAVING IS 6" THICK 3600 PSI CONCRETE.
4. USE CITY OF ROCKWALL & NTCOG 3RD EDITION STANDARDS FOR ALL PAVING AND CURB DETAILS.
5. FREELANE TO BE MIN 6" 3600 PSI CONCRETE (MIN 6 SACK FOR MACHINE PLACE AND MIN 6½ SACK FOR HAND PLACE).

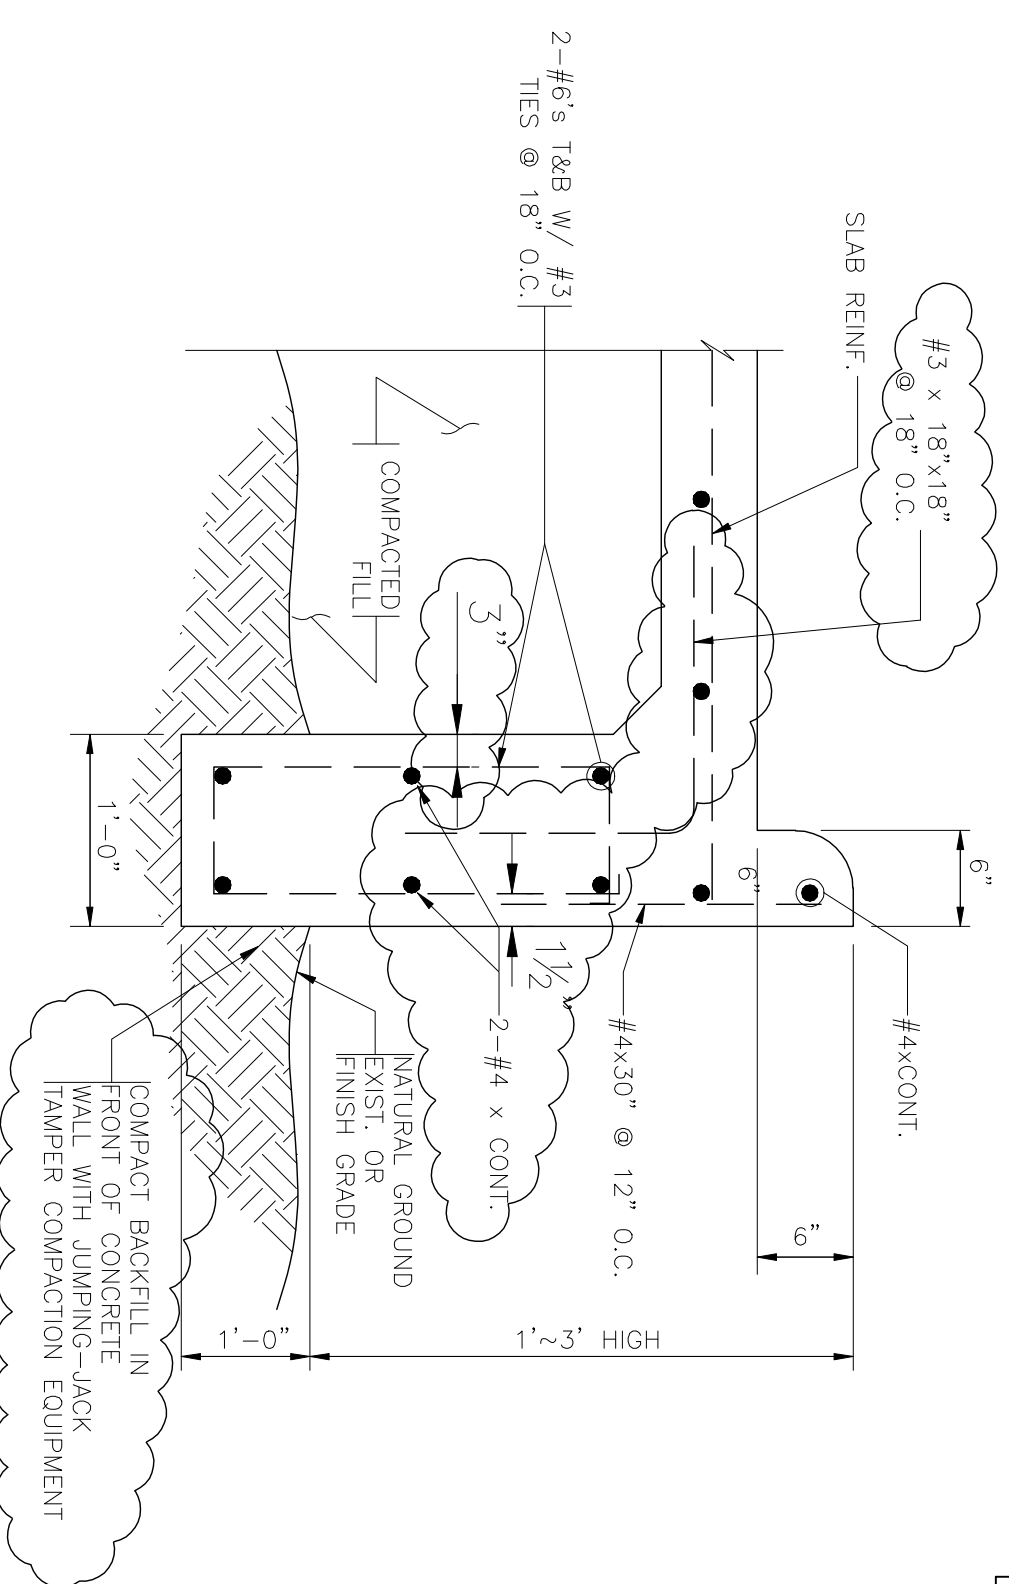

1 TYP. PARKING LOT RETAINING WALL
NOT TO SCALE

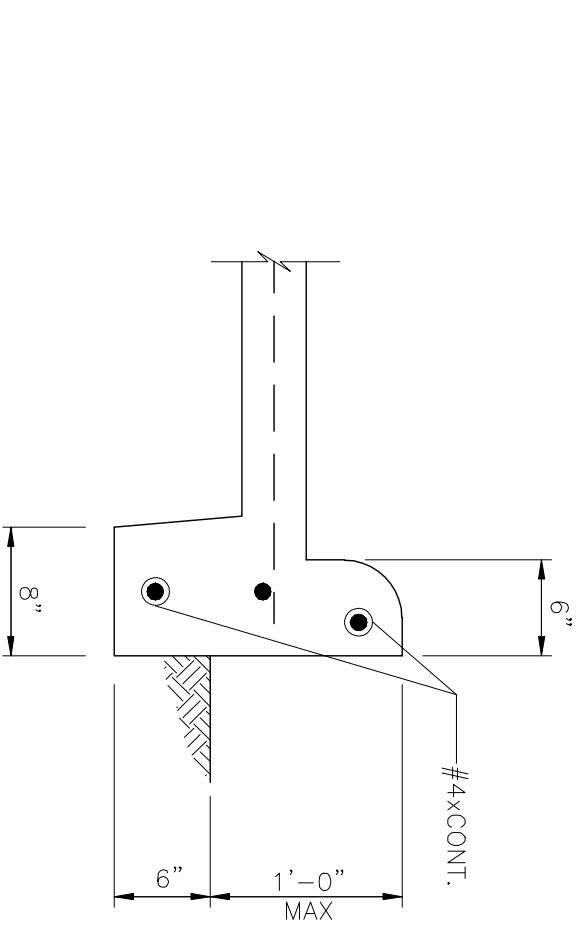

2 SHORT PARKING LOT RETAINING WALL
NOT TO SCALE

g W C engineering, LP

4201 Spring Valley Road Ste. 1120
Farmers Branch, Tx 75244
(tel) 469-374-0810 (fax) 469-374-0811
(email) production@gwceengineering.com




12770 Cahill, Suite # 902 Dallas, TX 75251
Phone 972-991-0498 Fax 972-991-0499

New Facility for New Car Dealership

Rockwall Kia

1790 East Interstate 30
Rockwall, Texas

AS-BUILT DRAWINGS

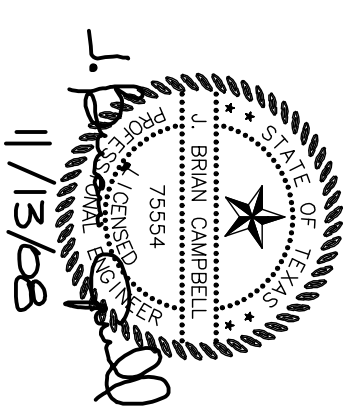

REVISIONS:

DRAWN BY: IMH
CHECKED BY: JBC
ISSUE DATE: JUN 2008
JOB NUMBER: 50304

SHEET NO:

C-6