


I:\2005\25131\lubesite.dwg F:\Jun 30 07:36:47 2006

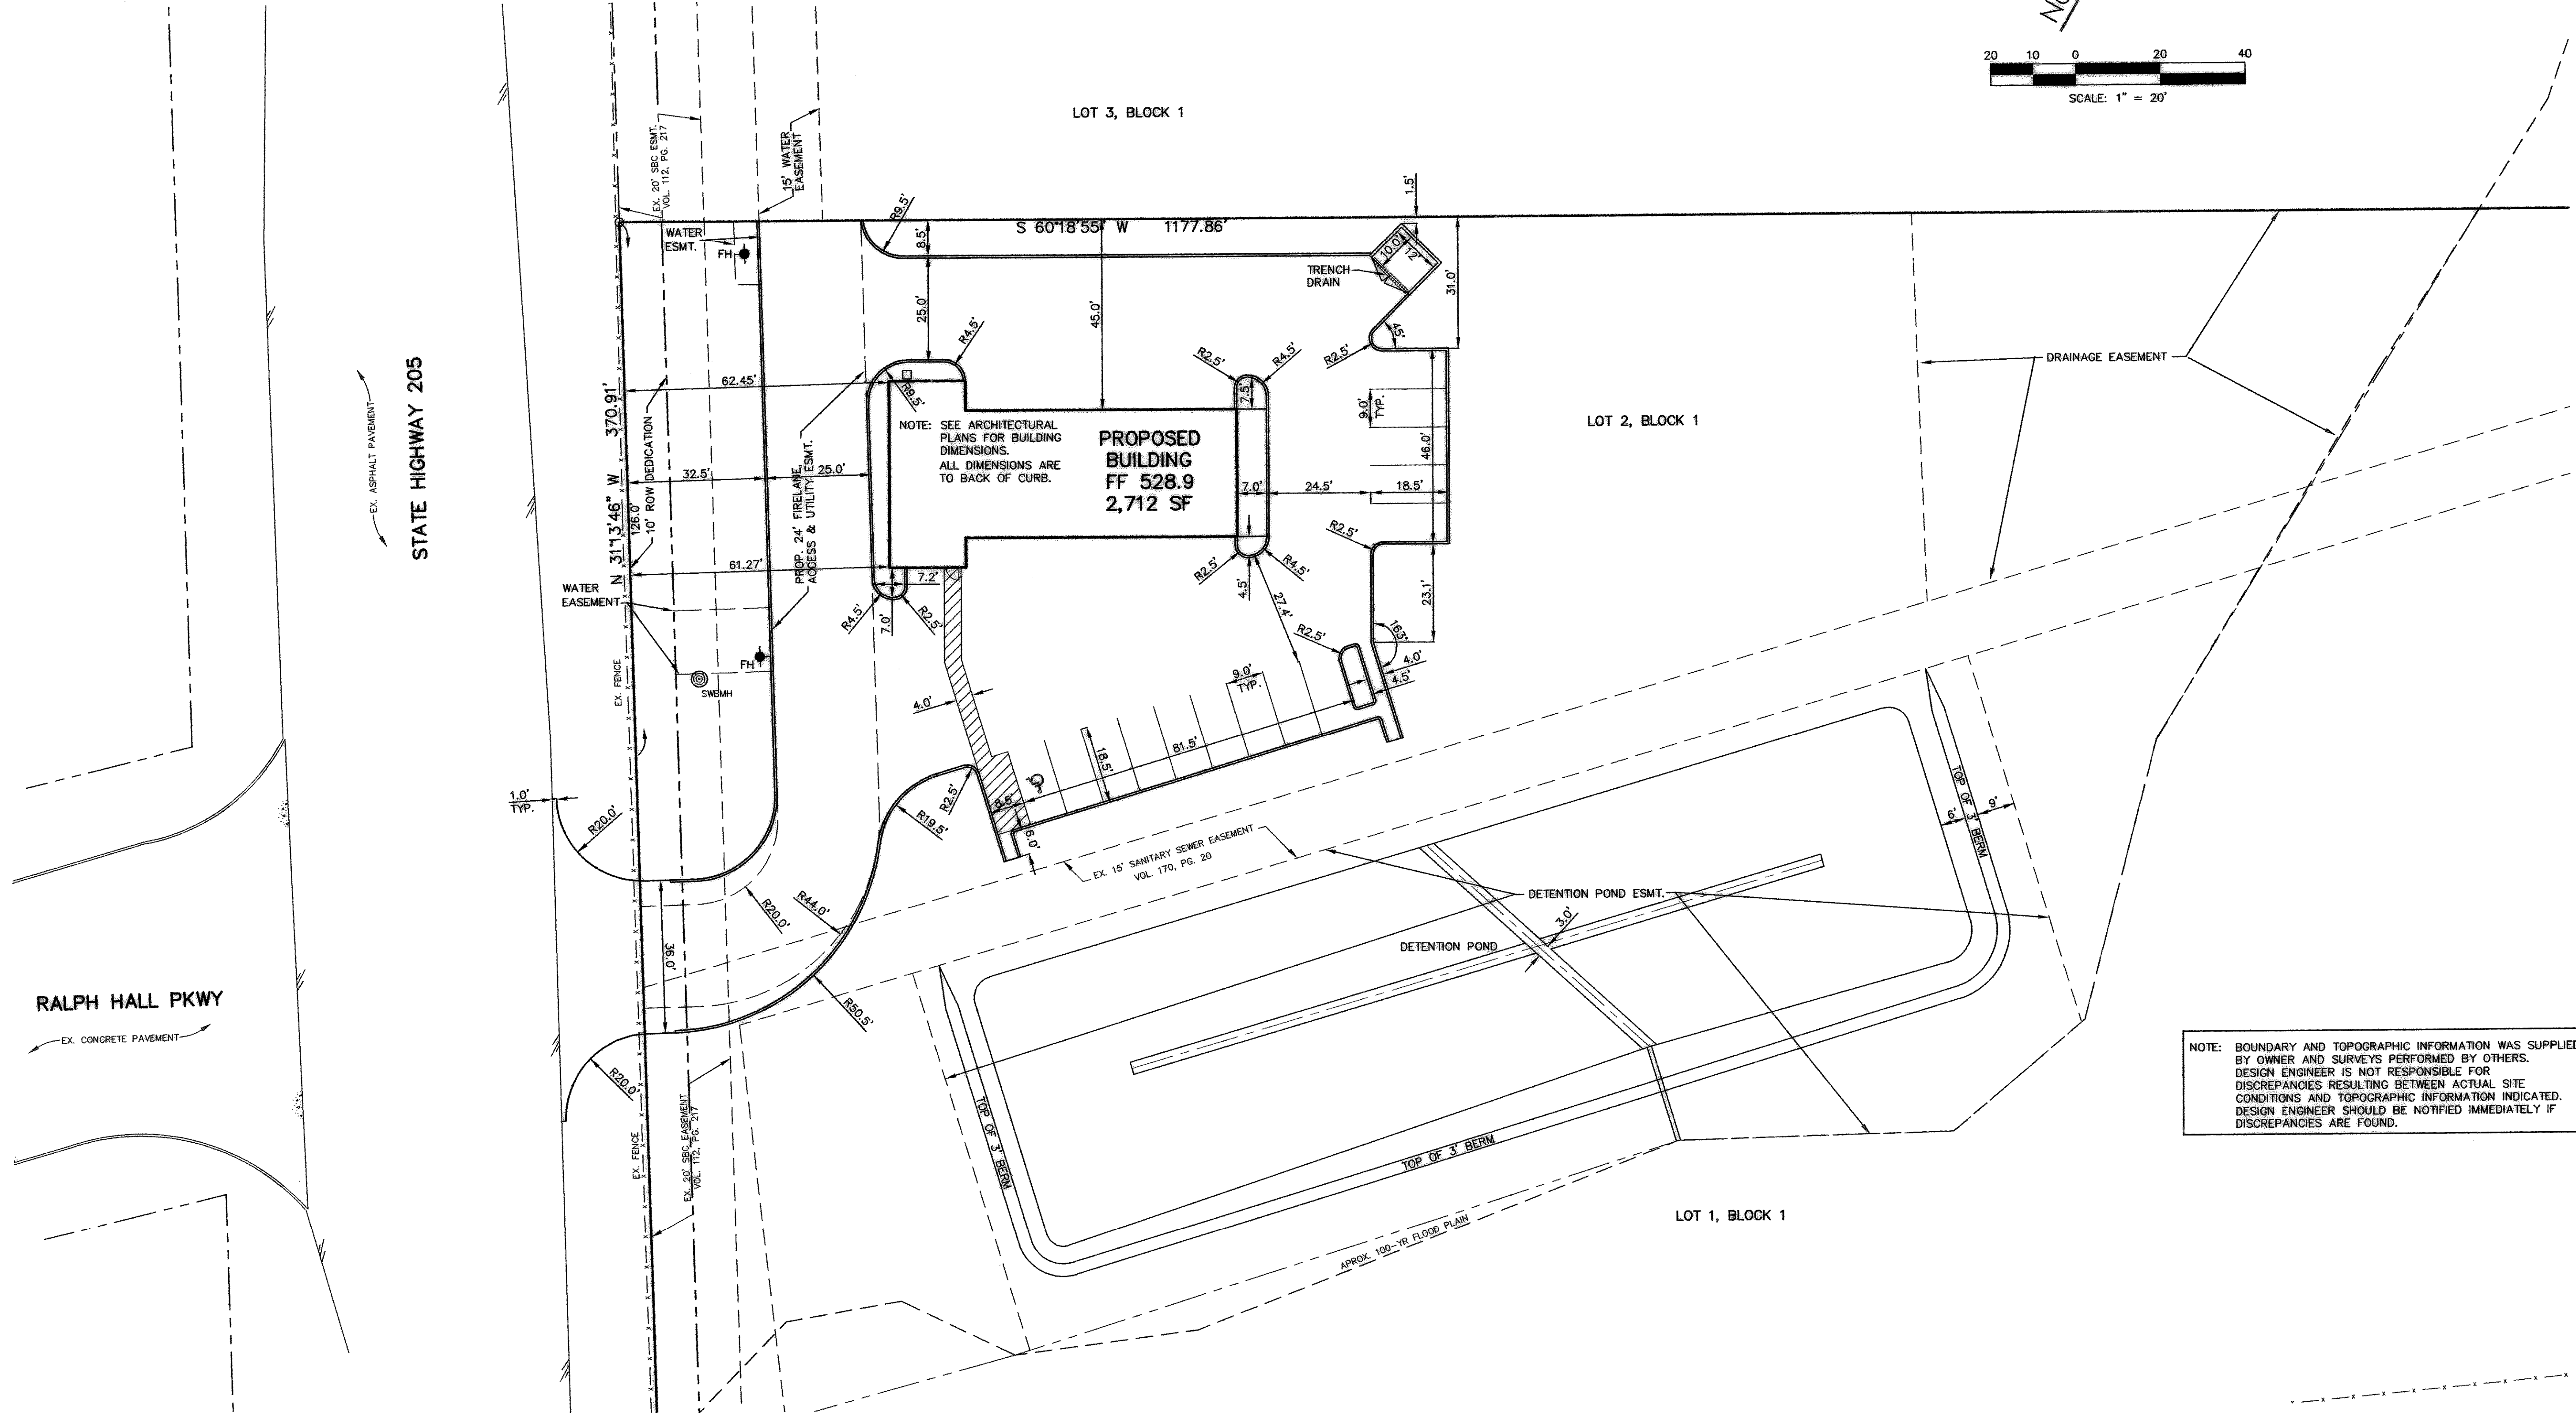

NOTE: BOUNDARY AND TOPOGRAPHIC INFORMATION WAS SUPPLIED BY OWNER AND SURVEYS PERFORMED BY OTHERS. DESIGN ENGINEER IS NOT RESPONSIBLE FOR DISCREPANCIES RESULTING BETWEEN ACTUAL SITE CONDITIONS AND TOPOGRAPHIC INFORMATION INDICATED. DESIGN ENGINEER SHOULD BE NOTIFIED IMMEDIATELY IF DISCREPANCIES ARE FOUND.

41725 BROADWAY BLVD.  
GARLAND, TEXAS 75043  
PH. 972.240.4821  
FAX. 972.240.0722

MARC O. BENTLEY  
64980  
LICENSED PROFESSIONAL ENGINEER  
STATE OF TEXAS

THE SEAL APPEARING ON THIS DOCUMENT WAS AUTHORIZED BY MARC O. BENTLEY, P.E. NO. 64980 ON 11/29/05

**DIMENSION CONTROL**  
MEADOWCREEK BUSINESS CENTER LOT 2, BLOCK 1  
CITY OF ROCKWALL, TEXAS

RECORD DRAWING	No.	Date	Revision

Scale: 1"=20'  
File Name: LUBESITE  
Date: JULY 2005  
Project No.: 25131

Sheet  
**C1**

**RECORD DRAWING**  
IMPROVEMENTS INDICATED ON THESE PLANS WHERE REVISED IN ACCORDANCE WITH THE ASBUILT SURVEY PERFORMED BY ROCKWALL SURVEYING, INC. AND PROVIDED TO BENTLEY ENGINEERING, INC. ON 06/20/06.  
DATE: JUNE 23, 2006