

SANITARY SEWER PROFILE - LINE 'A'

2+00


1+00

0+00

- BENCHMARKS:
- BENCHMARK 1: City of Rockwall Monument Reset #1. ELEVATION = 567.70 feet
 - BENCHMARK 2: Square cut on south bull nose of median, 550± southeast of the intersection of Tubbs Road and F.M. 3097. ELEVATION = 520.73
 - BENCHMARK 3: Square cut on back of curb, southwest of main entrance at Tubbs Road, 100± southwest of helicopter pad. ELEVATION = 530.78

RECORD DRAWING
02/24/14

NOTE:
TO THE BEST OF OUR KNOWLEDGE BROCKETTE DAVIS DRAKE, INC., HEREBY STATES THAT THIS PLAN IS AS-BUILT. THIS INFORMATION PROVIDED IS BASED ON SURVEYING AT THE SITE AND INFORMATION PROVIDED BY THE CONTRACTOR.

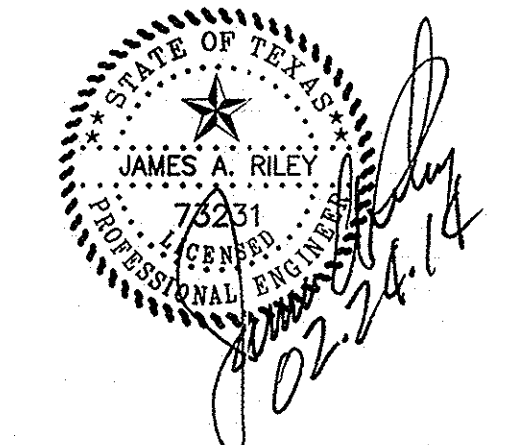


NOTE:
All responsibility for adequacy of the design remains with the Design Engineer. The City of Rockwall, in reviewing and releasing plans for construction, assumes no responsibility for adequacy or accuracy of design.

No.	Revision	Date

SANITARY SEWER PROFILES

MEDICAL OFFICE BUILDING
LOT 7, BLOCK A
PRESBYTERIAN HOSPITAL ADDITION
ROCKWALL, TEXAS

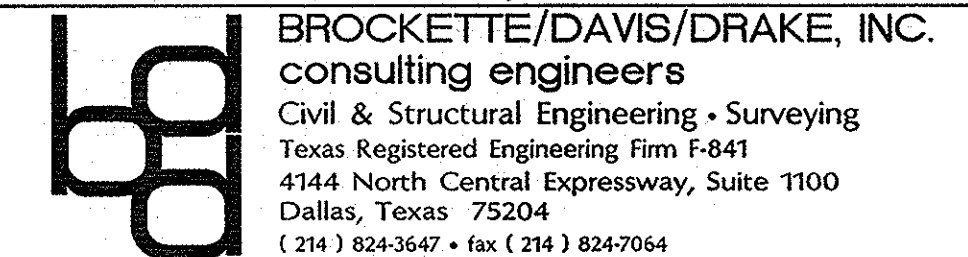

BROCKETTE/DAVIS/DRAKE, INC.
consulting engineers
Civil & Structural Engineering • Surveying
Texas Registered Engineering Firm F-841
4144 North Central Expressway, Suite 1100
Dallas, Texas 75204
(214) 824-3647 • fax (214) 824-7064

DESIGN	DRAWN	DATE	SCALE	NOTES	FILE	NO.
JAR	DJA	05/14/13	H:1"=20' V:1"=5'	BDD	C12126	C10

©Copyright 2013 Brockette/Davis/Drake, Inc. All Rights Reserved.
This drawing is the property of Brockette/Davis/Drake, Inc.
Any modification or use of this drawing without the express
written authorization of Brockette/Davis/Drake, Inc. is prohibited.