


PAVING, DRAINAGE, WATER AND SEWER IMPROVEMENTS
FOR THE
ROCKWALL MEDICAL CENTER PHASE II
LOTS 8 AND LOT 9, BLOCK B
OF THE
HORIZON RIDGE ADDITION
IN
THE CITY OF ROCKWALL
ROCKWALL COUNTY, TEXAS

CIVIL ENGINEER: RKM CONSULTING ENGINEERS, INC.
 14673 MIDWAY ROAD
 SUITE 203
 ADDISON, TEXAS 75001-3182
 (214) 432-8070 PH
 (214) 432-8069 FAX
 ROBERT K. MANAOIS, P.E.

DEVELOPER: PM REALTY GROUP
 3811 TURTLE CREEK BLVD.
 SUITE 800
 DALLAS, TX 75219
 (972) 680-0106 PH
 (972) 680-1066 FAX
 KERRY R. BURDEN

ARCHITECT: GSR-ANDRADE ARCHITECTS
 4121 COMMERCE STREET
 SUITE ONE
 DALLAS, TEXAS 75226
 (214) 824-7040 PH
 (214) 887-0559 FAX
 GARY STAIGER

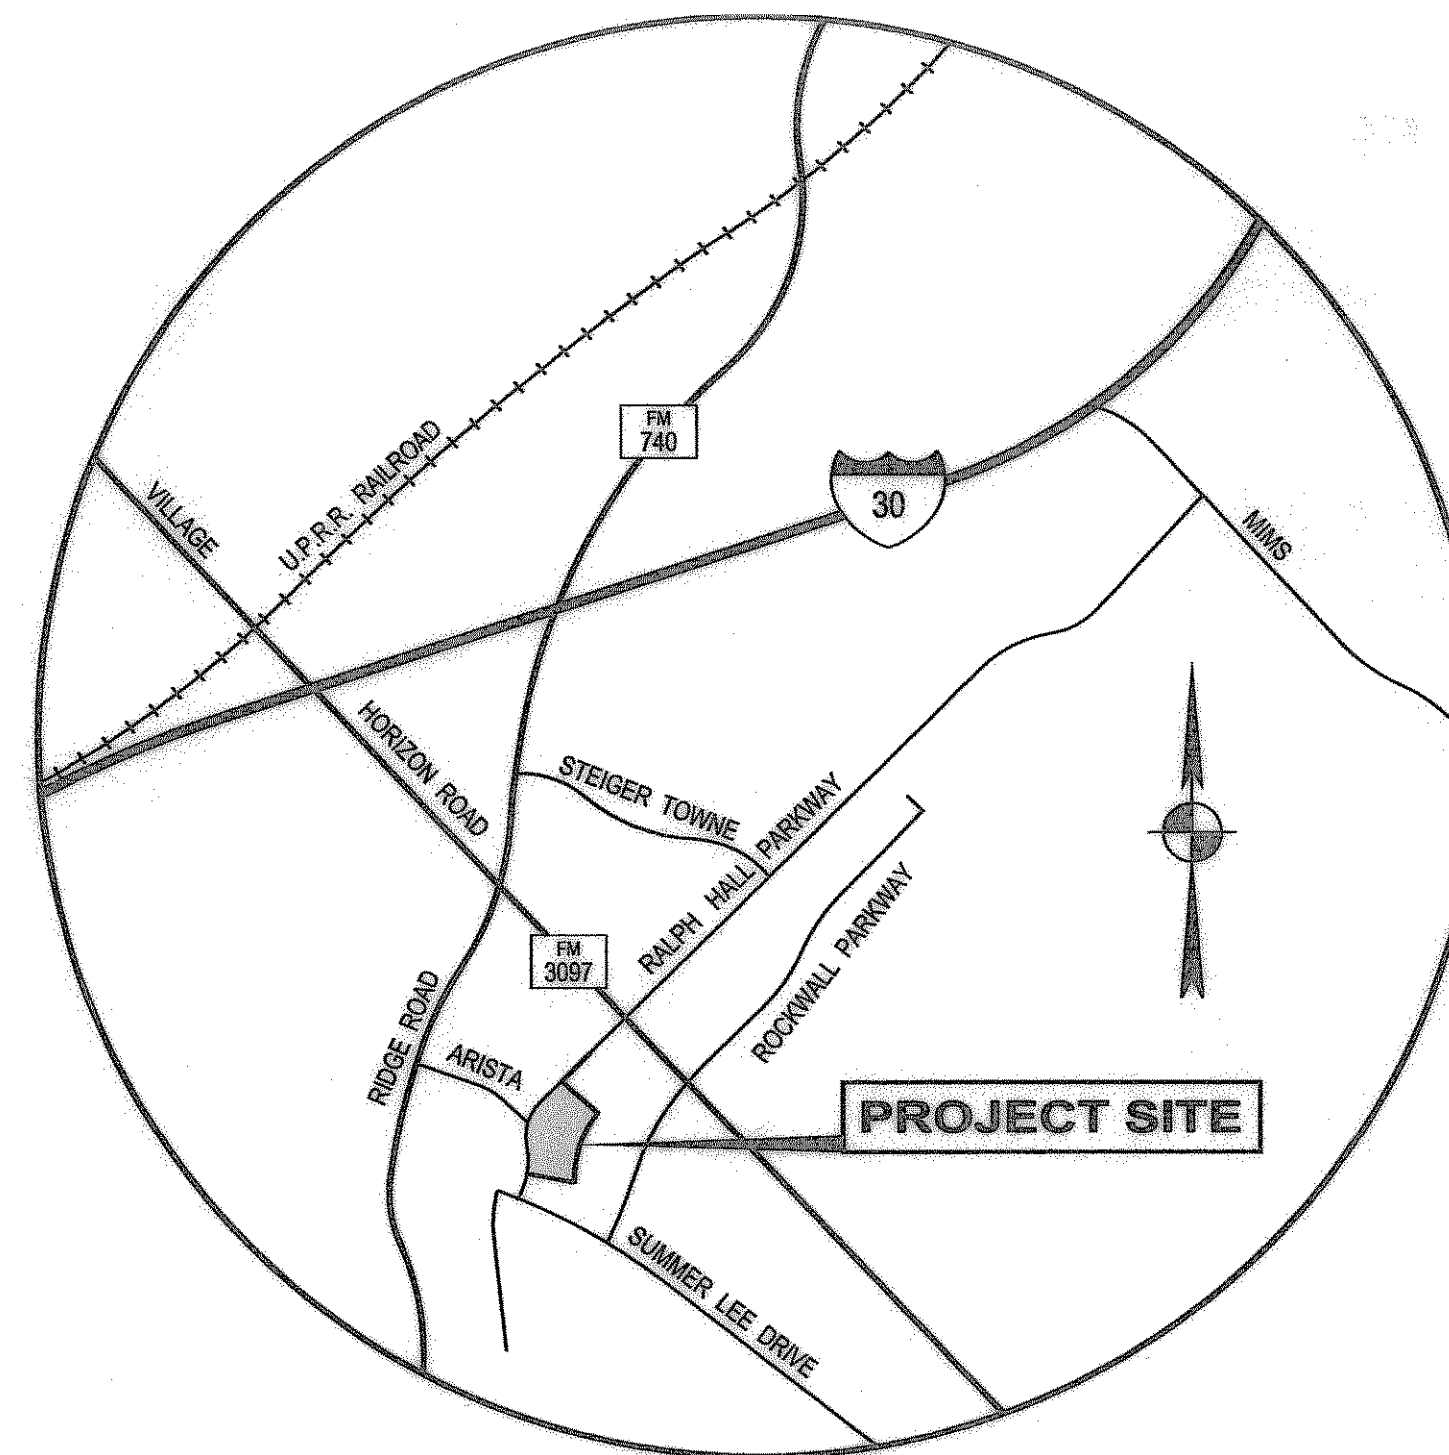

VICINITY MAP
 N.T.S.
 DALLAS MAPSCO 30C-K


July 2005

SHEET INDEX

SHEET NO.	DESCRIPTION
1	COVER SHEET
2	FINAL PLAT (1 OF 3)
2a	FINAL PLAT (2 OF 3)
3	FINAL PLAT (3 OF 3)
4	GENERAL NOTES
5	DIMENSIONAL CONTROL PLAN
6	PAVING PLAN
7	SUMMER LEE DRIVE PLAN & PROFILE
8	GRADING PLAN
9	POND GRADING PLAN
10	OVERALL DRAINAGE AREA MAP
11	ONSITE DRAINAGE AREA MAP
12	STORM SEWER PLAN
13	WATER & SANITARY SEWER PLAN
14	STORM SEWER PROFILES
15	EROSION CONTROL PLAN
16	EROSION CONTROL DETAILS
17	SITE DETAILS
P-1	LANDSCAPE PLAN
P-2	LANDSCAPE PLAN
P-3	LANDSCAPE PLAN
P-4	LANDSCAPE PLAN
P-5	LANDSCAPE PLAN

BENCHMARKS:

- #1: BOX CUT IN NW CURB RETURN AT THE INTERSECTION OF WESTWOOD AND ROCKWALL PARKWAY. ELEVATION = 537.56
- #2: TOP OF N. CORNER OF CURB INLET APPROXIMATELY 100 FEET SOUTH OF THE PROPERTY ALONG THE EAST SIDE OF RALPH HALL PARKWAY. ELEVATION = 543.18'

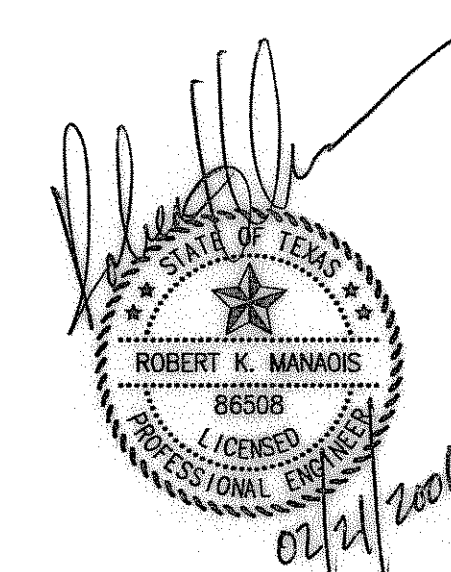

RECORD DRAWING
 RECORD INFORMATION PROVIDED BY
 C. F. JORDAN, L.P., DALLAS, TEXAS
 ELEVATION VERIFICATION PERFORMED BY
 dMAC SURVEYING & MAPPING, DENTON, TEXAS

RKM RKM Consulting Engineers, Inc.
 14673 Midway Road, Suite 203
 Addison, Texas 75001
 phone (214) 432-8070
 fax (214) 432-8069