

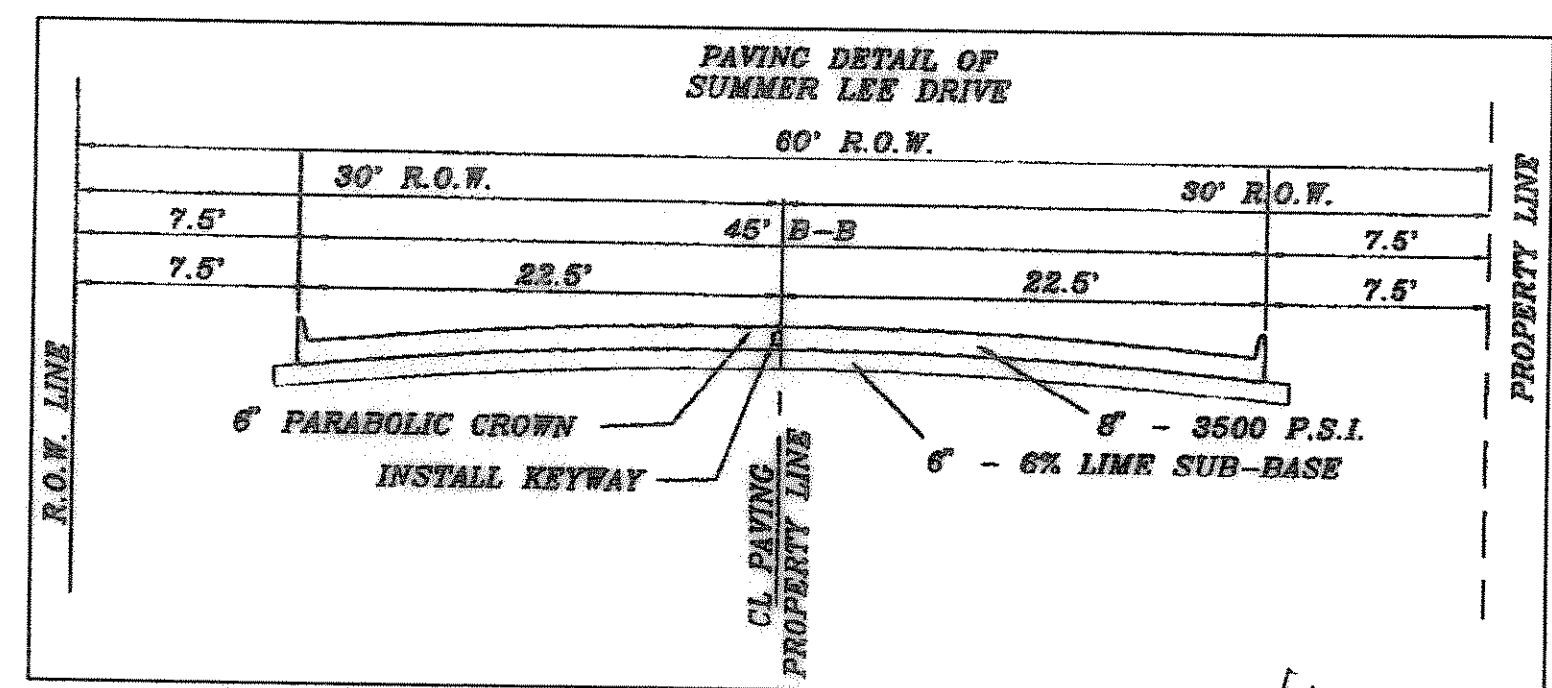
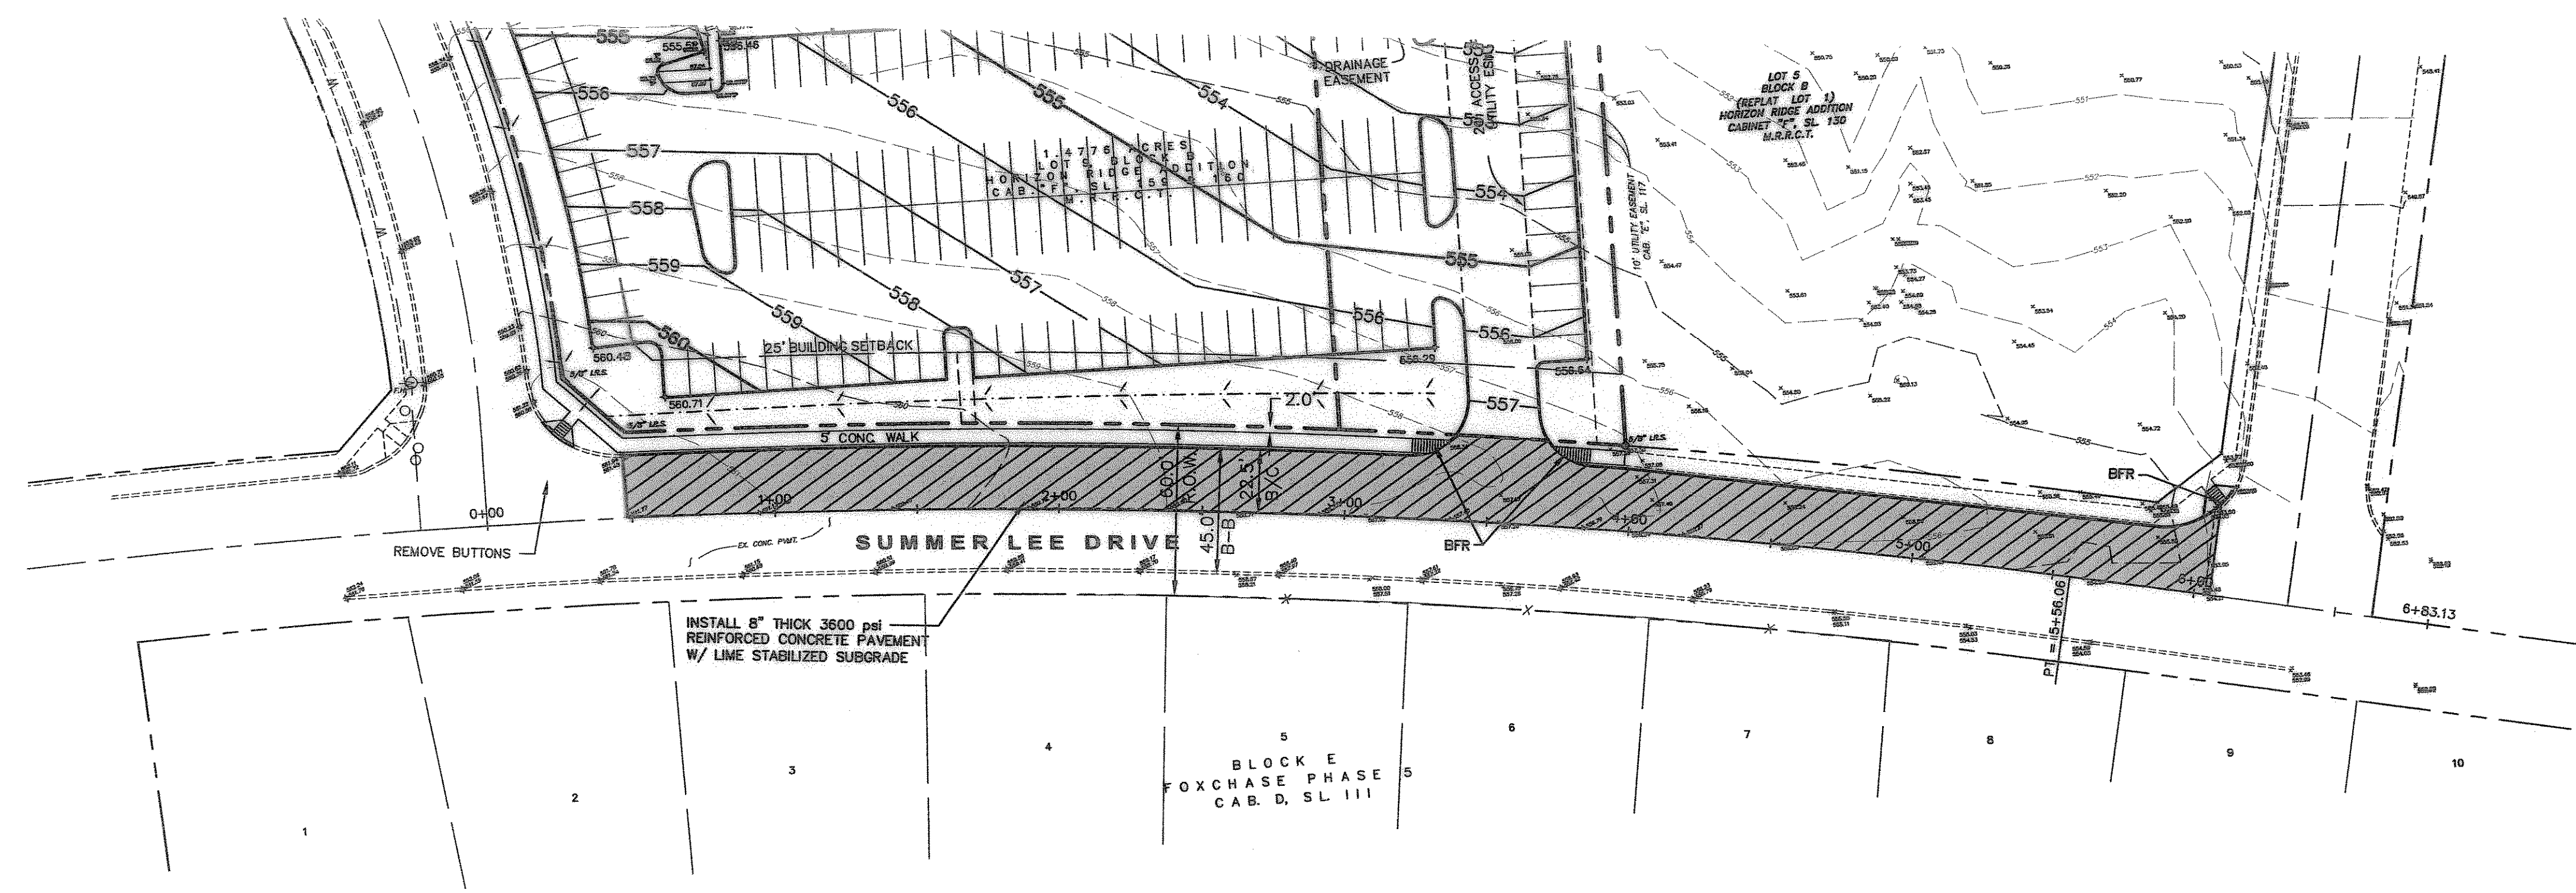
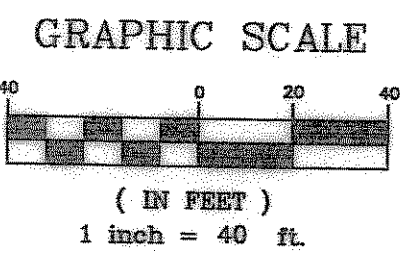


BENCHMARK:  
 BOX CUT IN NW CURB RETURN AT  
 THE INTERSECTION OF WESTWOOD  
 AND ROCKWALL PARKWAY.  
 ELEVATION = 537.56

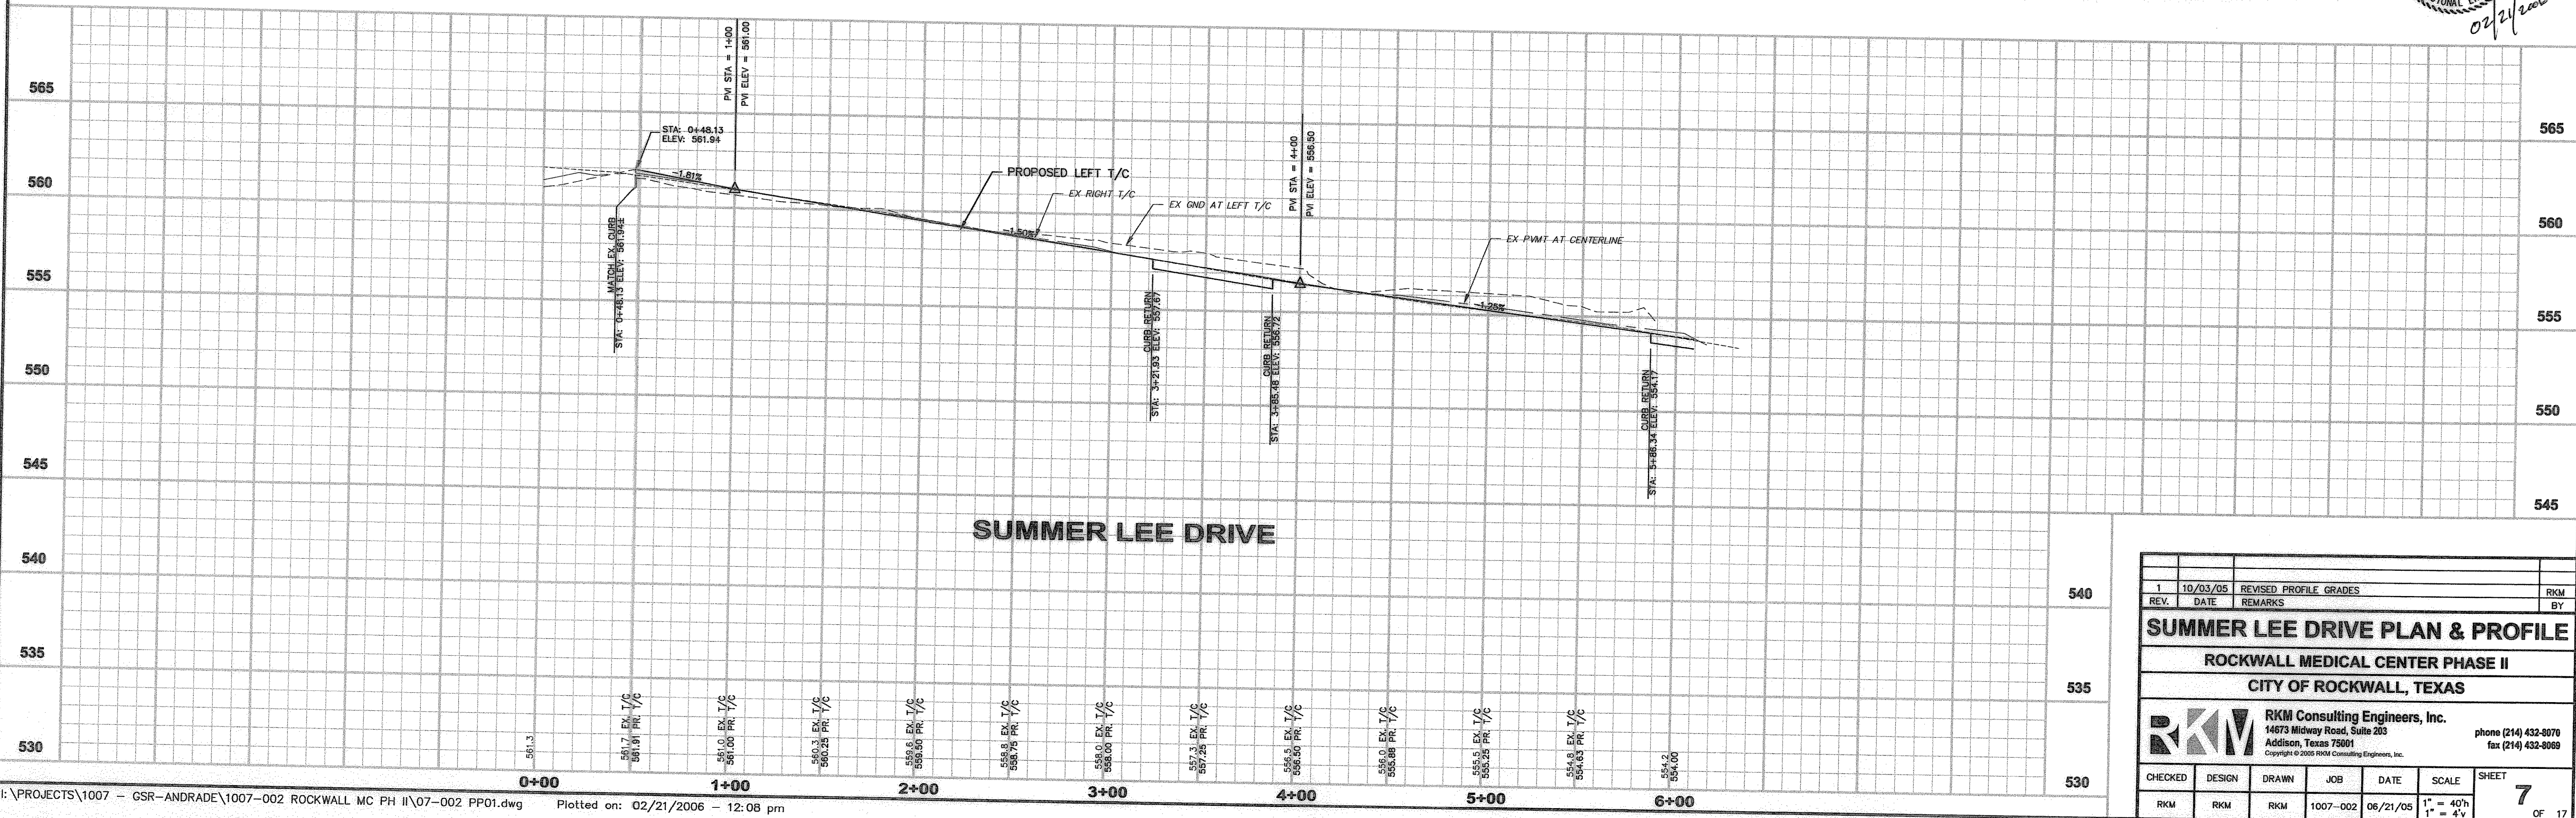

RECORD DRAWING  
 RECORD INFORMATION PROVIDED BY  
 C. F. JORDAN, L.P., DALLAS, TEXAS  
 ELEVATION VERIFICATION PERFORMED BY  
 dMAC SURVEYING & MAPPING, DENTON, TEXAS

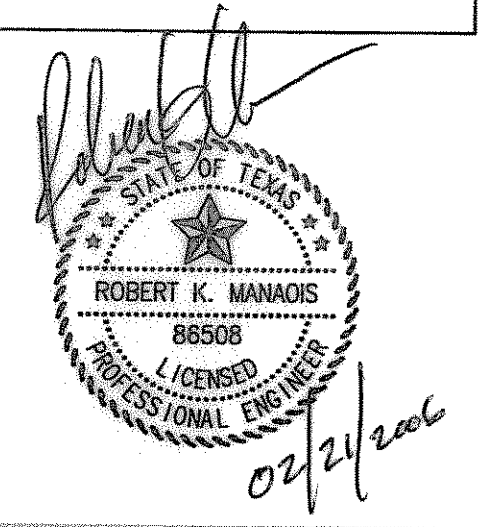

REV.	DATE	REMARKS	BY
1	10/03/05	REVISED PROFILE GRADES	RKM

**SUMMER LEE DRIVE PLAN & PROFILE**  
 ROCKWALL MEDICAL CENTER PHASE II  
 CITY OF ROCKWALL, TEXAS

**RKM Consulting Engineers, Inc.**  
 14673 Midway Road, Suite 203  
 Addison, Texas 75001  
 phone (214) 432-8070  
 fax (214) 432-8069

CHECKED	DESIGN	DRAWN	JOB	DATE	SCALE	SHEET
RKM	RKM	RKM	1007-002	06/21/05	1" = 40' h 1" = 4' v	7 OF 17