






TOCS
1-800-245-4545
tkticket@1-call.com

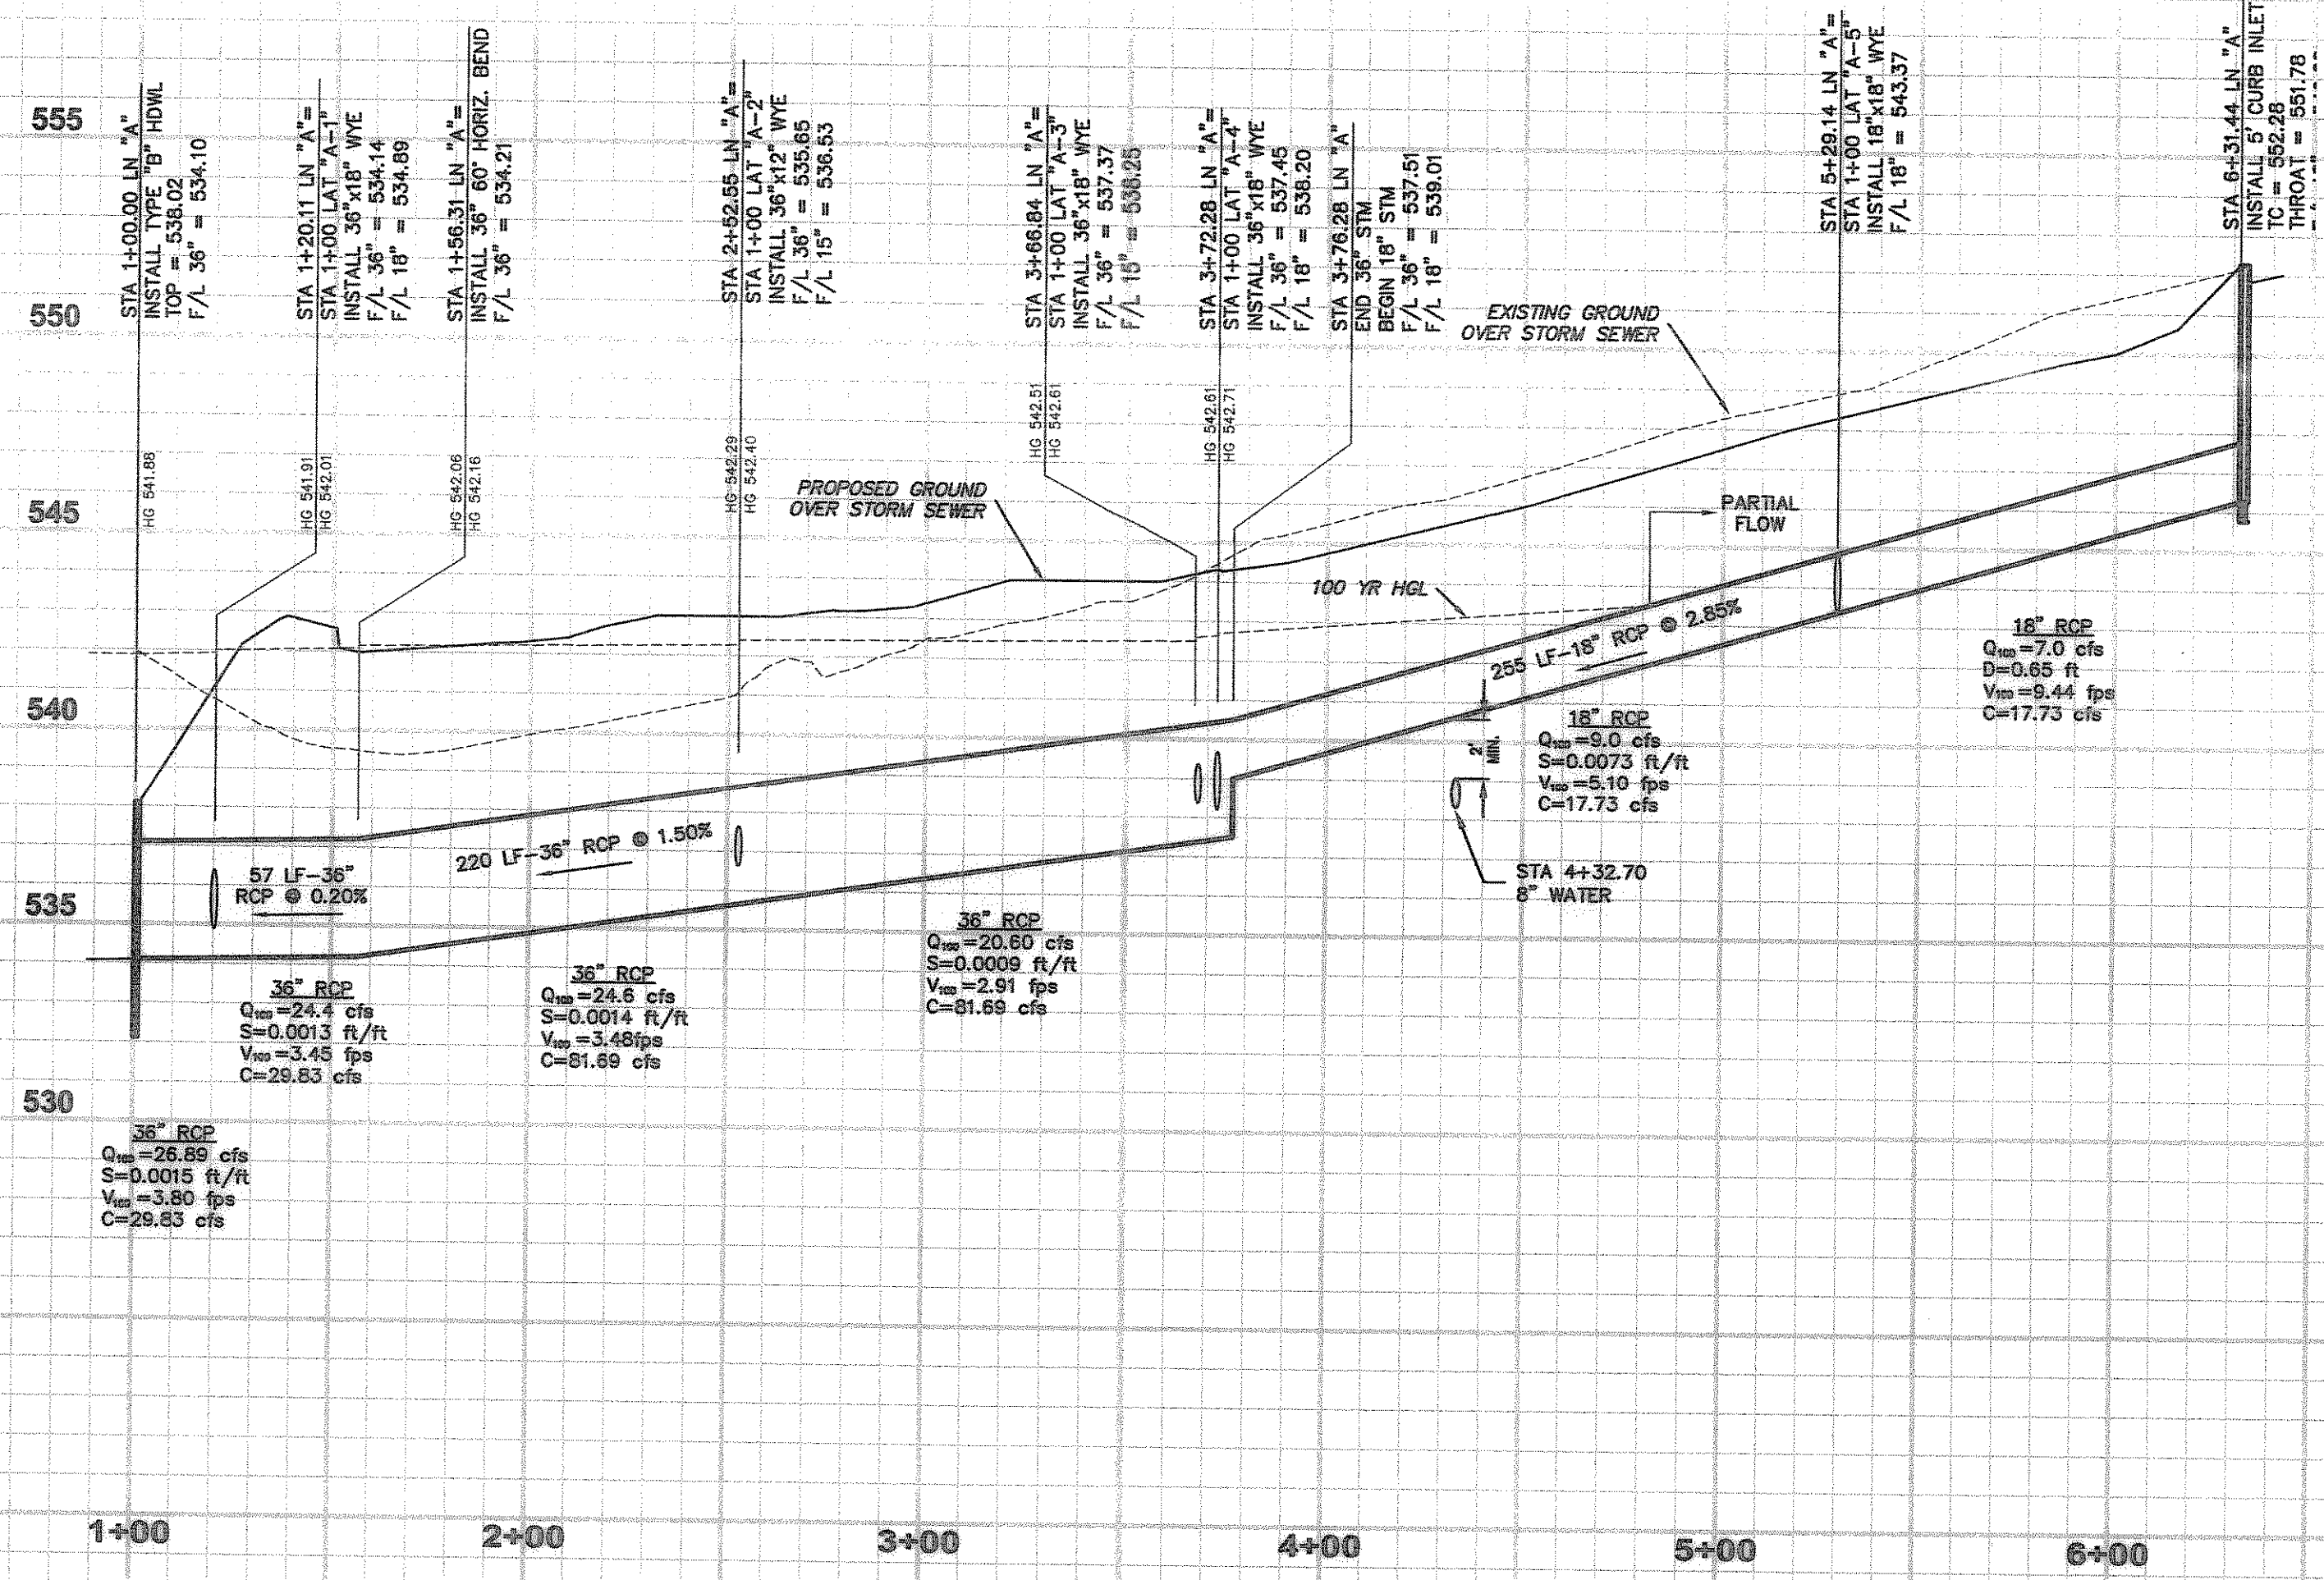

STORM LINE "A"
PUBLIC

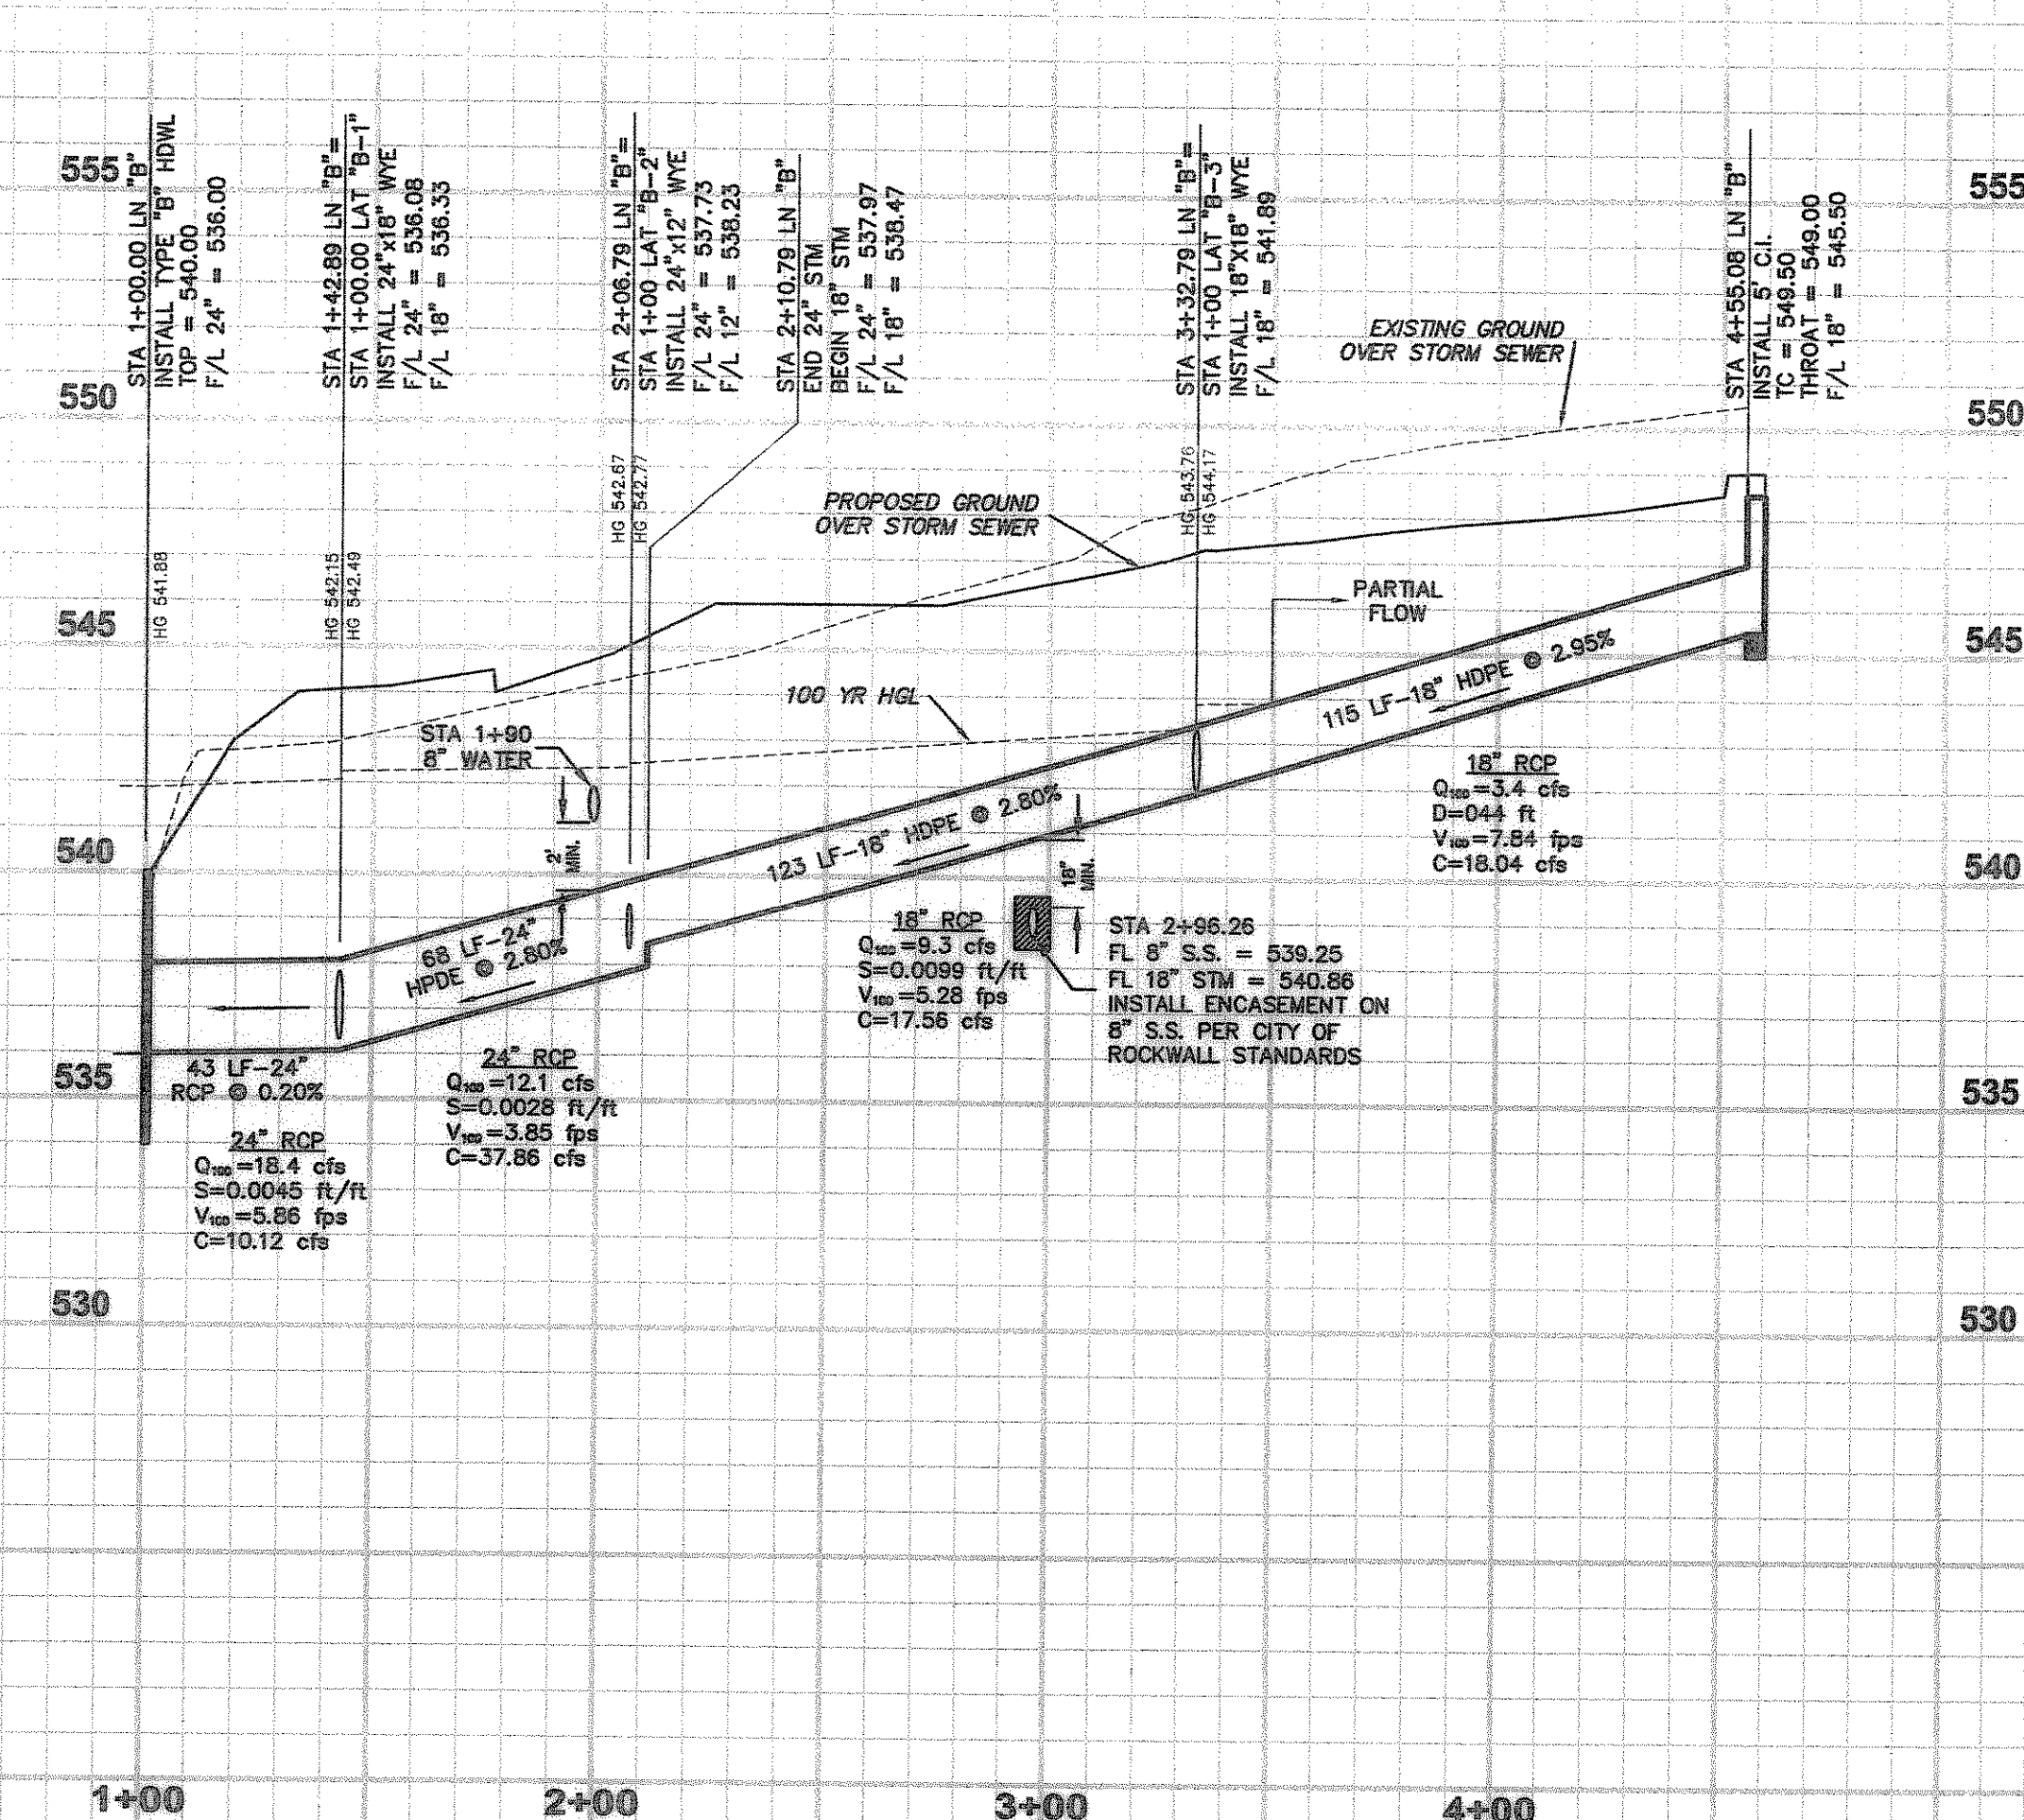

STORM LINE "B"
PRIVATE

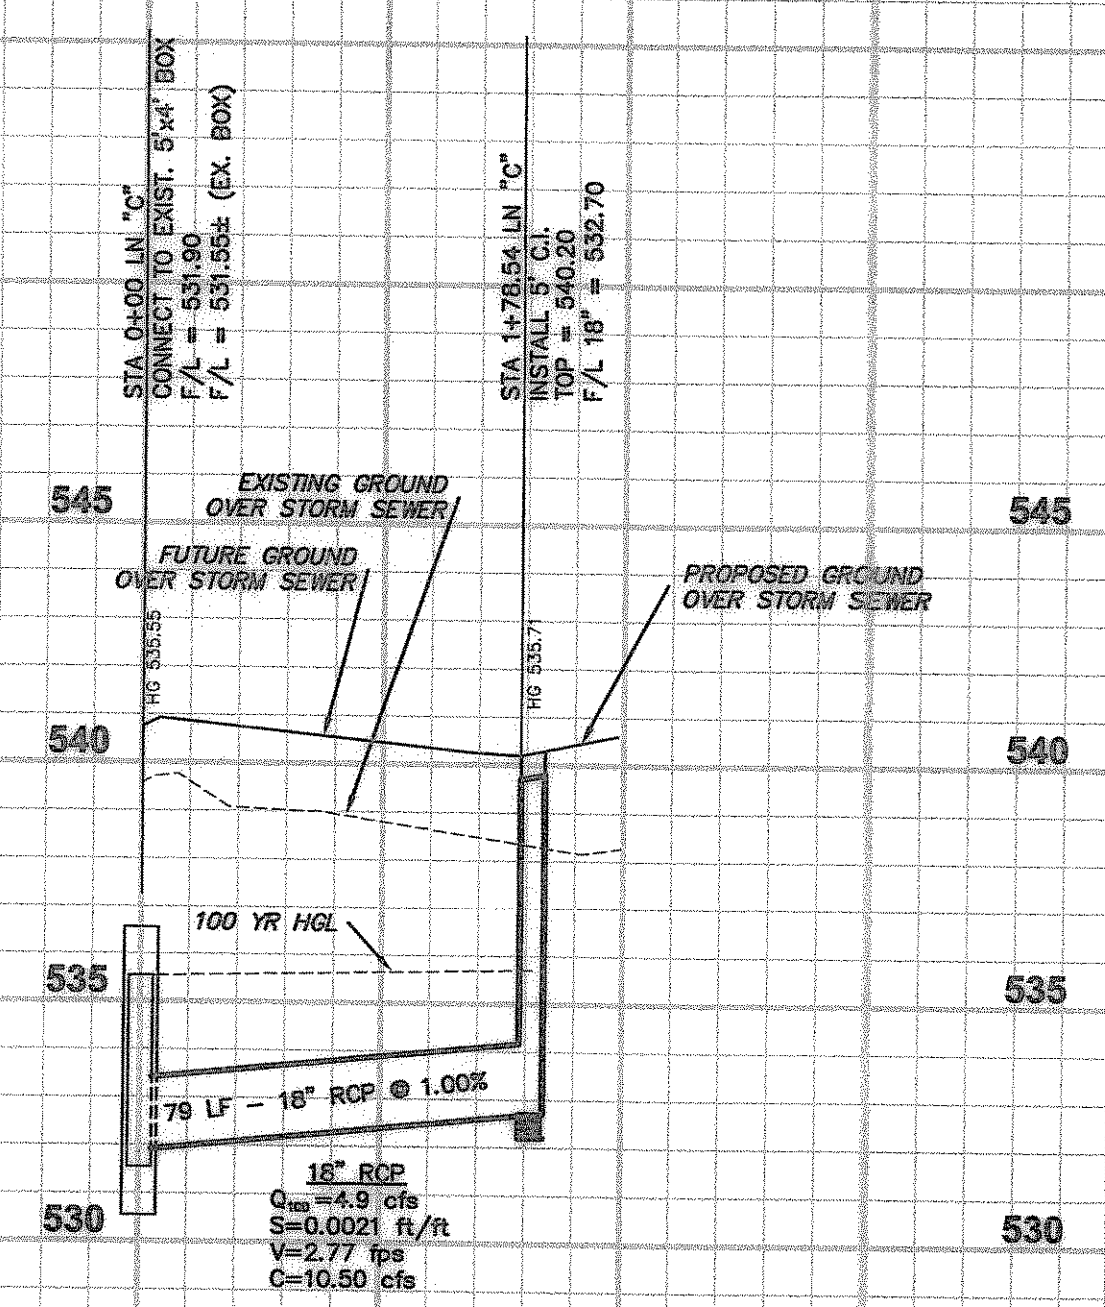

STORM LINE "C"
PUBLIC

RECORD DRAWING
RECORD INFORMATION PROVIDED BY
C. F. JORDAN, L.P., DALLAS, TEXAS
ELEVATION VERIFICATION PERFORMED BY
dMAC SURVEYING & MAPPING, DENTON, TEXAS

[Signature]
ROBERT K. MANOIS
LICENSED PROFESSIONAL ENGINEER
02/21/2006

REV.	DATE	REMARKS	BY
STORM SEWER PROFILES			
ROCKWALL MEDICAL CENTER PHASE II			
CITY OF ROCKWALL, TEXAS			
RKM		RKM Consulting Engineers, Inc. 14673 Midway Road, Suite 203 Addison, Texas 75001 Copyright © 2005 RKM Consulting Engineers, Inc.	phone (214) 432-0070 fax (214) 432-0069
CHECKED	DESIGN	DRAWN	JOB
RKM	RKM	RKM	1007-002
DATE	SCALE	SHEET	
06/21/05	1"=40' H 1"=4' V	14	
OF 17			