


appr. by:
 drawn by:
 date: 09-30-04

revisions
10-14-04
10-29-04
04-12-05
05-02-05
05-19-05
6/15 06-15-05

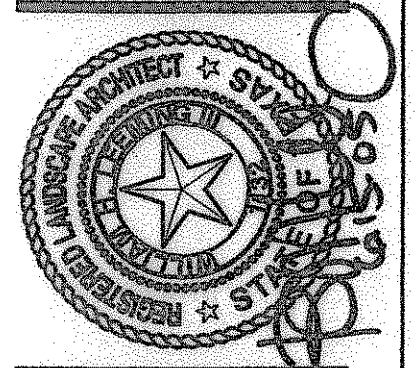



Learning Design Group
 Landscape Architecture
 Fort Worth, Texas 76155
 P.O. Box 155393 972.264.9900
 972.263.0685

SITE LANDSCAPE

ROCKWALL M.O.B.
 RALPH HALL PARKWAY
 ROCKWALL, TEXAS

file name:
 c:\rockwall\03\phase2\04\p2-02-baseP2.dwg

sheet
P-2

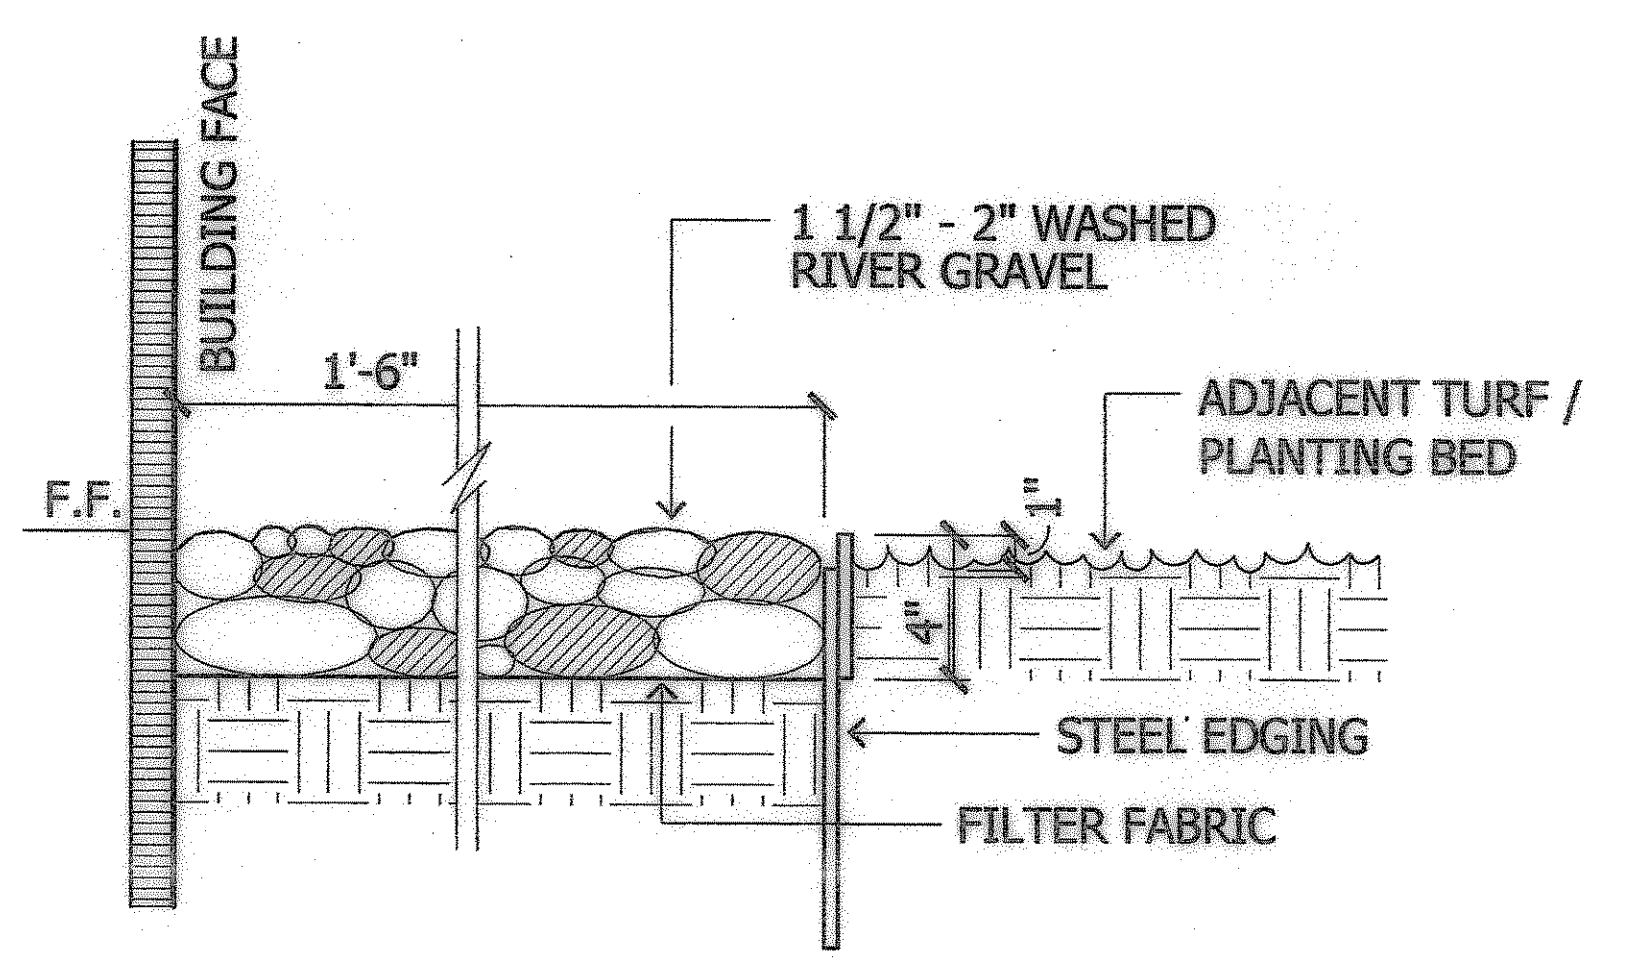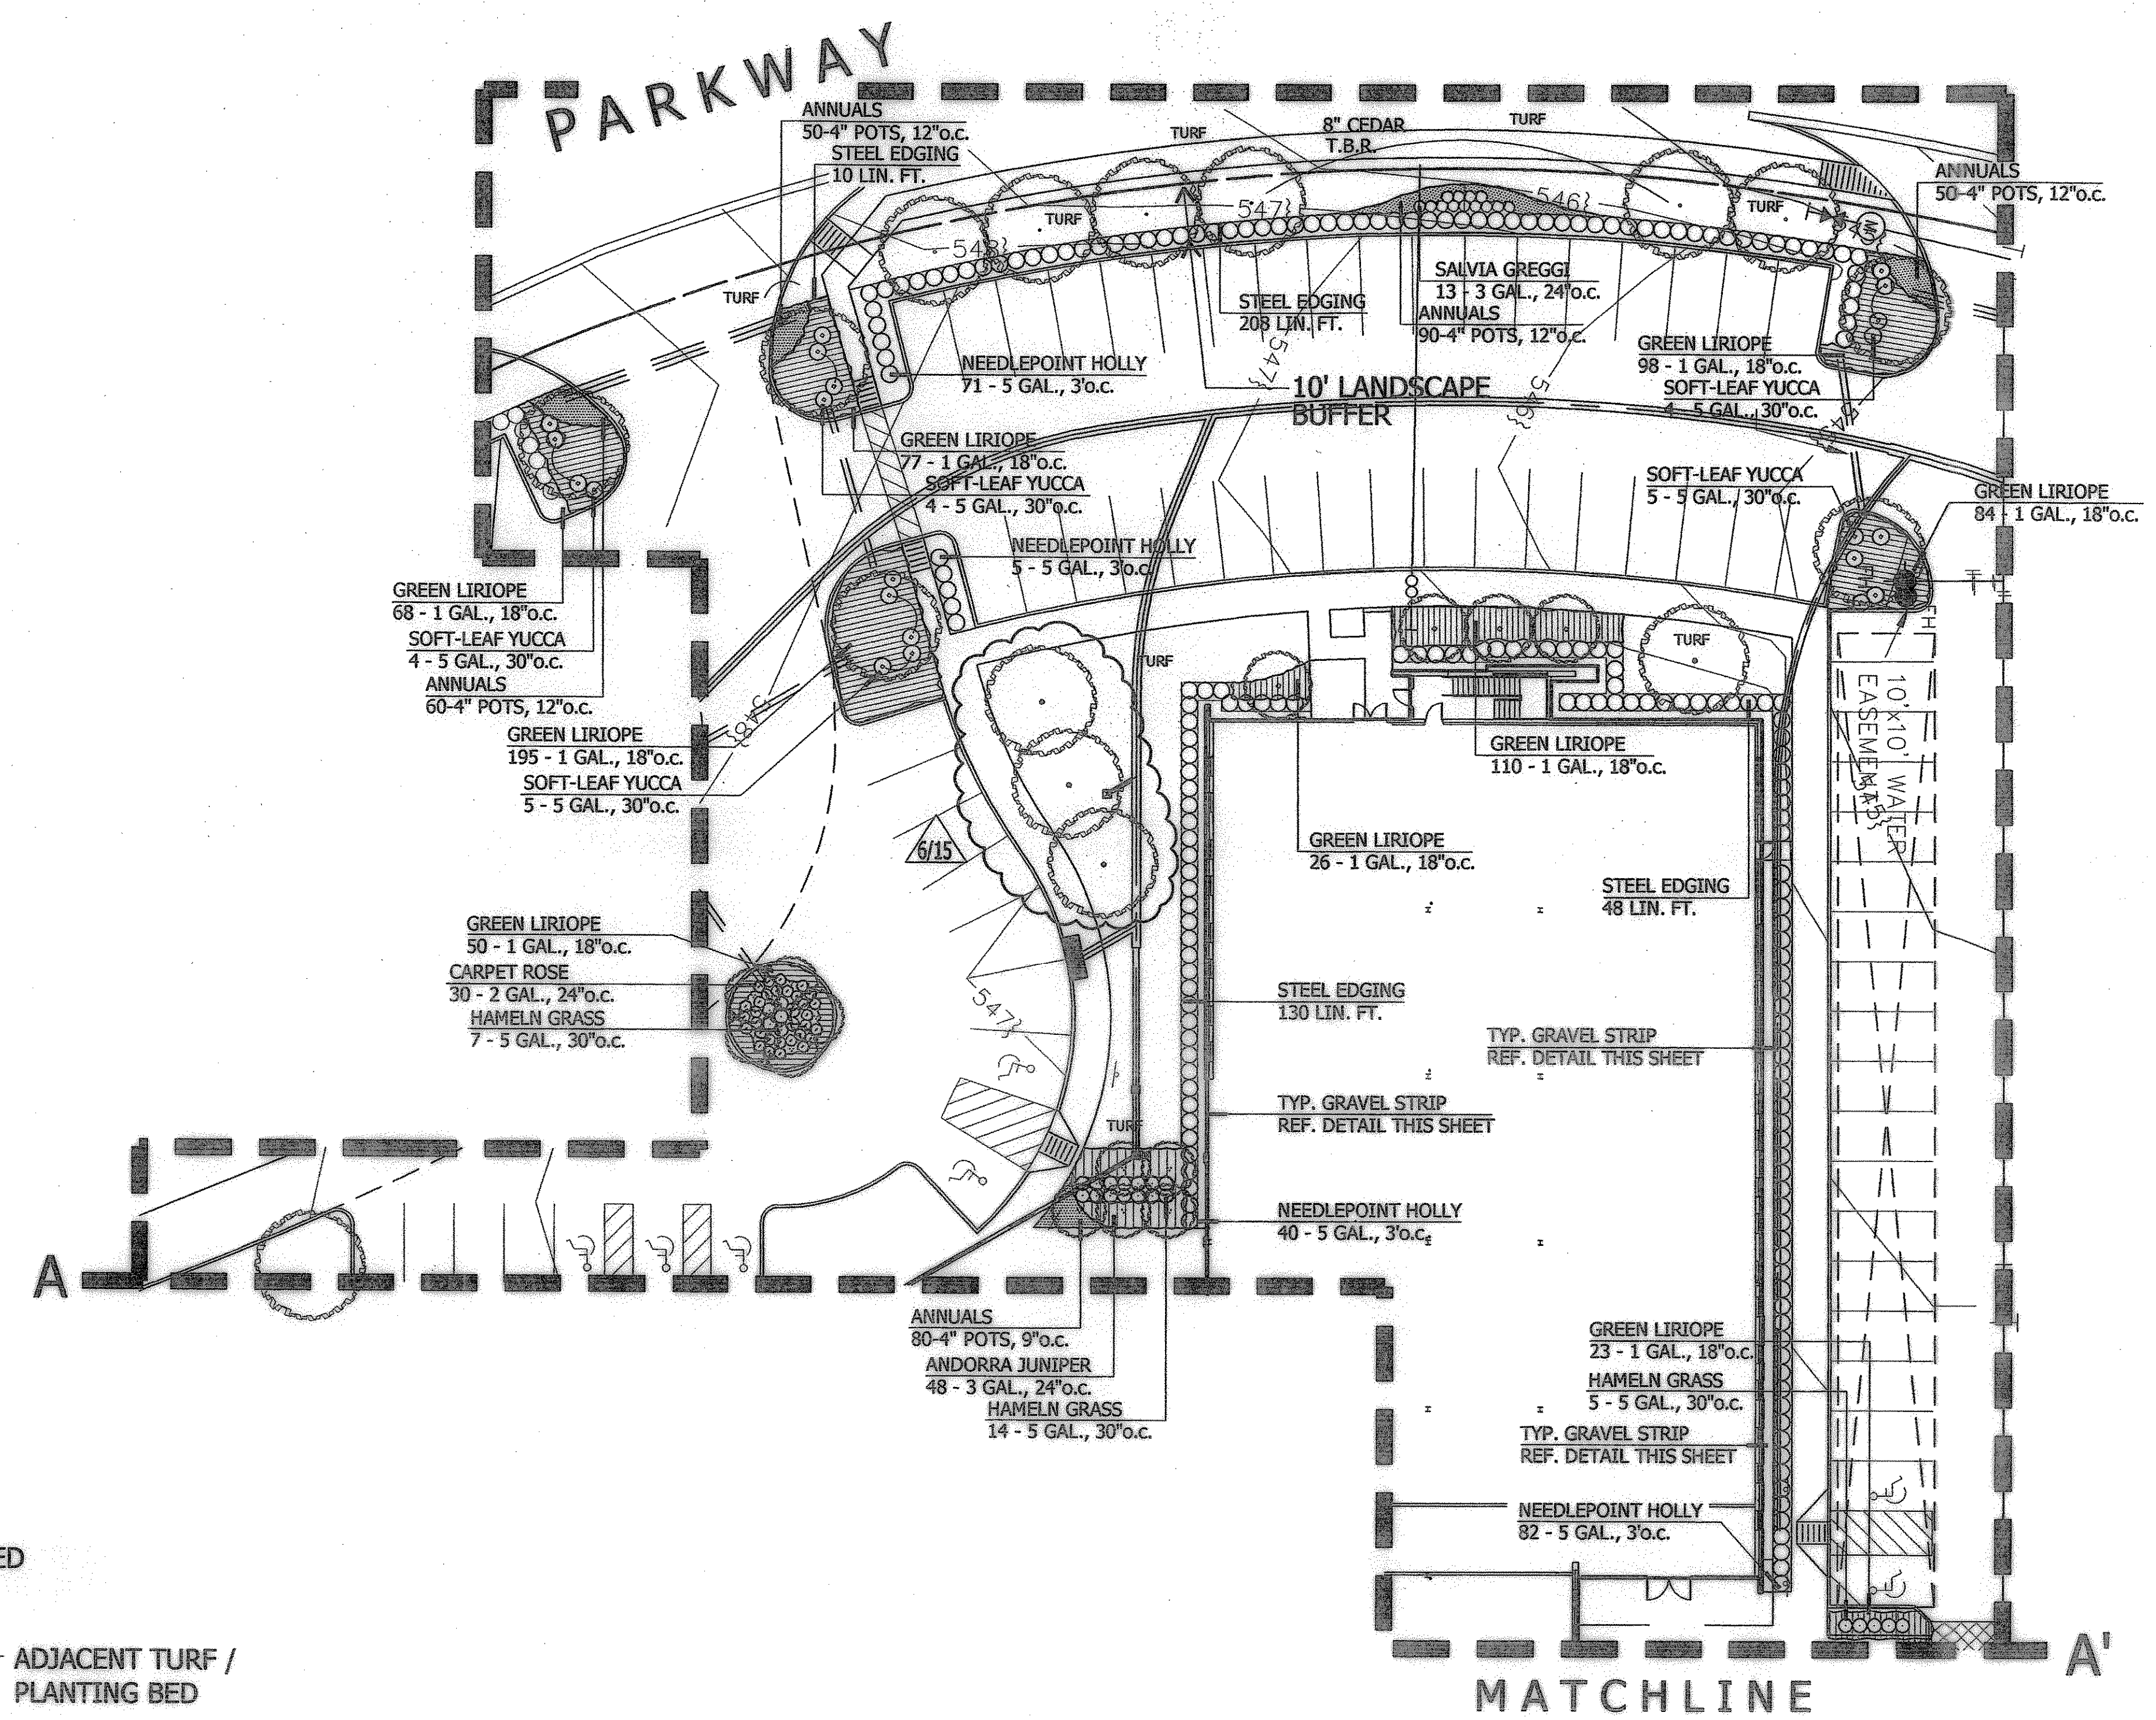

GRAVEL STRIP at BUILDING

SCALE: 1 1/2" = 1'-0"

north
 scale: 1" = 20'-0"