



LEGEND

- RAINBIRD #1804 POP UP SPRAY HEAD WITH 8' MPR NOZZLE UNLESS NOTED OTHERWISE.
- RAINBIRD #1804 POP UP SPRAY HEAD WITH MPR SERIES NOZZLE AS NOTED BELOW.
- RAINBIRD #1812 POP UP SPRAY HEAD WITH MPR SERIES NOZZLE AS NOTED BELOW.
- RAINBIRD #1804 POP UP SPRAY HEAD WITH 4"-SST / 4"-EST MPR SERIES NOZZLE
- HUNTER PGP 4" POP UP ROTARY HEAD, PART CIRCLE, #8 NOZZLE
- ⊕ RAINBIRD PEB SERIES ELECTRIC REMOTE CONTROL VALVE
- ▲ RAINBIRD #3RC QUICK COUPLING VALVE
- +— FEBCO 850 2" D.C.A. INSTALLED PER CITY CODE
- 2" IRRIGATION TAP AND WATER METER
- HUNTER ICC-2800-PED SERIES PEDESTAL MOUNT AUTOMATIC CONTROLLER WITH MINI-CLICK RAIN AND FREEZE SENSORS
- CLASS 200 PVC MAINLINE PIPE
- CLASS 200 (EXCEPT 1/2 INCH #315) PVC LATERAL PIPE
- CLASS 200 SLEEVE PIPES (ONE 4" & ONE 2" UNLESS NOTED OTHERWISE)

L.I.C. SHALL SELECT MPR SERIES SPRAY NOZZLES FOR "HEAD-TO-HEAD" COVERAGE, ADJUSTED FOR MINIMUM OVERSPRAY ONTO WALLS AND WALKS. NO OVERSPRAY INTO STREETS IS PERMITTED.

NOTE - INSTALL ALL LATERAL LINE IN R.O.W. IMMEDIATELY ADJACENT TO STREET-SIDE OF SIDEWALK


NOTE - INSTALL ALL LATERAL LINE IN R.O.W. IMMEDIATELY ADJACENT TO STREET-SIDE OF SIDEWALK

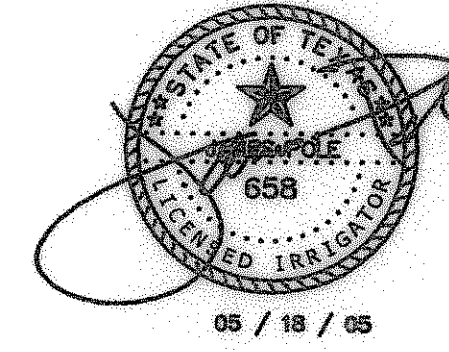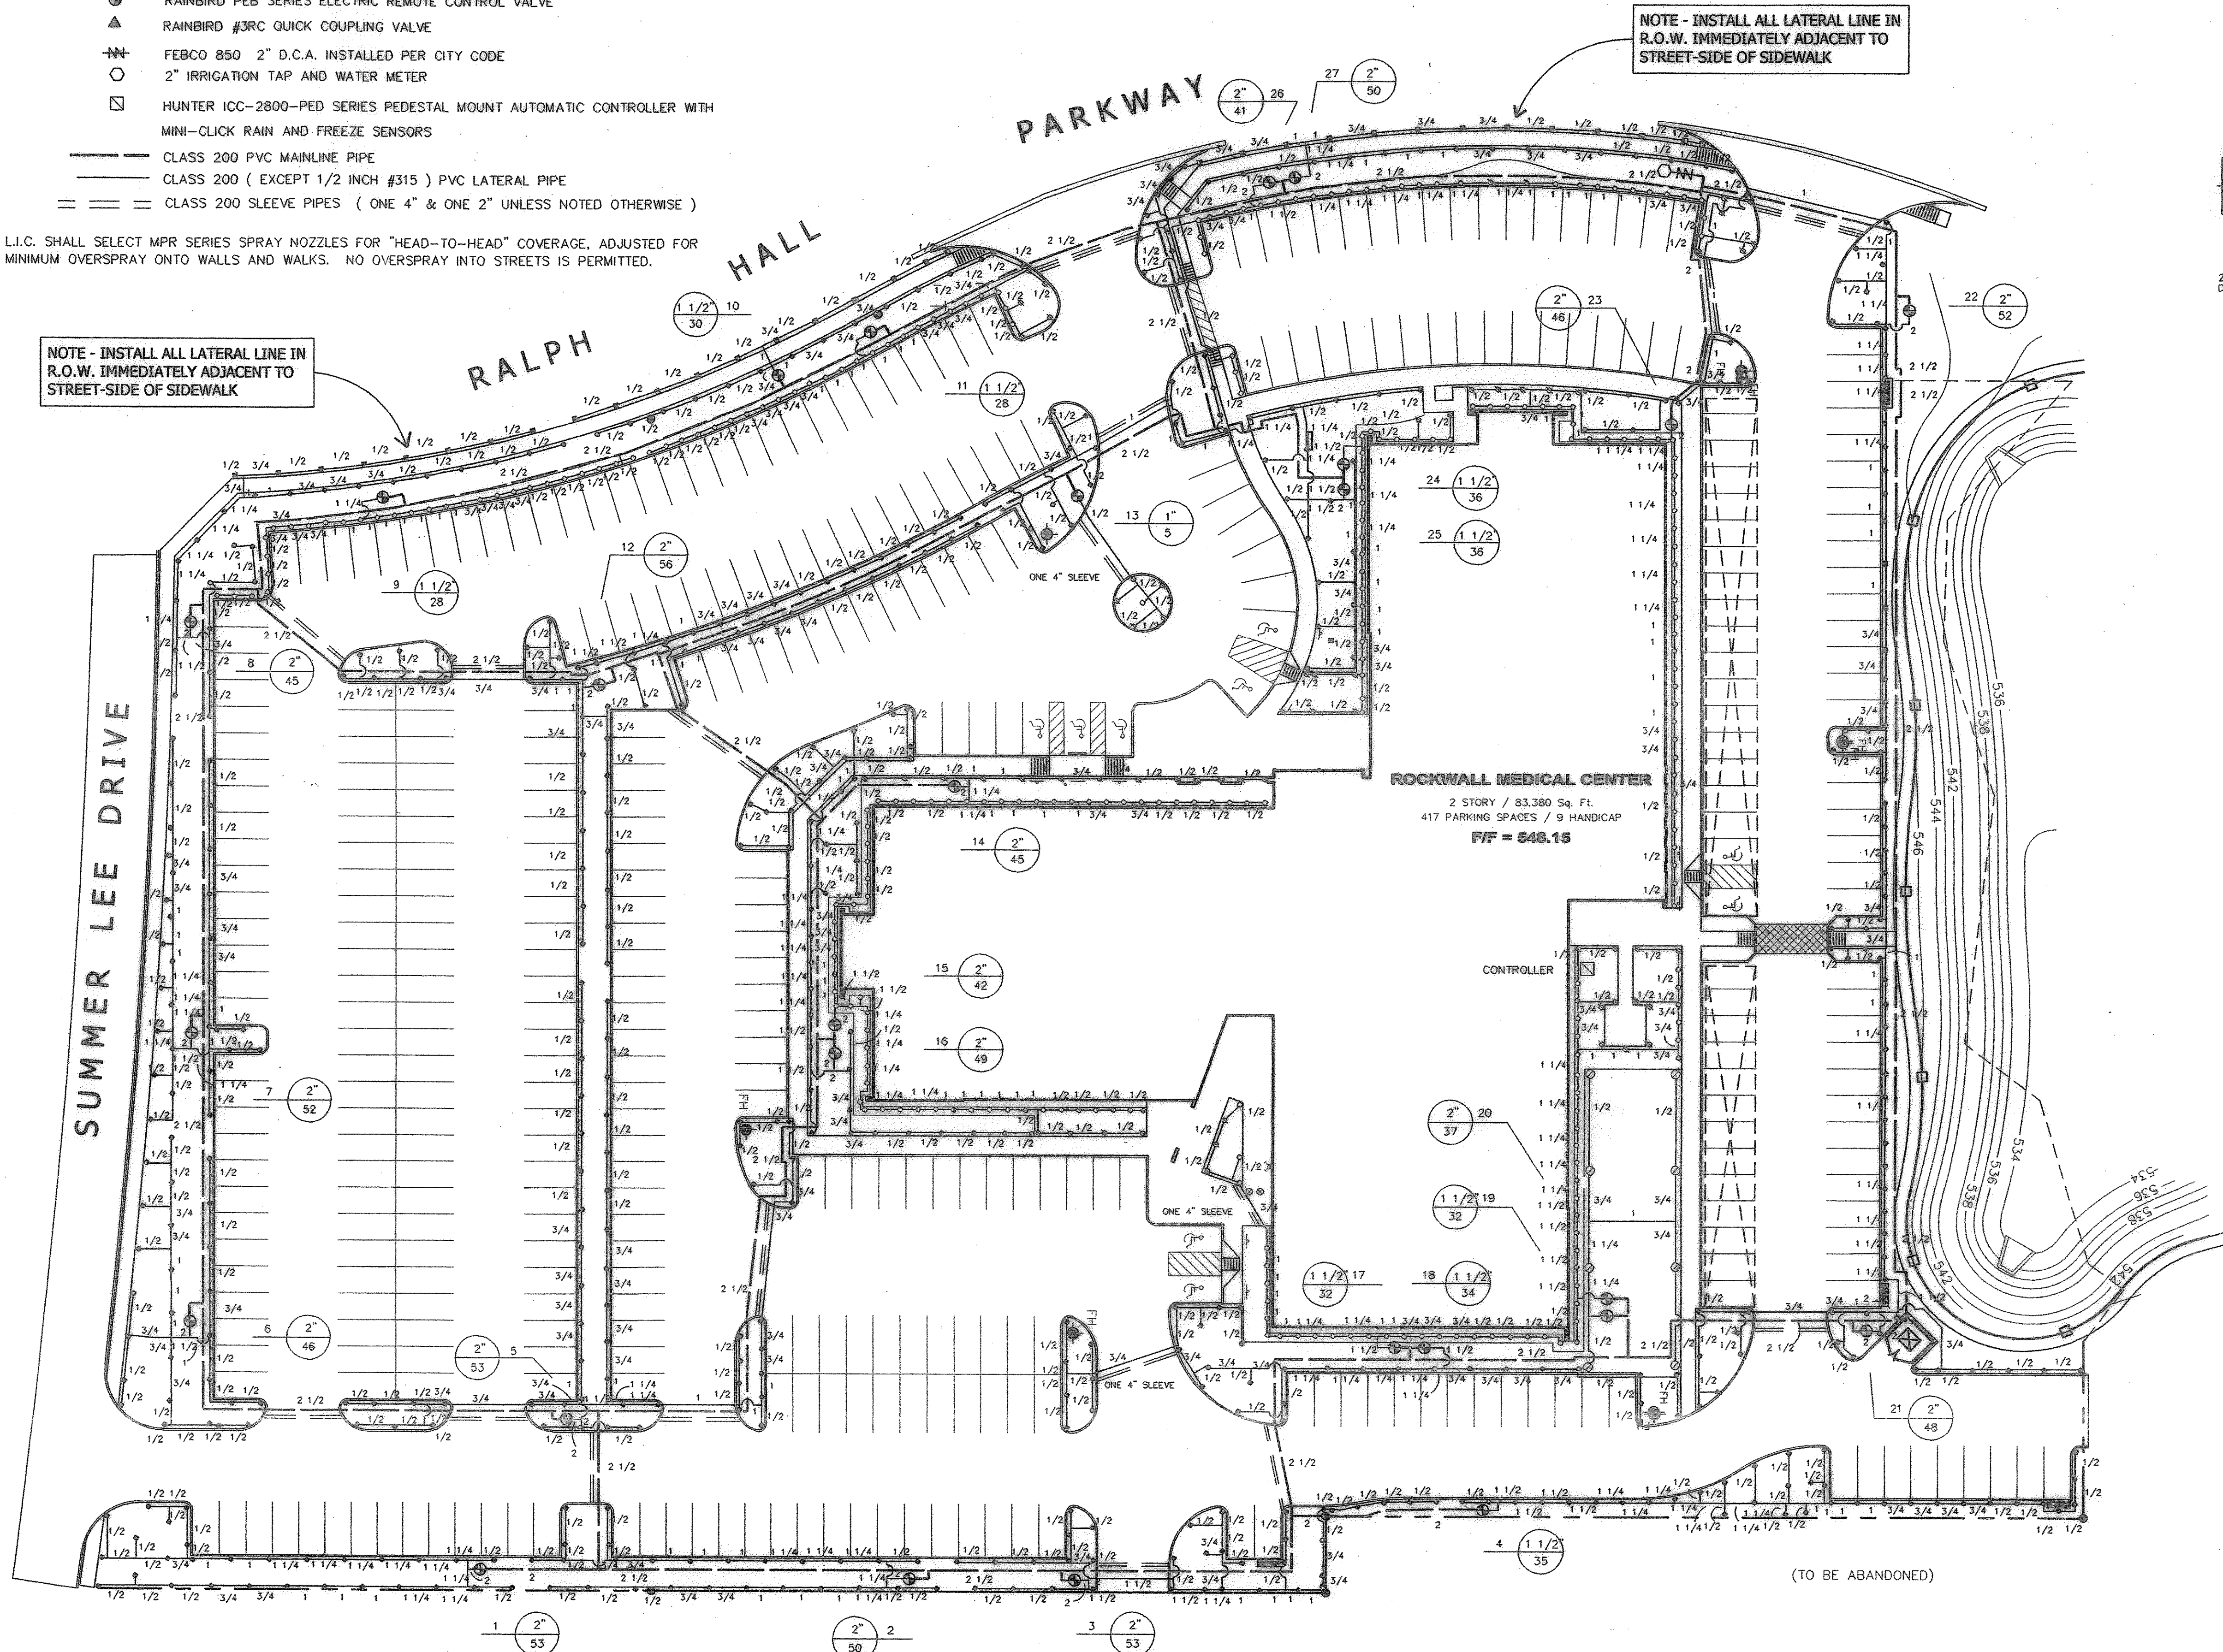

James Pole
 LANDSCAPE IRRIGATION SPECIALIST
 CONSULTING, DESIGN, SPECIFICATIONS
 TEXAS LICENSED IRRIGATOR #658
 2615 WOODHAVEN
 DENTON, TEXAS 76209
 PHONE: 940.243.2364

appr. by:
 drawn by: MJP
 date: 05-19-05

revisions
 06-08-05
 06-15-05

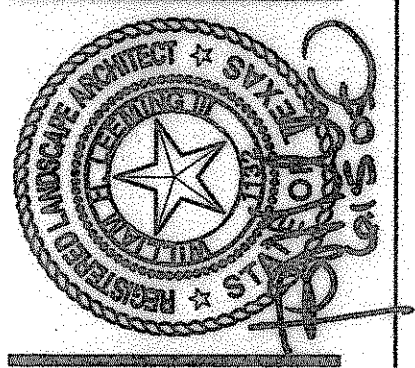

Leeming Design Group
 Landscape Architecture
 Fort Worth, Texas 76105
 P.O. Box 135393
 972.263.0005

SITE IRRIGATION

ROCKWALL M.O.B.
 RALPH HALL PARKWAY
 ROCKWALL, TEXAS

file name:
 c:\rockwall\mobs\plans\p4\p4-IRR.dwg

scale: 1" = 30'-0"

sheet
 P-4