


# CONSTRUCTION PLANS FOR ROCKWALL MEDICAL OFFICE BUILDING IN CITY OF ROCKWALL, TEXAS


**OWNER/APPLICANT**  
TRIO PARTNERS, LLC  
2611 NORTH BELTLINE ROAD, STE 105  
SUNNYVALE, TEXAS 75182  
PHONE: (972) 226-4704  
FAX: (972) 226-6133  
CONTACT: PRESTON TEEL  
EMAIL: PBTEEL@MSN.COM

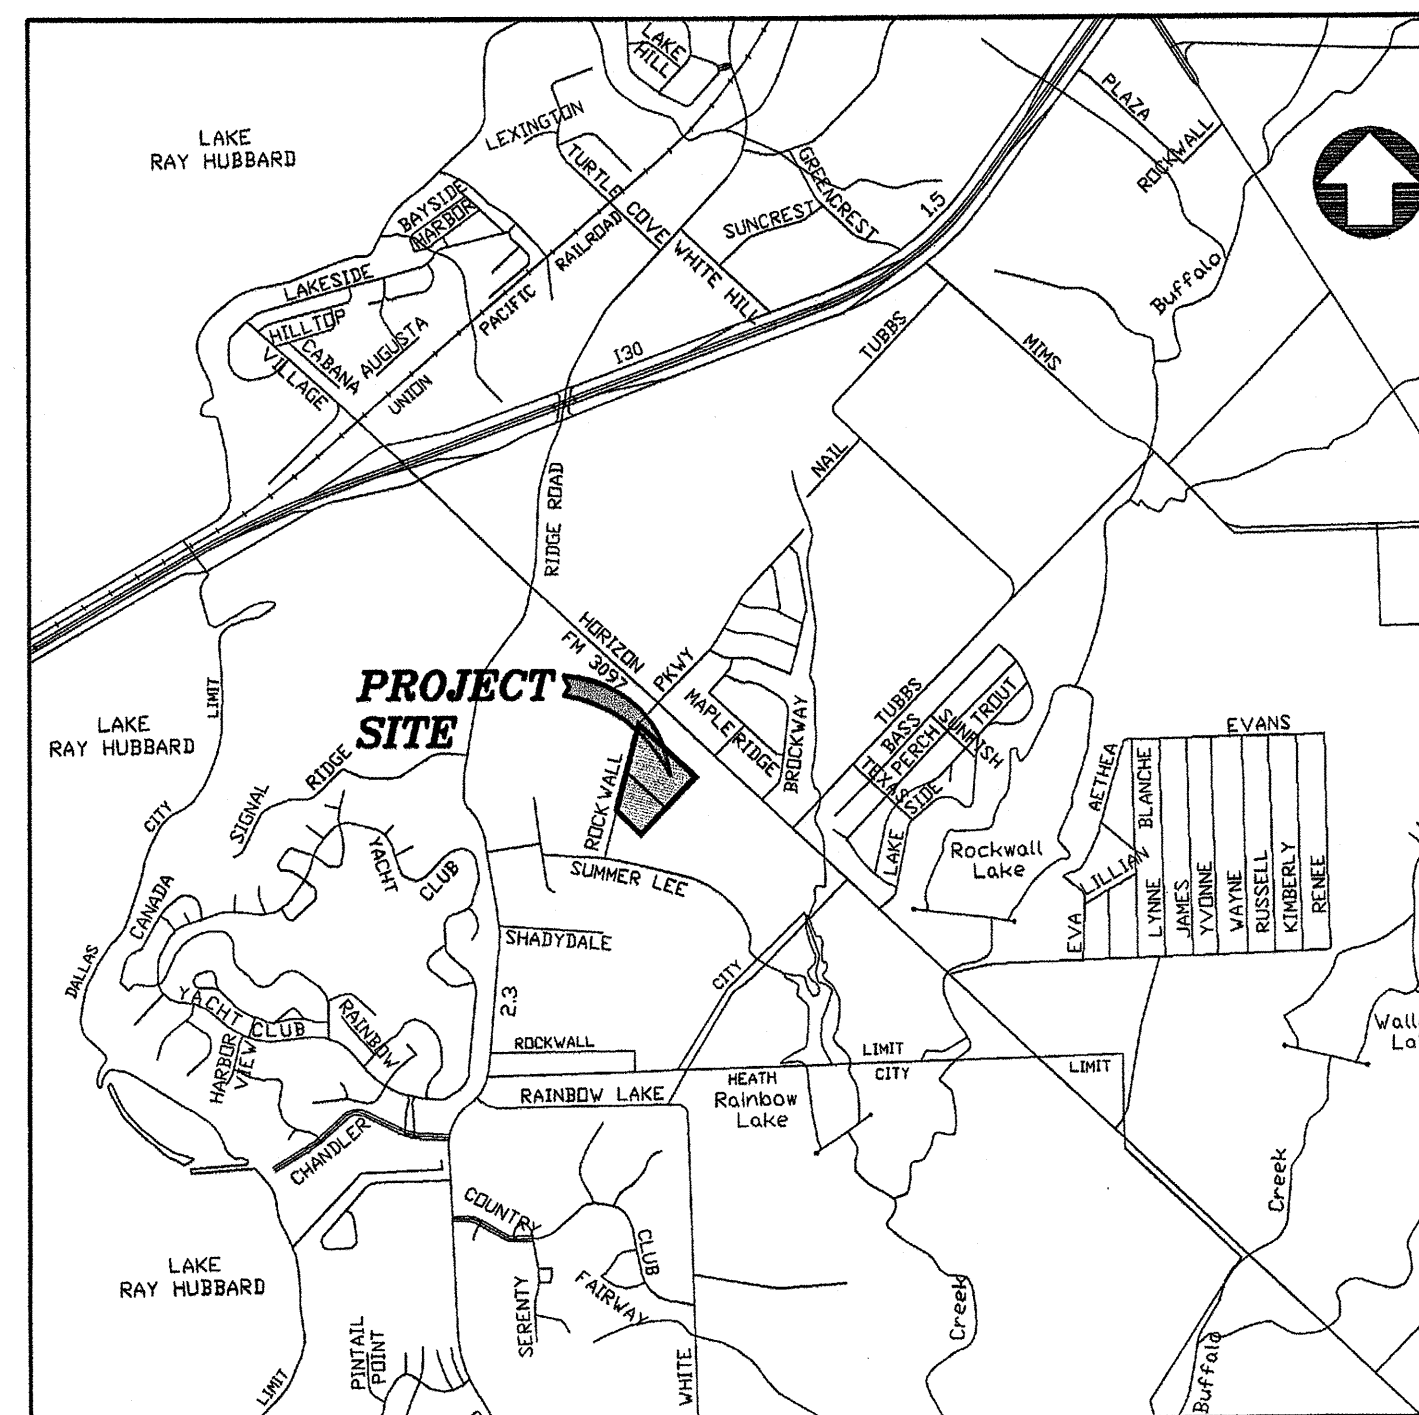


**VICINITY MAP**  
NTS

## SHEET INDEX

| No.    | TITLE                                     |
|--------|---|
| C1.1   | COVER SHEET                               |
| C1.2   | GENERAL NOTES                             |
| C1.3   | FINAL PLAT                                |
| C1.4   | FINAL PLAT                                |
| C2.1   | DIMENSION CONTROL PLAN                    |
| C2.2   | ON-SITE DETAILS                           |
| C3.1   | DRAINAGE AREA MAP AND CALCULATIONS        |
| C3.2   | STORM DRAIN PLAN AND PROFILE<br>LINE SD-A |
| C3.3   | STORM DRAIN PLAN AND PROFILE<br>LINE SD-B |
| C3.4   | STORM DRAIN DETAILS                       |
| C4.1   | GRADING PLAN                              |
| C5.1   | UTILITY PLAN                              |
| C6.1   | EROSION CONTROL PLAN                      |
| C6.2   | EROSION CONTROL DETAILS                   |
| LP1.01 | LANDSCAPE PLAN                            |
| IR1.01 | IRRIGATION PLAN                           |
| IR1.02 | IRRIGATION PLAN                           |

 **PATE ENGINEERS**  
8150 BROOKRIVER DR.  
SUITE S-700  
DALLAS, TEXAS, 75247  
PH. (214) 357-2981  
FAX (214) 357-2985  
CONTACT: BRIAN J. DENCH, P.E.

**RECORD DRAWING**  
THIS DRAWING REFLECTS REVISIONS  
AS FIELD VERIFIED BY ENGINEER AND  
CONTRACTOR  
*Rusty Prentice* DATE: 6/17/08

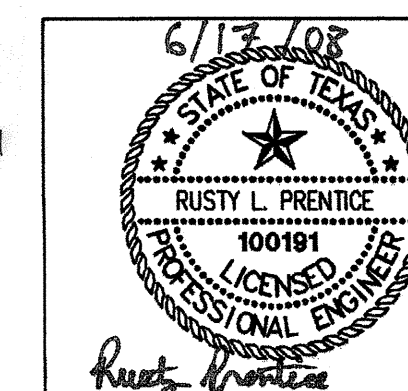

THE SEAL APPEARING ON THIS DOCUMENT  
WAS AUTHORIZED BY  
RUSTY L. PRENTICE, P.E. 100191 ON 06/17/08.  
ALTERATION OF A SEALED DOCUMENT WITHOUT  
PROPER NOTIFICATION TO THE RESPONSIBLE  
ENGINEER IS AN OFFENSE UNDER THE  
TEXAS ENGINEERING PRACTICE ACT.

| REVISION NUMBER | DATE | DESCRIPTION |
|-----------------|------|-------------|
|                 |      |             |
|                 |      |             |
|                 |      |             |

DATED: JUNE 17, 2008  
PEI JOB NO: 182800100