


AS BUILT

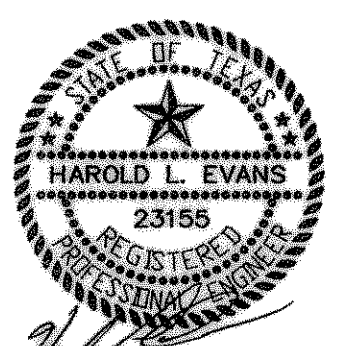

9/19

REVISION DESCRIPTION <small>3886CRD3</small>		DATE 9/17/99	SCALE 1" = 30'	DESIGN H.L.E.	DRAWN	HAROLD L. EVANS CONSULTING ENGINEER P.O. BOX 28365 2931 GUS THOMASSON ROAD, SUITE 102 DALLAS, TEXAS 75228, (214) 328-8133	OFF-SITE FIRE LANE GRADING ROCKWALL MINI-WAREHOUSE NO. 2	SHEET NO. 4 5
							CITY OF ROCKWALL	JOB NO. 9668