

INSTALL:
1-8" X8" TAPPING
SLEEVE
1-8" VALVE
1-8" 11-1/4" BEND


INSTALL:
1-FH COMPLETE
W/TEE, VALVE,
PIPING, AND BLOCKING

INSTALL:
1-FH COMPLETE
W/TEE, VALVE,
PIPING, AND BLOCKING

INSTALL:
1-8" X8" TEE
2-8" VALVES
1-8" BLIND FLANGE
1-FH COMPLETE
W/TEE, VALVE,
PIPING, AND BLOCKING

INSTALL:
1-FH COMPLETE
W/TEE, VALVE,
PIPING, AND BLOCKING
4 STEEL BOLLARDS

AS BUILT

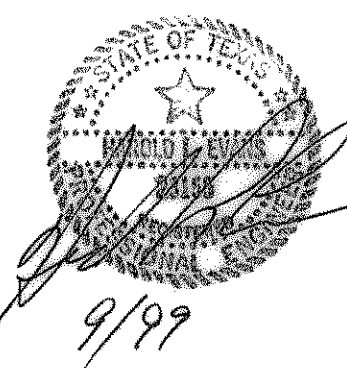

HAROLD L. EVANS CONSULTING ENGINEER P.O. BOX 28355 2331 GUS THOMASSON ROAD, SUITE 102 DALLAS, TEXAS 75228, (214) 328-8133		PROPOSED WATER ROCKWALL MINI-WAREHOUSE NO. 2		SHEET NO. 5
REV.	DATE	SCALE	DESIGN	DRAWN
3668W22	1/4/99	1" = 40'	H.L.E.	CITY OF ROCKWALL
CITY OF ROCKWALL				JOB NO. 9668