


DRAINAGE TABLE

DRAINAGE AREA NO.	ACRES	T.C.	C	I 100 YR.	Q 100 YR.	SUM Q 100 YR.
1	6.69		0.9	9.8	59.01	59.01
2	0.47		"	"	4.15	63.15
3	0.56		"	"	4.94	68.10
4	0.60		"	"	5.29	73.39
5	2.14		"	"	18.88	92.27

AS BUILT

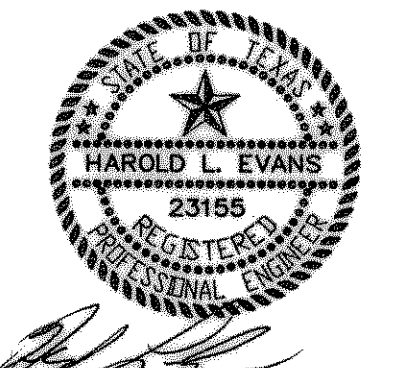

H.L.E.
9/99

	HAROLD L. EVANS CONSULTING ENGINEER P.O. BOX 28355 2331 CUS THOMASSON ROAD, SUITE 102 DALLAS, TEXAS 75228, (214) 328-8133	DRAINAGE AREA MAP ROCKWALL MINI-WAREHOUSE NO. 2	SHEET NO. 3A 5
		CITY OF ROCKWALL	JOB NO. 9668
REVISION DESCRIPTION <small>066822N</small>	DATE 9/16/99	SCALE 1" = 50'	DESIGN H.L.E.