

CITY OF ROCKWALL, TEXAS

PAVING, DRAINAGE & UTILITY IMPROVEMENTS PLANS

FOR

ROCKWALL PARKWAY & SUMMER LEE DRIVE

ROCKWALL, TEXAS

PROJECT DRAWINGS

G-1 COVER SHEET
G-2 GENERAL NOTES AND QUANTITATIVE SUMMARY
P-1 TYPICAL PAVING SECTIONS
P-2 PAVING PLAN/PROFILE STA 0+00 TO 4+50 (ROCKWALL PKWY)
P-3 PAVING PLAN/PROFILE STA 4+50 TO 9+00 (ROCKWALL PKWY)
P-4 PAVING PLAN/PROFILE STA 9+00 TO 12+35 (ROCKWALL PKWY)
P-5 PAVING PLAN/PROFILE STA 0+00 TO 3+00 (SUMMER LEE DRIVE)
D-1 DRAINAGE AREA MAP
D-2 DRAIN PLAN/PROFILE STA 0+00 TO 4+00 (LINE "A")
D-3 DRAIN PLAN/PROFILE STA 0+00 TO 4+00 (LINE "C")
D-4 EROSION CONTROL DETAILS
SET STANDARD DETAIL CITY OF ROCKWALL (NOT INCLUDED)

CITY COUNCIL

SCOTT SELF, MAYOR

BILL CECIL

RON COLESON

SAM BUFFINGTON

JOHN KING

TERRY RAULSTON

BILLY MORRIS

CITY MANAGER

JULIE COUCH


CITY ENGINEER/DIRECTOR OF PUBLIC WORKS

CHUCK TODD, P.E.

ASA
ENGINEERING

17400 DALLAS PARKWAY, SUITE 110
DALLAS, TEXAS 75287
(972)248-9651 FAX (972)248-9681

DEVELOPER
SCHULER PROPERTY
1500 E. INDUSTRIAL BLVD.
MCKINNEY, TX 75069
(972)562-5555 FAX (972)548-2313

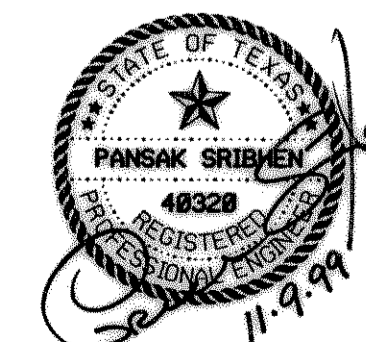

SHEET

G-1

NOV 9, 1999

AS-BUILT