


**TYPICAL PAVING SECTION**  
NTS

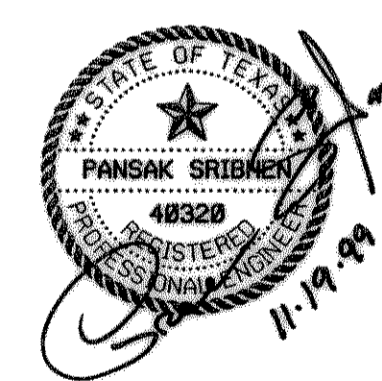

P-1

ROCKWALL PKWY & SUMMER LEE DR.						
TYPICAL PAVING SECTION						
Engineering Department						
City Of Rockwall, Texas						
PSA ENGINEERING-DALLAS, TEXAS						
17400 DALLAS PARKWAY, SUITE 110, DALLAS, TEXAS 75287						
(972) 248-9651 FAX (972) 248-9681						
DESIGN	DRAWN	DATE	SCALE	NOTES	FILE	NO.
PSA ENGR.	MIR ALI	11-9-99	NO SCALE	PSA ENGR.	PSA	9907.HRC

AS-BUILT