


9+00 10+00 11+00 11+92 12+65 13+00

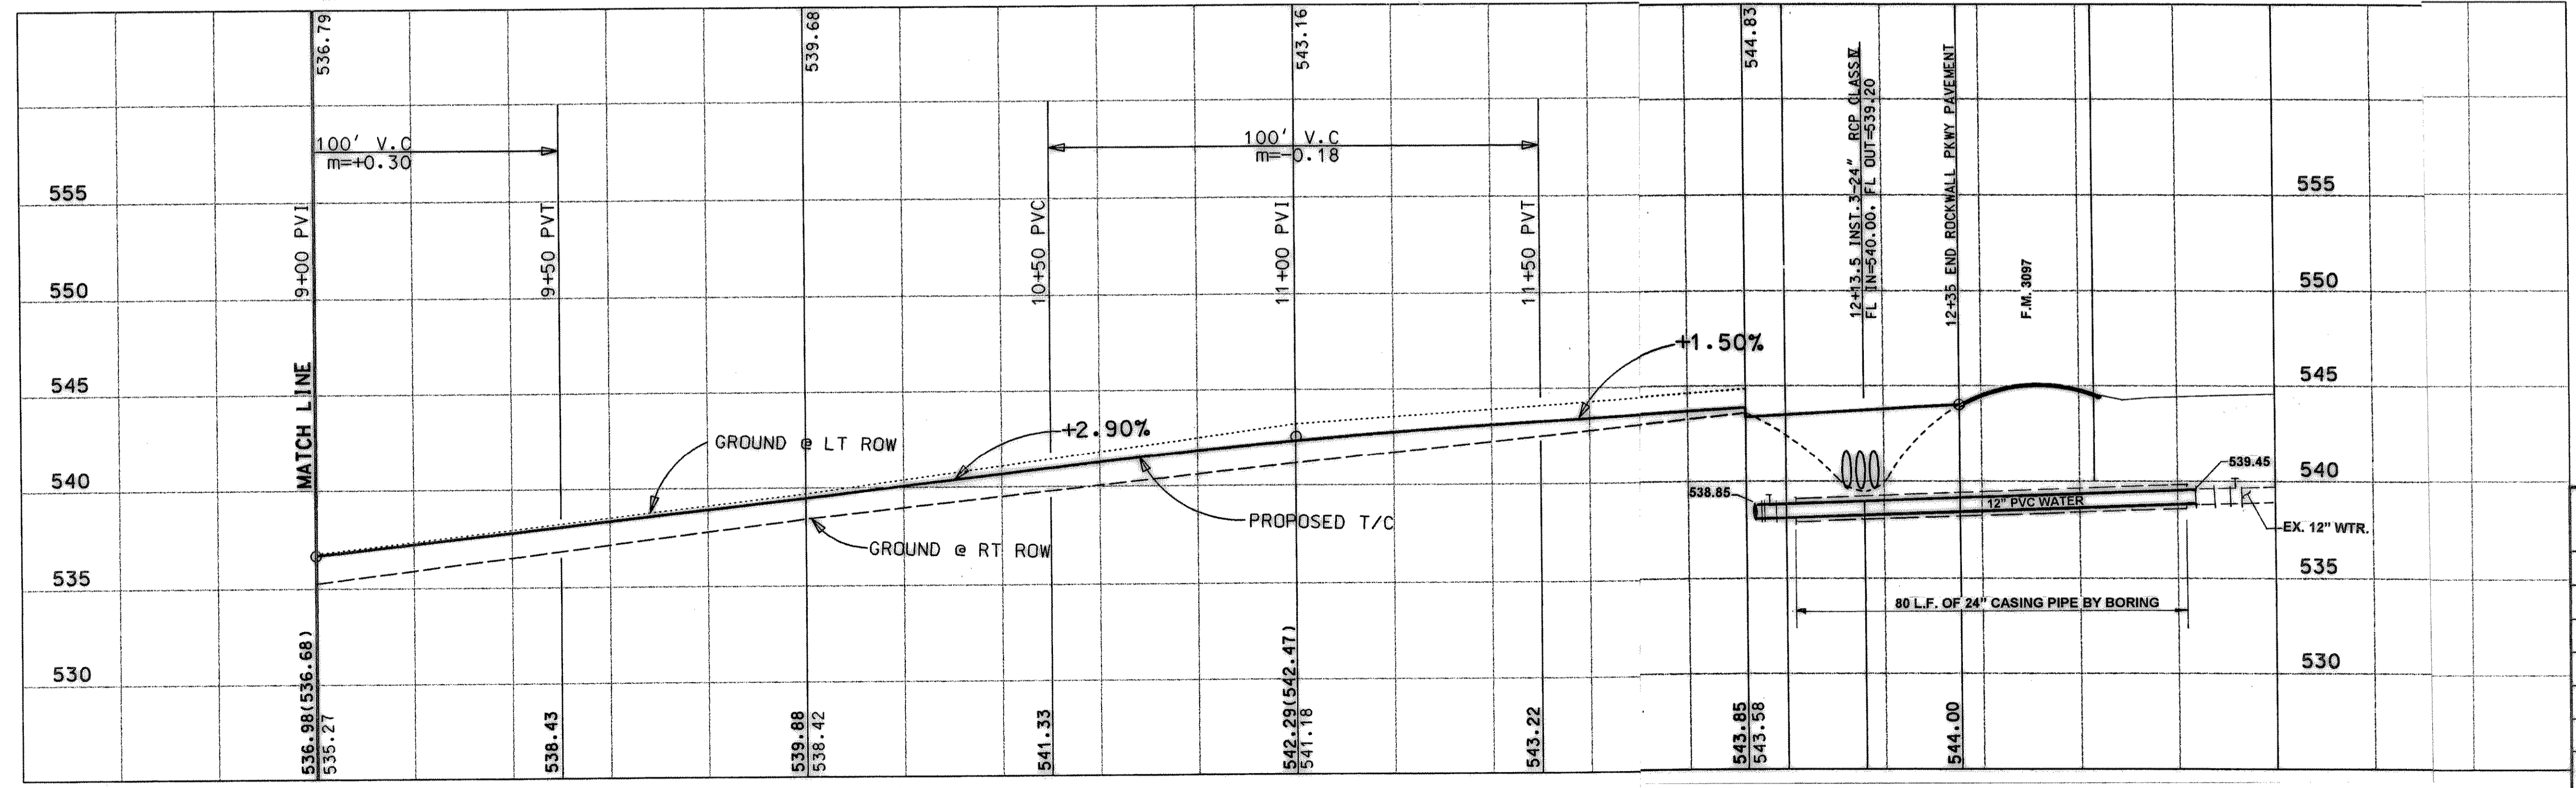

(P-4)

ROCKWALL PKWY. IMPROVEMENTS
PAVING/PROFILE STA 9+00 TO 12+35
Engineering Department
City Of Rockwall, Texas

PSA ENGINEERING-DALLAS, TEXAS
 17488 DALLAS PARKWAY, SUITE 110, DALLAS, TEXAS 75287
 (972) 248-9651 FAX (972) 248-9681

| DESIGN | DRAWN | DATE | SCALE | NOTES | FILE | NO. |
|-----------|---------|---------|---------------------|-----------|------|----------|
| PSA ENGR. | MIR ALI | 11-9-99 | 1"=20' H 1"=5' V | PSA ENGR. | PSA | 9907.HRC |

AS-BUILT