


SUMMER LEE DRIVE IMPROVEMENTS
PAVING PROFILE STA 0+00 TO 3+00
Engineering Department
City Of Rockwall, Texas
PSA ENGINEERING-DALLAS, TEXAS
17400 DALLAS PARKWAY, SUITE 110, DALLAS, TEXAS 75287
(972) 248-9651 FAX (972) 248-9681

DESIGN	DRAWN	DATE	SCALE	NOTES	FILE	NO.
PSA ENGR.	MIR ALI	11-9-99	1"=20' H 1"=5' V	PSA ENGR.	PSA	9907.HRC

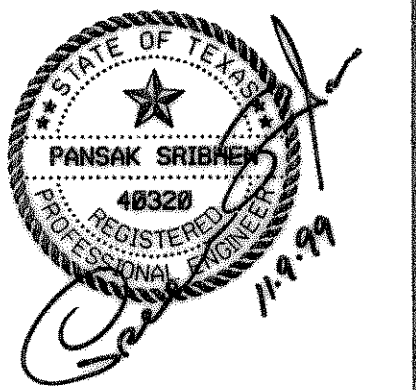

P-5

AS-BUILT