


CONSTRUCTION PLANS FOR  
**ROCKWALL PLACE APARTMENTS**  
 ROCKWALL, TEXAS

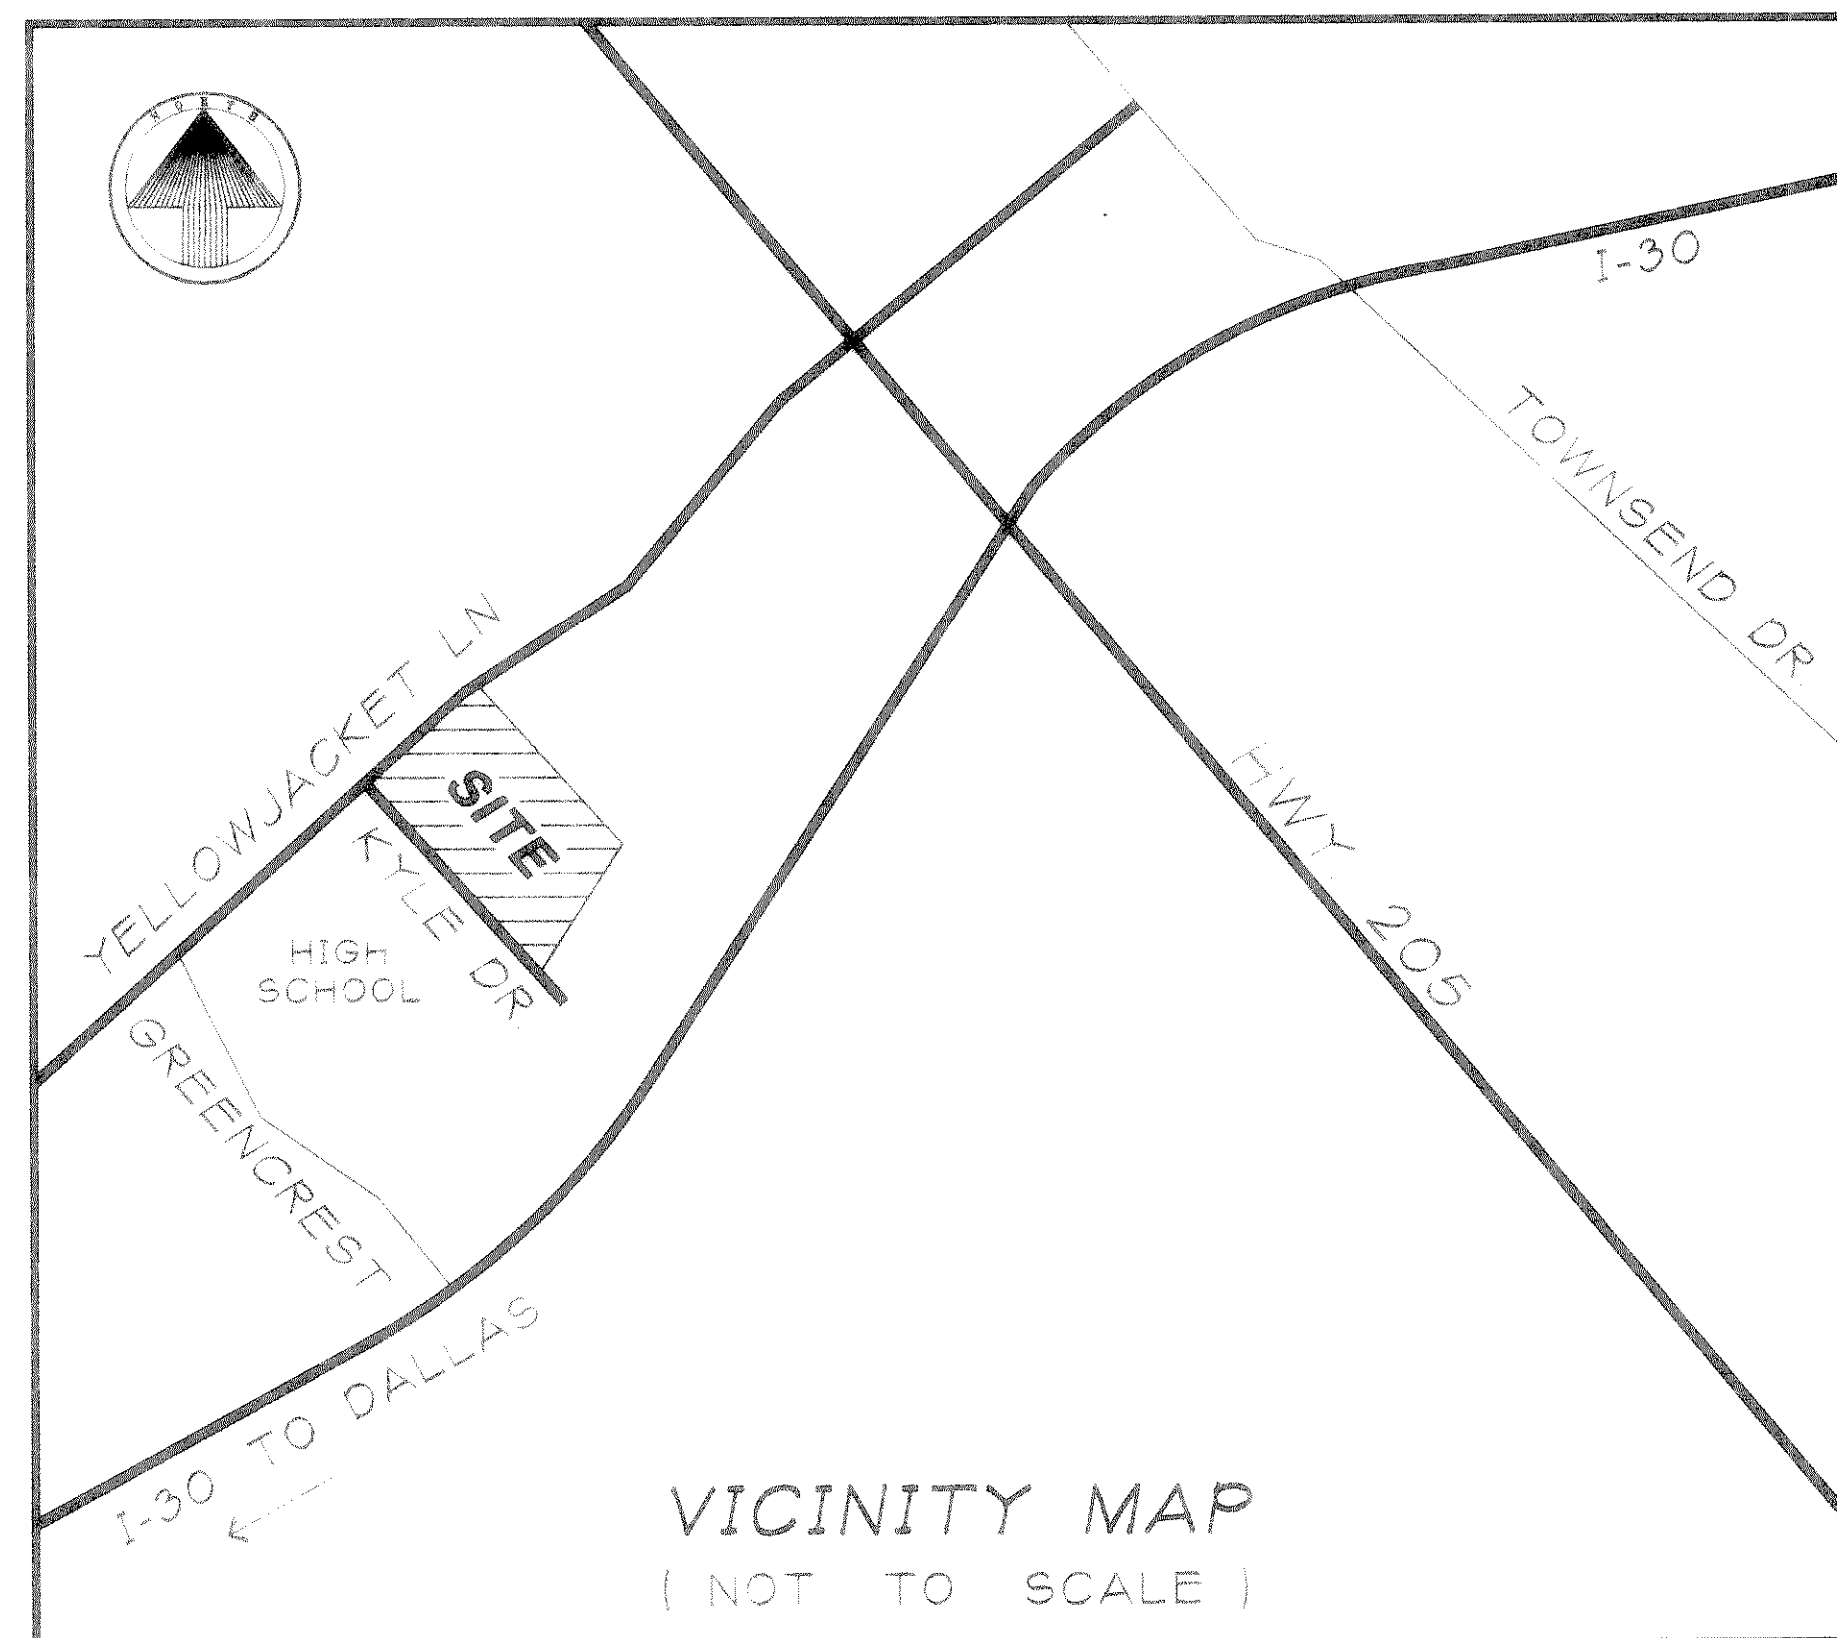

**SHEET INDEX :**

- 1-2 FINAL PLAN
- 3 WATER AND SANITARY SEWER PLAN
- 4 SANITARY SEWER PROFILES
- 5 GRADING PLAN
- 6 DRAINAGE AREA MAP
- 7 STORM SEWER PLAN
- 8 STORM SEWER PROFILES
- 9 DIMENSION CONTROL PLAN
- 10 EROSION CONTROL PLAN
- 11 CITY DETAILS


OWNED BY :

**SMARTT INTERSTATE 30 JOINT VENTURE**  
 5001 SPRINGVALLEY ROAD  
 SUITE 1100 W, LBII WEST  
 DALLAS, TEXAS 75252

DEVELOPED BY :

**ROCKWALL / S-130, LTD.**  
 5703 COVEHAVEN  
 DALLAS, TEXAS 75252

AS-BUILT  
 Full D.O.  
 2.9.97

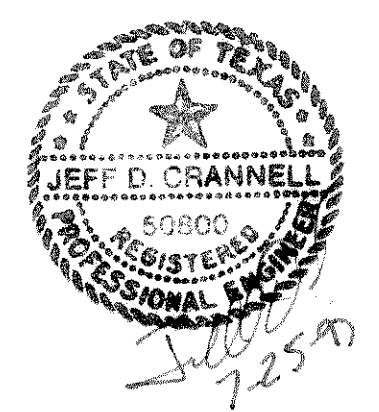

PREPARED BY :



1120 EMPIRE CENTRAL PLACE - S. 308 - DALLAS, TEXAS 75247 - (214) 630-5200