


AS-BUILT  
DATE 2-1-99

BENCHMARK:  
TOP OPERATING NUT OF FIRE HYDRANT  
LOCATED AT THE SOUTHEAST CORNER  
OF KYLE DRIVE & YELLOWJACKET LANE  
ELEVATION = 529.27

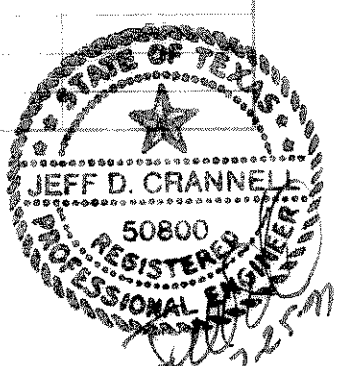

REVISED 7-21-97

SANITARY SEWER PROFILES						
ROCKWALL PLACE APARTMENTS						
ROCKWALL / S-130, LTD.						
CCM ENGINEERING, CORP.						
CITY OF ROCKWALL, TEXAS						
DESIGN	DRAWN	DATE	SCALE	NOTES	FILE	NO.
CCM	CCM	3-97	H:1"=50' V:1"=5'		RVAL-SS1-R	4