


AS-BUILT
Full on
 DATE 2-1-97

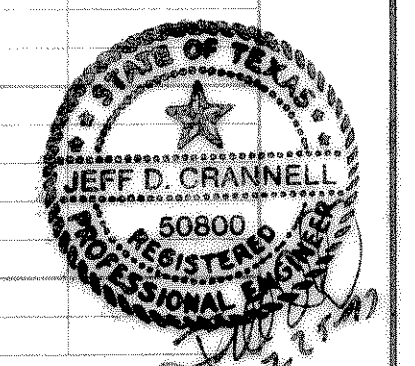

REVISED: 7-22-97

STORM SEWER PROFILES						
ROCKWALL PLACE APARTMENTS						
ROCKWALL / S-130, LTD.						
CCM ENGINEERING, CORP.						
CITY OF ROCKWALL, TEXAS						
DESIGN	DRAWN	DATE	SCALE	NOTES	FILE	NO.
CCM	CCM	3-97	H:1"=50'	V:1"=5'	RWL-STMI	8