



General Notes
 All dimensions to reinforcing bars refer to ϵ of bar.
 All bar lap to be 40 ϕ .
 Concrete shall have min. compressive strength of 3000 ψ @ 28 days.
 All exposed wall surfaces shall have a carborundum finish.
 Maximum spacing of Expansion Joint to be 60'.

RETAINING WALL DETAIL

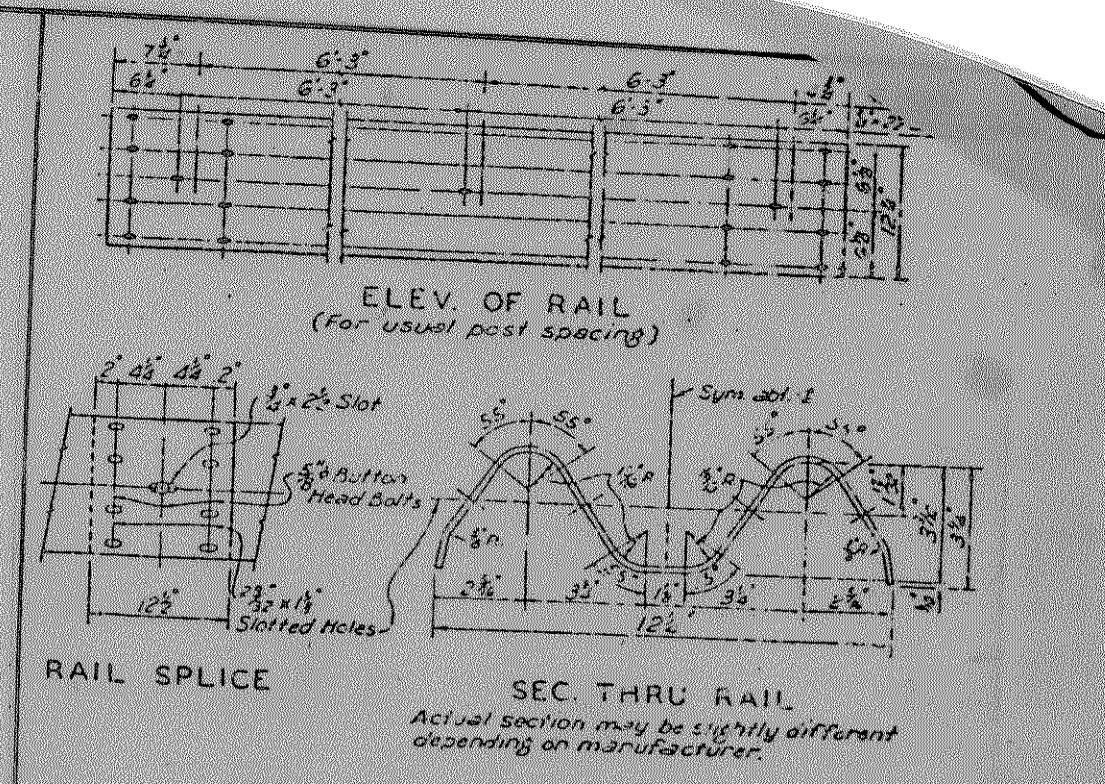

GENERAL NOTES:
 All anchorage provisions, including bolts, nuts and washers are considered as parts of the railing.
 The lower anchor bolts for posts on the abutment and ends of spines shall be bent as required to provide a maximum penetration of 3/8\"/>

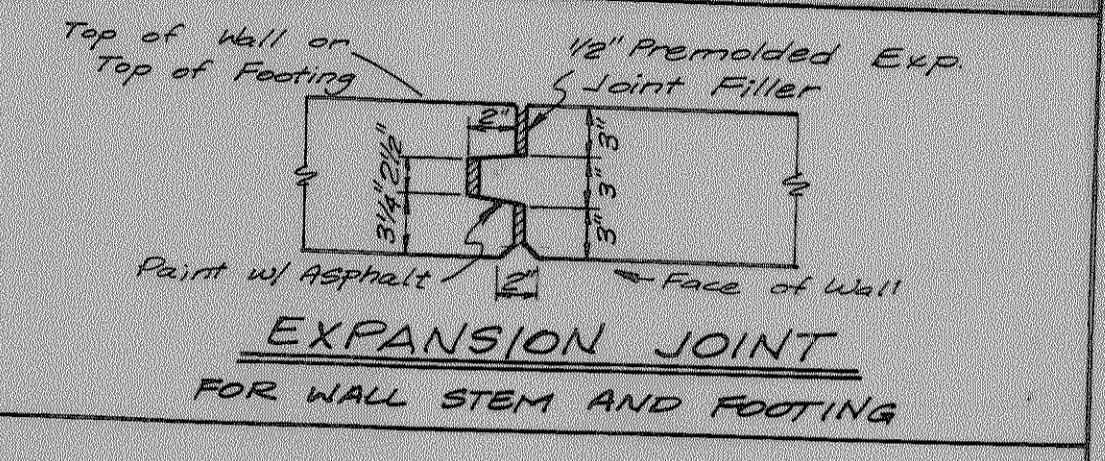

AS BUILT

4/8

HAROLD L. EVANS CONSULTING ENGINEER 2331 GUS THOMASSON RD. SUITE 102 DALLAS, TEXAS 75228 PHONE (214) 328-8133		GRADING & DRAINAGE HAROLD CHENAULT B.F. BOYDSTUN SURVEY - ABSTRACT 14 CITY OF ROCKWALL, ROCKWALL CO., TEXAS	
REVISED GRADES PUMP ISLAND FEB 9, 1987 REVISED GRADES OCT 27, 1986 REVISED PER CITY REVIEW JUNE 10, 1986	SCALE 1" = 20' DATE 5-8-86 JOB NO. 85193		