


PROP Ln. "A"

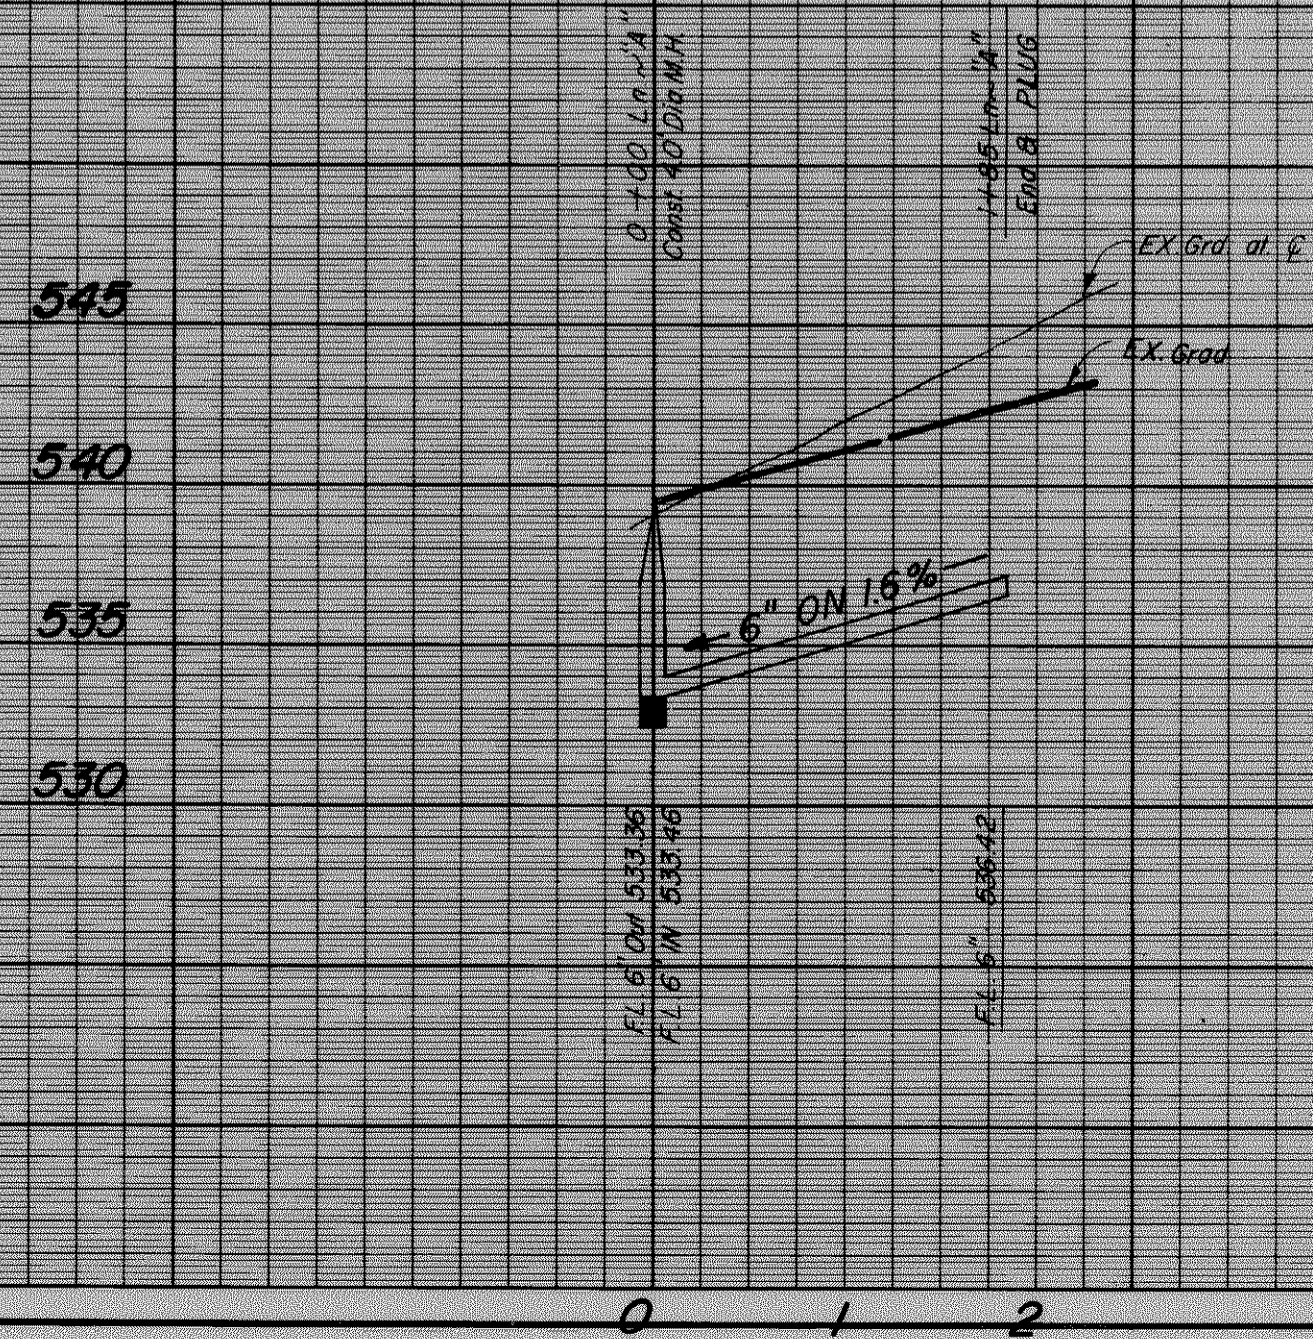

**AS BUILT**

<b>PROPOSED UTILITY PLAN</b>						
ROCKWALL SCHOOL ADDITION NO. 2						
CITY OF ROCKWALL						
ROCKWALL COUNTY, TEXAS						
HAROLD L. EVANS CONSULTING ENGINEER						
DESIGN	DRAWN	DATE	SCALE	NOTES	FILE	NO.
D. H.	D. H.	NOV. 83	1" = 100'			83227