

SITE ENGINEERING PLANS

RIDGE ROAD TOWN CENTRE - PHASE II


ROCKWALL, TEXAS

OWNER:
RIDGE ROAD TOWN CENTRE PARTNERS, L.P.

DEVELOPER:



5400 W. PLANO PARKWAY, SUITE 200
 PLANO, TEXAS 75093
 972-381-9600

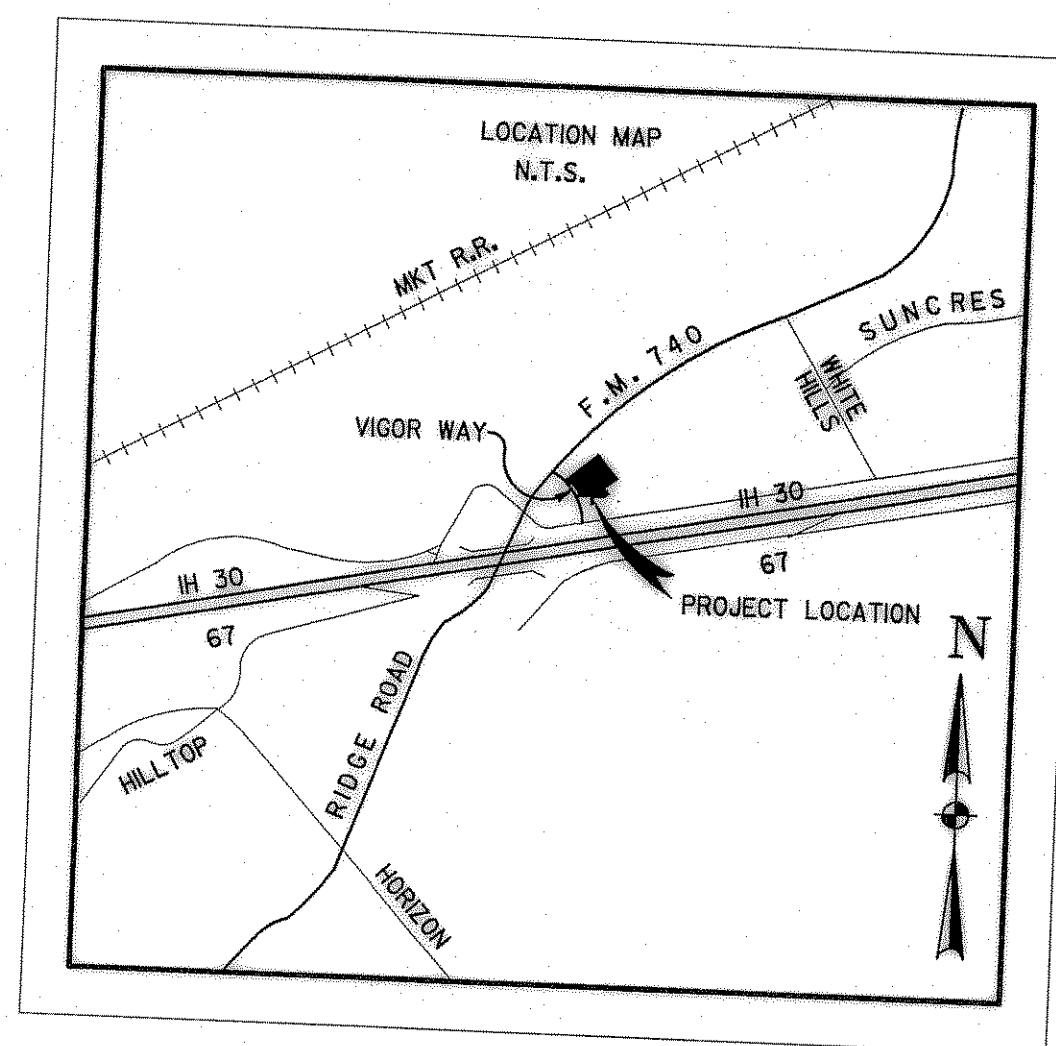


ENGINEER:



8616 NORTHWEST PLAZA - DALLAS, TX 75225
ENGINEERS • SCIENTISTS • PLANNERS • SURVEYORS
 Phone: (214) 346-6200 Fax: (214) 361-5573
 Contact: Mark McGraw or Alex Bennett

AVO 20817

July, 2004

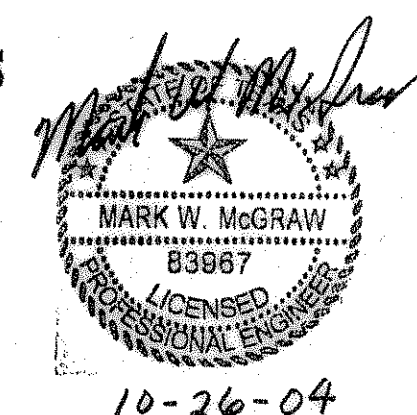

RECORD DRAWINGS BASED ON
 FIELD SURVEY (12/05) AND
 CONTRACTOR INFORMATION ONLY.
Mark W. McGraw 2-8-06

SHEET INDEX	
SHEET NUMBER	TITLE
	COVER SHEET/INDEX
C1.1	EROSION CONTROL PLAN
C1.2	EROSION CONTROL NOTES & DETAILS
C2.1	FINAL PLAT - PAGE 1
C2.2	FINAL PLAT - PAGE 2
C3.1	DRAINAGE AREA MAP
C3.2	GRADING PLAN
C4.1	PAVING & DIMENSION CONTROL PLAN
C4.2	SLEEVING PLAN
C5.1	STORM SEWER PLAN
C5.2	STORM SEWER PROFILES
C6.1	WATER AND SEWER PLAN
C6.2	SANITARY SEWER PROFILES
C6.3	SANITARY SEWER LIFT STATION (PRIVATE)
C6.4	PROJECT DETAILS
C6.5	ROCKWALL STANDARD DETAILS
PED-02	TxDOT PEDESTRIAN FACILITIES
L1.01	LANDSCAPE PLAN
L2.01	LANDSCAPE DETAILS-
L2.02	LANDSCAPE DETAILS-
E2.2	PRIVATE LIFT STATION ELECTRICAL

RIDGE ROAD TOWN CENTRE - PHASE II