


RIDGE ROAD
TOWN
CENTRE
ROCKWALL, TEXAS

Ridge Road Town Centre
Partners, L.P.
by its General Partners:
RIDGE ROAD
PARTNERS L.L.C.

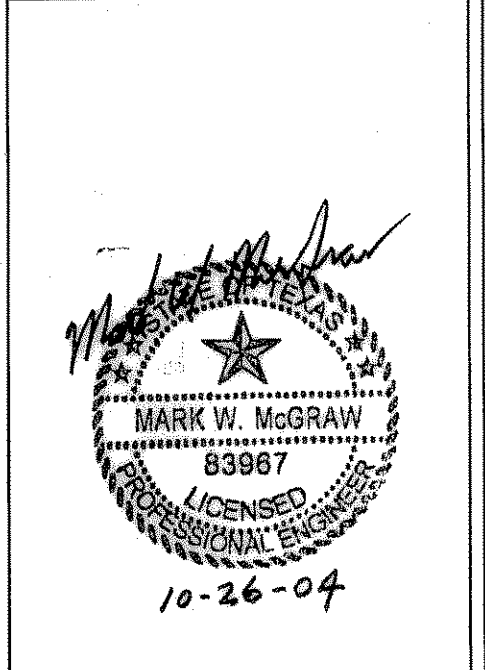

Half Associates, Inc.
ENGINEERS • ARCHITECTS • SCIENTISTS • PLANNERS • SURVEYORS
8606 NORTHWEST PLAZA DRIVE
TELL (214) 346-4000
FAX (214) 739-0895

Project No: AVG # 20817
Revision:

No.	Date	Description
1	10/02/06	FIRST SUBMITTAL
2	4/08/06	SECOND SUBMITTAL
3	5/09/06	THIRD SUBMITTAL
4	6/09/06	FOURTH SUBMITTAL
5	7/02/06	FIFTH SUBMITTAL
7	10/26/04	SEVENTH SUBMITTAL

Drawn by:
Checked by:
Sheet Title:
**SANITARY SEWER
PROFILES**
Sheet Number:
C6.2

RECORD DRAWINGS BASED ON
FIELD SURVEY (12/05) AND
CONTRACTOR INFORMATION ONLY.
Mark W. McGraw 2-8-06

- 02-08-06 RECORD DRAWINGS
- 12-28-04 REV. LIFT STA. & F.M. PER COMMENTS
- 12-13-04 ELM. DROP MH
- 12-13-04 REV. F.M. DISCH. LOC.

HORIZ. SCALE: 1"= 40'
VERT. SCALE: 1"=4'