


LEGEND	
+ETP600.0	EX. TOP OF PVMT.
+ETG600.0	EX. TOP OF GRND.
+ETC600.0	EX. TOP OF CURB
+600.0	FIN.FLR. SPOT ELEV.
TP600.0	TOP OF PAVEMENT
TC600.0	TOP OF CONCRETE
TG600.0	TOP OF GROUND
600.0	TOP OF CURB
==650==	PROP. GRADE LINE
-650-	EX. GRADE LINE
FF	FINISHED FLOOR
↑	GUY WIRE ANCHOR
⊕	POWER POLE
⊕	STREET/CABLE SIGN
⊕	WATER VALVE
⊕	UTILITY BOX
⊕	WOOD BOLLARD
⊕	GAS METER
⊕	CURB INLET
⊕	GRATE INLET
⊕	FIRE HYDRANT
⊕	WATER METER
⊕	STORM/SS MANHOLE
⊕	TREE
⊕	LIGHT POLE
⊕	SIGNAL POLE
⊕	SIGNAL PULL BOX

dietz engineering

CIVIL ENGINEERING · SURVEYING


972-889-9977
FAX 972-889-9993

1751 INTERNATIONAL PARKWAY SUITE 115
RICHARDSON TX 75081

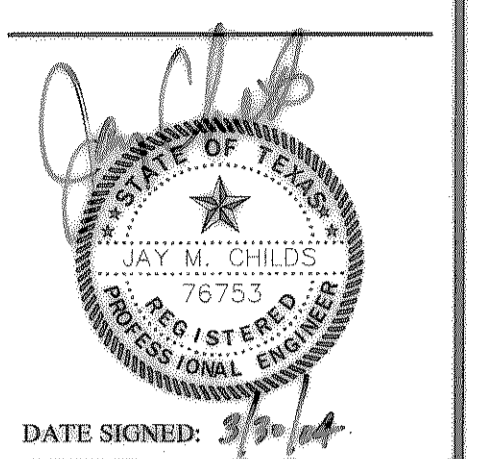

DATE SIGNED: 3/30/04

A New Site Design for
ROCKWALL TOWNE CENTRE, REPLAT
SHAFFER PROPERTIES
ROCKWALL, TEXAS
DEMOLITION PLAN

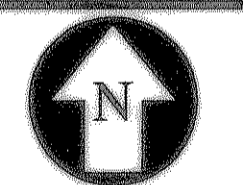

SCALE:

Horizontal: 1" = 30'
 Vertical: N/A

VERIFY SCALES

BAR IS ONE INCH ON ORIGINAL DRAWING
 0 1"
 IF NOT ONE INCH ON THIS SHEET, ADJUST SCALES ACCORDINGLY.

Project No.: ESPC002
 Date: 03/29/04
 Issue: AS BUILT
 Drawn By: TDK
 Checked By: JMC
 Revisions:

SHEET

C1.02