


DRAINAGE AREA NO.	AREA (ACRES)	C	I (IN/HR)	Q (CFS)
A-1	0.47	0.8	9.8	3.7
A-2	2.93	0.8	9.8	23.0
B-1	2.91	0.8	9.8	23.0
C-1	3.41	0.8	9.8	26.7
C-2	0.73	0.8	9.8	5.7
D-1	0.50	0.8	9.8	3.9
D-2	0.79	0.8	9.8	6.2

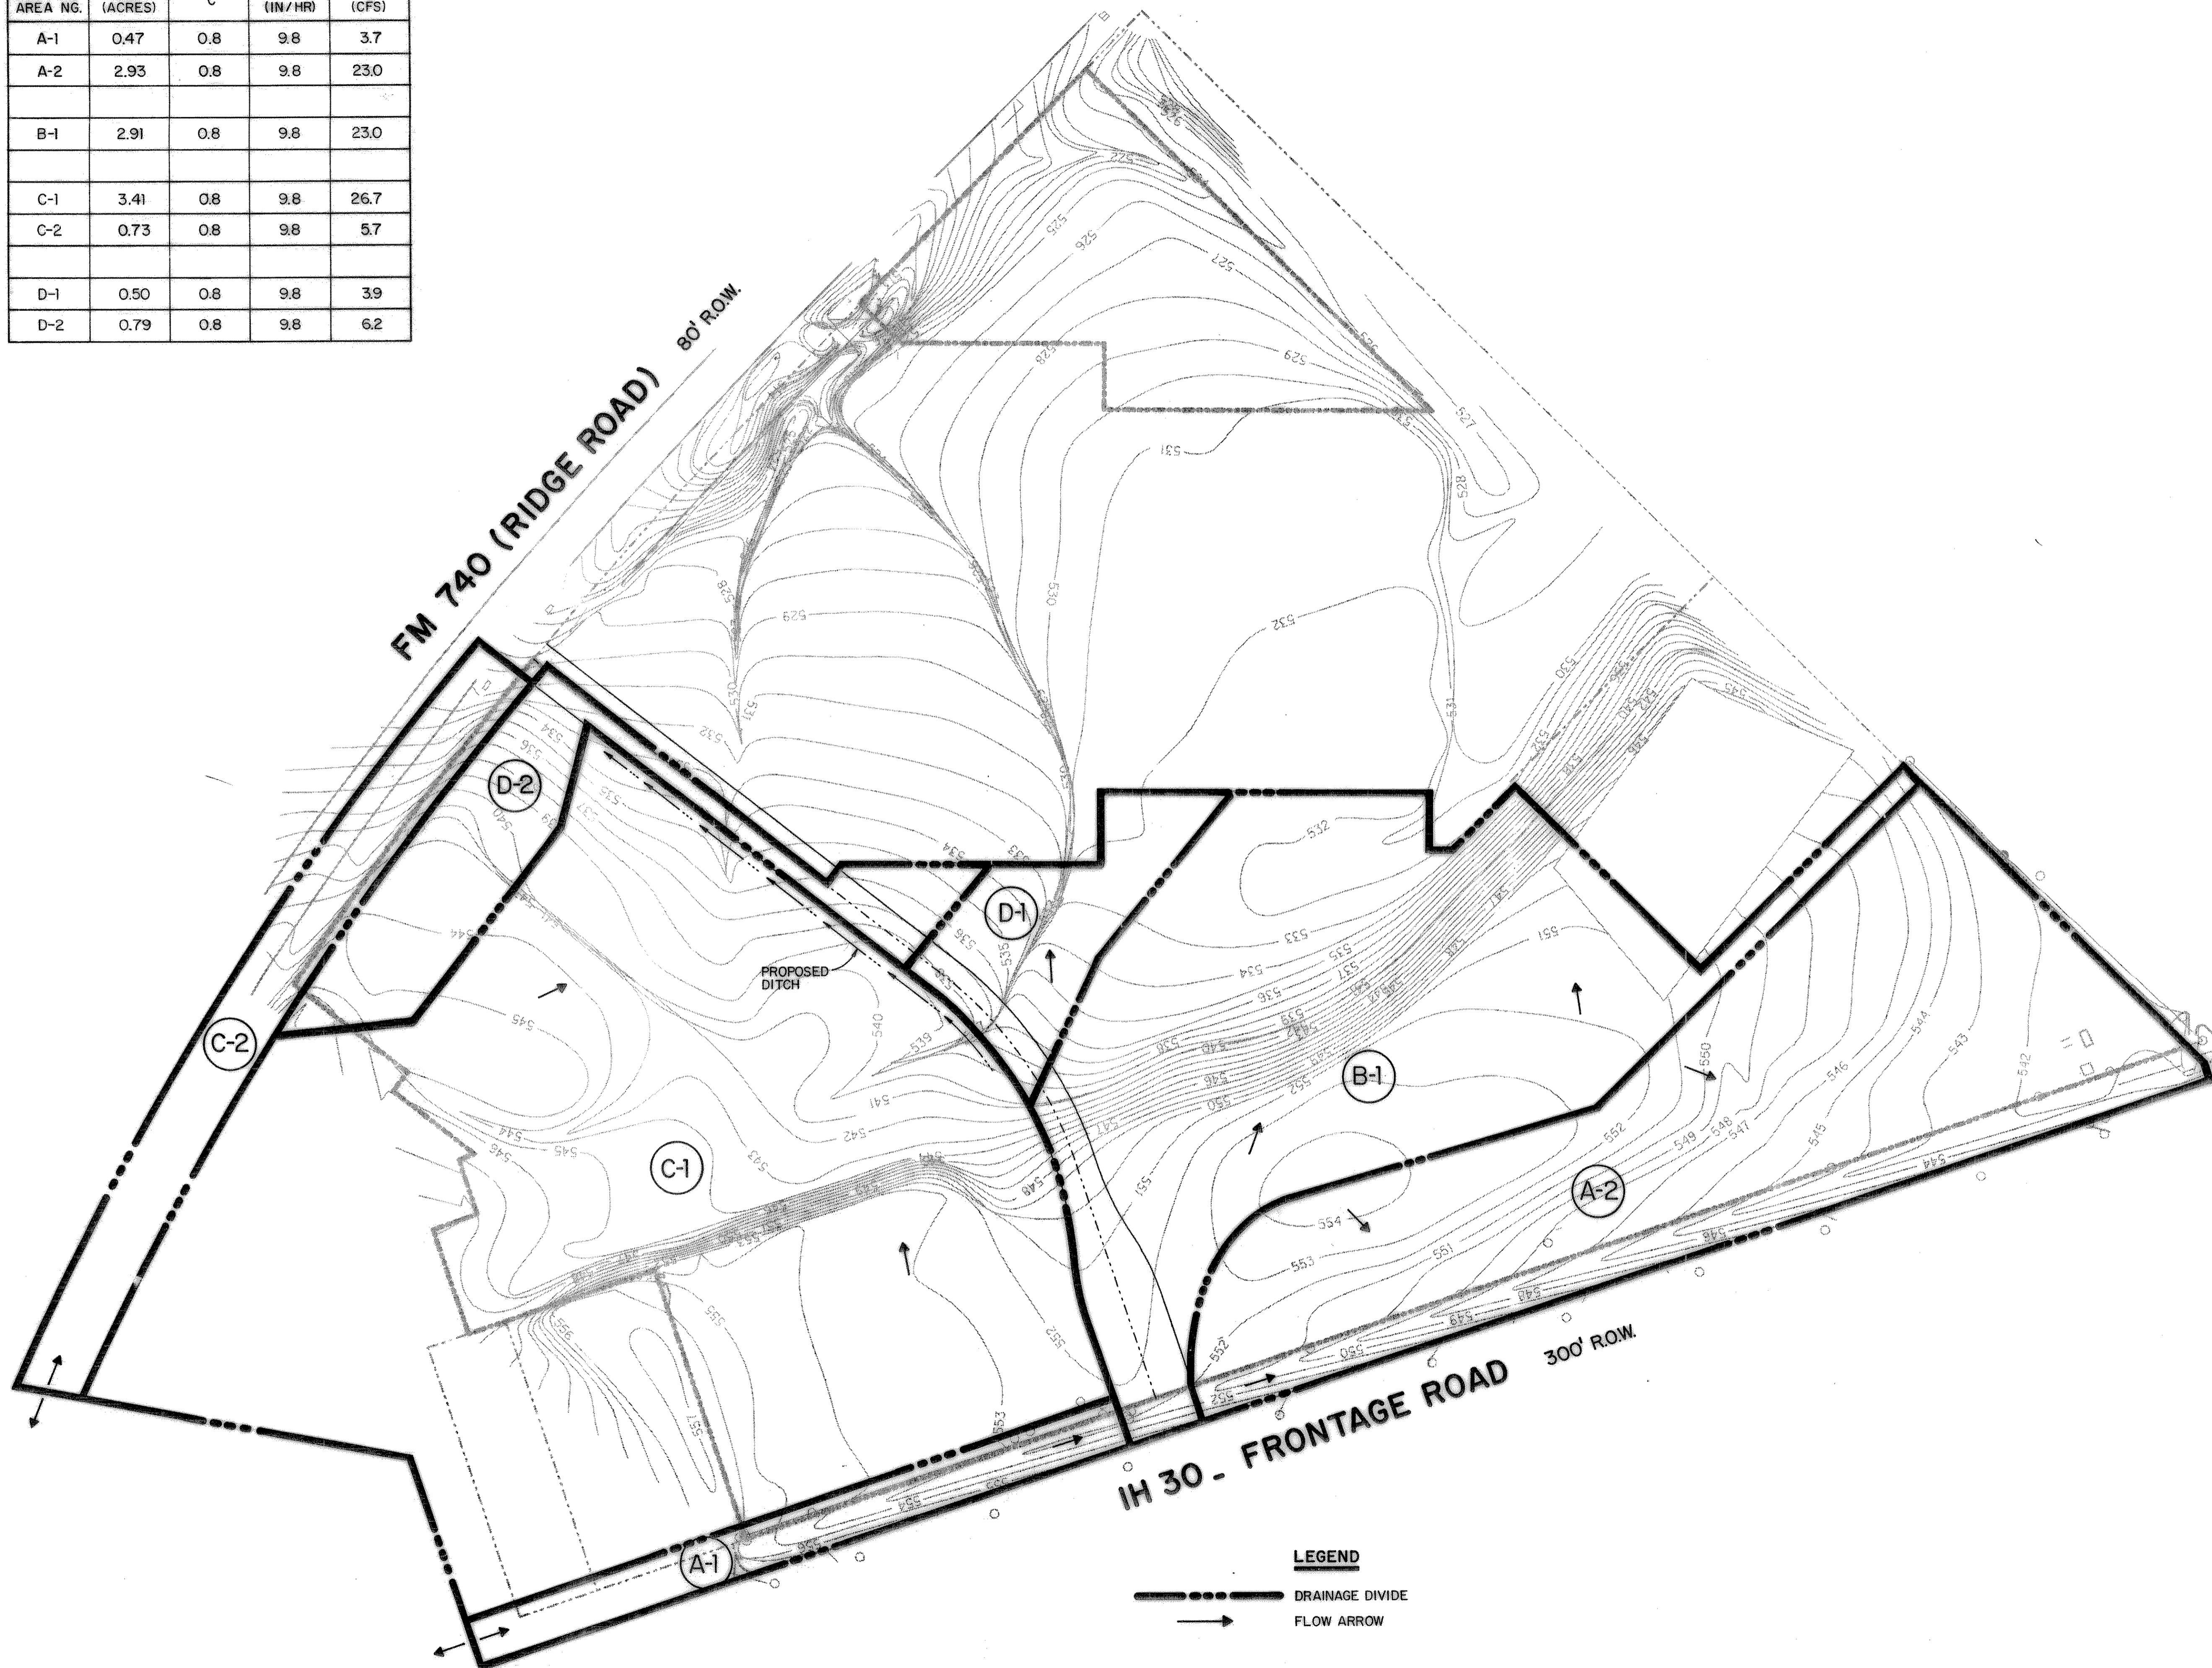

Patrick Lee Acker
   
 3/10/95

DRAINAGE AREA MAP						
ROCKWALL TOWNE CENTRE						
LEGACY CAPITAL						
ROCKWALL, TEXAS						
 <b>HALFF ASSOCIATES, INC.</b> ENGINEERS • SCIENTISTS • SURVEYORS						
DESIGN	DRAWN	DATE	SCALE	NOTES	FILE	NO.
A.H.H.	CADD	FEB. 1995	1" = 60'	AVG 189DAMAP		D-1