



CAUTION UNDERGROUND UTILITIES
 EXISTING UTILITIES INDICATED ON THESE PLANS HAVE BEEN LOCATED FROM REFERENCE INFORMATION. IT SHALL BE THE CONTRACTOR'S RESPONSIBILITY TO VERIFY BOTH HORIZONTALLY AND VERTICALLY THE LOCATION OF ALL EXISTING UTILITIES PRIOR TO CONSTRUCTION AND TO PROMPTLY NOTIFY THE ENGINEER OF ANY CONFLICTS OF THE WORK WITH EXISTING FACILITIES.

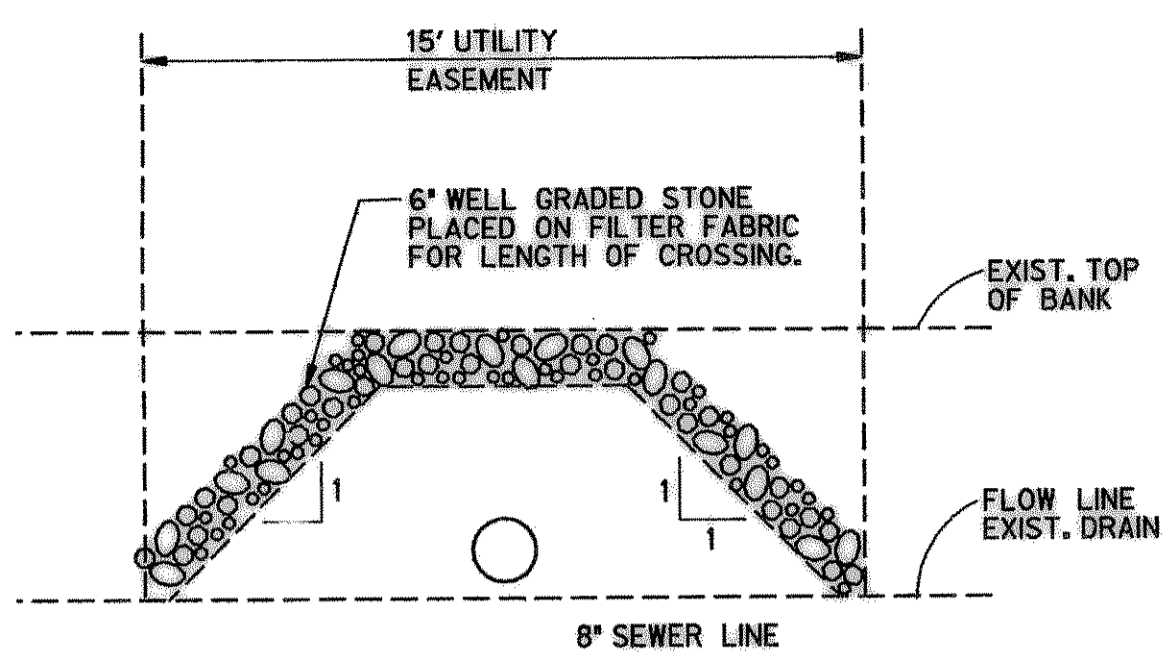

SECTION A-A

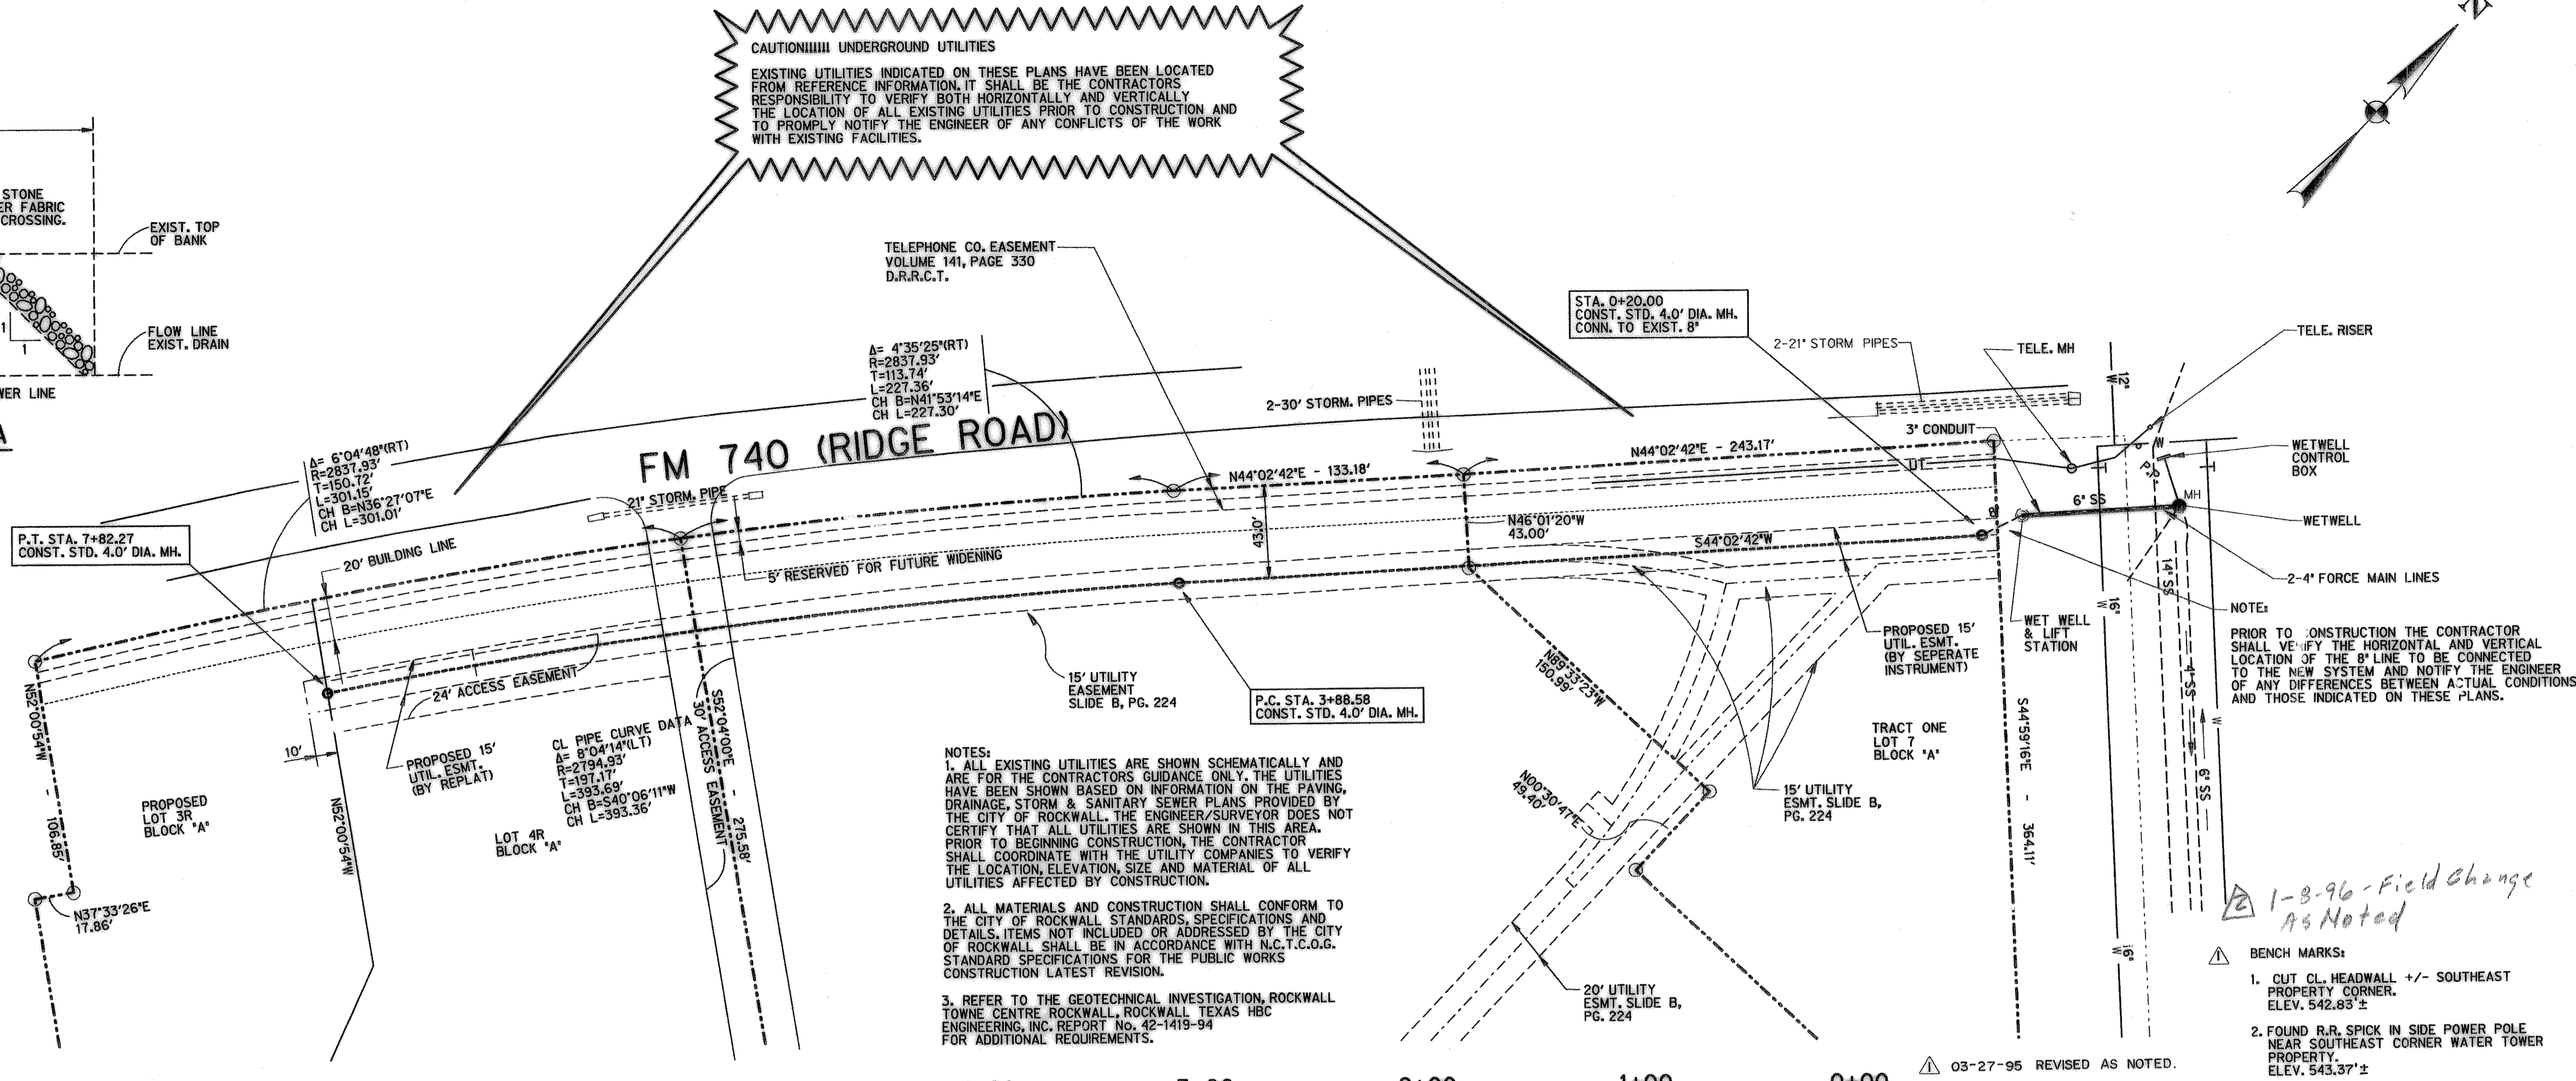



NOTES:
 1. ALL EXISTING UTILITIES ARE SHOWN SCHEMATICALLY AND ARE FOR THE CONTRACTOR'S GUIDANCE ONLY. THE UTILITIES HAVE BEEN SHOWN BASED ON INFORMATION ON THE PAVING, DRAINAGE, STORM & SANITARY SEWER PLANS PROVIDED BY THE CITY OF ROCKWALL. THE ENGINEER/SURVEYOR DOES NOT CERTIFY THAT ALL UTILITIES ARE SHOWN IN THIS AREA. PRIOR TO BEGINNING CONSTRUCTION, THE CONTRACTOR SHALL COORDINATE WITH THE UTILITY COMPANIES TO VERIFY THE LOCATION, ELEVATION, SIZE AND MATERIAL OF ALL UTILITIES AFFECTED BY CONSTRUCTION.
 2. ALL MATERIALS AND CONSTRUCTION SHALL CONFORM TO THE CITY OF ROCKWALL STANDARDS, SPECIFICATIONS AND DETAILS. ITEMS NOT INCLUDED OR ADDRESSED BY THE CITY OF ROCKWALL SHALL BE IN ACCORDANCE WITH M.C.T.C.O.G. STANDARD SPECIFICATIONS FOR THE PUBLIC WORKS CONSTRUCTION LATEST REVISION.
 3. REFER TO THE GEOTECHNICAL INVESTIGATION, ROCKWALL TOWNE CENTRE ROCKWALL, ROCKWALL, TEXAS HBC ENGINEERING, INC. REPORT No. 42-1419-94 FOR ADDITIONAL REQUIREMENTS.

NOTE:
 PRIOR TO CONSTRUCTION THE CONTRACTOR SHALL VERIFY THE HORIZONTAL AND VERTICAL LOCATION OF THE 8" LINE TO BE CONNECTED TO THE NEW SYSTEM AND NOTIFY THE ENGINEER OF ANY DIFFERENCES BETWEEN ACTUAL CONDITIONS AND THOSE INDICATED ON THESE PLANS.

1-8-96 - Field Change As Noted

- BENCH MARKS:**
- CUT CL. HEADWALL +/- SOUTHEAST PROPERTY CORNER. ELEV. 542.63' ±
 - FOUND R.R. SPICK IN SIDE POWER POLE NEAR SOUTHEAST CORNER WATER TOWER PROPERTY. ELEV. 543.37' ±

03-27-95 REVISED AS NOTED.

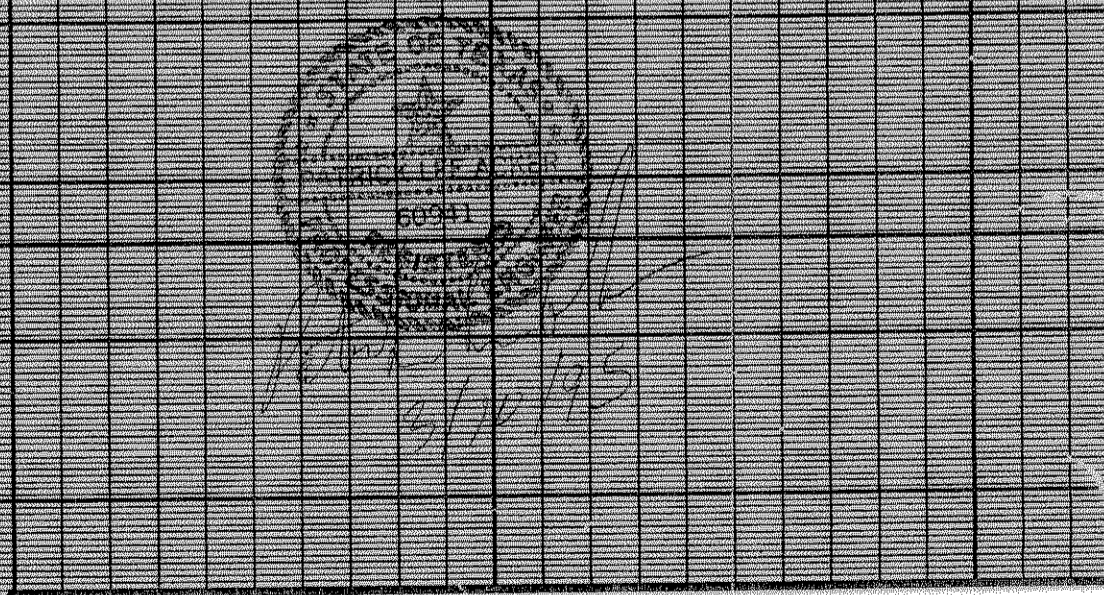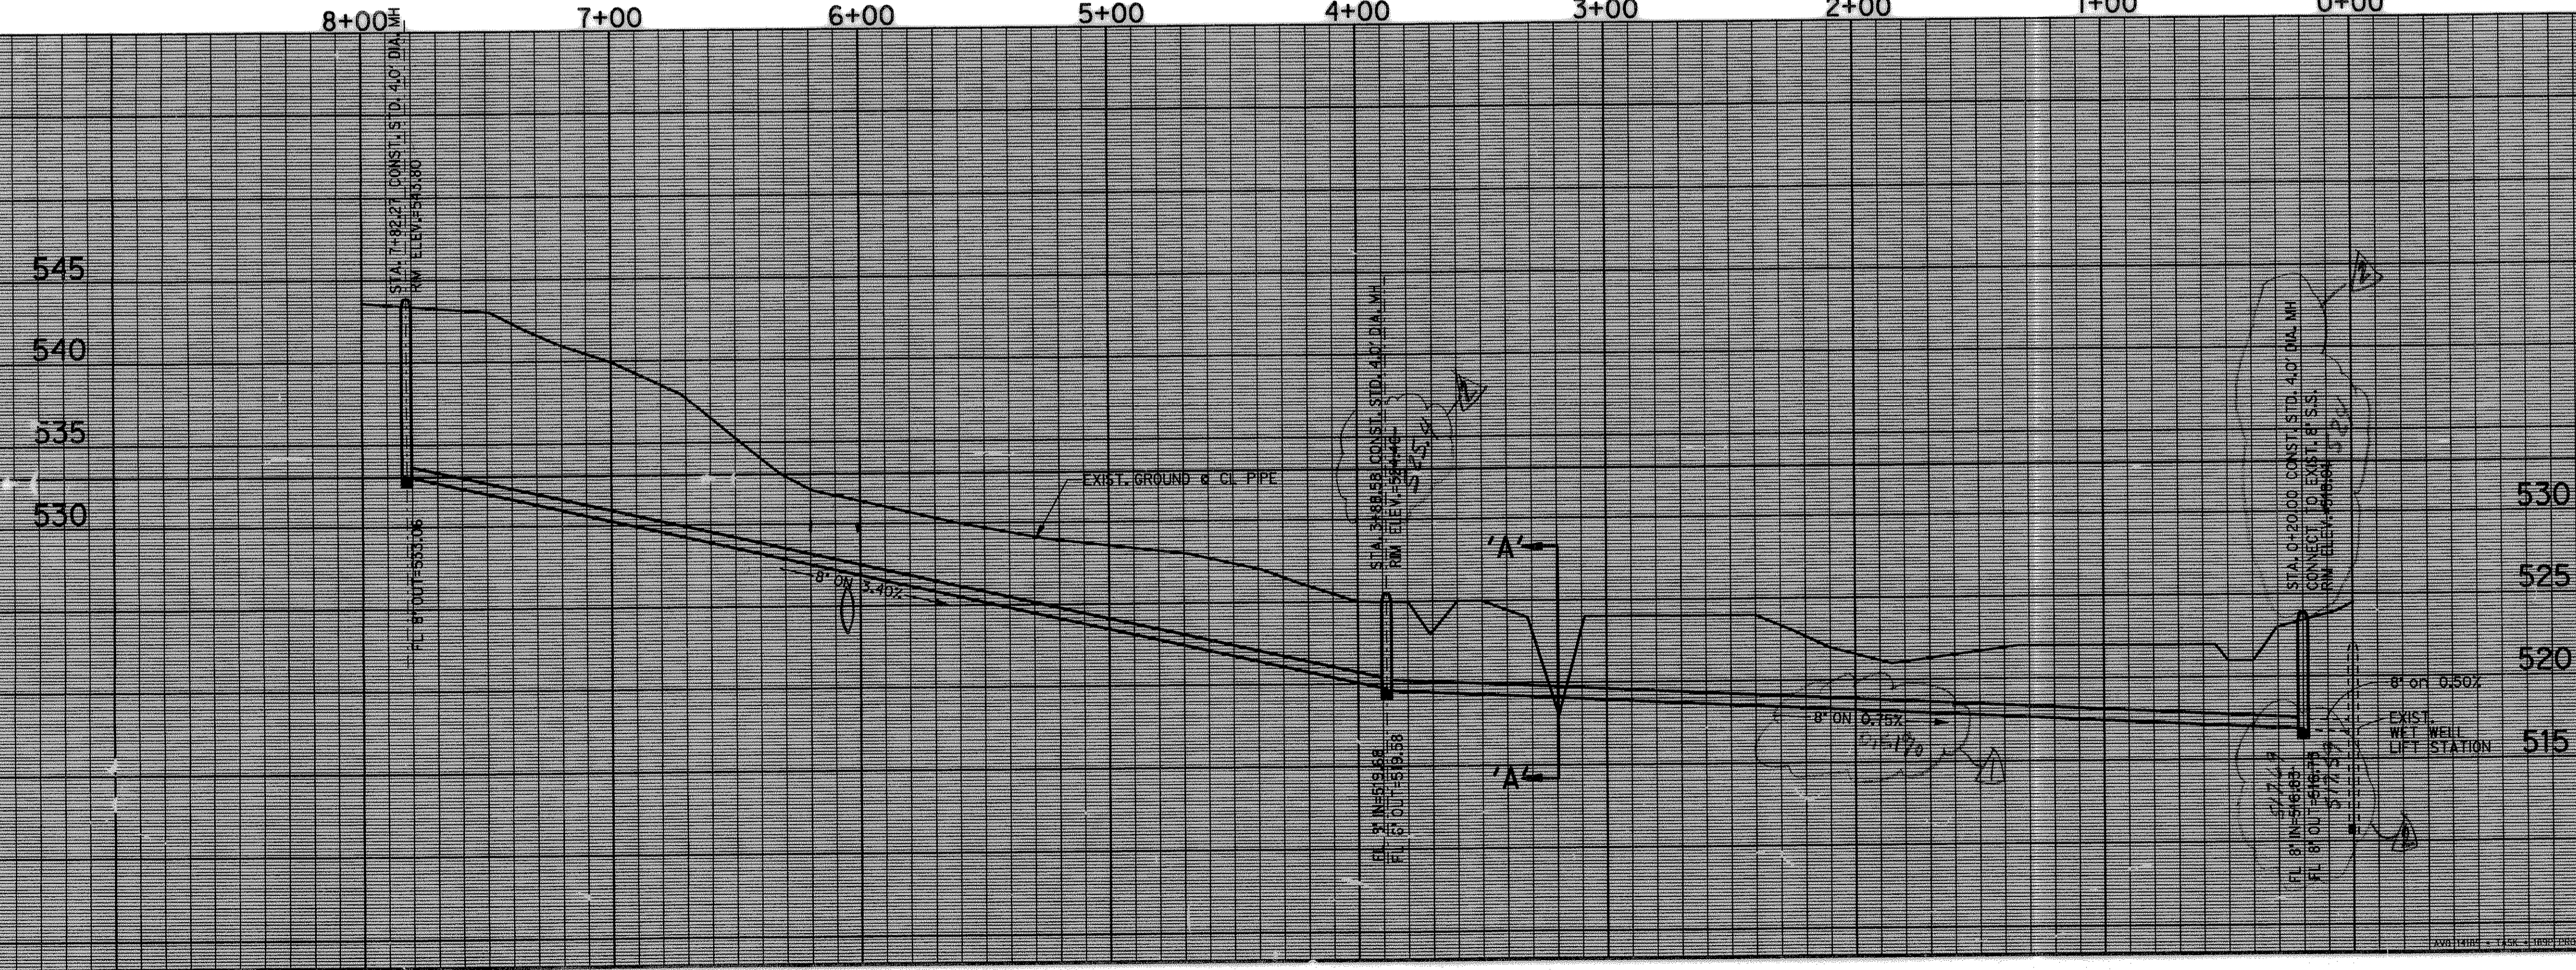

SANITARY SEWER						
ROCKWALL TOWNE CENTRE						
LEGACY CAPITAL						
ROCKWALL, TEXAS						
HALFF ASSOCIATES, INC. ENGINEERS • SCIENTISTS • SURVEYORS						
DESIGN	DRAWN	DATE	SCALE	NOTES	FILE	NO.
A.H.H.	CADD	FEB. 1995	H ₁ 1"=40' V ₂ 1"=6'	AVO 189PLPRD		SS - 1