


BENCH MARK  
 Monument #927 on North Side of UP RR &  
 East Side of State Hwy. No. 549.  
 Elev. = 612.96

**PAVING PLAN**  
 ROLLING MEADOWS ESTATES  
 Rockwall County, Texas

**TIPTON ENGINEERING, INC.**  
 6330 Belt Line Rd. ~ Suite C ~ Garland, Texas 75043

DESIGN	DRAWN	DATE	SCALE	NOTES	FILE	NO.
T.E. Inc.	T.E. Inc.	12-95	1"=40'H. 1"=5'V.		4180	5

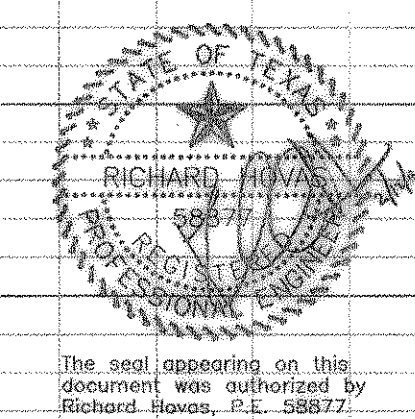

The seal appearing on this document was authorized by Richard Hovav, P.E. 58877.

2-12-96 4180P3