


AS BUILTS
RETAINING WALL
RTG 7/17/17




**ASSOCIATES, INC.
RETAINING WALLS**

Mailing: P.O. Box 557; Pilot Point, TX 76258
Delivery: 1016 N. Industrial Blvd.; Pilot Point, TX 76258
Phone: (830) 980-4037 Fax: (830) 438-4863

December 13, 2016

Helker & Crawford Constructors, LP
720 Valley Ridge Circle, Suite 1
Lewisville, Texas 75057

Attention: Mr. Chad Violette


**Pavestone Anchor Diamond Pro Beveled Geotechnical Design Submittal
Rooms To Go
Rockwall, TX**


Enclosed please find the engineering design submittals for your approval for the modular block retaining walls on the above referenced project.

We appreciate the opportunity to work with Helker & Crawford, please contact us should you have any questions or need additional information.

- NO EXCEPTIONS (1 page)
- EXCEPTIONS AS NOTED Obtain written approval
- REJECTED - RESUBMIT from owner for exact material color and facade.

Review is only for general conformance with design concept of project and general compliance with the Contract Documents. Contractor is responsible for confirming and correlating dimensions at job site; for information which pertains to fabrication processes or construction techniques; and for coordination of work of all trades. Review of shop drawings shall not relieve contractor, any Subcontractor, and/or Material Supplier of responsibility from deviation from requirements of Contract Documents nor for errors or omissions in shop drawings. Contractor is responsible for conforming to review authority specifications on any and all materials used and procedures implemented.


Morgan Mueller
Sales Administrator
JDK Associates, Inc.

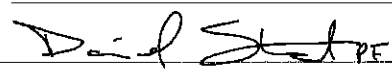DATE: 16 December 2016
BY: 

 **CATES-CLARK**
CATES-CLARK & ASSOCIATES, LLP
Consulting Engineers Dallas, Texas

SynchroPile, Inc.

Firm Registration F-6831



Project No. ZA16-0602
December 8, 2016

6123 Blanco Road
San Antonio, Texas 78218
Phone: 210-541-0540
Fax: 210-340-6434
phil.king@synchropile.com

JDK Associates, Inc.
P.O. Box 557
Pilot Point, Texas 76258-0557

Attention: Mr. James S. Kenney
President

**Geotechnical Design, Modular Retaining Wall
Pavestone Anchor Diamond Pro Beveled Face Units
Rooms To Go - Rockwall
IH-30 and Greencrest
Rockwall, Texas**

This letter presents Plans and Specifications detailing the typical layout of the Pavestone Anchor Diamond Pro Beveled Face Modular Retaining Walls to be used on the Rooms To Go project, located at IH-30 and Greencrest in Rockwall, Texas. Our services in developing these plans and specifications were performed in general accordance with our Proposal No. ZA16-0602, dated December 8, 2016. Our services were requested and authorized by Ms. Morgan Mueller with JDK in an email.

Geotechnical Data. The design is based on geotechnical data developed by Alpha Testing, Inc., and presented in their Report No. G152918, dated February 5, 2015. Their study was performed for subsurface exploration and foundation analysis for the proposed facility. For our design, we have assumed the soils in the retaining wall area are similar to those revealed by the Alpha borings. Should different soils be encountered during the construction of the wall, it may be necessary to revise the design presented herein.

Special Inspections. As indicated in the attached specifications, Special Inspections from a licensed engineering company is a recommendation of this design (unless required by the City of Rockwall). Therefore, if the Owner follows this recommendation they will need to arrange for a licensed engineering firm to provide special inspection services of the contractor's work in accordance with IBC Chapter 17 (See IB 132).

Global Stability Analysis. Our design was performed without the need to perform a Global Stability Analysis (GSA). This analysis was not within our scope of work and therefore was not performed. It may be a requirement or recommendation of other parties that a GSA be performed, and if so it can be performed if requested.




Limitations. The attached design is to be utilized within the scope of work presented in our proposal, and is for the exclusive use of JDK Associates. This design is not intended to be used for any other purposes. SynchroPile, Inc. makes no claim or representation concerning any activity or condition falling outside the specified purposes to which this design is directed, said purposes being specifically limited to the scope of work as defined in said agreement. Inquiries as to said scope of work or concerning any activity or condition not specifically contained therein should be directed to SynchroPile, Inc., for determination and, if necessary, further investigation.

The professional services that form the basis for this design have been performed using that degree of care and skill ordinarily exercised, under similar circumstances, by reputable geotechnical engineers practicing in the same locality. No warranty, express or implied, is made as to the professional advice set forth.

We appreciate being of service to JDK Associates on this project. Please call if we can be of additional assistance.

Sincerely,
SynchroPile, Inc., Firm Registration F-8831



Philip G. King, P.E., D.G.E., F.ASCE
President

tbn/PGK(c:\ZA16-0602\et.doc)
Copies Submitted: (1)





**Concrete Modular Retaining Wall
Pavestone Anchor Diamond Pro Beveled Face Units
JDK Project No. 996
Rooms To Go – Rockwall Project
IH-30 at Greencrest
Rockwall, Texas**

General Notes

1. This Specification, the attached Design Plans, and Letter dated December 8, 2016, are combined to make up the complete design package; and are for the exclusive use of JDK Associates.
2. Location and final finished height of the wall shall be as shown on the Site Drainage plan sheet developed for the project by the Site Civil Engineer. Any discrepancies between the Project Specifications and Plans developed for the project and these specifications and attached plans shall be forwarded in writing to SynchroPile, Inc. for clarification. Analyses were performed and design developed based on subsurface data developed by Alpha Testing, Inc., and presented in their Report No. G152918, dated February 5, 2015.
3. Upper layer of Modular Concrete Units shall be stepped down uniformly across the wall as to shape the wall to grade contours.
4. The Modular Concrete Units shall be "Pavestone Anchor Diamond Pro Beveled Face" Retaining Wall Units as manufactured under license from Anchor Wall Systems.
5. The first course (lowest course) of Modular Concrete Units shall be placed a minimum depth of 12 inches below lowest adjacent grade.
6. Geogrid shall be Synteen SF 20 and SF 35, as directed in the following table (Page 2), Manufactured by Geo-Synthetics, Inc. (or equivalent).
7. At completion of project, Contractor to verify with Owner that safety handrails and fences are provided at the top of wall to meet local ordinances and codes. Design of handrails and fences are not included in this specification. Design details are provided on the attached plan sheets.
8. During and after general construction, no excavations, embedments or embodiments are to occur into the reinforced zone or within 5 ft of it, nor are excavations to occur below the toe of the wall without prior consultation with SynchroPile, Inc. The Contractor is to verify that this specification requirement is passed on the Owner.
9. During construction and prior to final placement of topsoil and/or pavement behind the wall, construction equipment and vehicles shall stay a minimum of 3 ft from back of wall. This requirement shall be passed on to the owner and/or General Contractor.
10. Positive drainage away from the wall (both top and bottom) shall be maintained prior to final placement of topsoil and/or pavement adjacent to the wall. The grades above the wall shall be such to address erosion issues above or below the wall. This requirement shall be passed on to the owner and/or General Contractor.
11. Unless noted otherwise on the site civil plans, the front face of the retaining wall shall be set at a slope ranging from near vertical to 8 vertical to 1 horizontal (8:1) slope as required to shape the wall.
12. The drainage of water from behind the wall is accomplished by the drainage of water through the reinforced gravel fill material (as specified herein) from behind the wall and through the face of the wall via the joints between the individual wall units.
13. Geogrid Placement is presented in the Following Table:

SynchroFile, Inc., Firm Registration No. 8831
 Project Specifications, Pavestone Anchor Diamond Pro Beveled Face, Modular Retaining Wall
 Roccess To Go - Rockwell, Rockwell, Texas

December 8, 2016
 SynchroFile Project No. ZK16-0602
 JDK Job No. 966

Maximum Wall Height, ft. (1)	No. of Wall Unit Courses	Geogrid Length, ft. (Beveled Front Face of Wall Units)	Geogrid Placement, Height From Base of Wall, ft.														
			Top Grid Letter	Remaining Grid Layers	Grid "A"	Grid "B"	Grid "C"	Grid "D"	Grid "E"	Grid "F"	Grid "G"	Grid "H"	Grid "I"	Grid "J"			
2.00	3	-	3.5	-	1.33	-	-	-	-	-	-	-	-	-	-	-	-
2.67	4	-	3.5	-	1.33	-	-	-	-	-	-	-	-	-	-	-	-
3.33	5	-	3.5	-	1.33	-	-	-	-	-	-	-	-	-	-	-	-
4.00	6	3.5	4.5	3.5	3.33	1.33	-	-	-	-	-	-	-	-	-	-	-
4.67	7	4.5	4.5	3.5	3.33	1.33	-	-	-	-	-	-	-	-	-	-	-
5.33	8	4.5	4.5	3.5	3.33	1.33	-	-	-	-	-	-	-	-	-	-	-
6.00	9	5.0	4.8	4.8	4.67	3.33	1.33	-	-	-	-	-	-	-	-	-	-
6.67	10	5.5	4.5	4.5	5.33	3.33	1.33	-	-	-	-	-	-	-	-	-	-
7.33	11	5.5	4.5	4.5	5.33	3.33	1.33	-	-	-	-	-	-	-	-	-	-
8.00	12	5.5	5.5	5.5	7.33	6.33	1.33	-	-	-	-	-	-	-	-	-	-



Notes: 1) Wall Height is measured from base of bottom layer of Modular Concrete Units to top of wall (top of cap unit); and
 2) Geogrid length is measured as the distance behind the front face of the MSE units;
 3) Geogrid shall be Synchro SF 20 for all layers.



Specification Guidelines

SPECIFICATION FOR SEGMENTAL RETAINING WALL SYSTEMS

PART 1: GENERAL

1.01 Description

- A. Work includes furnishing and installing segmental retaining wall (SRW) units to the lines and grades designated on the project's final construction drawings or as directed by the Architect/Engineer.
- B. Also included are furnishing and installing appurtenant materials required for construction of the retaining wall as shown on the construction drawings.

1.02 Reference Standards

A. Segmental Retaining Wall Units

1. ASTM C 1372 - Standard Specification for Segmental Retaining Wall Units
2. ASTM C 140 - Standard Test Methods of Sampling and Testing Concrete Masonry Units

B. Geosynthetic Reinforcement

1. ASTM D 4596 - Tensile Properties of Geotextiles by the Wide-Width Strip Method
2. ASTM D 5262 - Test Method for Evaluating the Unconfined Creep Behavior of Geosynthetics
3. GRI:GG1 - Single Rib Geogrid Tensile Strength
4. GRI:GG5 - Geogrid Pullout

C. Soils

1. ASTM D 698 - Moisture Density Relationship for Soils, Standard Method
2. ASTM D 422 - Gradation of Soils
3. ASTM D 424 - Atterberg Limits of Soil

D. Mortar

1. ASTM C 270 - Standard Specification for Mortar for Unit Masonry

E. Drainage Pipe

1. ASTM D 3034 - Specification for Polyvinyl Chloride (PVC) Plastic Pipe
2. ASTM D 1248 - Specification for Corrugated Plastic Pipe

F. Engineering Design

1. "NCMA Design Manual for Segmental Retaining Walls", 3rd Edition



2. Any discrepancies between the Project Specifications and Plans developed for the project and these specifications and attached plans shall be forwarded in writing to SynchroPile, Inc. for clarification and final determination of applicable document.

1.03 Submittals

- A. **Material Submittals:** Samples of all products used in the work of this section.
- B. **Manufacturer's specifications** (latest edition) for proposed materials, method of installation and list of materials proposed for use.

1.04 Delivery, Storage and Handling

- A. Contractor shall check materials upon delivery to assure that specified type and grade of materials have been received and proper color and texture of SRW units have been received.
- B. Contractor shall prevent excessive mud, wet concrete, epoxies, and like materials that may affix themselves, from coming in contact with materials.
- C. Contractor shall store and handle materials in accordance with manufacturer's recommendations.
- D. Contractor shall protect materials from damage. Damaged materials shall not be incorporated into the retaining wall.

PART 2: MATERIALS

2.01 Segmental Retaining Wall Units

- A. SRW units shall be machine formed, Portland Cement concrete blocks specifically designed for retaining wall applications. SRW units currently approved for this project are "Pavestone Anchor Diamond Pro Beveled Face" Retaining Wall Units as manufactured under license from Anchor Wall Systems.
- B. Color of SRW units shall be selected by the owner or his representative.
- C. Texture: Split-Rock Face.
- D. Meet requirements of ASTM C1372, except the maximum water absorption shall be limited to 7 percent, and unit height dimensions shall not vary more than plus or minus 1/16 inch from that specified in the ASTM reference, not including textured face.
- E. Unit Face Area: Not less than 0.67 square feet.
- F. Include an integral concrete shear connection flange/locator.
- H. SRW units shall be sound and free of cracks or other defects that would interfere with the proper placing of the unit or significantly impair the strength or permanence of the structure. Cracking or excessive chipping may be grounds for rejection. Units showing cracks longer than 1/2" shall not be used within the wall. Units showing chips visible at a distance of 30 feet from the wall shall not be used within the wall.



- I. Concrete used to manufacture SRW units shall have a minimum 28 days compressive strength of 3,000 psi. Compressive strength test specimens shall conform to the saw-cut coupon provisions of Section 5.2.4 of ASTM C140 with the following exception: Coupon shall be taken from the least dimension of the unit of a size and shape representing the geometry of the unit as a whole.
- J. SRW units' molded dimensions shall not differ more than + 1/8 inch from that specified, except height which shall be + 1/16 inch as measured in accordance with ASTM C140.

2.02 Mortar

- A. Mortar used shall consist of a Type S, Grade NS, Class 25.

2.03 Drainage Pipe

- A. Drainage Pipe shall be perforated or slotted PVC or corrugated HDPE pipe manufactured in accordance with D3034 and/or ASTM F406. The pipe may be covered with a geotextile filter fabric to function as a filter.

2.04 Geosynthetic Reinforcement

- A. Geogrid shall be Syntex SF 20, SF 35, SF 55, SF 80 or SF 110, Manufactured by Geo-Synthetics, Inc, or equivalent, and having the property requirements described within the manufacturer's specifications and required by the design (or equivalent).
- B. The type, strength, and placement location of the reinforcing geosynthetic shall be as determined by the Wall Design Engineer, as shown on the final, P.E. sealed retaining wall plans.

2.05 Levelling Pad

- A. Material shall consist of compacted crushed stone or unreinforced concrete as shown on the construction drawing. "Pea gravel" or any other poorly graded stone shall not be permitted. The leveling pad should extend laterally at least a distance of 6 inches from the toe and heel of the lowermost SRW unit. A minimum of two inches of concrete can be used for the leveling pad if founded on competent rock.

2.06 Reinforced (Infill) Soil and Drainage Aggregate

Reinforced Select Fill shall consist of clean 1-1/2" minus crushed stone or crushed gravel meeting the gradation listed below. This material will also serve as Drainage Aggregate. "Pea gravel" shall not be used.

Sieve Size	Percent Passing
1-1/2 inch	100
3/4 inch	75-100
No. 4	0 - 10
No. 50	0 - 5



PART 3: CONSTRUCTION

3.01 Quality Control / Quality Assurance

- A. The wall installation contractor is responsible for quality control (QC) of installation of all materials. Contractor's field construction supervisor shall have demonstrated experience and be qualified to direct all work at the site. The contractor should enlist the assistance of a qualified party to verify the correct installation of all materials according to these specifications and the construction drawings.
- B. The Owner, at his own expense, should retain a qualified professional to perform quality assurance (QA) checks of the contractor's work.
- C. Work found to be deficient according to these specifications or the construction drawings must be corrected at the contractor's expense.
- D. The Owner, at his own expense, should (unless required by the City of Rockwall) retain a licensed engineering company to perform the following **Special Inspections** (in accordance with IBC Chapter 17 (See IB 132)), including field reports to verify proper construction in accordance with these specifications:
 - D.1 Observed that proper materials (backfill, modular blocks and grid etc.) are used in the wall construction;
 - D.2 Verify proper construction of the Foundation Preparation and Base Leveling Pad;
 - D.3 Verify proper construction of the modular blocks, geogrid, and backfill, including compaction of the backfill material;
 - D.4 Notify SynchroPile of any occurrence of changed conditions from those listed in these design documents.
 - D.5 Verify condition of finished grades, above and below the wall, meets the design requirements contained herein.

3.02 Excavation

- A. Contractor shall excavate to the lines and grades shown on the project grading plans. Contractor shall take precautions to minimize over-excavation. Contractor shall be careful not to disturb embankment and foundation materials beyond lines shown. Do not excavate within 3 ft of existing trees. Place guy lines to tie back and support trees during excavation.
- B. Contractor shall verify location of existing structures and utilities prior to excavation. Contractor shall ensure all surrounding structures are protected from the effects of wall excavation. Excavation support, if required, is the responsibility of the Contractor.

3.03 Foundation Preparation

- A. Foundation soil shall be excavated as required for leveling pad and specified number of SRW units (See General Notes), or as directed by the Engineer.
- B. Foundation soil shall be in an undisturbed state, or compacted to a density to support the wall with minimum settlement (notify Engineer of any concerns with unsuitable or less than optimal foundation soils).



- C. Unsuitable soils shall be removed and replaced with acceptable material under the guidance of the Engineer.
- D. Extend areas requiring fill to a slope of no greater than 4 horizontal to 1 vertical (4:1) for a distance until natural grade is achieved.

3.04 Base Leveling Pad

- A. Leveling pad materials shall be placed upon an approved foundation to a minimum thickness of 3", or as directed by the Engineer.
- B. Foundation soil shall be approved by the Engineer to confirm that the actual foundation soil conditions meet or exceed assumed design conditions.
- C. Compact aggregate base material to provide a level, hard surface on which to place the first course of units.
- D. Prepare base materials to ensure complete contact with retaining wall units. Gaps are not allowed.

3.05 SRW ERECTION

- A. General: Erect units in accordance with manufacturer's instructions and recommendations, and as specified herein.
- B. Place first course of concrete wall units on the prepared base material. Check units for level and alignment. Maintain the same elevation at the top of each unit within each section of the base course.
- C. Ensure that foundation units are in full contact with natural or compacted soil base.
- D. Place concrete wall units side-by-side for full length of wall alignment. Alignment may be done by using a string line measured from the back of the block. Gaps are not allowed between the foundation concrete wall units.
- E. Place 12 inches (minimum) of drainage aggregate between, and directly behind, the concrete wall units. Fill voids in retaining wall units with drainage aggregate. Provide a drainage zone behind the wall units to within 9 inches of the final grade. Cap the backfill and drainage aggregate zone with 9 inches of impervious material.
- F. Install drainage pipe at the lowest elevation possible, to maintain gravity flow of water to outside of the reinforced zone. Slope the main collection drainage pipe, located just behind the concrete retaining wall units, 2 percent (minimum) to provide gravity flow to the daylighted areas. Daylight the main collection drainage pipe through the face of the wall, and/or to an appropriate location away from the wall system at each low point or at 50-foot (maximum) intervals along the wall. Alternately, the drainage pipe can be connected to a storm sewer system at 50-foot (maximum) intervals.
- G. Remove excess fill from top of units and install next course. Ensure drainage aggregate and backfill are compacted before installation of next course.
- H. Check each course for level and alignment. Adjust units as necessary to maintain level and alignment prior to proceeding with each additional course.
- I. Install each succeeding course. Backfill as each course is completed. Pull the units forward until the locating surface of the unit contacts the locating surface of the units in



the preceding course. Interlock wall segments that meet at corners by overlapping successive courses. Attach concrete retaining wall units at exterior corners with adhesive specified.

3.06 Geosynthetic Reinforcement Placement

- A. All geosynthetic reinforcement shall be installed in accordance with geosynthetic manufacturer's recommendations at the proper elevation and orientation as shown on the retaining wall plan profiles and details, or as directed by the Wall Design Engineer.
- B. At the elevations shown on the final plans, the geosynthetic reinforcement shall be laid horizontally on compacted infill and on top of the concrete SRW units. Embedment of the geosynthetic in the SRW units shall be consistent with SRW manufacturer's recommendations. Correct orientation of the geosynthetic reinforcement shall be verified by the Contractor to be in accordance with the geosynthetic manufacturer's recommendations. The highest strength direction of the geosynthetic must be perpendicular to the wall face.
- C. Geosynthetic reinforcement layers shall be one continuous piece for their entire embedment length. Overlap of the geosynthetic in the design strength direction (perpendicular to the wall face) shall not be permitted. Horizontally adjacent sections of geosynthetic reinforcement shall be butted in a manner to assure 100 percent coverage after placement. Gapping between horizontally adjacent layers of geosynthetic (partial coverage) will not be allowed.
- D. Tracked construction equipment shall not be operated directly on the geosynthetic reinforcement. A minimum of 6 inches of backfill is required prior to operation of tracked vehicles over the geosynthetic. Turning should be kept to a minimum. Rubber-tired equipment may pass over the geosynthetic reinforcement at slow speeds (less than 5 mph).
- E. The geosynthetic reinforcement shall be in tension and free of wrinkles prior to placement of soil fill. The nominal tension shall be applied to the reinforcement and secured in place with staples, stakes or by hand tensioning until reinforcement is covered by six inches of fill.

3.07 Drainage Materials

Drainage aggregate shall be installed to the line, grades, and sections shown on the final plans. Drainage aggregate shall be placed to the minimum thickness shown on the construction plans between and behind units (a minimum of one cubic foot for each exposed square foot of wall face unless otherwise noted on the final wall plans).

3.08 Select Fill Placement

- A. Crushed Rock Reinforced select fill material shall be placed in 6-inch maximum compacted lifts using at least three (3) passes of a lightweight hand operated mechanical tamper, plate, or roller. The crushed stone material shall be densely compacted per TxDOT Item 423.3 E. The backfill shall be placed and spread in such a manner as to eliminate wrinkles or movement of the geosynthetic reinforcement and the SRW units.
- B. At completion of wall construction, general clay backfill shall be placed level with the final top of wall elevation. If final grading, paving, landscaping, and/or storm drainage



Installation adjacent to the wall is not placed immediately after wall completion, temporary grading and drainage shall be provided to ensure water runoff is not directed at the wall nor allowed to collect or pond behind the wall until final construction adjacent to the wall is completed.

3.09 SRW Caps

- A. SRW caps shall be properly aligned and glued to underlying units with a flexible, high-strength concrete adhesive. Rigid adhesive or mortar are not acceptable.
- B. Caps shall overhang the top course of units by 3/4 to 1 inch. Slight variation in overhang is allowed to correct alignment at the top of the wall.
- C. Cut cap units as necessary to obtain the proper fit.


3.10 Construction Adjacent to Completed Wall

- A. The Owner or Owner's Representative is responsible for ensuring that construction by others adjacent to the wall does not disturb the wall or place temporary construction loads on the wall that exceed design loads, including loads such as water pressure, temporary grades, or equipment loading. Heavy paving or grading equipment shall be kept a minimum of three feet behind the back of the wall face. Equipment with wheel loads in excess of 150 psf live load shall not be operated within 10 feet of the face of the retaining wall during construction adjacent to the wall. Care should be taken by the General Contractor to ensure water runoff is directed away from the wall structure until final grading and surface drainage collection systems are completed.

END OF SECTION

NOTES:
 1) WIND LOADED FENCE OR GUARD RAIL DESIGN AND CONSTRUCTION REQUIRES SPECIFIC ANALYSIS FOR EVERY WALL CASE. CONTACT A QUALIFIED LOCAL ENGINEER FOR ASSISTANCE.
 2) ANY VERTICAL GUARD RAIL POSTS SHOULD BE A MINIMUM OF 36" BEHIND WALL FACE

contractor to verify compliance with existing grades and proposed top of wall grades

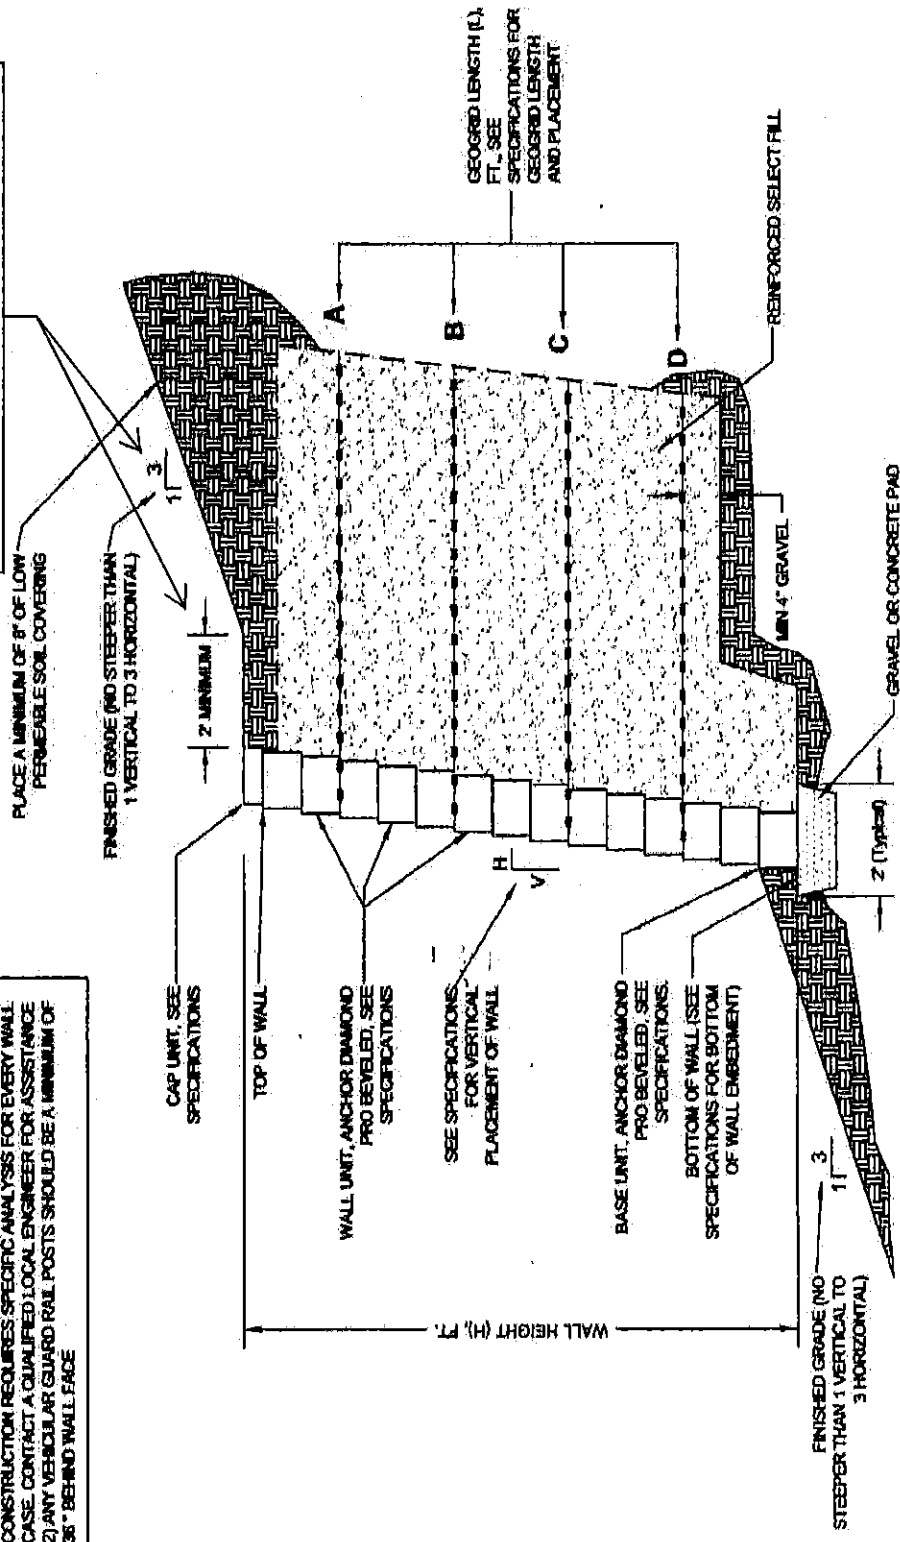

Anchor™ Diamond Pro®
Typical Reinforced Section
 NOT TO SCALE

SHEET 1 OF 3




SYNCHROPOLE, INC.
 TYPE FIRM REGISTRATION NO. P-4631

8123 Blanco Road
 San Antonio, Texas 78210
 Phone: 210-441-0540
 Fax: 210-440-6434

ANCHOR DIAMOND PRO (BEVELED)
MODULAR RETAINING WALL
ROOMS TO GO - ROCKWALL
14-30 AND GREENCREST
ROCKWALL, TEXAS

PROJ. NO. 2418-0201
 DATE 12/20/01



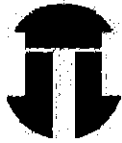


SYNCHROPIX, INC.
TYPE FIRM REGISTRATION NO. F-6631


0123 Bando Road
San Antonio, Texas 78210
Phone: 210-641-0410
Fax: 210-240-8434

PROJ. NO. 241-028
DATE: 10/27/88

ANCHOR DIAMOND PRO (BEVELED)
MODULAR RETAINING WALL
ROOMS TO GO - ROCKWALL
IH-30 AND GREENCREST
ROCKWALL, TEXAS

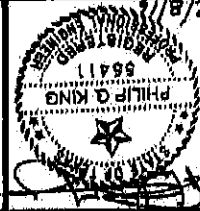


PLACE ADDITIONAL REINFORCEMENT ON THE NEXT COURSE OF SEGMENTAL UNITS IMMEDIATELY ABOVE THE SPECIFIED PLACEMENT ELEVATION IN A MANNER THAT ELIMINATES GAPS LEFT BY THE PREVIOUS LAYER OF GEOSYNTHETIC AT THE SPECIFIED REINFORCEMENT ELEVATION.

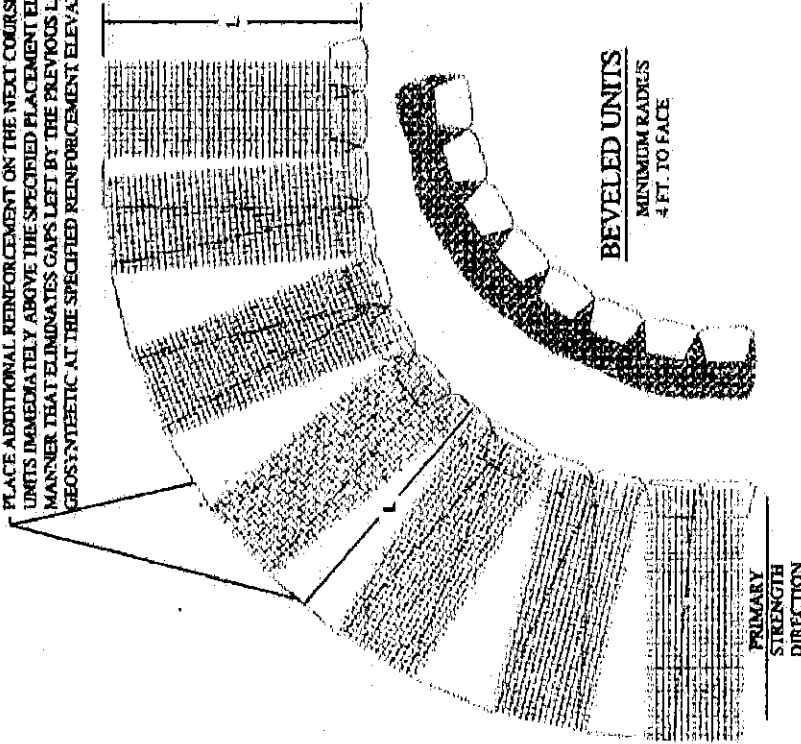


Anchor™ Diamond Pro®
Inside Curve Details
NOT TO SCALE

SHEET 2 OF 3

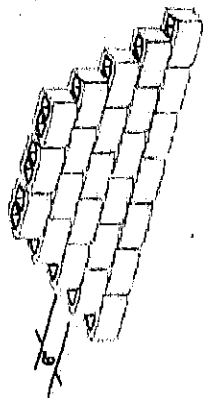

BEVELED UNITS

EXTERNAL GEOSYNTHETIC REINFORCEMENT TO EXTEND 1' OF THE LOWER BLOCK FACE

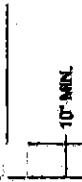

10" MIN.

Anchor™ Diamond Pro®
Reinforcement Connection Detail
NOT TO SCALE




ANCHOR DIAMOND PRO, INC.
 TYPE PIMA REGISTRATION NO. P-0831

5133 Blanco Road
 San Antonio, Texas 78216
 Phone: 210-441-0810
 Fax: 210-440-8734

PROJ. NO. Z414008
 DATE: 10/20/78


**ANCHOR DIAMOND PRO (BEVELD)
 MODULAR RETAINING WALL**

**ROOMS TO GO - ROCKWALL
 IH-30 AND GREENCREST
 ROCKWALL, TEXAS**

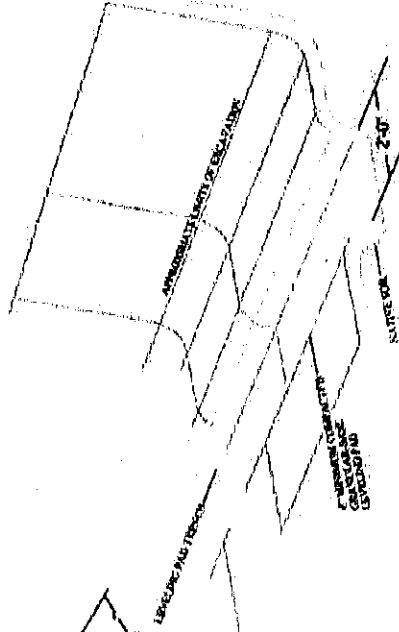


**Anchor™ Diamond Pro®
 Typical Base Preparation**
 NOT TO SCALE

STEP 3 - PLACE REINFORCEMENT IN THE AREAS WHERE THE MARKS SHOW GAPS IN THE LOWER REINFORCEMENT PATTERN. CONTINUE NORMAL WALL CONSTRUCTION, REPEATING THESE STEPS AS NEEDED.

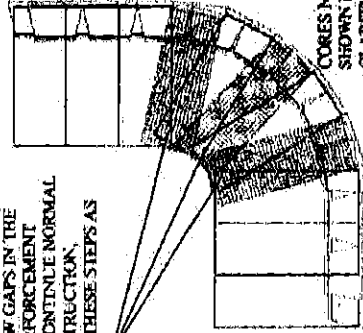


CORES NOT SHOWN FOR CLARITY

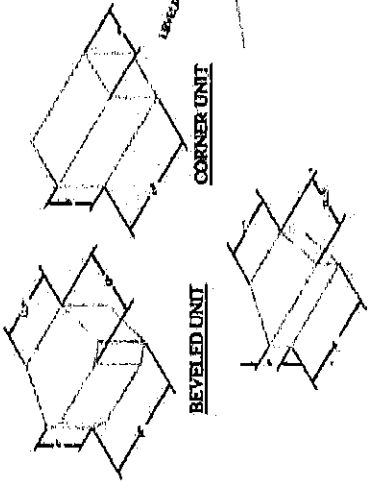


**Anchor™ Diamond Pro®
 Isometric Block Details**
 NOT TO SCALE

STEP 2 - LAY THE NEXT COURSE OF BLOCK. MAKE A MARK ON THE BACK OF THE BLOCKS IN THE AREAS THAT ARE NOT REINFORCED. BACKFILL AND COMPACT THAT COURSE.

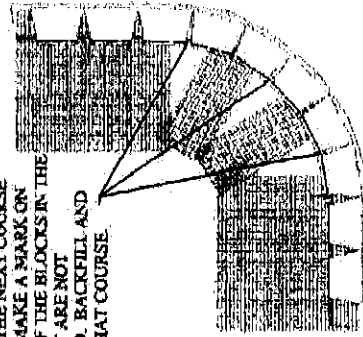

REVELED UNITS MINIMUM RADIUS - 4 FT. TO FACE

**Anchor™ Diamond Pro®
 Outside Curve Details**
 NOT TO SCALE

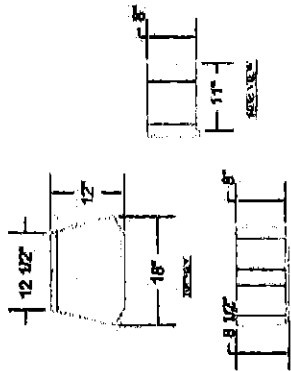

**Anchor™ Diamond Pro®
 Individual Block Views**
 NOT TO SCALE

STEP 1 - PLACE REINFORCEMENT SO THAT LITTLE OR NO OVERLAP OCCURS IN THE RADIUS AREA. IF OVERLAP OCCURS, PLACE 2 TO 3 INCHES OF FILL BETWEEN THE REINFORCEMENT LAYERS.

2 TO 3 INCHES OF FILL REQUIRED BETWEEN OVERLAPPED REINFORCEMENT FOR PROPER SOIL AND REINFORCEMENT INTERACTION

