


1. ALL WATER & SANITARY SEWER LINES ARE 6" UNLESS OTHERWISE NOTED.
2. WATER METER BOXES ARE 1' OFF BACK OF CURB.
3. ALL WATER SERVICES ARE TO THE CENTER OF LOT.
4. ALL SANITARY SEWER SERVICES ARE 10' OFF CENTER OF LOT ON THE DOWNSTREAM SIDE UNLESS OTHERWISE NOTED.
5. P.V.C. WATER LINES SHALL BE CLASS 150 (DR 18) RUBBER RING TYPE AND MANUFACTURED TO CAST IRON PIPE OUTSIDE DIA.
6. P.V.C. SEWER PIPE SHALL BE SDR 35 WITH RING TYPE (RUBBER RING) JOINTS.

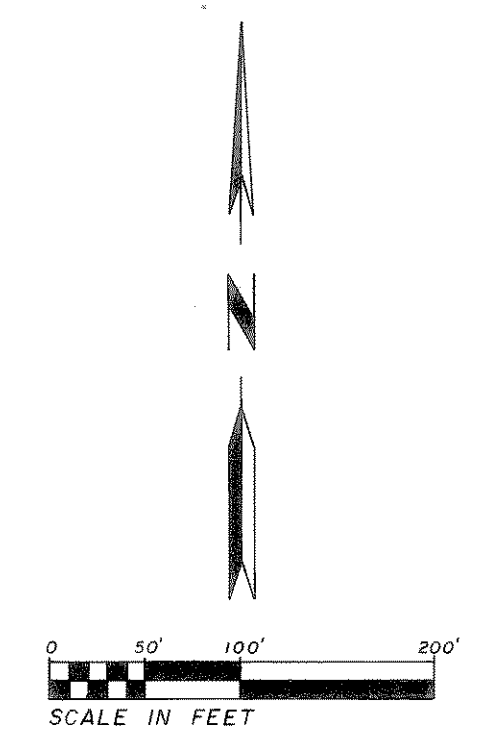

AS BUILT

**WATER & SANITARY SEWER**

ROYAL PARK PLACE  
ROCKWALL COUNTY, TEXAS

DESIGN: D.E.O.	DRAWN: Danny O.	DATE: SEPT., 1976	SCALE: 1"=100'
-------------------	--------------------	----------------------	-------------------

DALLAS HAROLD EVANS - CONSULTING ENGINEER 320-033